

**Drawings are for building reference only.**


REV NO	DESCRIPTION	DATE

DEPARTMENT OF DEFENSE  
HAWAII ARMY NATIONAL GUARD  
STATE OF HAWAII

PN15110011  
KALAELOA BUILDING 46  
INTERIOR RENOVATIONS  
KALAELOA, KAPOLEI, OAHU, HAWAII

SITE PLAN



DESIGNED BY:	CHECKED BY:	HARRIS JOB NO.	DRAWING NO.
DRAWN BY:	APPROVED BY:	DATE	A100
SCALE: AS NOTED	10 APR 2015	OF	SHTS

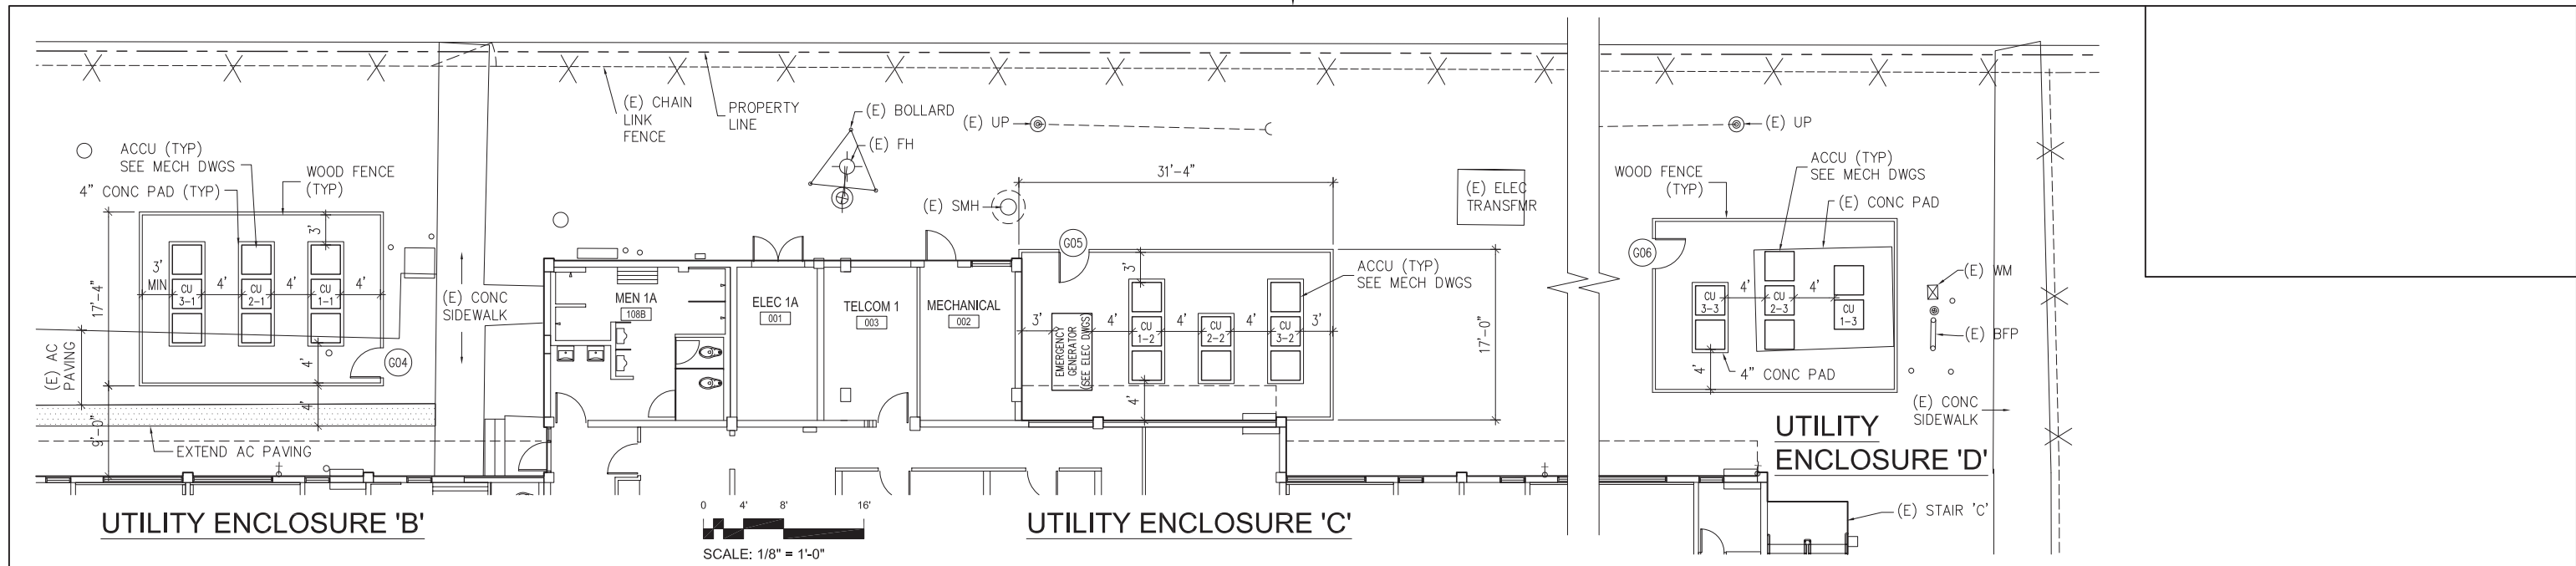

UTILITY ENCLOSURE 'B'


UTILITY ENCLOSURE 'C'

UTILITY ENCLOSURE 'D'

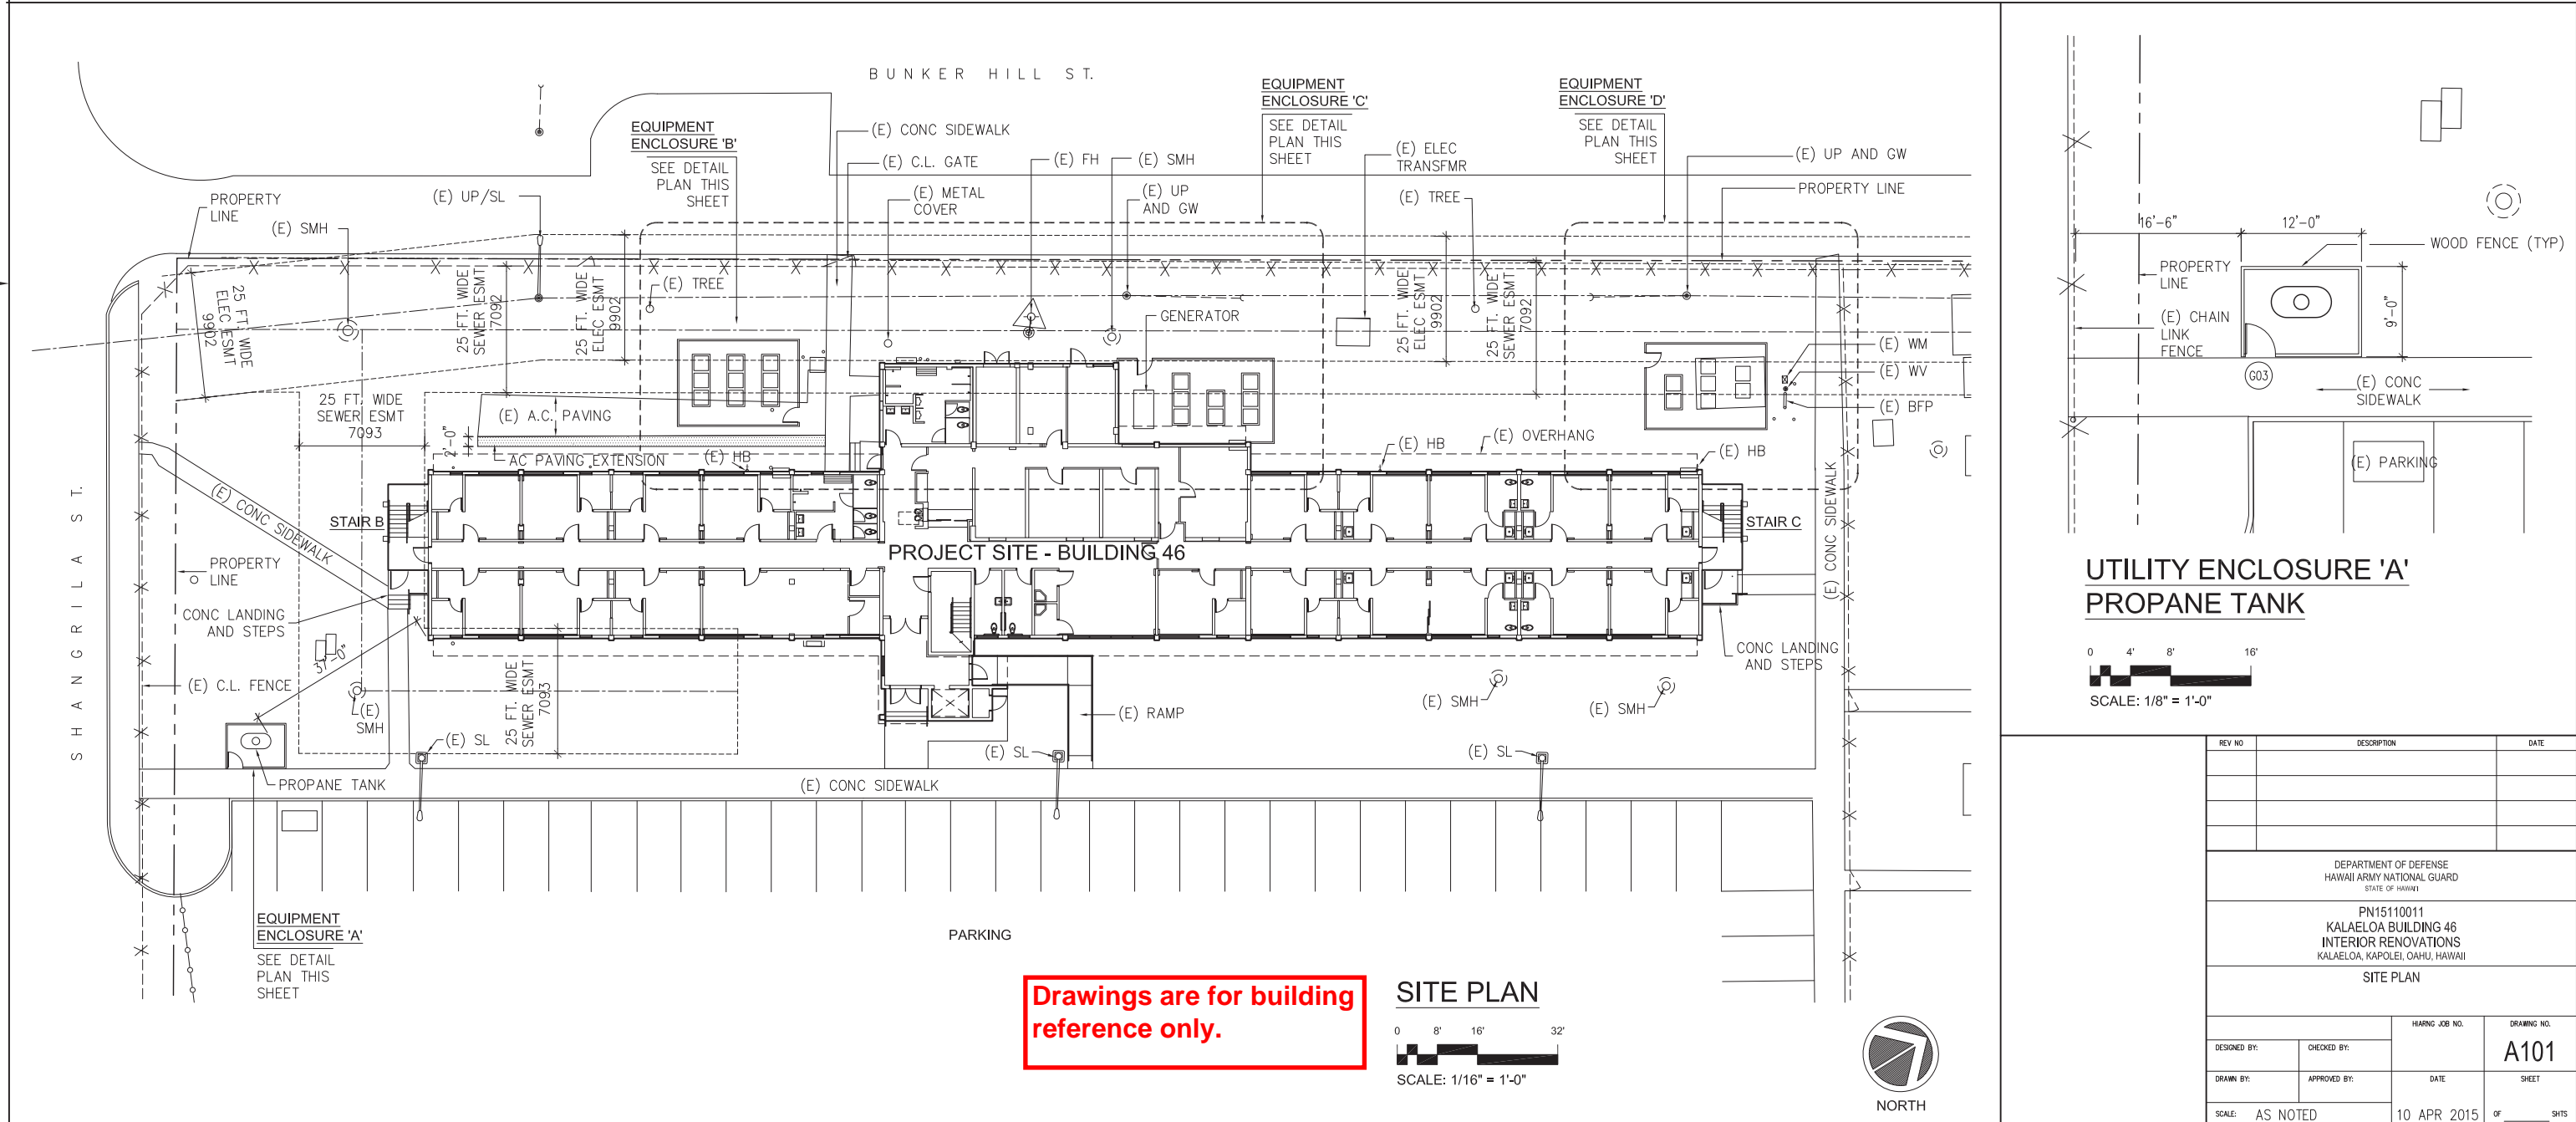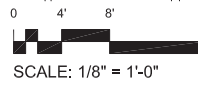


PROJECT SITE - BUILDING 46

UTILITY ENCLOSURE 'A'  
PROPANE TANK

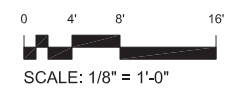


Drawings are for building reference only.

SITE PLAN

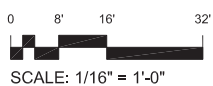

REV NO	DESCRIPTION	DATE
DEPARTMENT OF DEFENSE HAWAII ARMY NATIONAL GUARD STATE OF HAWAII		
PN15110011 KALAELOA BUILDING 46 INTERIOR RENOVATIONS KALAELOA, KAPOLEI, OAHU, HAWAII		
SITE PLAN		
DESIGNED BY:	CHECKED BY:	HARRIS JOB NO.
DRAWN BY:	APPROVED BY:	DATE
SCALE: AS NOTED	10 APR 2015	DRAWING NO. A101
		SHEET
		OF SHTS

DATE ISSUED: ---


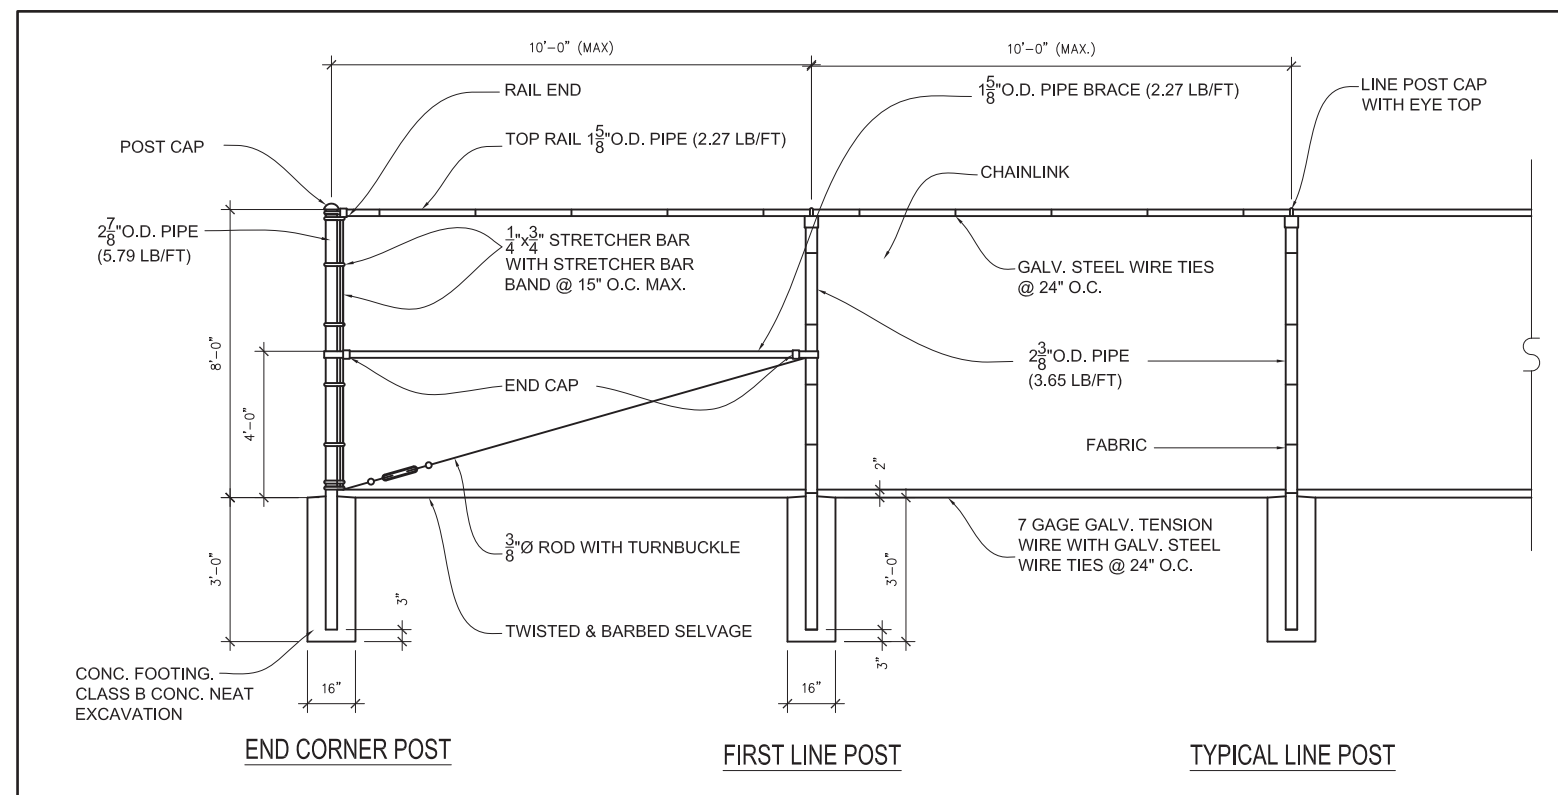


CHAIN LINK FENCE DETAIL


1  
1/2" = 1'-0"

REV NO	DESCRIPTION	DATE
DEPARTMENT OF DEFENSE HAWAII ARMY NATIONAL GUARD STATE OF HAWAII		
PN15110011 KALAELOA BUILDING 46 INTERIOR RENOVATIONS KALAELOA, KAPOLEI, OAHU, HAWAII		
SITE DETAILS		
DESIGNED BY:	CHECKED BY:	HARRIS JOB NO.
DRAWN BY:	APPROVED BY:	DATE
SCALE: AS NOTED	10 APR 2015	DRAWING NO. A105
		SHEET OF SHTS





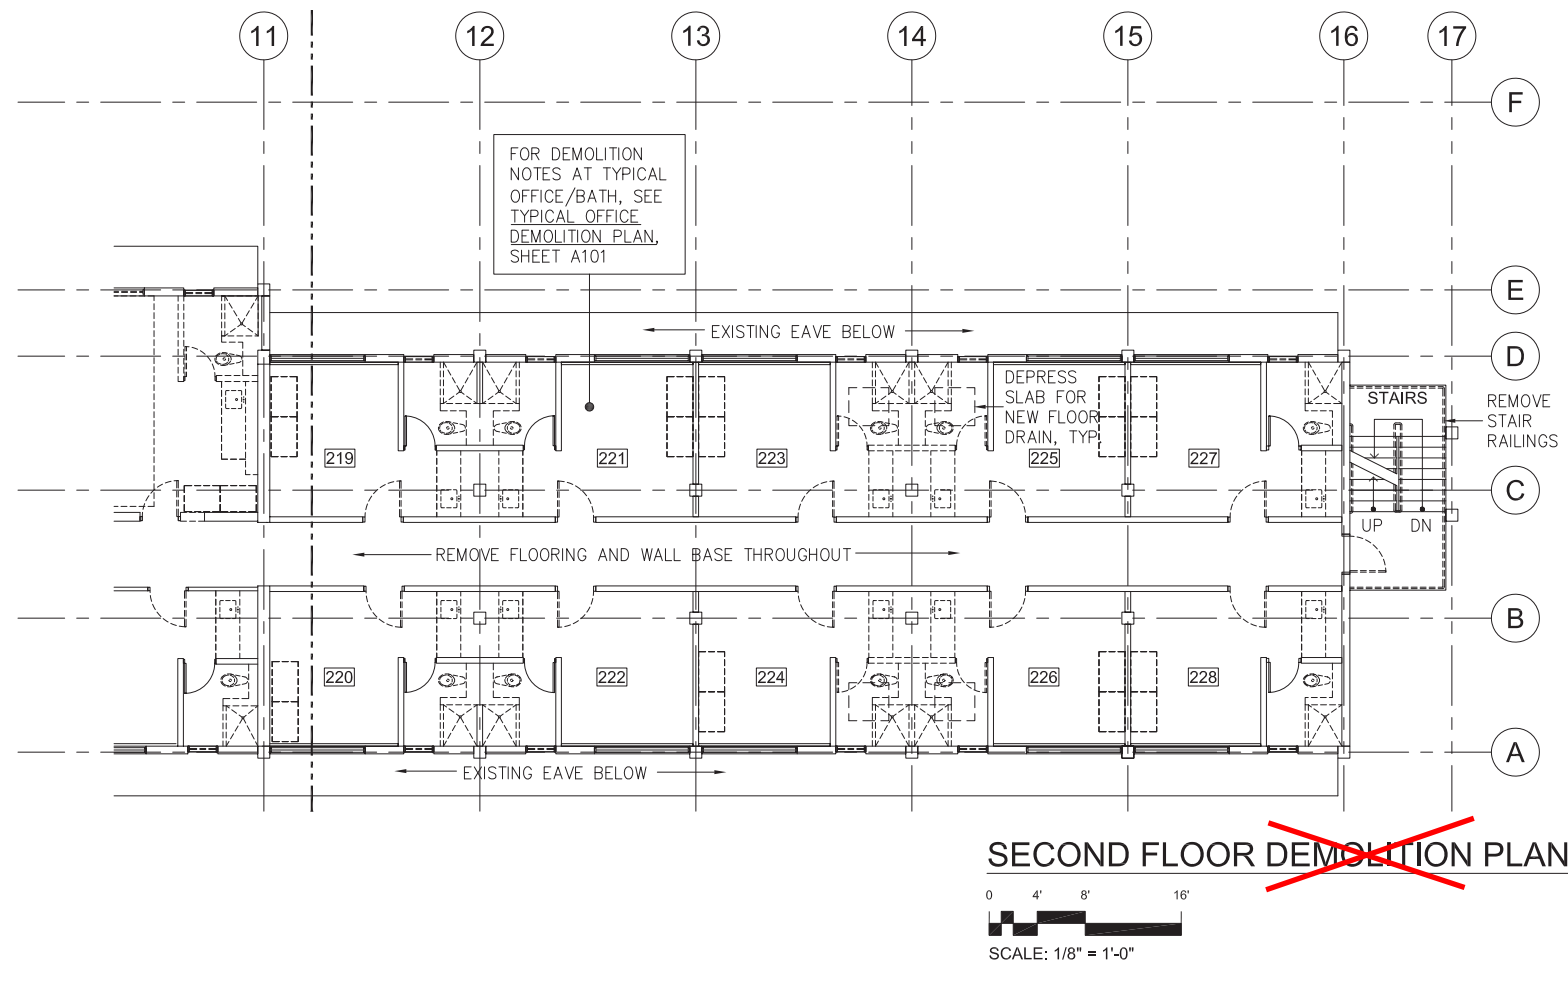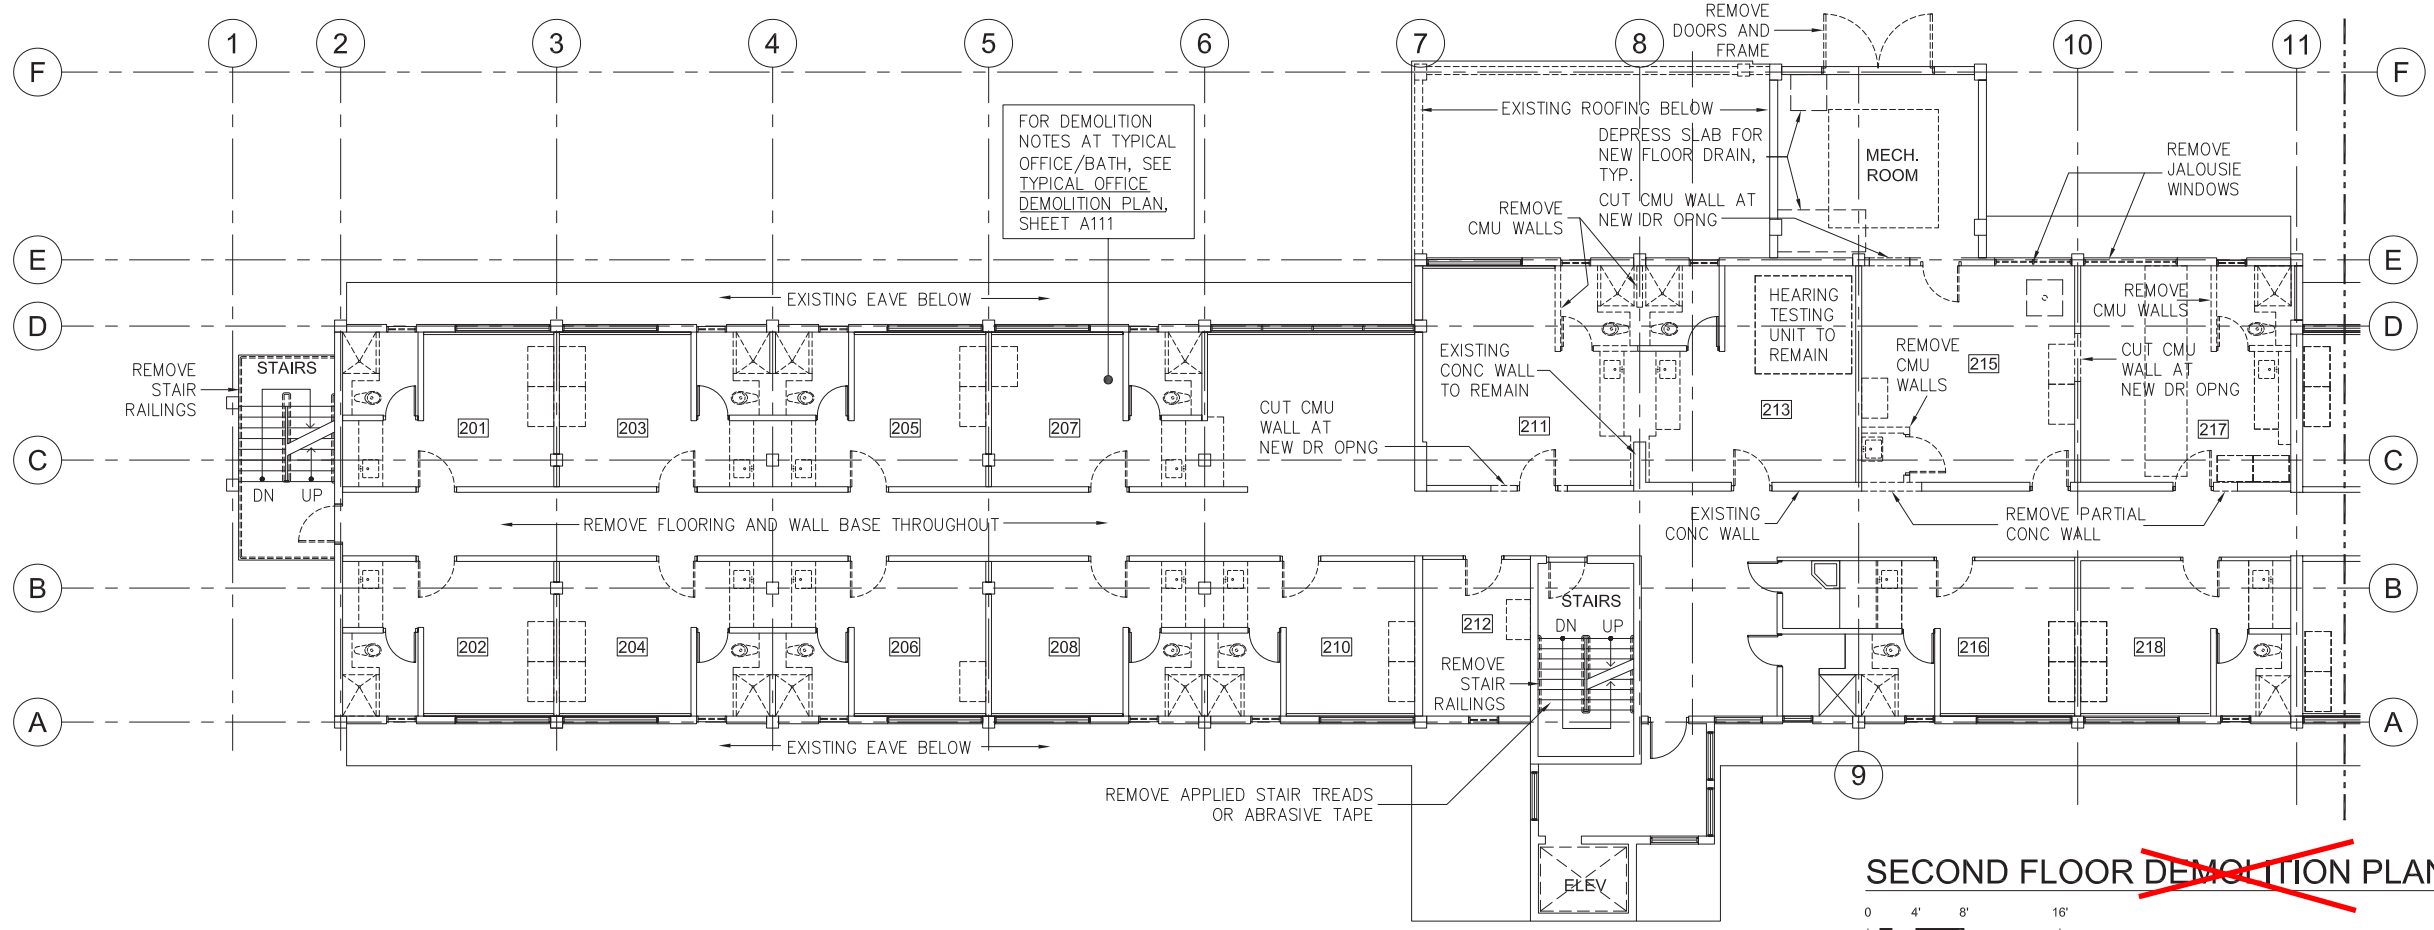


**Drawings are for building reference only.**

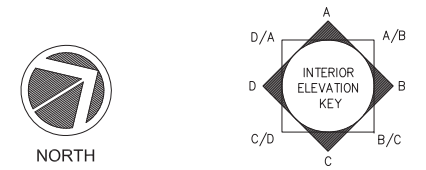

REV NO	DESCRIPTION	DATE
DEPARTMENT OF DEFENSE HAWAII ARMY NATIONAL GUARD STATE OF HAWAII		
PN15110011 KALAELOA BUILDING 46 INTERIOR RENOVATIONS KALAELOA, KAPOLEI, OAHU, HAWAII		
SECOND FLOOR EXISTING CONDITIONS AND DEMOLITION PLAN		
DESIGNED BY:	CHECKED BY:	HARRIS JOB NO.
DRAWN BY:	APPROVED BY:	DATE
SCALE: AS NOTED	10 APR 2015	DRAWING NO. A112
		SHEET
		OF SHTS

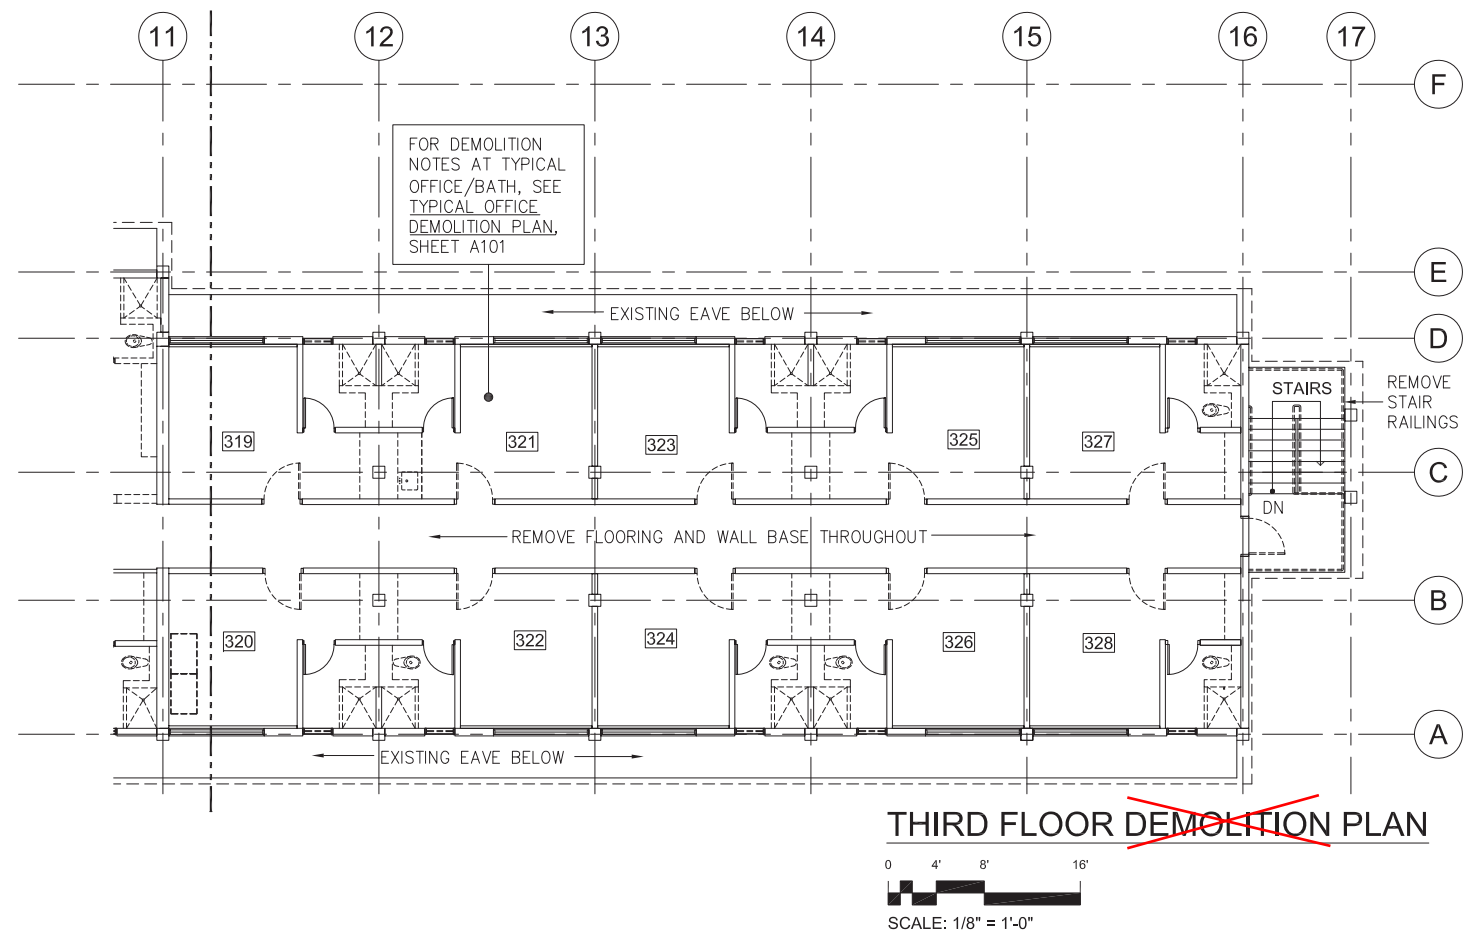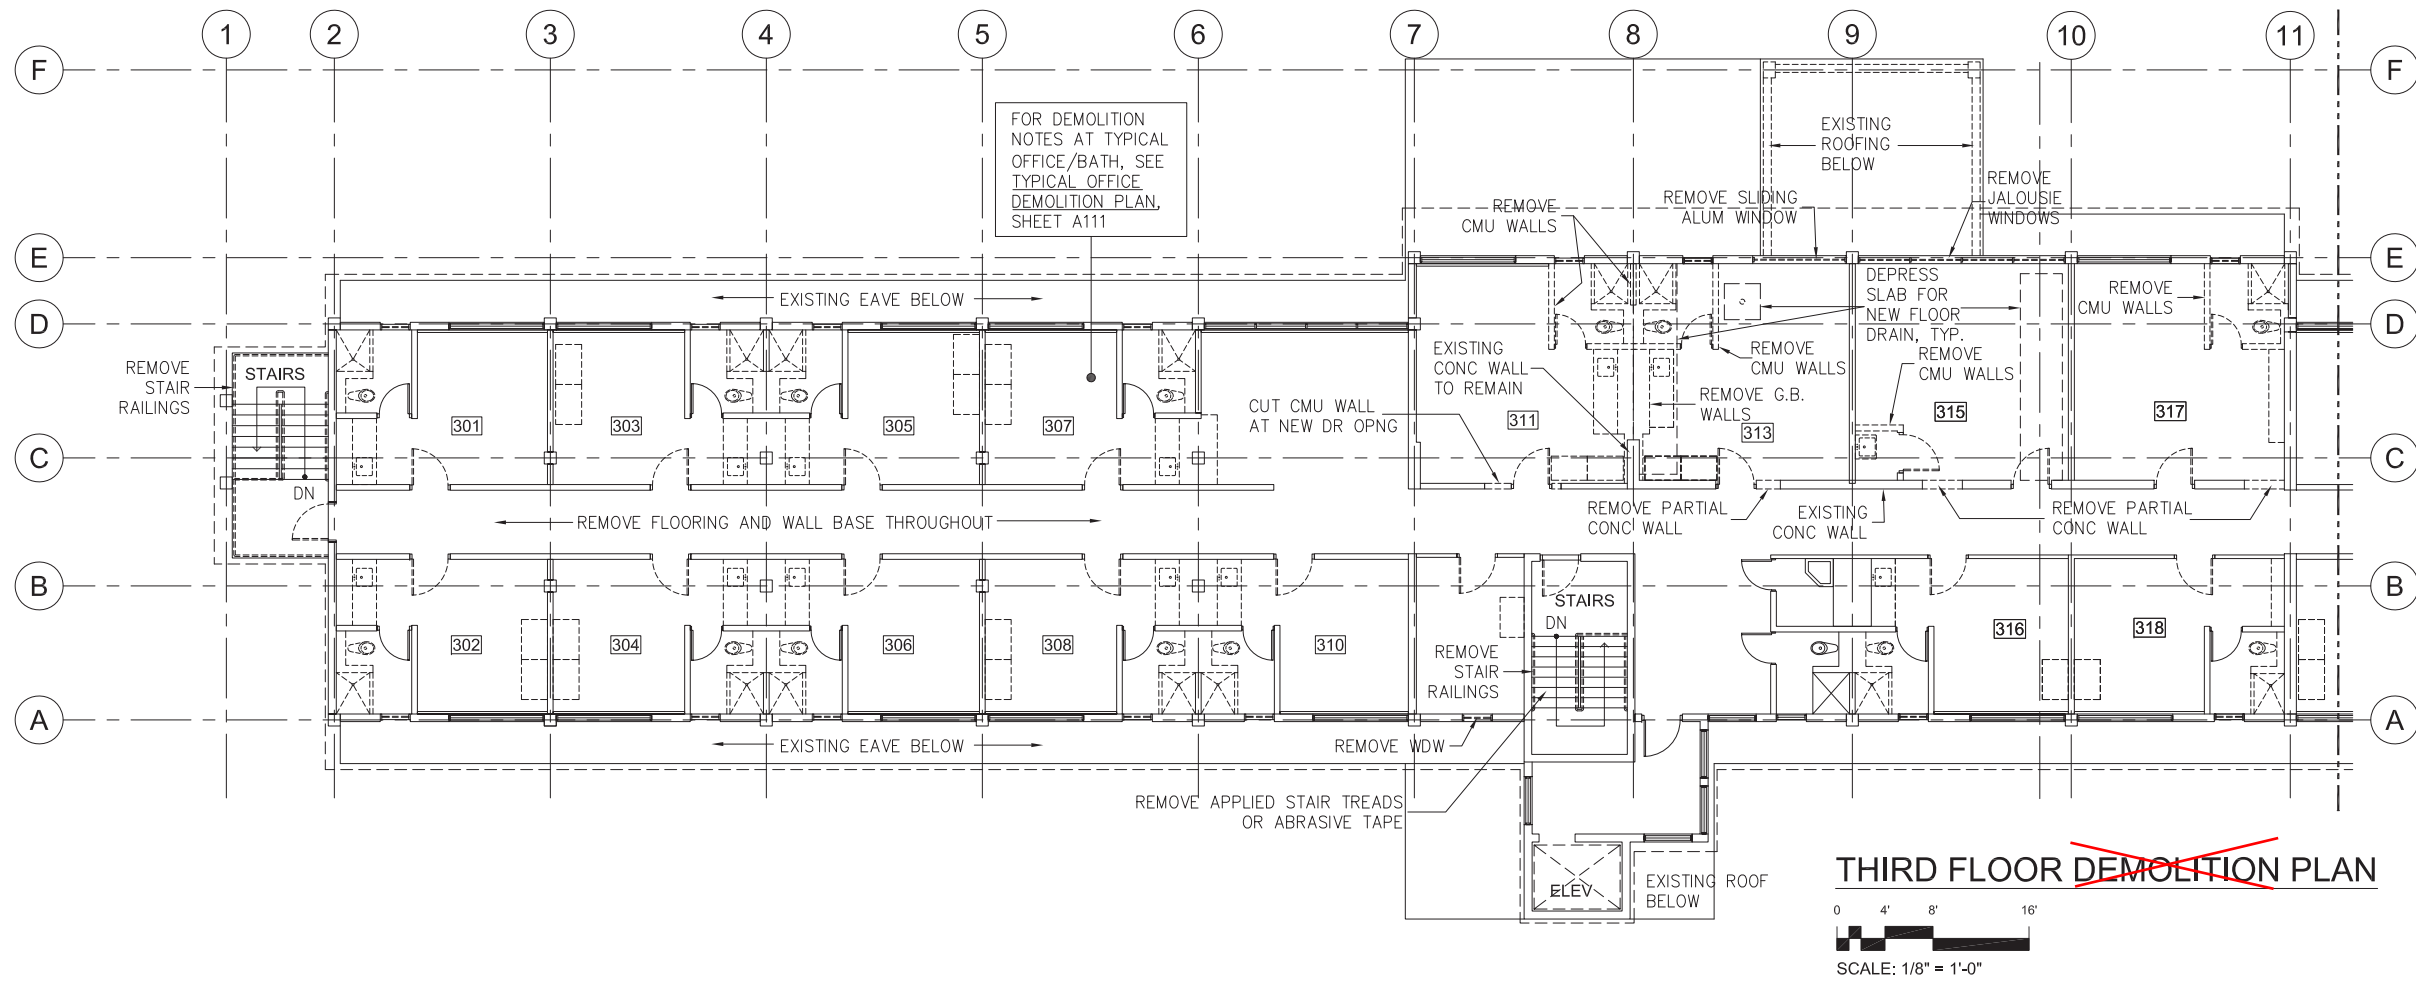


**Drawings are for building reference only.**


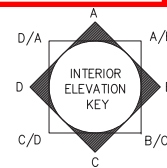


REV NO	DESCRIPTION	DATE
DEPARTMENT OF DEFENSE HAWAII ARMY NATIONAL GUARD STATE OF HAWAII		
PN15110011 KALAELOA BUILDING 46 INTERIOR RENOVATIONS KALAELOA, KAPOLEI, OAHU, HAWAII		
THIRD FLOOR EXISTING CONDITIONS AND DEMOLITION PLAN		
DESIGNED BY:	CHECKED BY:	HARRIS JOB NO.
DRAWN BY:	APPROVED BY:	DATE
SCALE: AS NOTED	10 APR 2015	OF SHTS
DRAWING NO. <b>A113</b>		SHEET





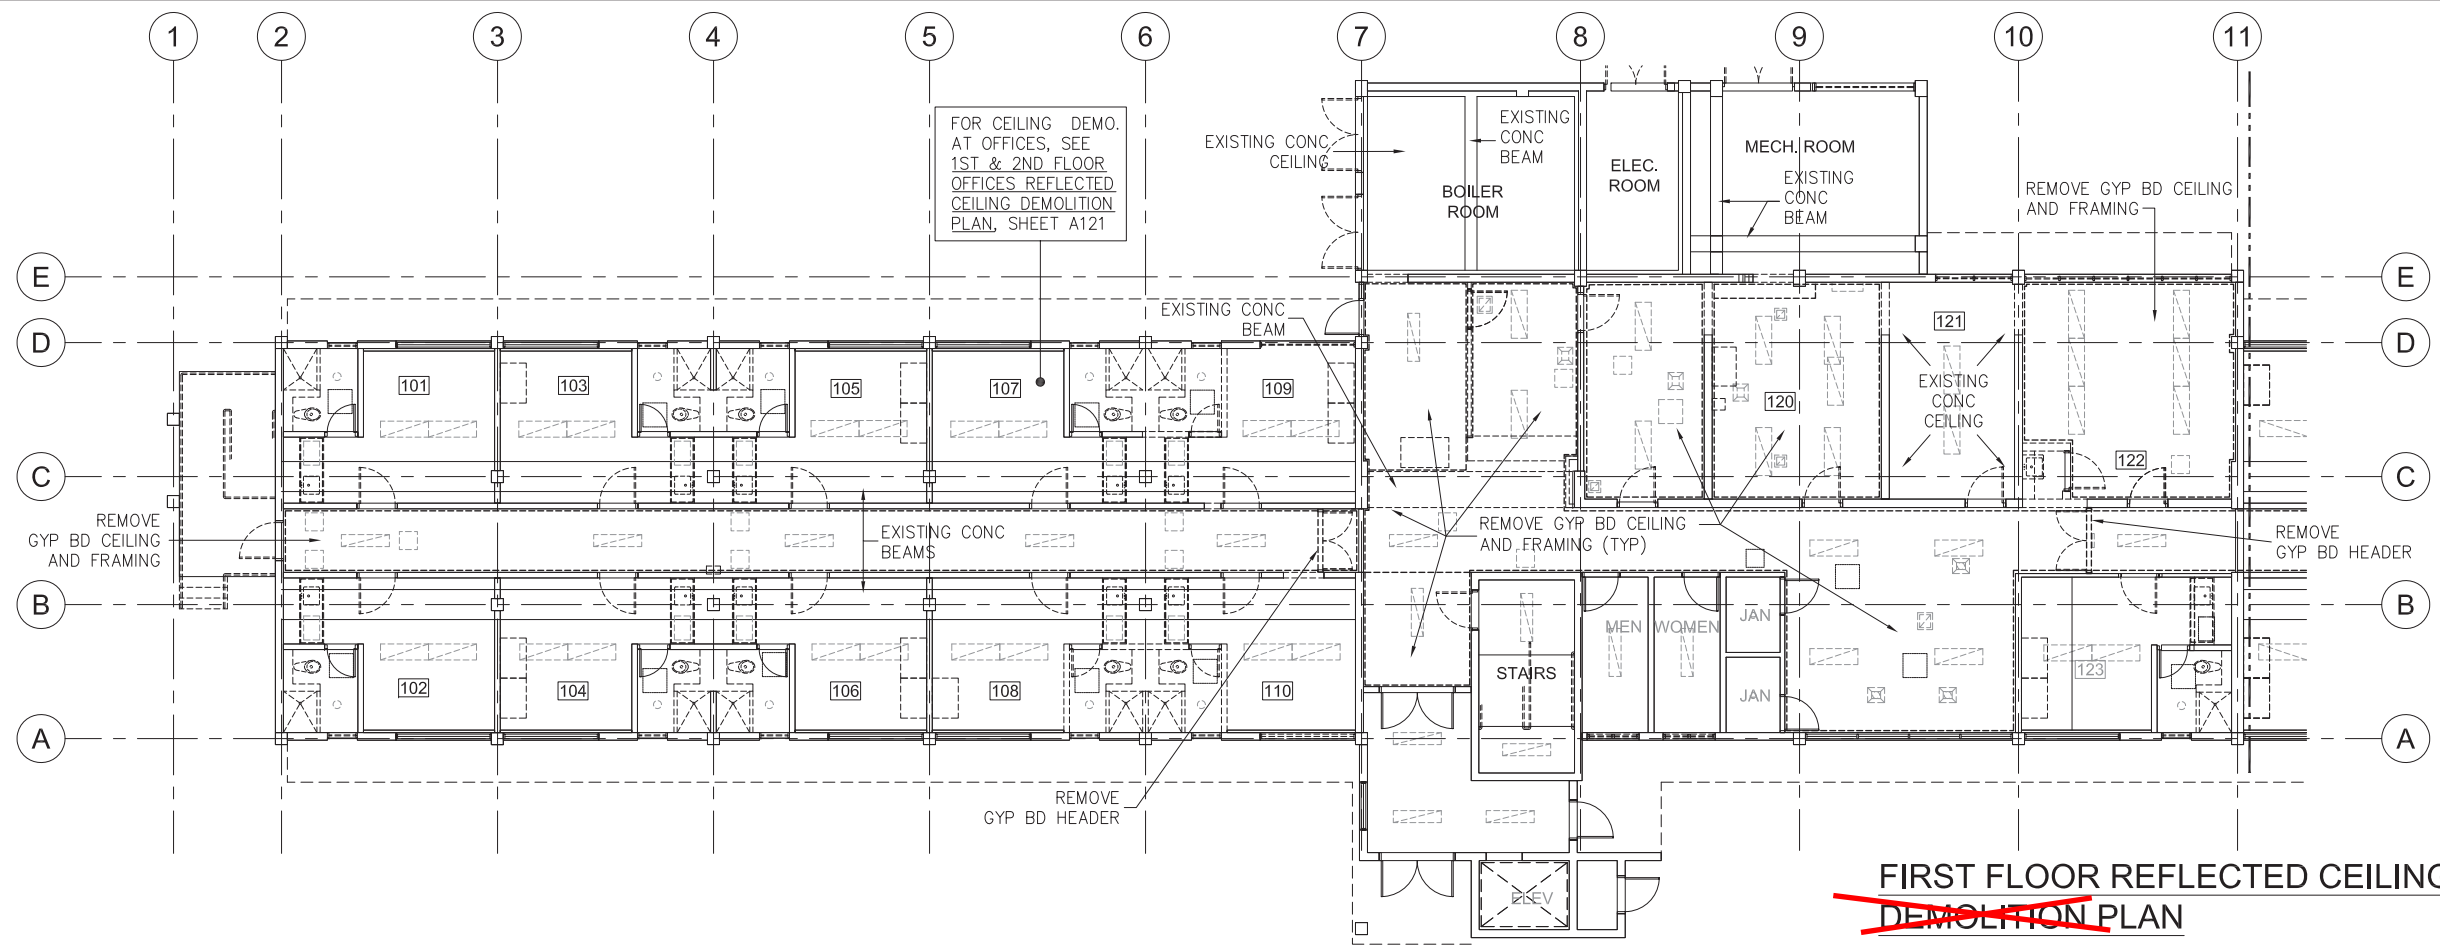


**FIRST FLOOR REFLECTED CEILING DEMOLITION PLAN**

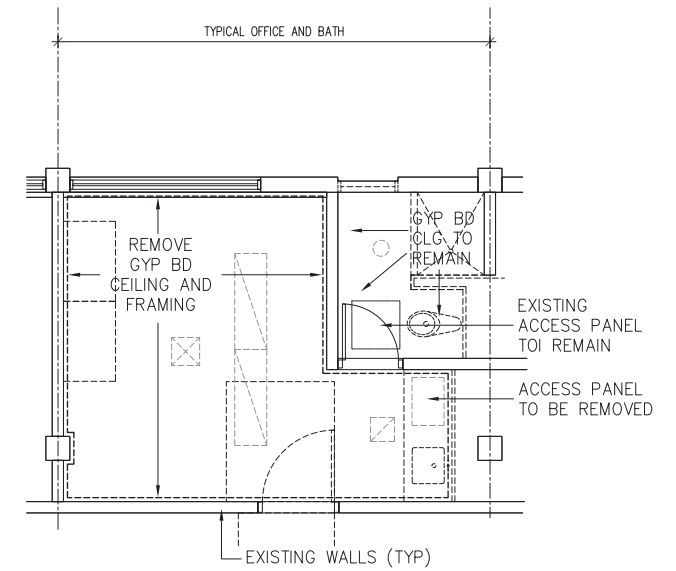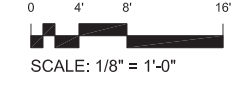


**1ST & 2ND FLOOR OFFICES REFLECTED CEILING DEMOLITION PLAN**

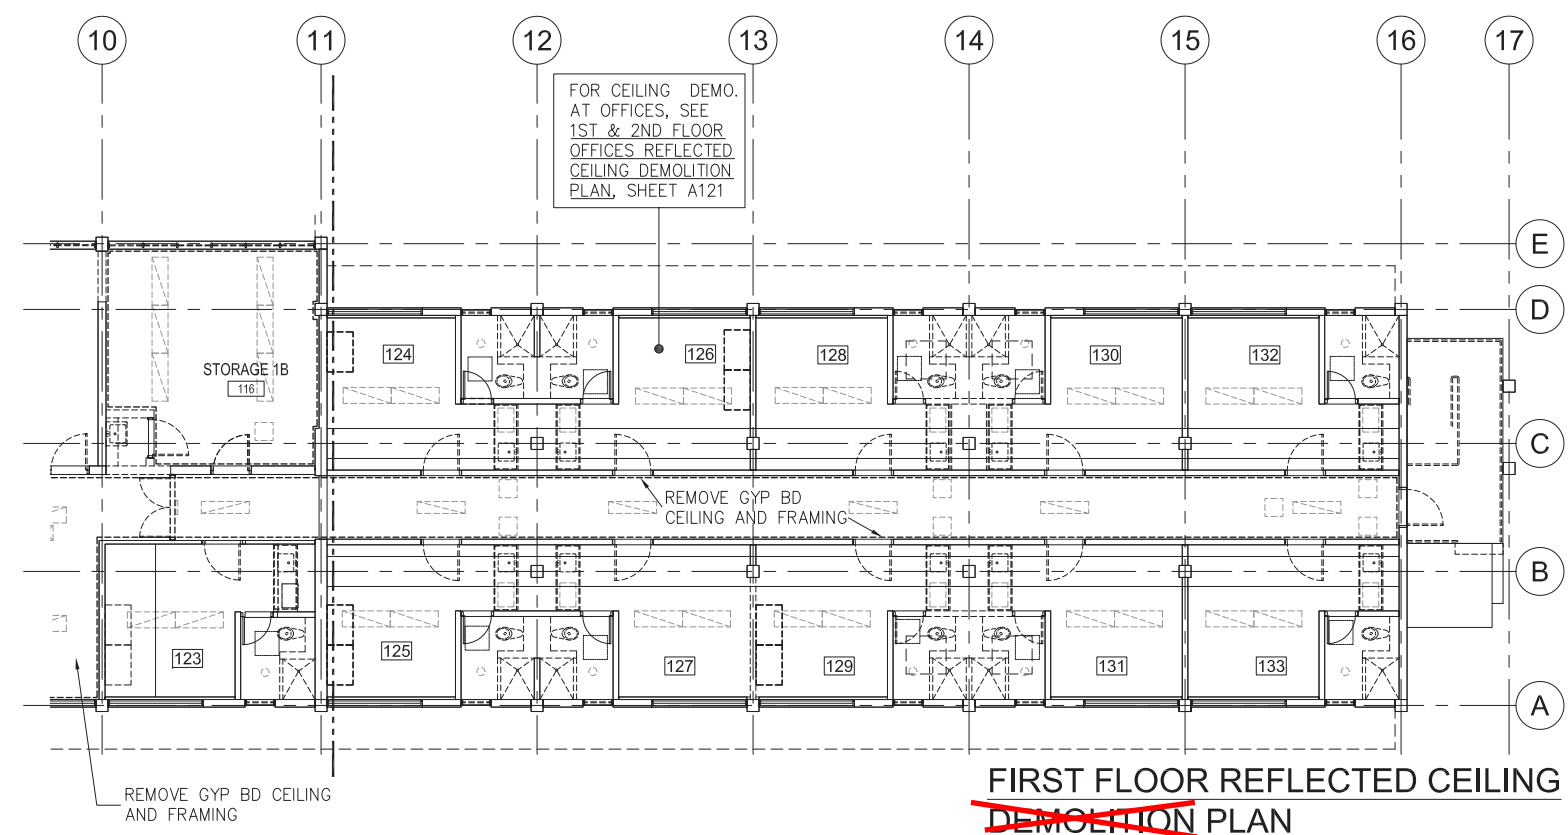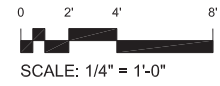

**FIRST FLOOR REFLECTED CEILING DEMOLITION PLAN**

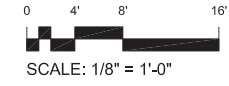

**Drawings are for building reference only.**

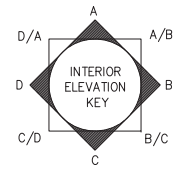


REV NO	DESCRIPTION	DATE
DEPARTMENT OF DEFENSE HAWAII ARMY NATIONAL GUARD STATE OF HAWAII		
PN15110011 KALAELOA BUILDING 46 INTERIOR RENOVATIONS KALAELOA, KAPOLEI, OAHU, HAWAII		
FIRST FLOOR REFLECTED CEILING DEMOLITION PLAN		
DESIGNED BY:	CHECKED BY:	HARRIS JOB NO.
DRAWN BY:	APPROVED BY:	DATE
SCALE: AS NOTED	10 APR 2015	OF SHTS



DRAWING NO.  
**A121**

SHEET


DATE ISSUED: ---

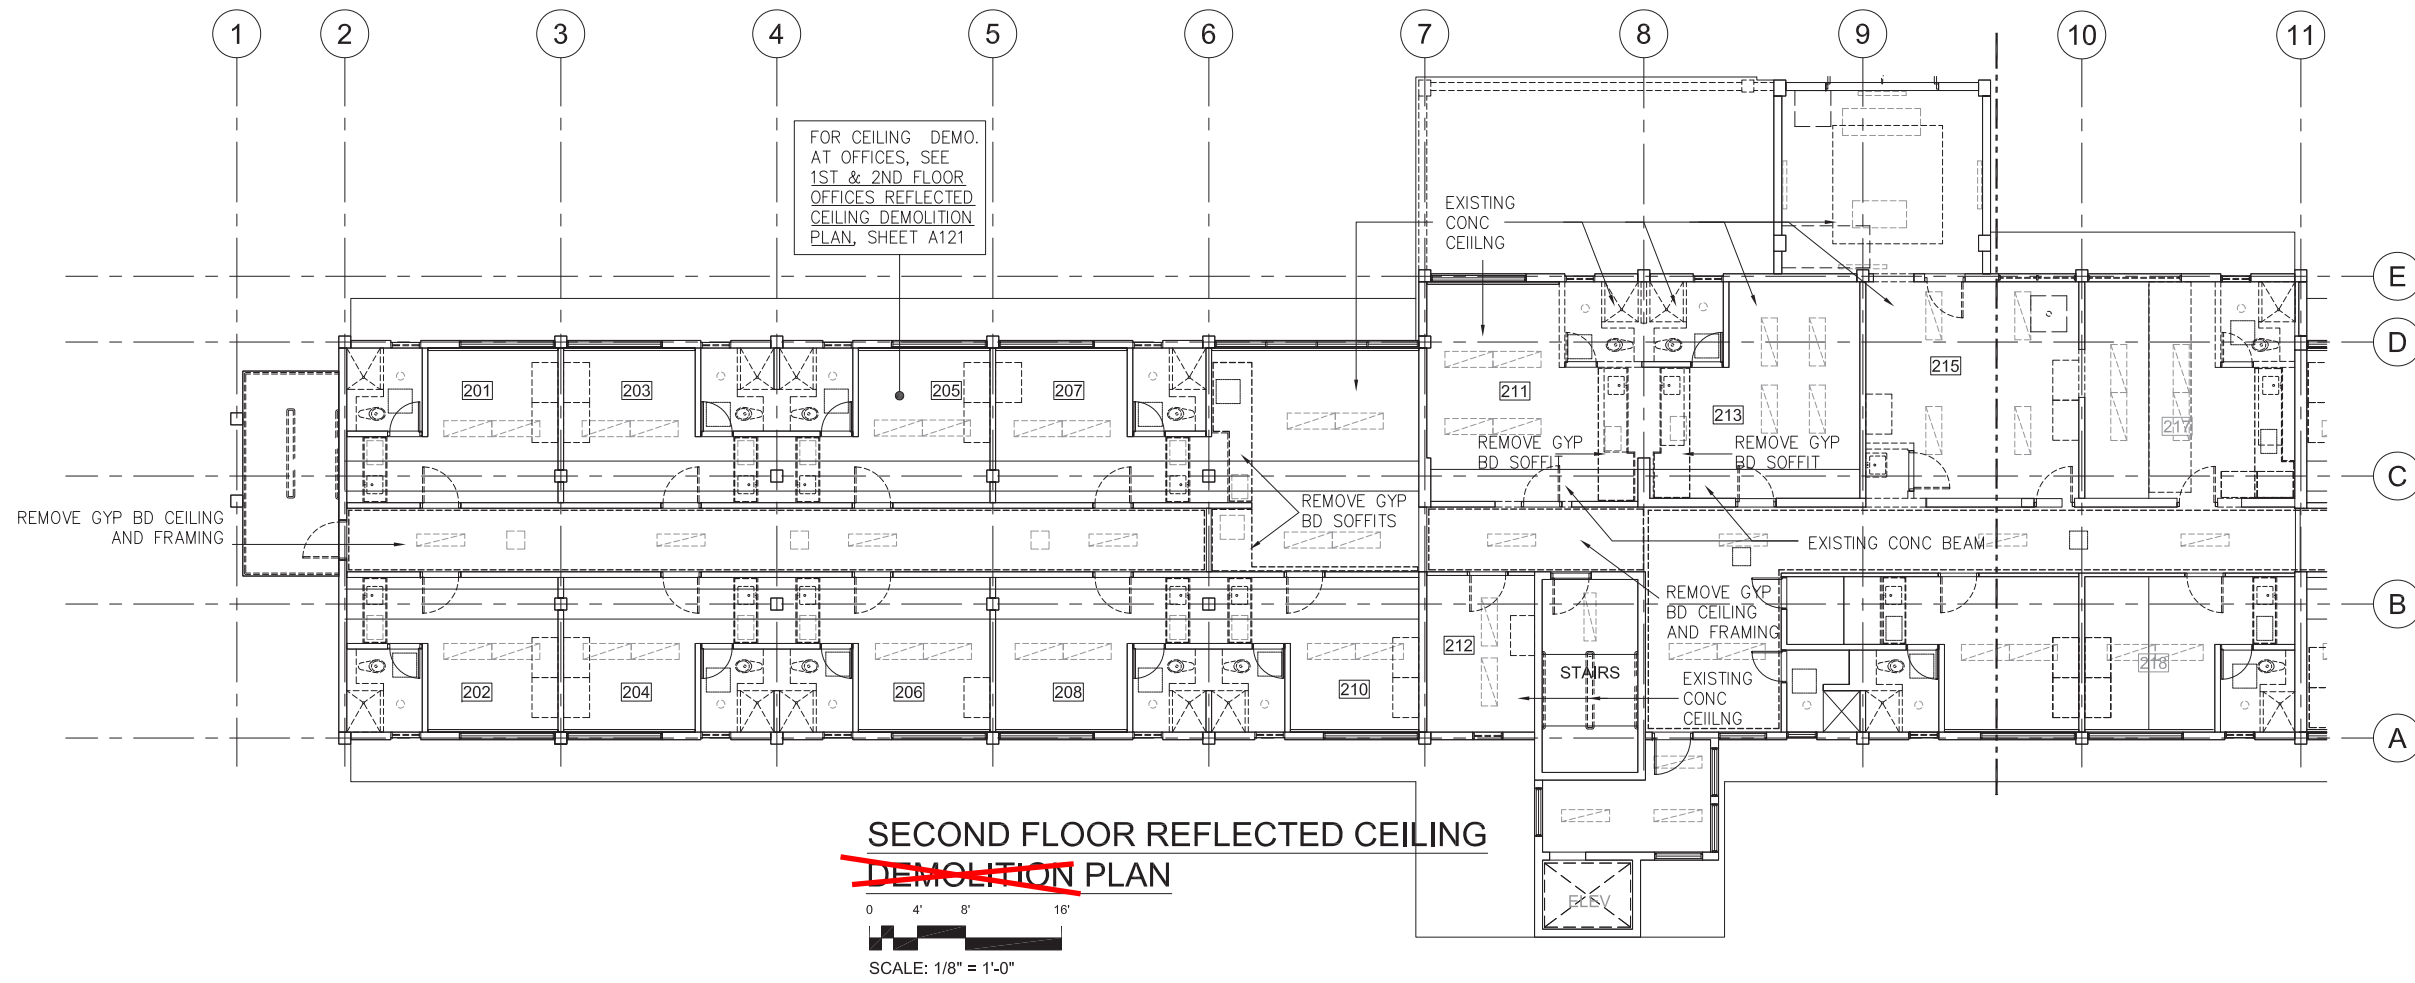


SECOND FLOOR REFLECTED CEILING  
~~DEMOLITION PLAN~~

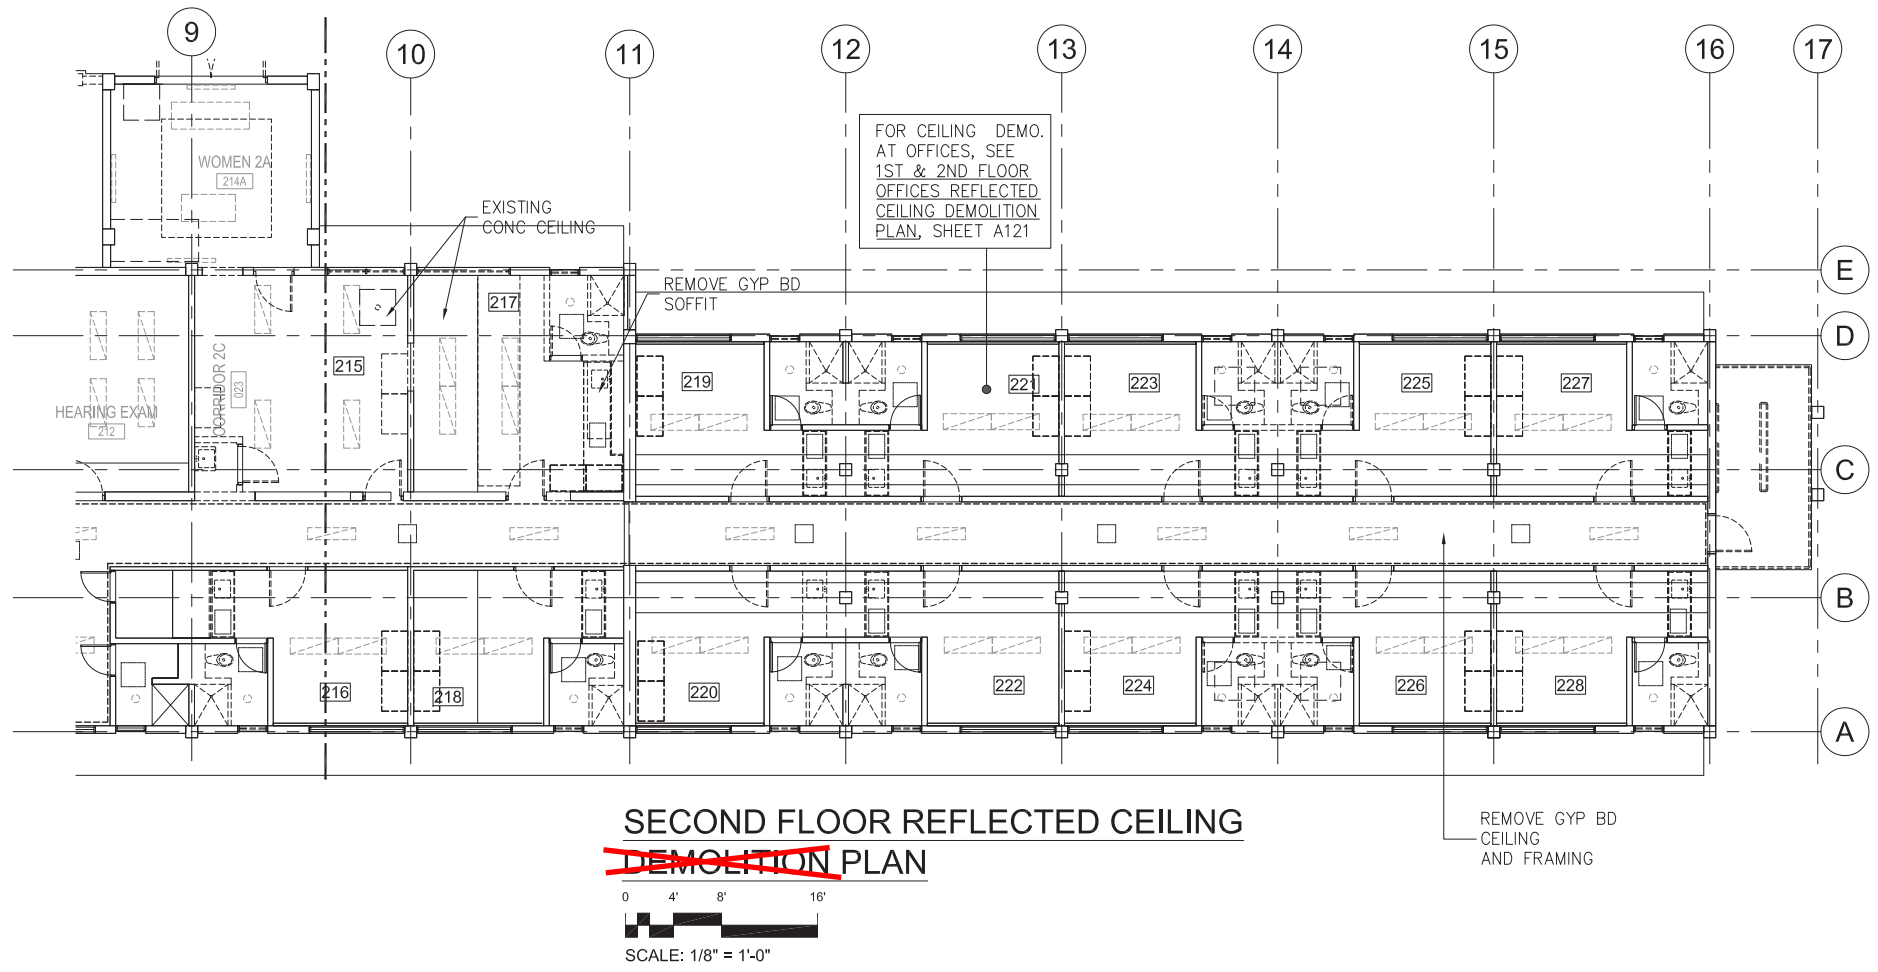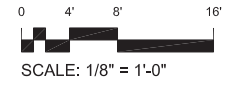

SECOND FLOOR REFLECTED CEILING  
~~DEMOLITION PLAN~~

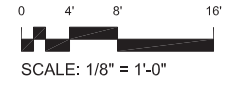

Drawings are for building reference only.

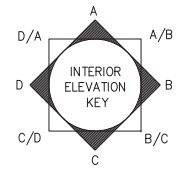


REV NO	DESCRIPTION	DATE
DEPARTMENT OF DEFENSE HAWAII ARMY NATIONAL GUARD STATE OF HAWAII  PN15110011 KALAELOA BUILDING 46 INTERIOR RENOVATIONS KALAELOA, KAPOLEI, OAHU, HAWAII  SECOND FLOOR REFLECTED CEILING DEMOLITION PLAN		
DESIGNED BY:	CHECKED BY:	HARRIS JOB NO.
DRAWN BY:	APPROVED BY:	DATE
SCALE: AS NOTED	10 APR 2015	OF SHTS

DRAWING NO.  
**A122**


SHEET

DATE ISSUED: ---




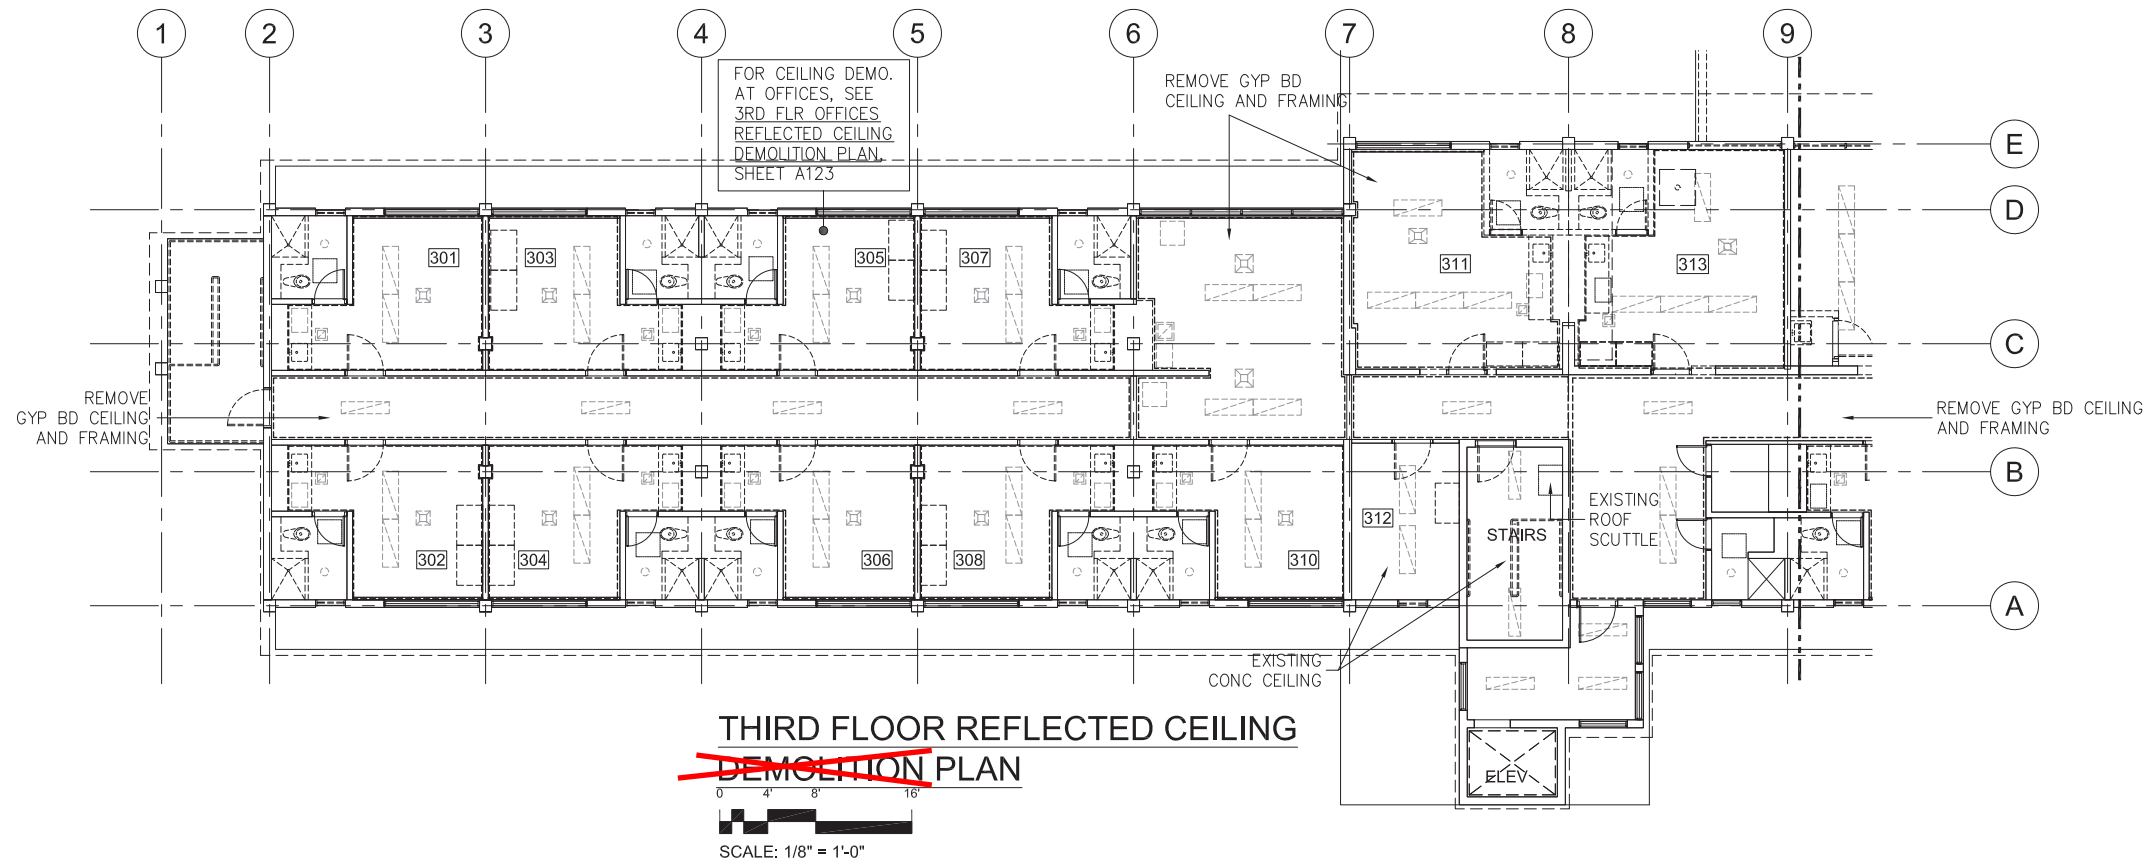

**THIRD FLOOR REFLECTED CEILING  
~~DEMOLITION PLAN~~**  
SCALE: 1/8" = 1'-0"

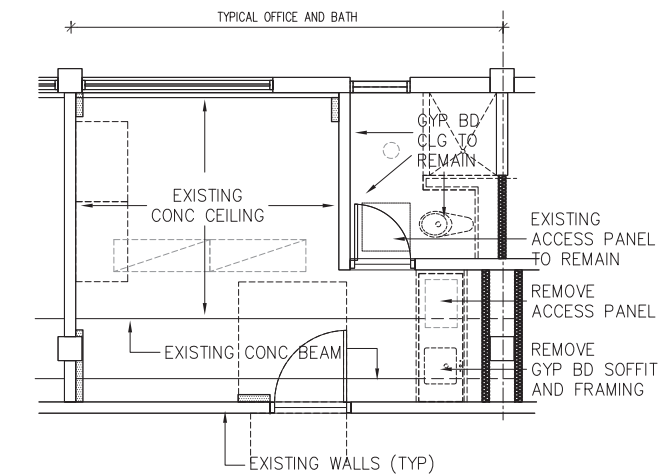


**3RD FLOOR OFFICES  
REFLECTED CEILING  
~~DEMOLITION PLAN~~**  
SCALE: 1/4" = 1'-0"

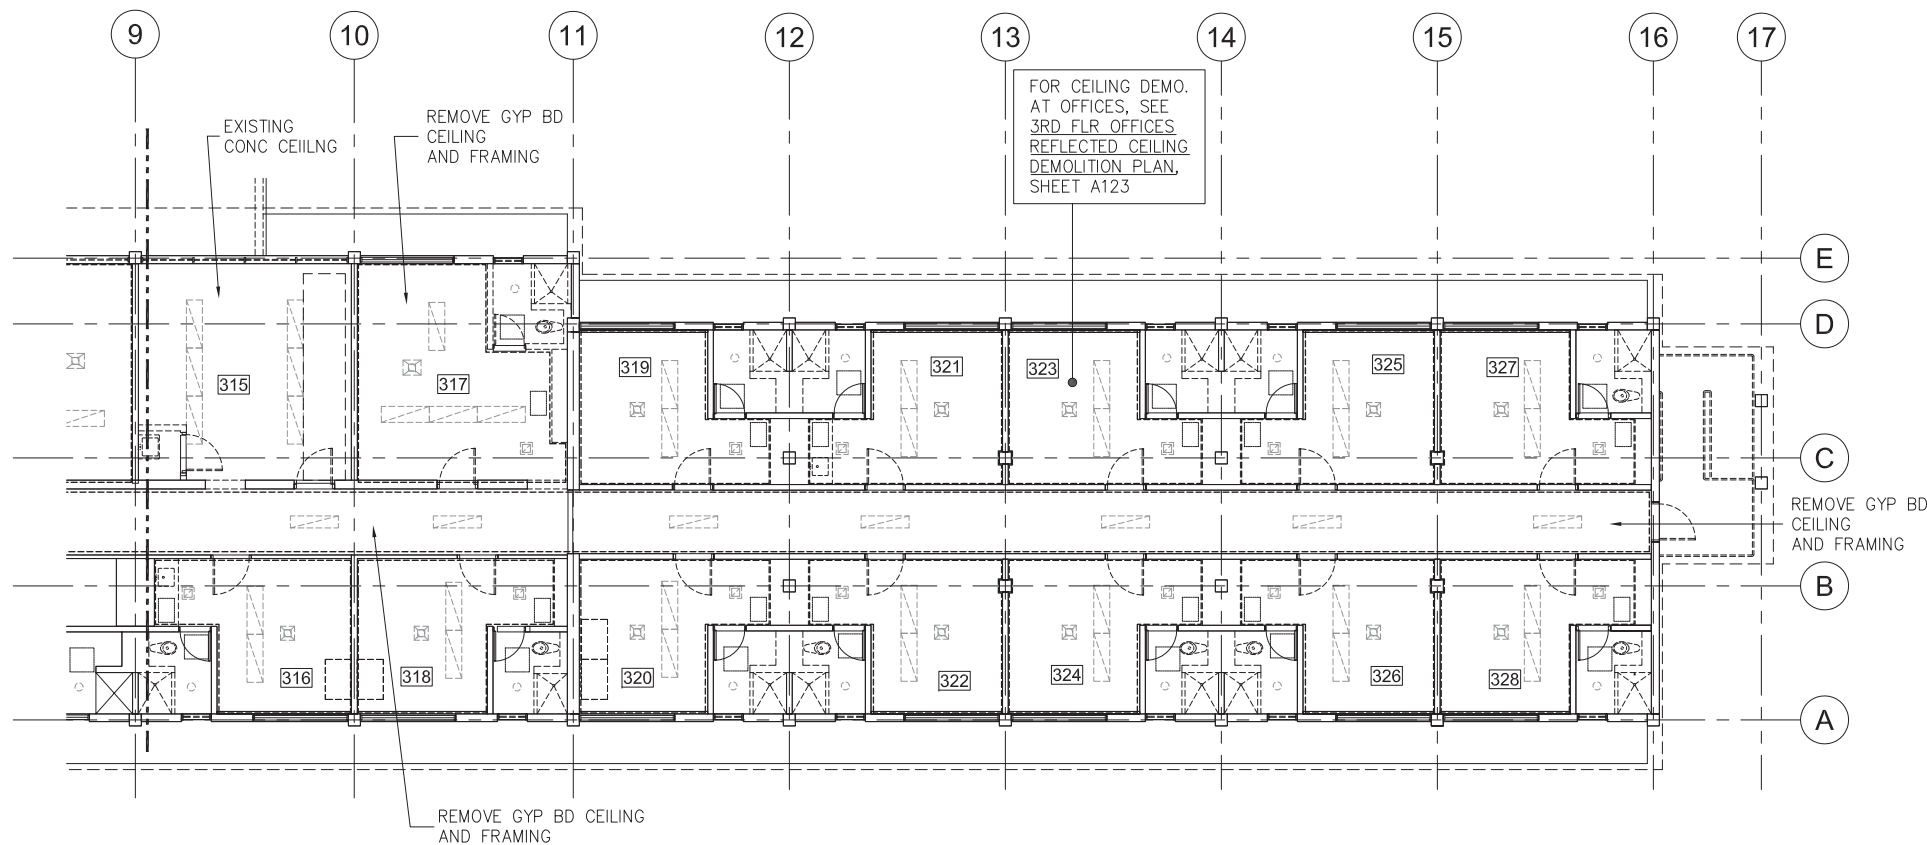

**THIRD FLOOR REFLECTED CEILING  
~~DEMOLITION PLAN~~**  
SCALE: 1/8" = 1'-0"



**Drawings are for  
building reference only.**

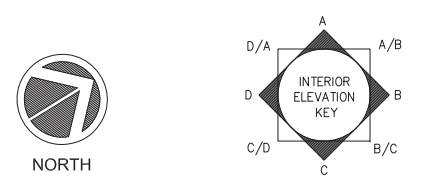

REV NO	DESCRIPTION	DATE



DEPARTMENT OF DEFENSE HAWAII ARMY NATIONAL GUARD STATE OF HAWAII			
PN15110011 KALAELOA BUILDING 46 INTERIOR RENOVATIONS KALAELOA, KAPOLEI, OAHU, HAWAII			
THIRD FLOOR REFLECTED CEILING DEMOLITION PLAN			
DESIGNED BY:	CHECKED BY:	HARRIG JOB NO.	DRAWING NO.
DRAWN BY:	APPROVED BY:	DATE	SHEET
SCALE: AS NOTED	10 APR 2015	OF	SHTS

DATE ISSUED: ---

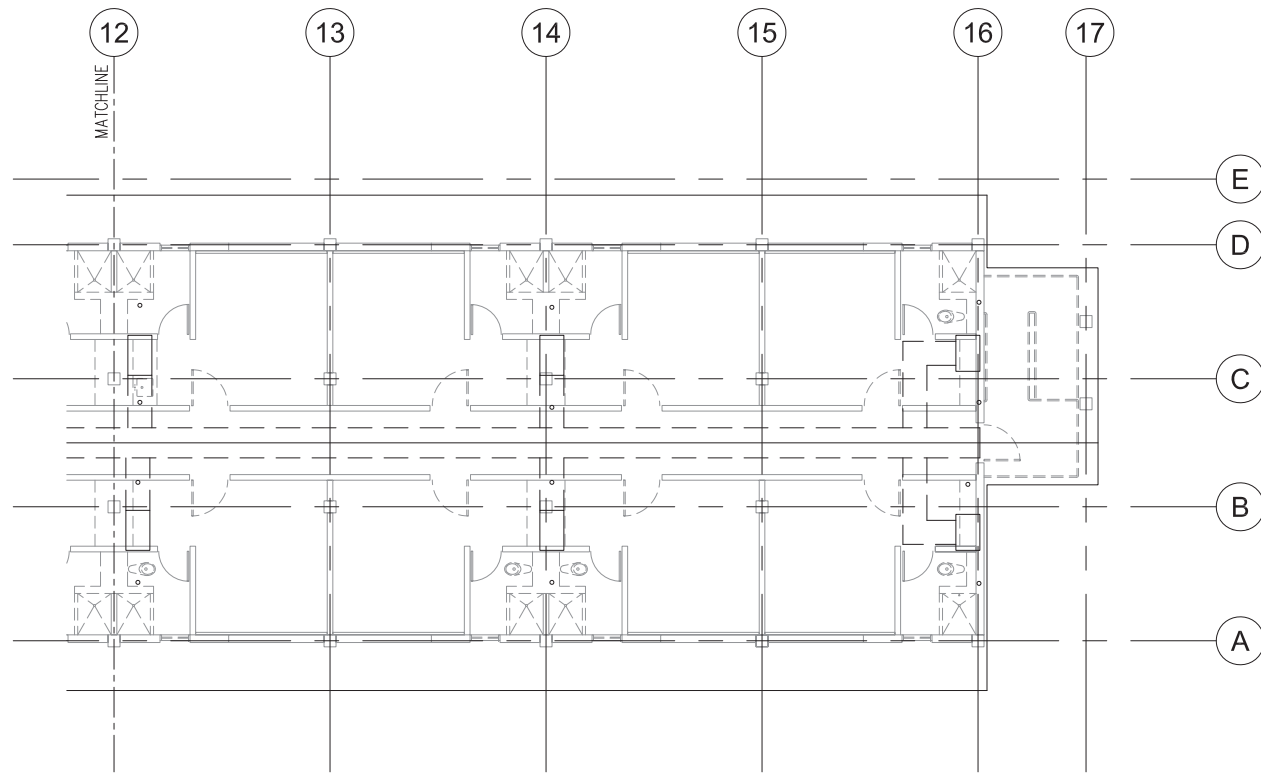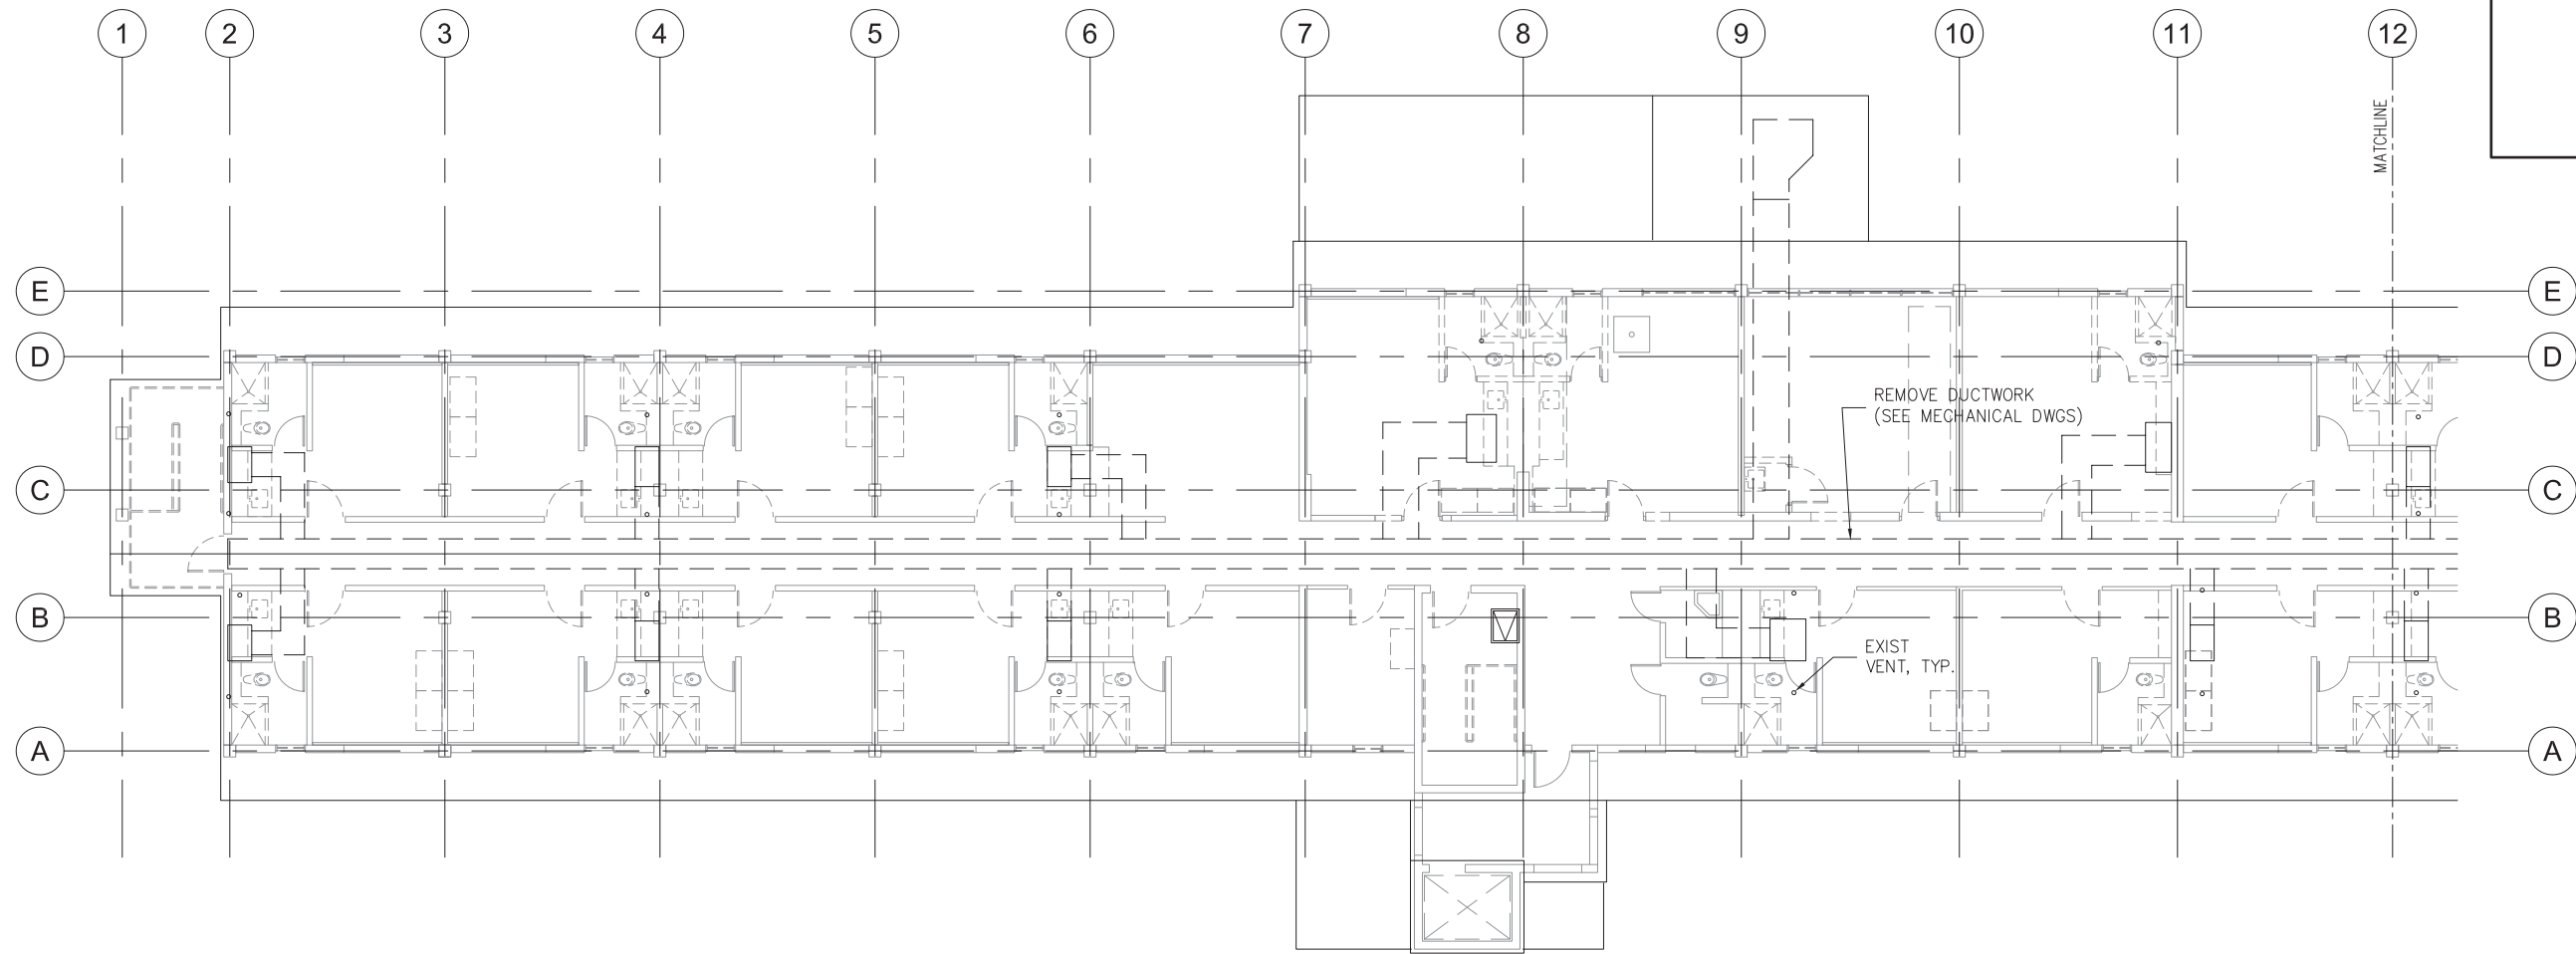

**Drawings are for building reference only.**

~~DEMOLITION~~  
**ROOF PLAN**

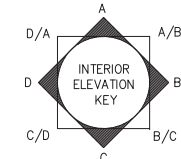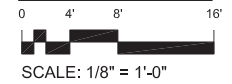



REV NO	DESCRIPTION	DATE

DEPARTMENT OF DEFENSE  
HAWAII ARMY NATIONAL GUARD  
STATE OF HAWAII

PN15110011  
KALAELOA BUILDING 46  
INTERIOR RENOVATIONS  
KALAELOA, KAPOLEI, OAHU, HAWAII



**DEMOLITION ROOF PLAN**

DESIGNED BY:	CHECKED BY:	HARRIS JOB NO.	DRAWING NO.
DRAWN BY:	APPROVED BY:	DATE	<b>A130</b>
SCALE: AS NOTED	10 APR 2015	OF	SHTS

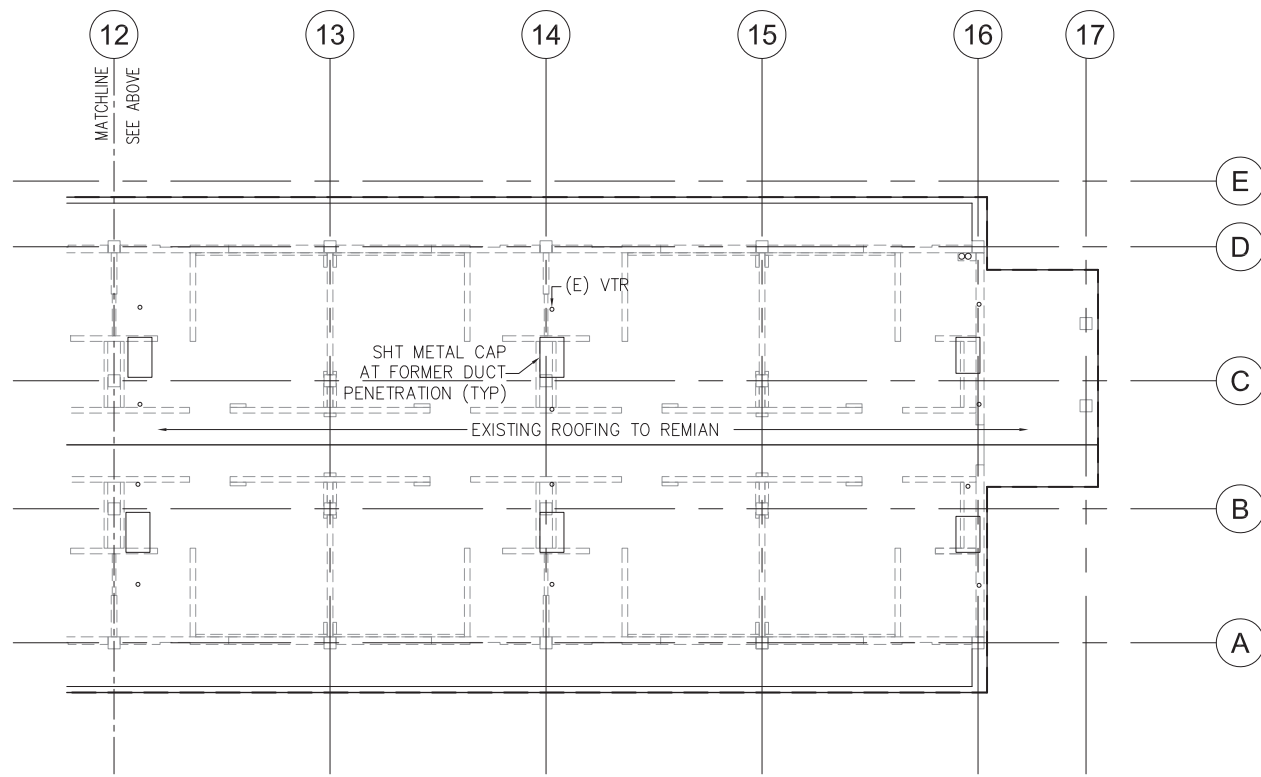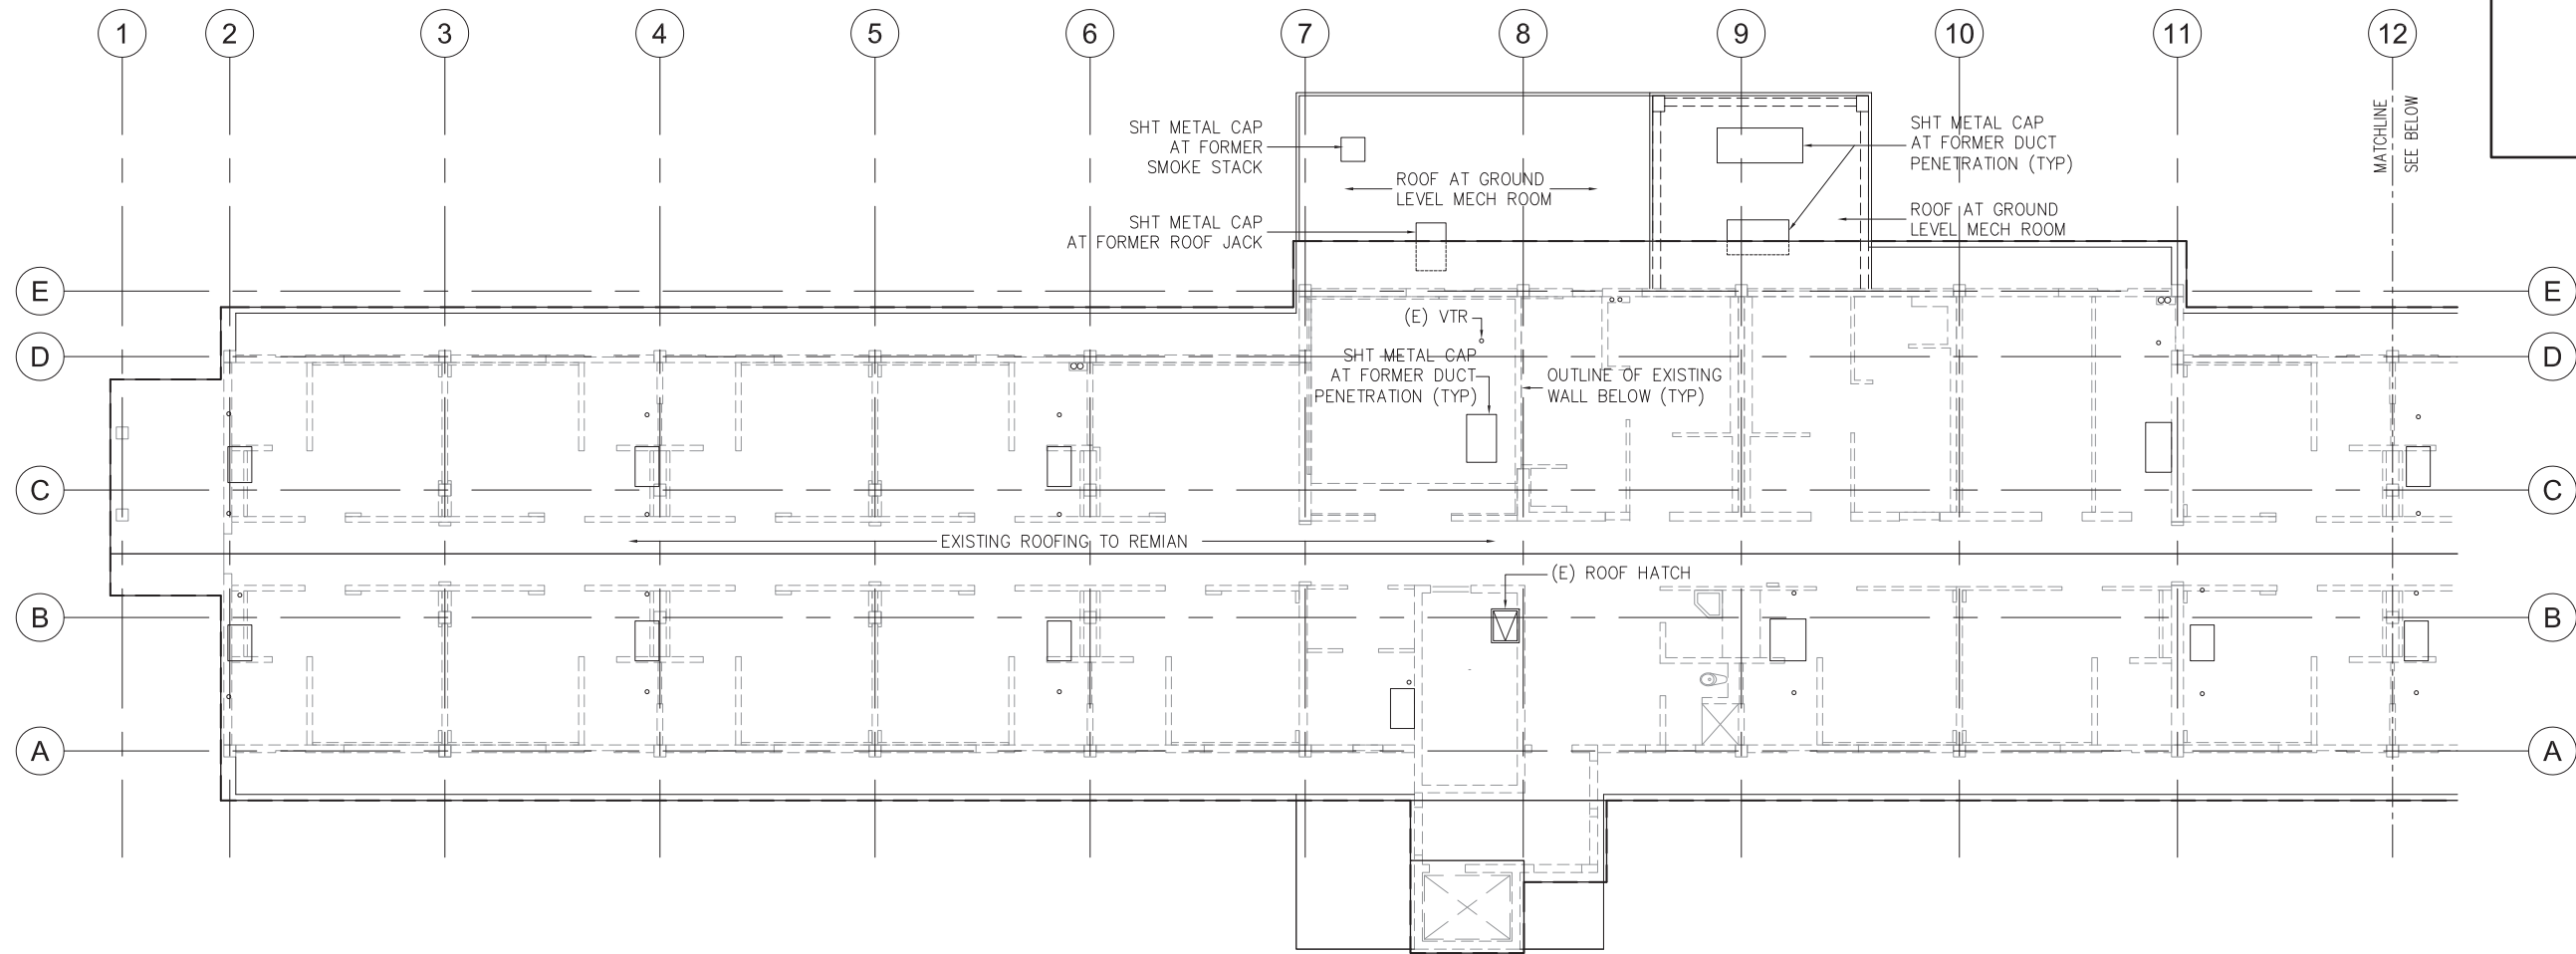

**Drawings are for building reference only.**

**ROOF PLAN**

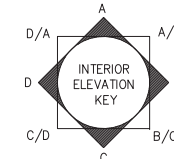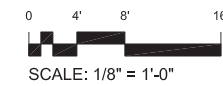

REV NO	DESCRIPTION	DATE
DEPARTMENT OF DEFENSE HAWAII ARMY NATIONAL GUARD STATE OF HAWAII		
PN15110011 KALAELOA BUILDING 46 INTERIOR RENOVATIONS KALAELOA, KAPOLEI, OAHU, HAWAII		
<b>ROOF PLAN</b>		
DESIGNED BY:	CHECKED BY:	HARRIS JOB NO.
DRAWN BY:	APPROVED BY:	DATE
SCALE: AS NOTED	10 APR 2015	DRAWING NO. <b>A230</b>
		SHEET
		OF SHTS