



4 REAR ELEVATION - UEPH 46 & 48
SCALE 1/16" = 1'-0"

3 FRONT ELEVATION - UEPH 46 & 48
SCALE 1/16" = 1'-0"

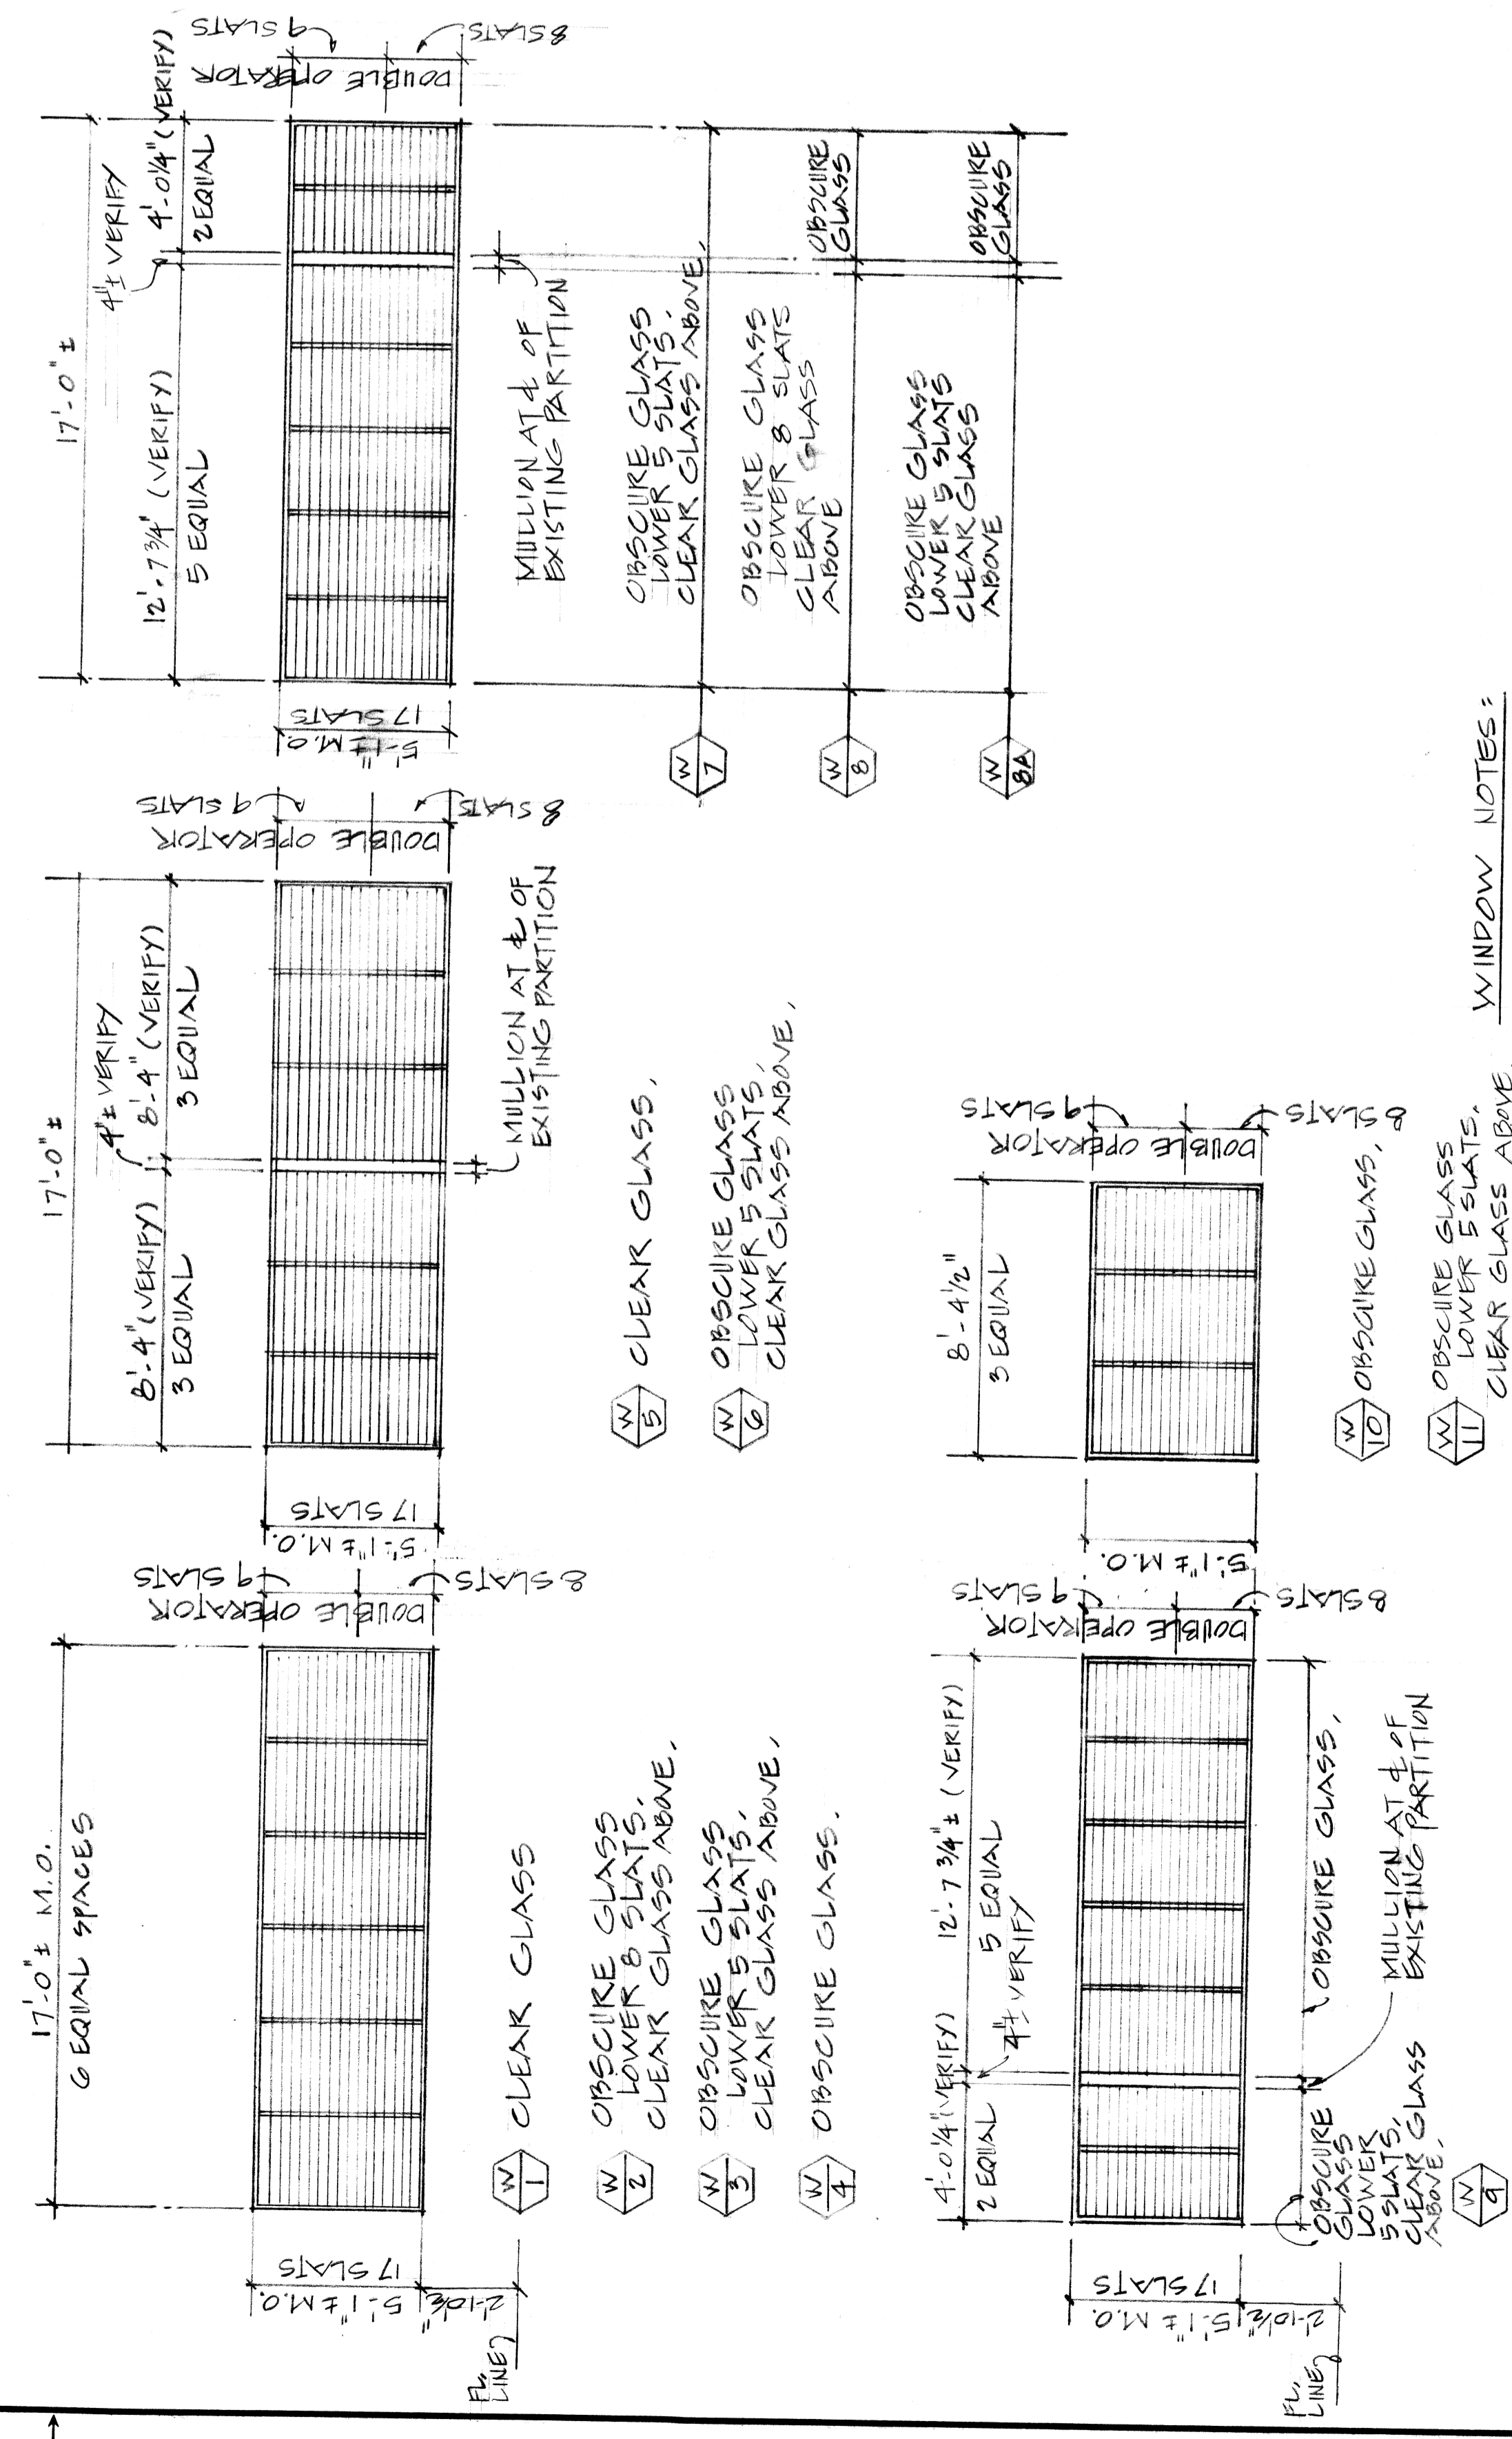

1 WINDOW TYPES, UEPH 46 & 48
SCALE 1/4" = 1'-0"

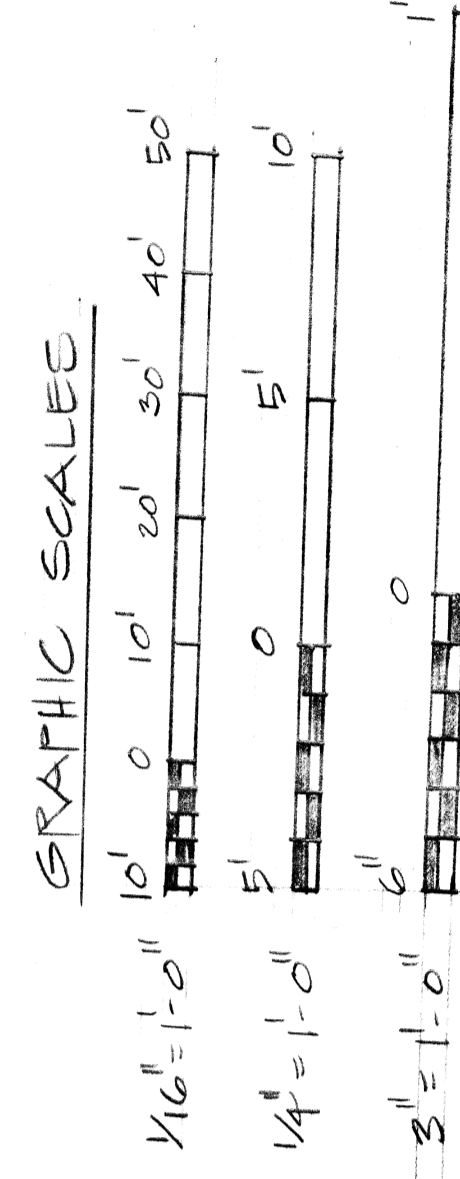

SCHEDULE OF DRAWINGS



SHEET NO.	NAVFAC NO.	DESCRIPTION
A-1	7033006	EXTERIOR ELEVATIONS, WINDOW TYPES & DETAILS
A-2	7033006	FLOOR PLANS
A-3	7033007	EXTERIOR ELEVATIONS, WINDOW TYPES & DETAILS
A-4	7033008	FLOOR PLANS

SYMBOLS

Symbol for window types.

2. NUMBER INDICATES DETAIL OR ELEVATION SHEET NUMBER WHERE DRAWN.

2. NUMBER INDICATES ELEVATION SHEET NUMBER WHERE DRAWN.

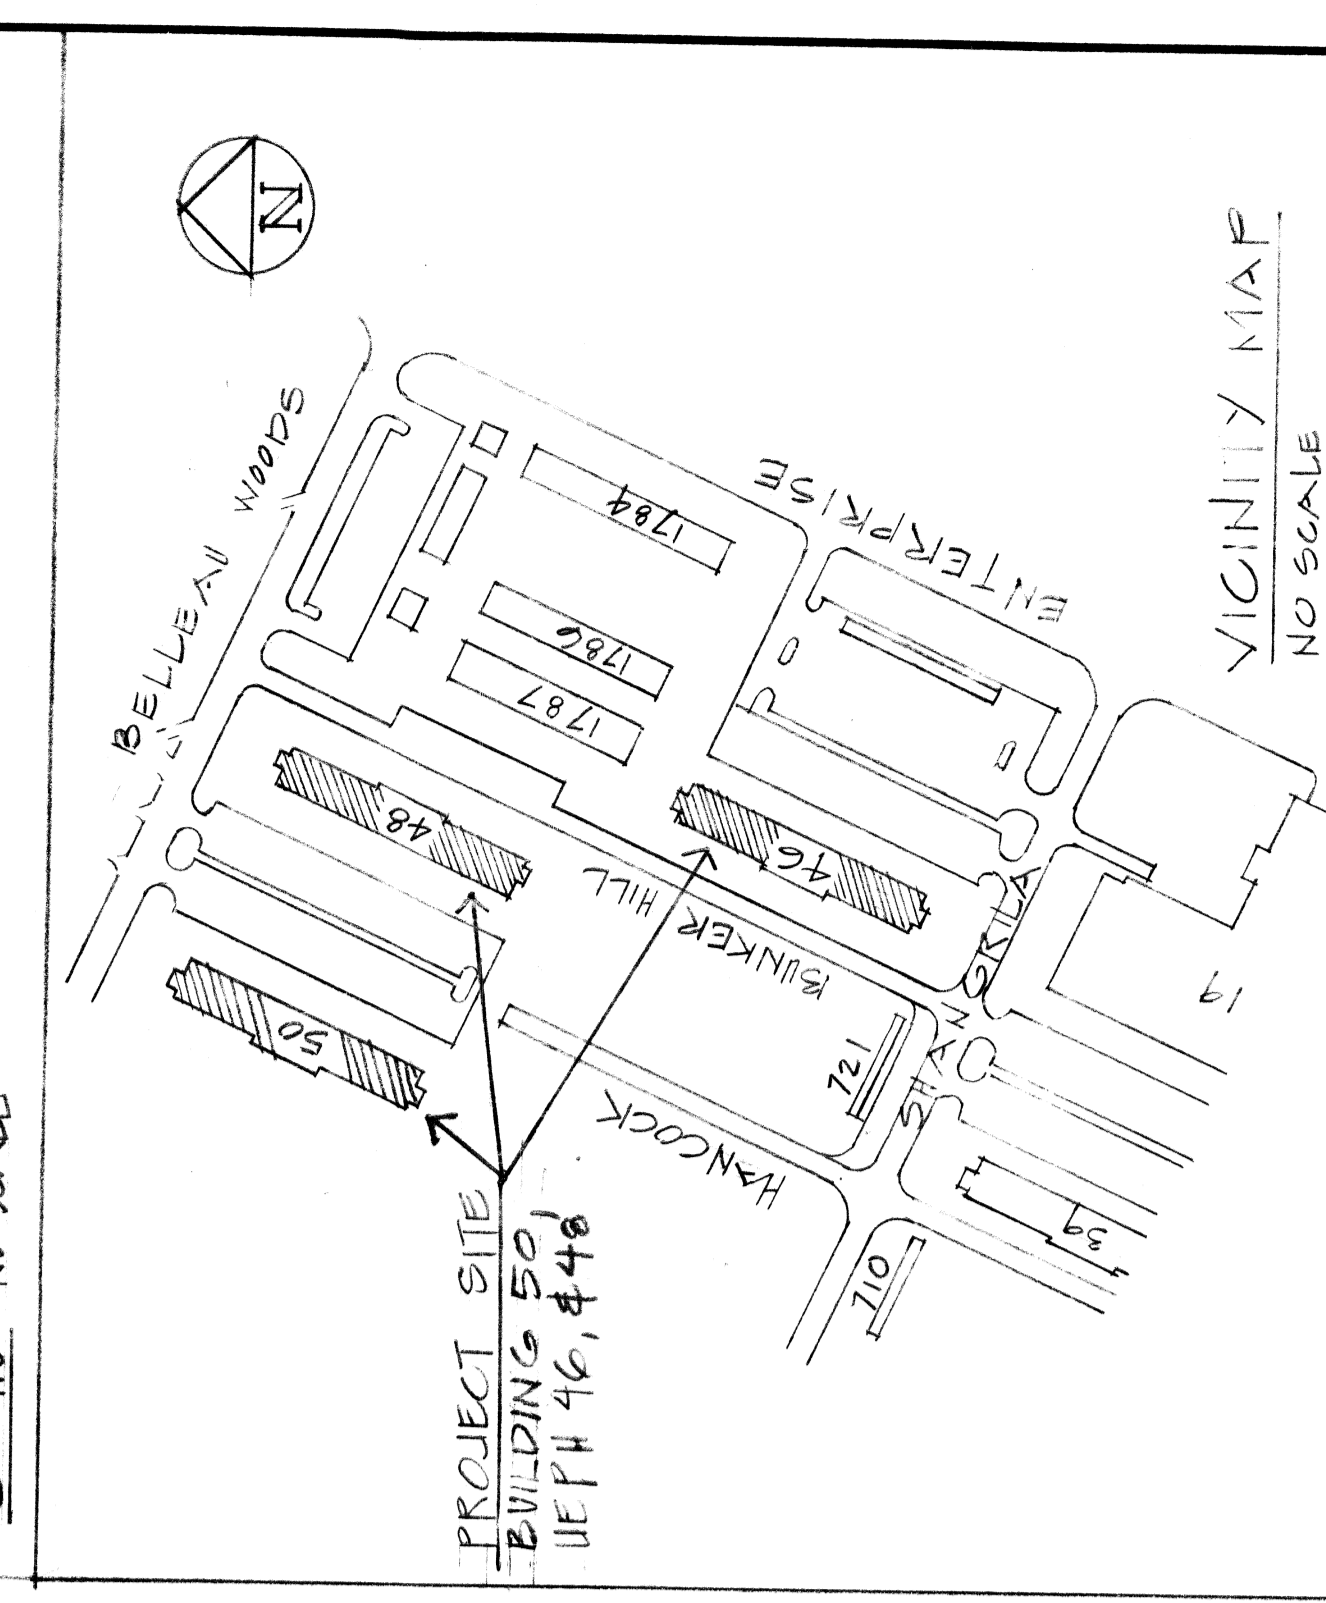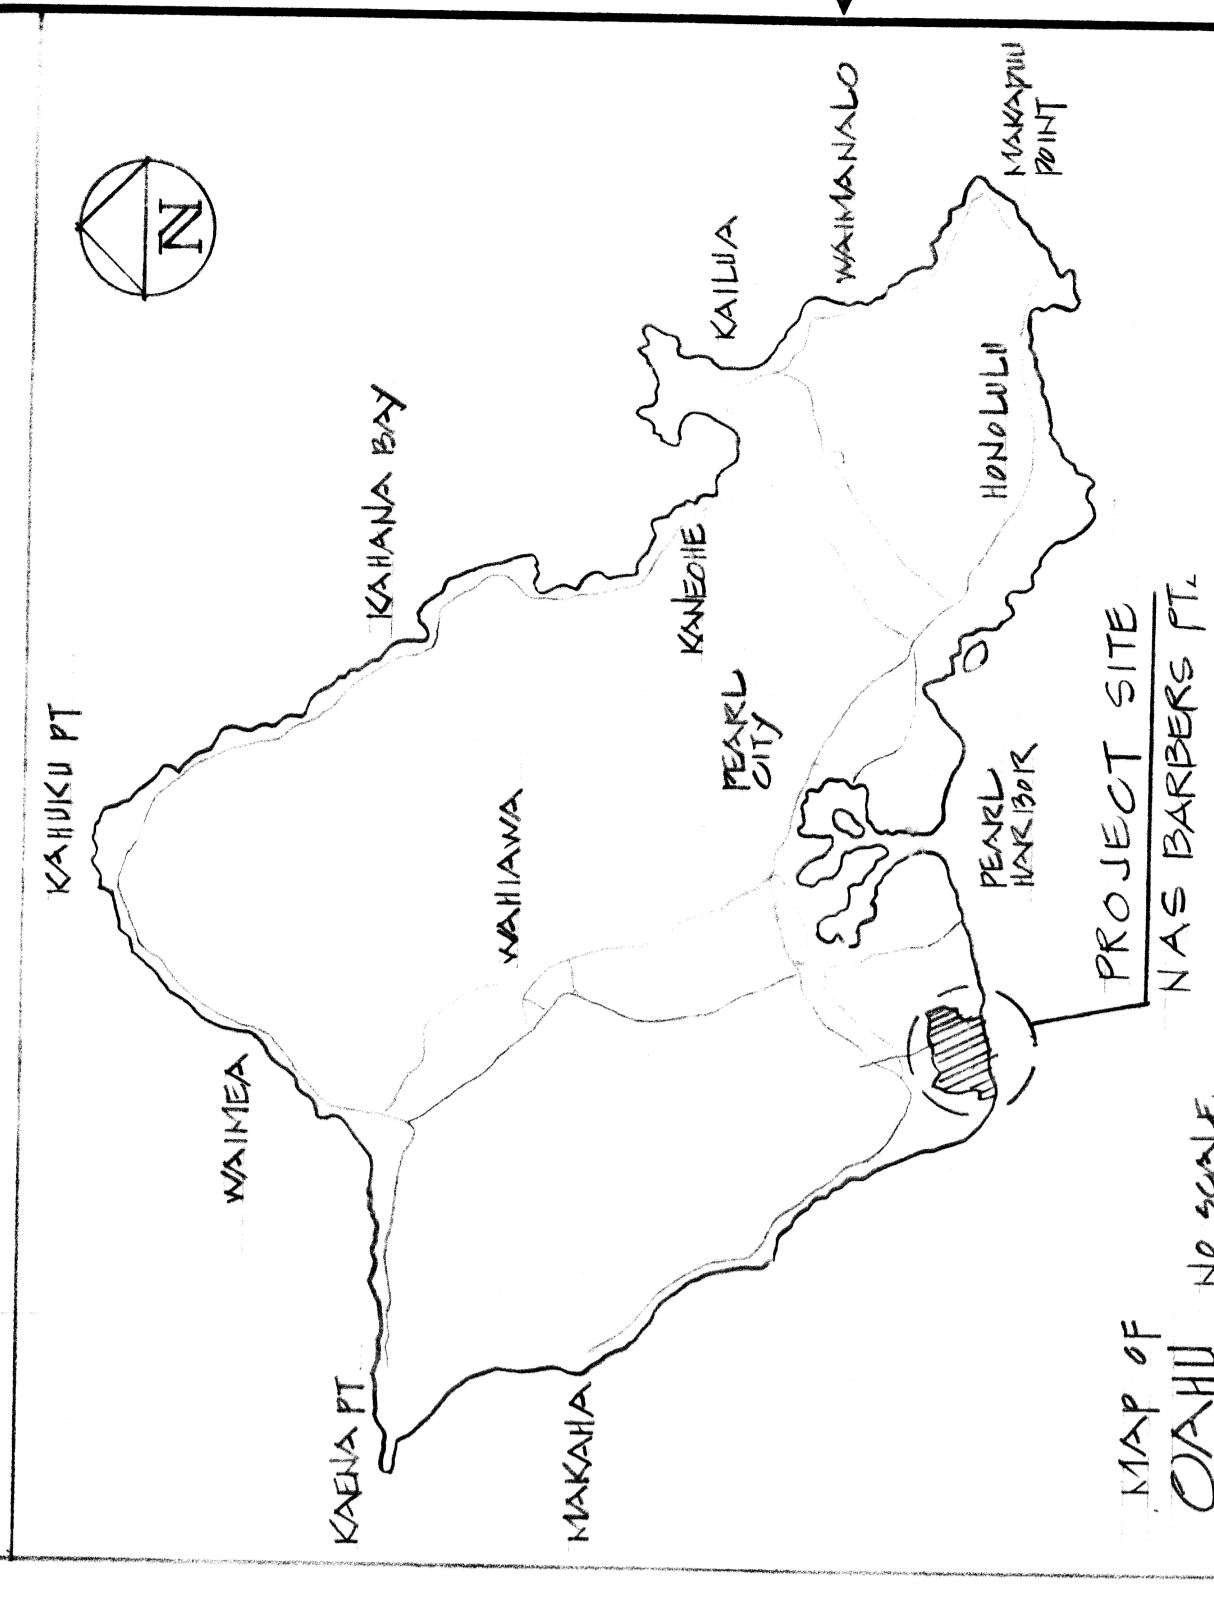

RECORD DRAWING

DATE: 5 FEB 1983

IF SHEET IS LESS THAN 24" x 40" SCALE REDUCED ACCORDINGLY

DEPARTMENT OF THE NAVY
NAVAL FACILITIES ENGINEERING COMMAND
PACIFIC DIVISION
HONOLULU, HAWAII 44812

PROJECT TITLE: NAVAL AIR STATION BARBERS POINT, OAHU, HAWAII
BLDG. 50 & UEPH 46 & 48
EXTERIOR ELEVATIONS, WINDOW TYPES & DETAILS

BLDG. 50 UEPH 46 & 48

CONTRACT NO. N471-80-01510

CONTRACTOR: [Name]

DATE: [Date]


SCALE: [Scale]

NO. OF SHEETS: [Number]

NO. OF PAGES: [Number]

NO. OF DRAWINGS: [Number]

NO. OF REVISIONS: [Number]

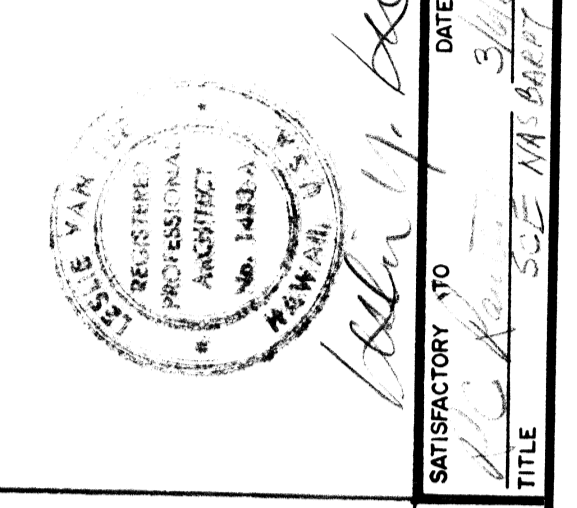

APPROVED: [Signature]

DATE: [Date]

TITLE: [Title]

2 JALOUSIE WINDOW DETAIL
SCALE 3/16" = 1'-0"