REVISIONS			
LTR	DESCRIPTION	DATE	APPROVED
MVC	AS BUILT	8 FEB 1983	MK

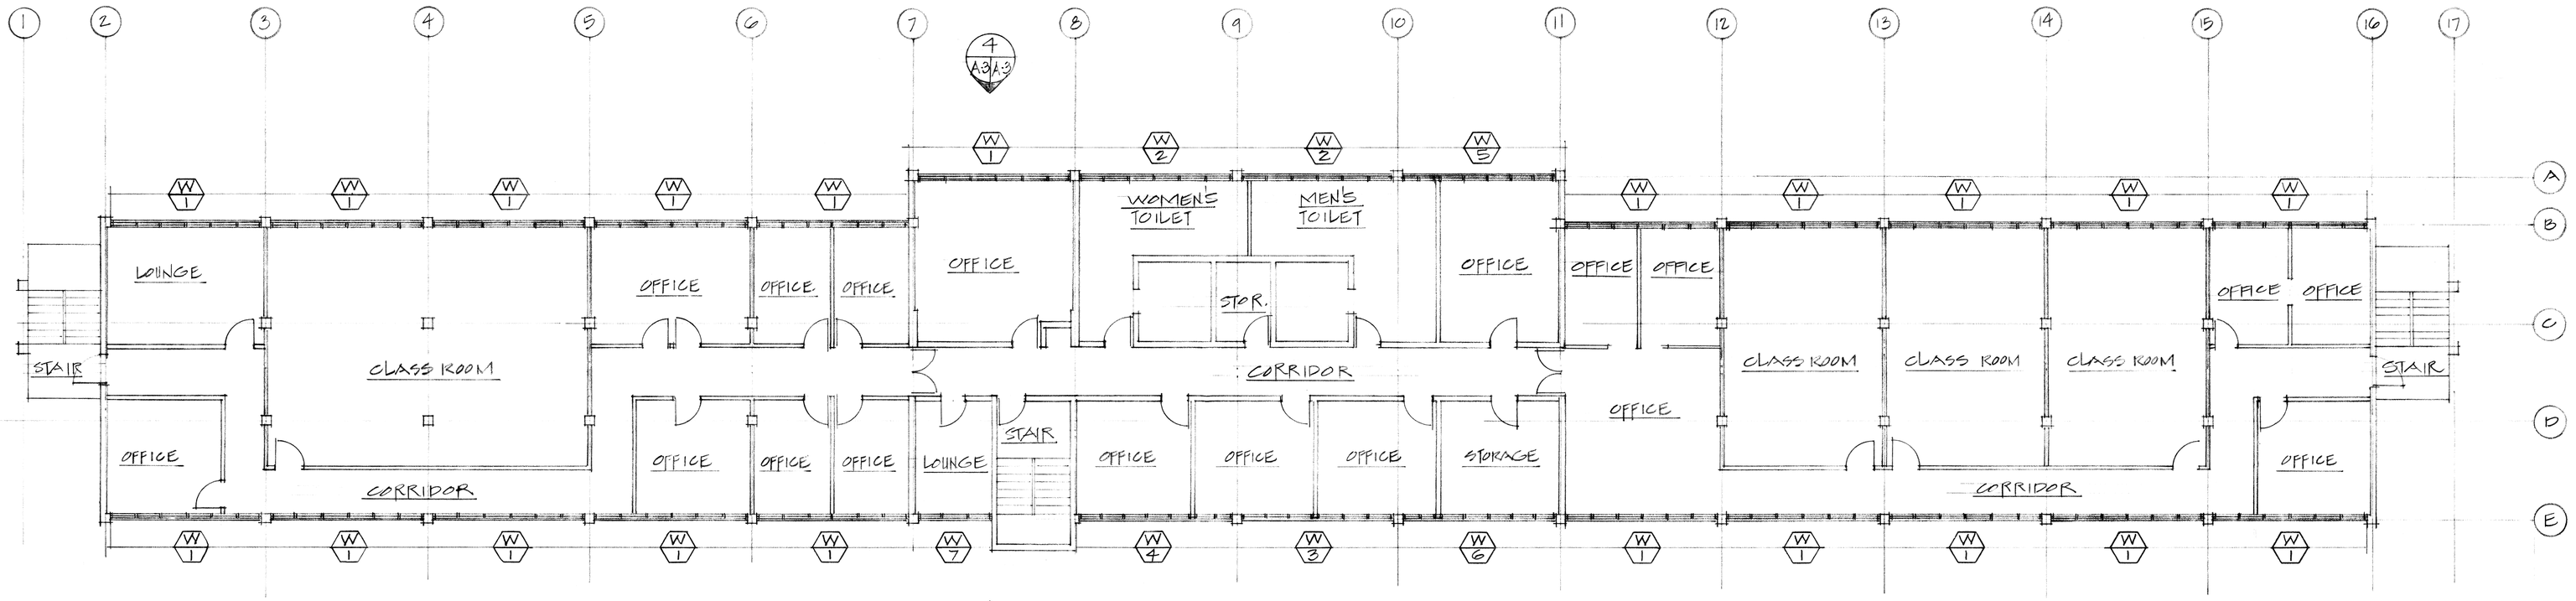

2 A4/A4 THIRD FLOOR PLAN - BLDG 50
SCALE 1/8" = 1'-0"

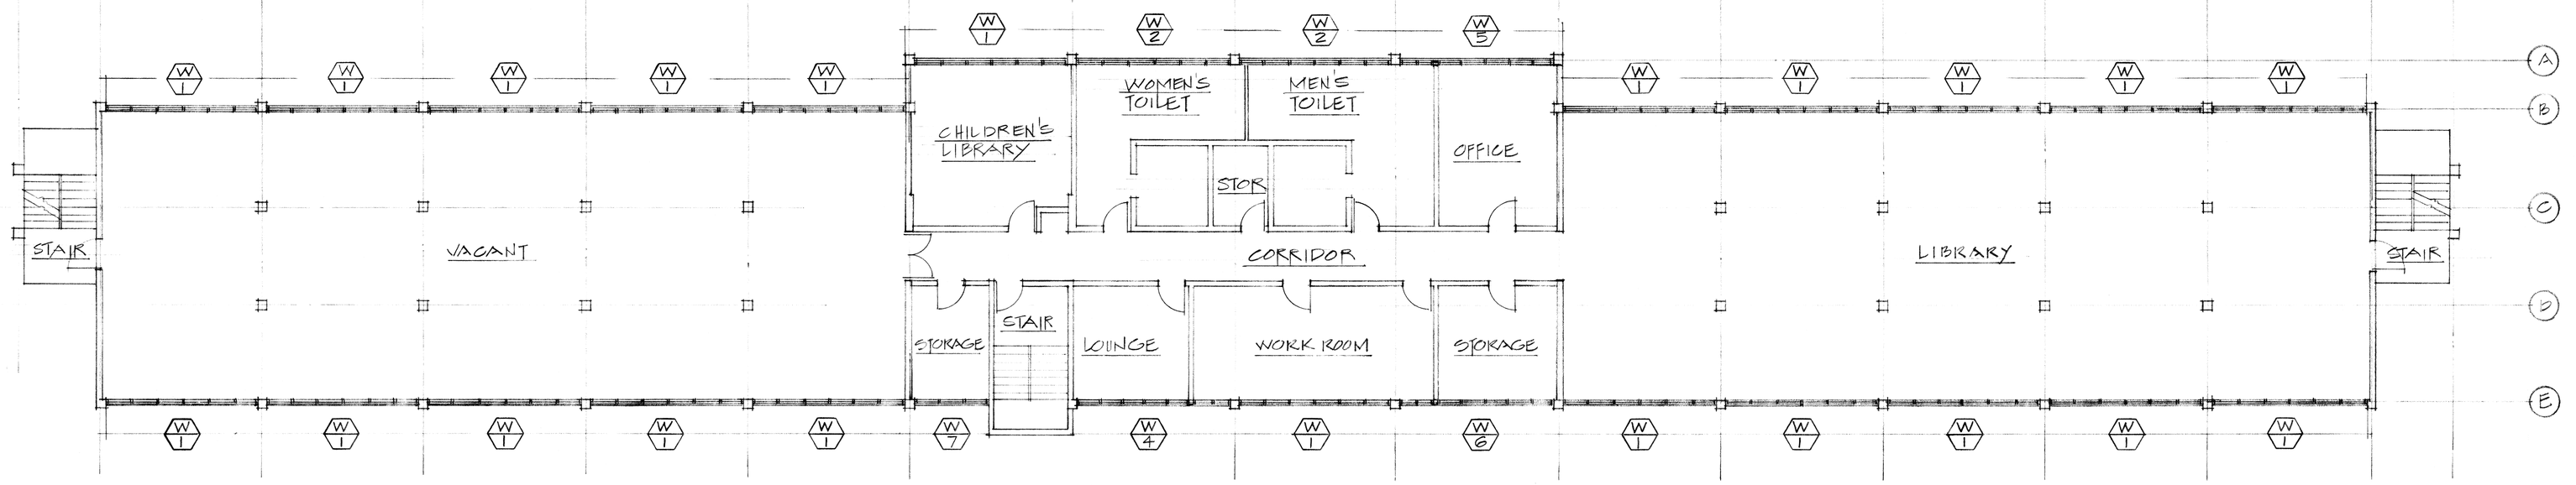

1 A4/A4 SECOND FLOOR PLAN - BLDG 50
SCALE 1/8" = 1'-0"

GENERAL NOTES:
REMOVE EXISTING AWNING WINDOWS AT THE SECOND AND THIRD FLOOR, AND REPLACE WITH NEW JALOUSIE WINDOWS.

GRAPHIC SCALE
1/8" = 1'-0"
5' 0 5' 10' 15' 20' 25'

The Contractor will be responsible for coordinating the work among the various trades as necessary to avoid conflicts and to insure the installation of all work within the available space.

RECORD DRAWING
DATE 8 FEB 1983

IF SHEET IS LESS THAN 28" x 40" IT IS A REDUCED PRINT – SCALE REDUCED ACCORDINGLY

LMLI ARCHITECTS/PLANNERS, INC.
SUITE 208-A, 505 BETHANIA ST.
HONOLULU, HAWAII 96813
DES L.L. DR H.O. CHK L.L.
SUPV CH ENG
SUBMITTED BY LESLIE LEE 17 MARCH 81
FIRM MEMBER (TITLE)
PACDIV REC: RVD BR MGR
OPPE PDE INSP
DIR CC
APPROVED APR 1981 DATE
FOR COMMANDER NAVFAC

DEPARTMENT OF THE NAVY NAVAL FACILITIES ENGINEERING COMMAND
PACIFIC DIVISION
MAKALAPA, HAWAII

NAVAL AIR STATION, BARBERS POINT, OAHU, HAWAII
REPLACE WINDOWS, BLDG 50 & UEPH 46 & 48
FLOOR PLANS

SIZE F | CODE IDENT NO 80091 | NAVFAC DRAWING NO 7033008
CONSTR CONTR NO N62471-80-C-1510
SCALE AS NOTED | SPEC NO. 14-80-1510 | SHEET 4 OF 4

A-4

SATISFACTORY TO DATE
TITLE

7033008
UEPH BLDG 46 & 48
BLDG. 50

14ND-PACDIV 4-4851/3 (4-77)