OUTLINE OF HANGAR ROOF ABOVE

100′-4″

101′-4″

100′-4″

SHEET M-3 | SHEET M-4

SHEET M-4 | SHEET M-5

REFER TO SHEET M-3 FOR DETAILS

REFER TO SHEET M-4 FOR DETAILS

REFER TO SHEET M-5 FOR DETAILS

1121

OUTLINE OF HANGAR ROOF ABOVE

558′-6″

SHEET M-3 | SHEET M-4

SHEET M-4 | SHEET M-5

1 / M-1 OVERALL 1ST FLOOR A/C PLAN

SCALE: 1" = 20' - 0"

1"=20'-0" 10' 0 20' 40'

100% SUBMITTAL

CONFIDENTIALITY CLAUSE

THIS DESIGN IS BASED ON ECONOMY PLUMBING AND SHEETMETAL'S DESIGN COMCEPT AND SHALL NOT BE SHARED WITH ANY THIRD PARTY.

BUILDING 282 HIARNG FACILITIES KALEALOA INSTALLATION OF ENERGY EFFICIENT DUCTLESS SPLIT AIR CONDITIONING SYSTEM

KAPOLEI, OAHU, HAWAII

CONTRACT NO.:	TASK ORDER NO.:
SCALE AS NOTED	APPROVED BY
DRAWN BY MC	
DATE 6/22/2012	Job No. CA-1216

OVERALL 1ST FLOOR A/C PLAN

ECONOMY PLUMBING & SHEETMETAL, Inc.
1029 ULUPONO STREET (SAND ISLAND)
HONOLULU, HAWAII 96819

DRAWING NUMBER M-1

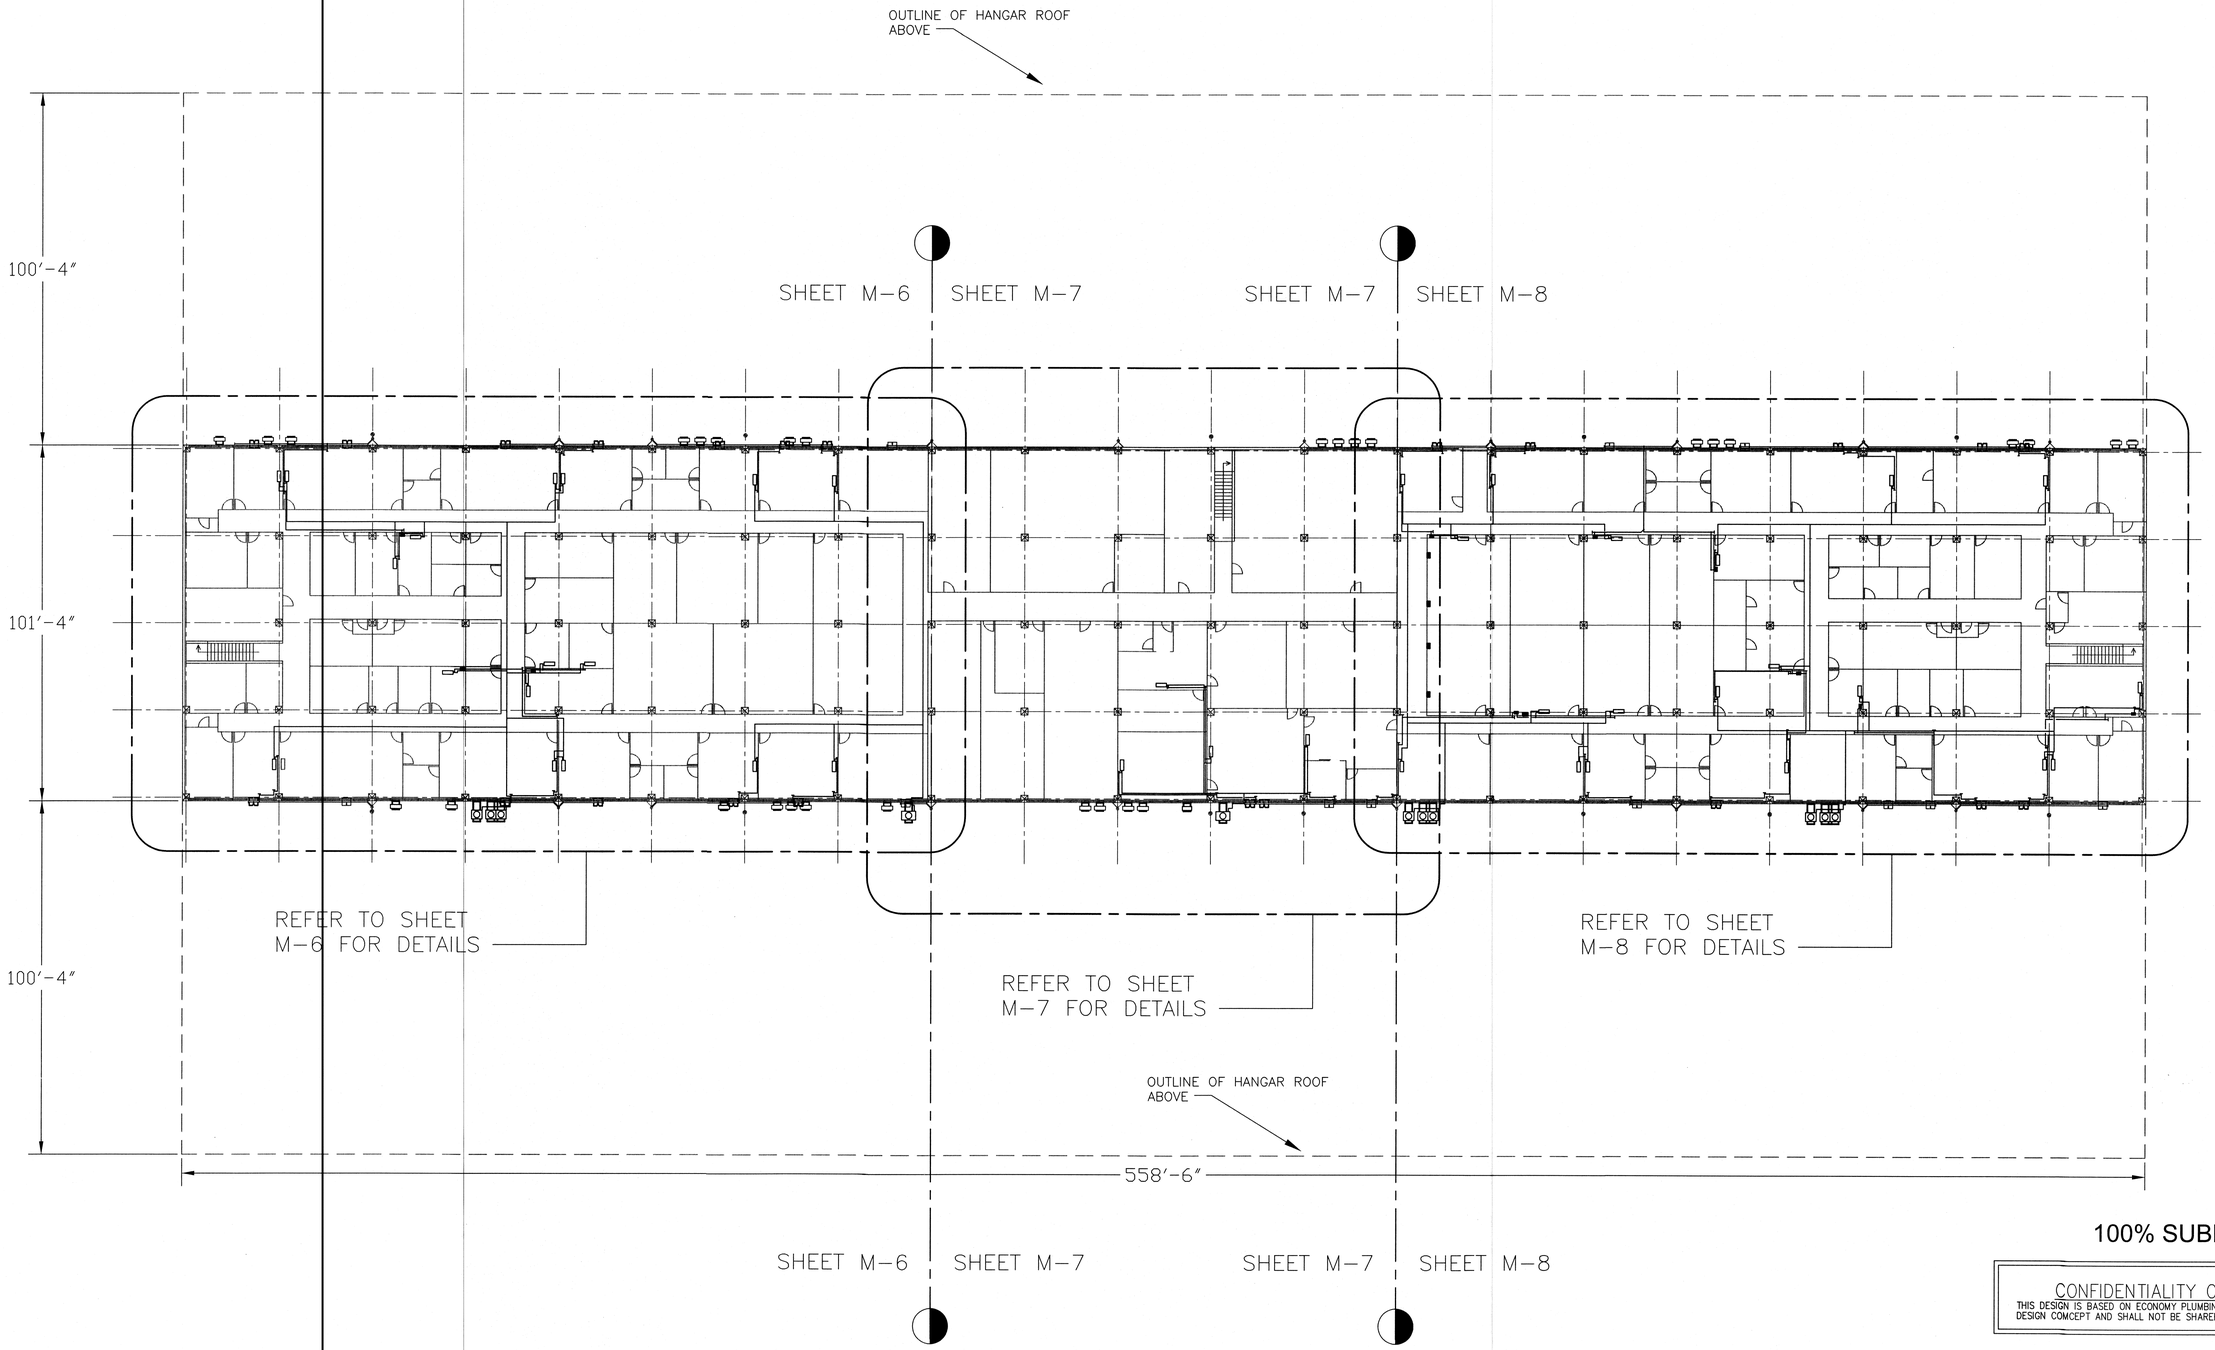

1 / M-2 OVERALL 2ND FLOOR A/C PLAN

SCALE: 1" = 20' - 0"

1"=20'-0" 10' 0 20' 40'

100% SUBMITTAL

CONFIDENTIALITY CLAUSE

THIS DESIGN IS BASED ON ECONOMY PLUMBING AND SHEETMETAL'S DESIGN CONCEPT AND SHALL NOT BE SHARED WITH ANY THIRD PARTY.

BUILDING 282 HIARNG FACILITIES KALEALOA
INSTALLATION OF ENERGY EFFICIENT DUCTLESS SPLIT AIR CONDITIONING SYSTEM
KAPOLEI, OAHU, HAWAII

CONTRACT NO.:	TASK ORDER NO.:	
SCALE AS NOTED	APPROVED BY	DRAWN BY MC
DATE 6/22/2012		Job No. CA-1216

OVERALL 2ND FLOOR A/C PLAN

ECONOMY PLUMBING & SHEETMETAL, Inc.
1029 ULUPONO STREET (SAND ISLAND)
HONOLULU, HAWAII 96819

DRAWING NUMBER M-2

(E)WALL-MOUNTED ACCU TO REMAIN (TYP)

(E)WALL-MOUNTED ACCU TO REMAIN (TYP)

(E)WALL-MOUNTED ACCU TO REMAIN (TYP)

SHEET M-3 FOR CONTINUATION REFER TO SHEET M-4

1000 2000 1001 2000 1022 1025 1031 1033 1021 1030

1002 1014 1020 1026 1032 1041

1016 1019

UP

1004 1008 1007 1018 1027 2000 1033 1036 1042

1005 1006 1030

1003 1015 1010 1017 1029 1034 1043

1011 1028 1035

NEW WALL-MOUNTED DUCTLESS FAN COIL UNIT (TYPICAL)

CP 1 FCU 1-1 CP 1 FCU 1-2

ACCU 1-1 ACCU 1-2

(E)WALL-MOUNTED ACCU TO REMAIN

(E)WALL-MOUNTED ACCU TO REMAIN (TYP)

(E)WALL-MOUNTED ACCU TO REMAIN

NEW ~~DUAL CIRCUIT~~ AIR-COOLED INVERTER-DRIVEN CONDENSING UNIT ~~MOUNTED ON NEW WALL SUPPORT~~

NEW ~~DUAL CIRCUIT~~ AIR-COOLED INVERTER-DRIVEN CONDENSING UNIT MOUNTED ~~ON NEW WALL SUPPORT~~

1010

SHEET M-3 FOR CONTINUATION REFER TO SHEET M-4

1 / M-3 PARTIAL 1ST FLOOR A/C PLAN

SCALE: 1/8" = 1' - 0"

POINT OF CONNECTION (NEW TO EXISTING)

1 ADD 1/2" TREATED PLYWOOD PER DETAIL 2/M-9.

1/8"=1'-0" 4' 0 10' 20'

100% SUBMITTAL

BUILDING 282 HIARNG FACILITIES KALEALOA
INSTALLATION OF ENERGY EFFICIENT DUCTLESS SPLIT AIR CONDITIONING SYSTEM
KAPOLEI, OAHU, HAWAII

CONTRACT NO.:		TASK ORDER NO.:
SCALE AS NOTED	APPROVED BY	DRAWN BY MC
DATE 6/22/2012		Job No. CA-1216

PARTIAL 1ST FLOOR A/C PLAN

ECONOMY PLUMBING & SHEETMETAL, Inc.
1029 ULUPONO STREET (SAND ISLAND)
HONOLULU, HAWAII 96819

DRAWING NUMBER M-3

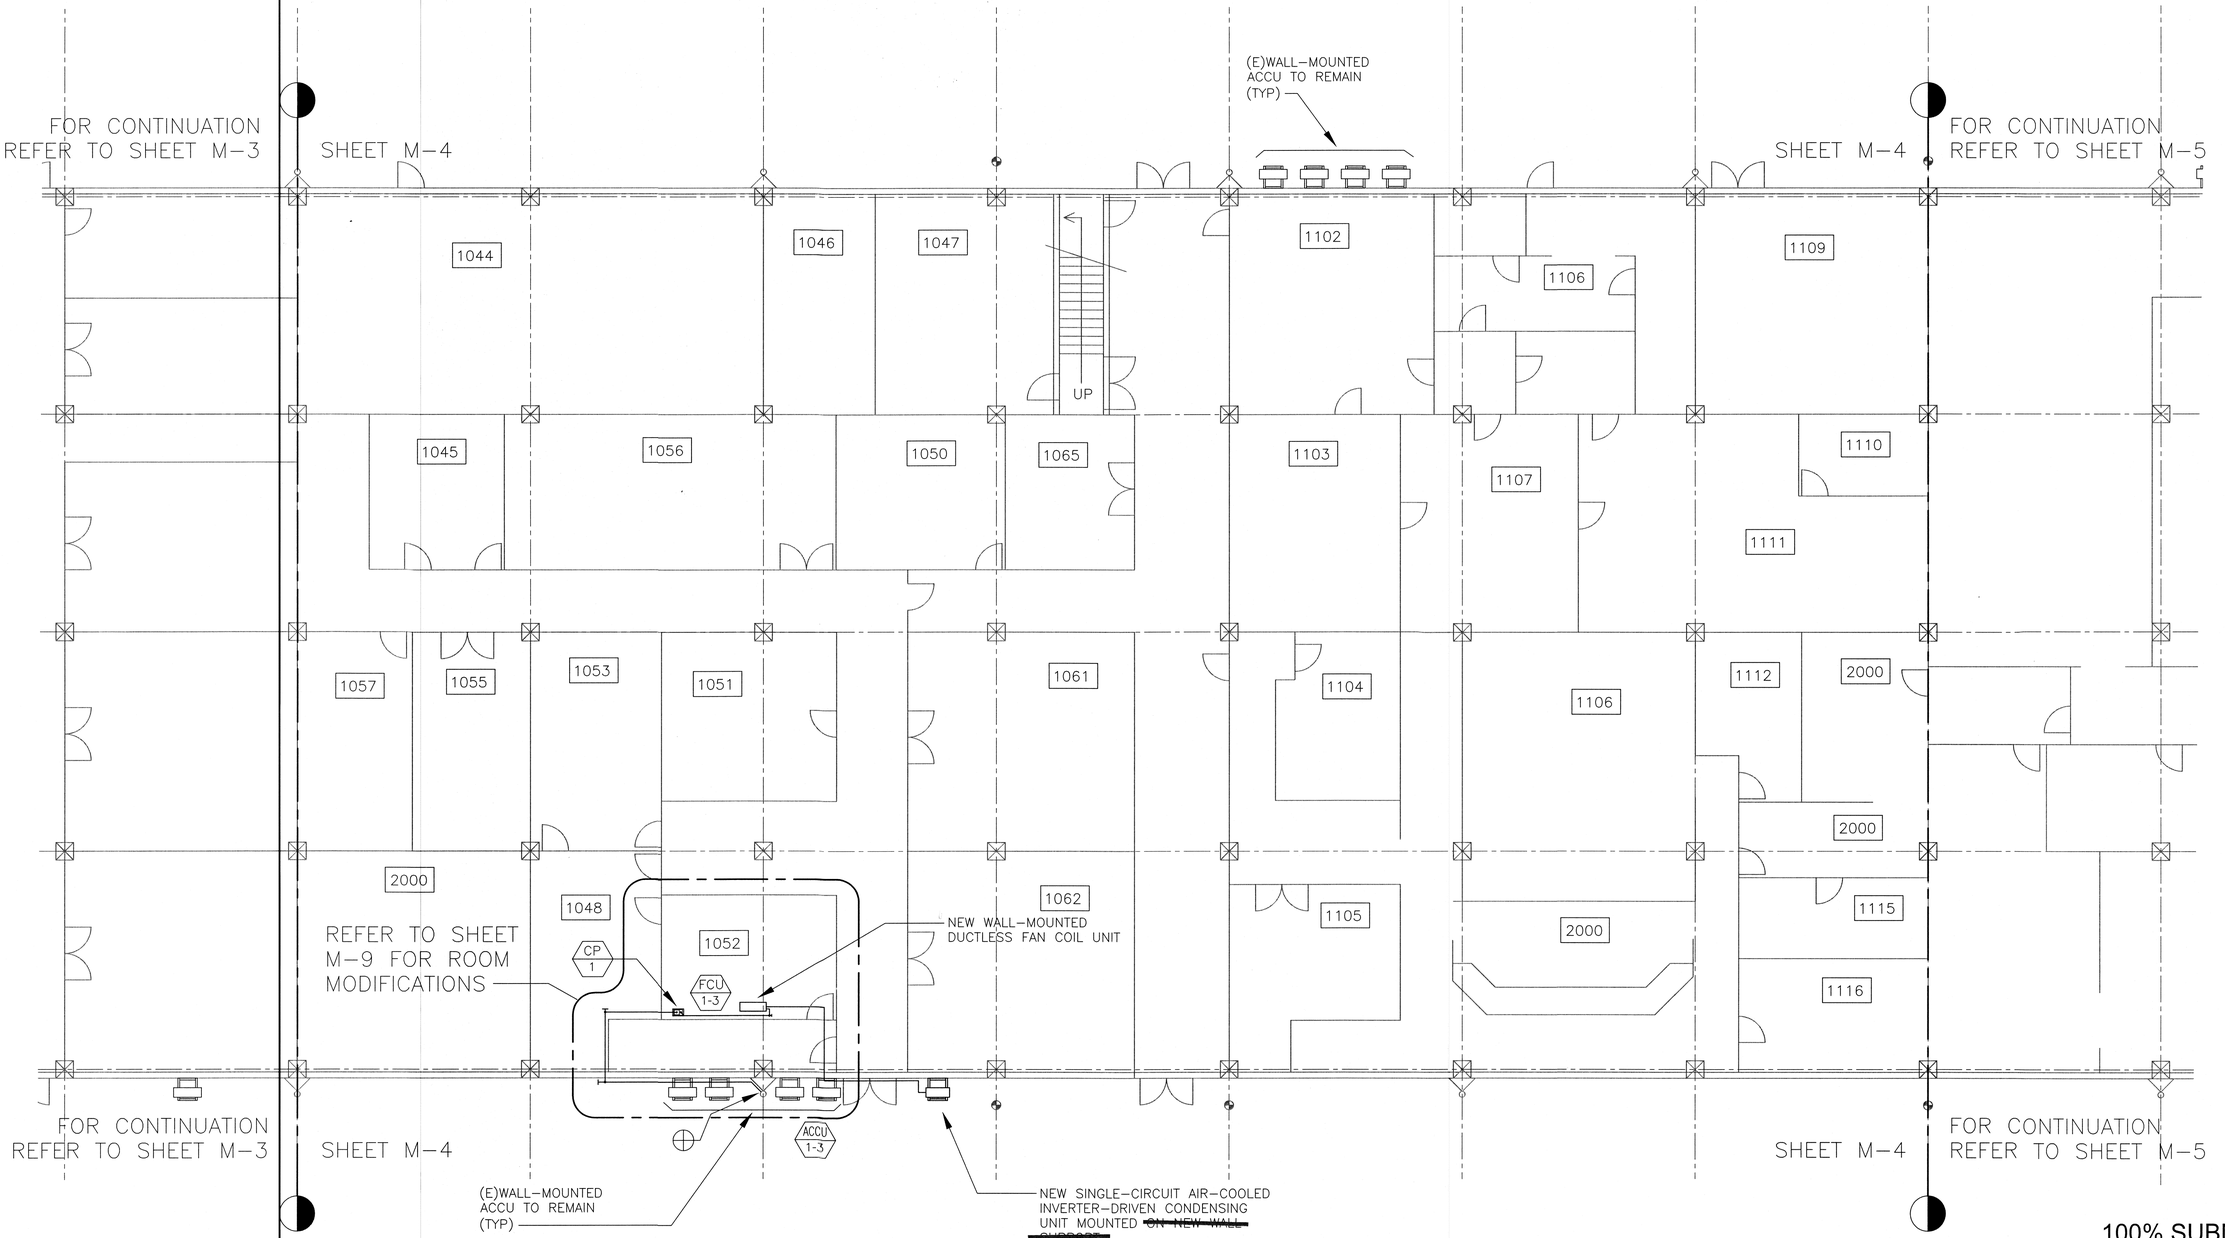

1 / M-4 PARTIAL 1ST FLOOR A/C PLAN

SCALE: 1/8" = 1' - 0"

POINT OF CONNECTION
(NEW TO EXISTING)

1 ADD 1/2" TREATED PLYWOOD
PER DETAIL 2/M-9.

1/8"=1'-0" 4' 0 10' 20'

100% SUBMITTAL

CONFIDENTIALITY CLAUSE

THIS DESIGN IS BASED ON ECONOMY PLUMBING AND SHEETMETAL'S DESIGN COMCEPT AND SHALL NOT BE SHARED WITH ANY THIRD PARTY.

BUILDING 282 HIARNG FACILITIES KALEALOA
INSTALLATION OF ENERGY EFFICIENT
DUCTLESS SPLIT AIR CONDITIONING SYSTEM
KAPOLEI, OAHU, HAWAII

CONTRACT NO.:		TASK ORDER NO.:
SCALE AS NOTED	APPROVED BY	DRAWN BY MC
DATE 6/22/2012		Job No. CA-1216

PARTIAL 1ST FLOOR A/C PLAN

ECONOMY PLUMBING & SHEETMETAL, Inc.
1029 ULUPONO STREET (SAND ISLAND)
HONOLULU, HAWAII 96819

DRAWING NUMBER M-4

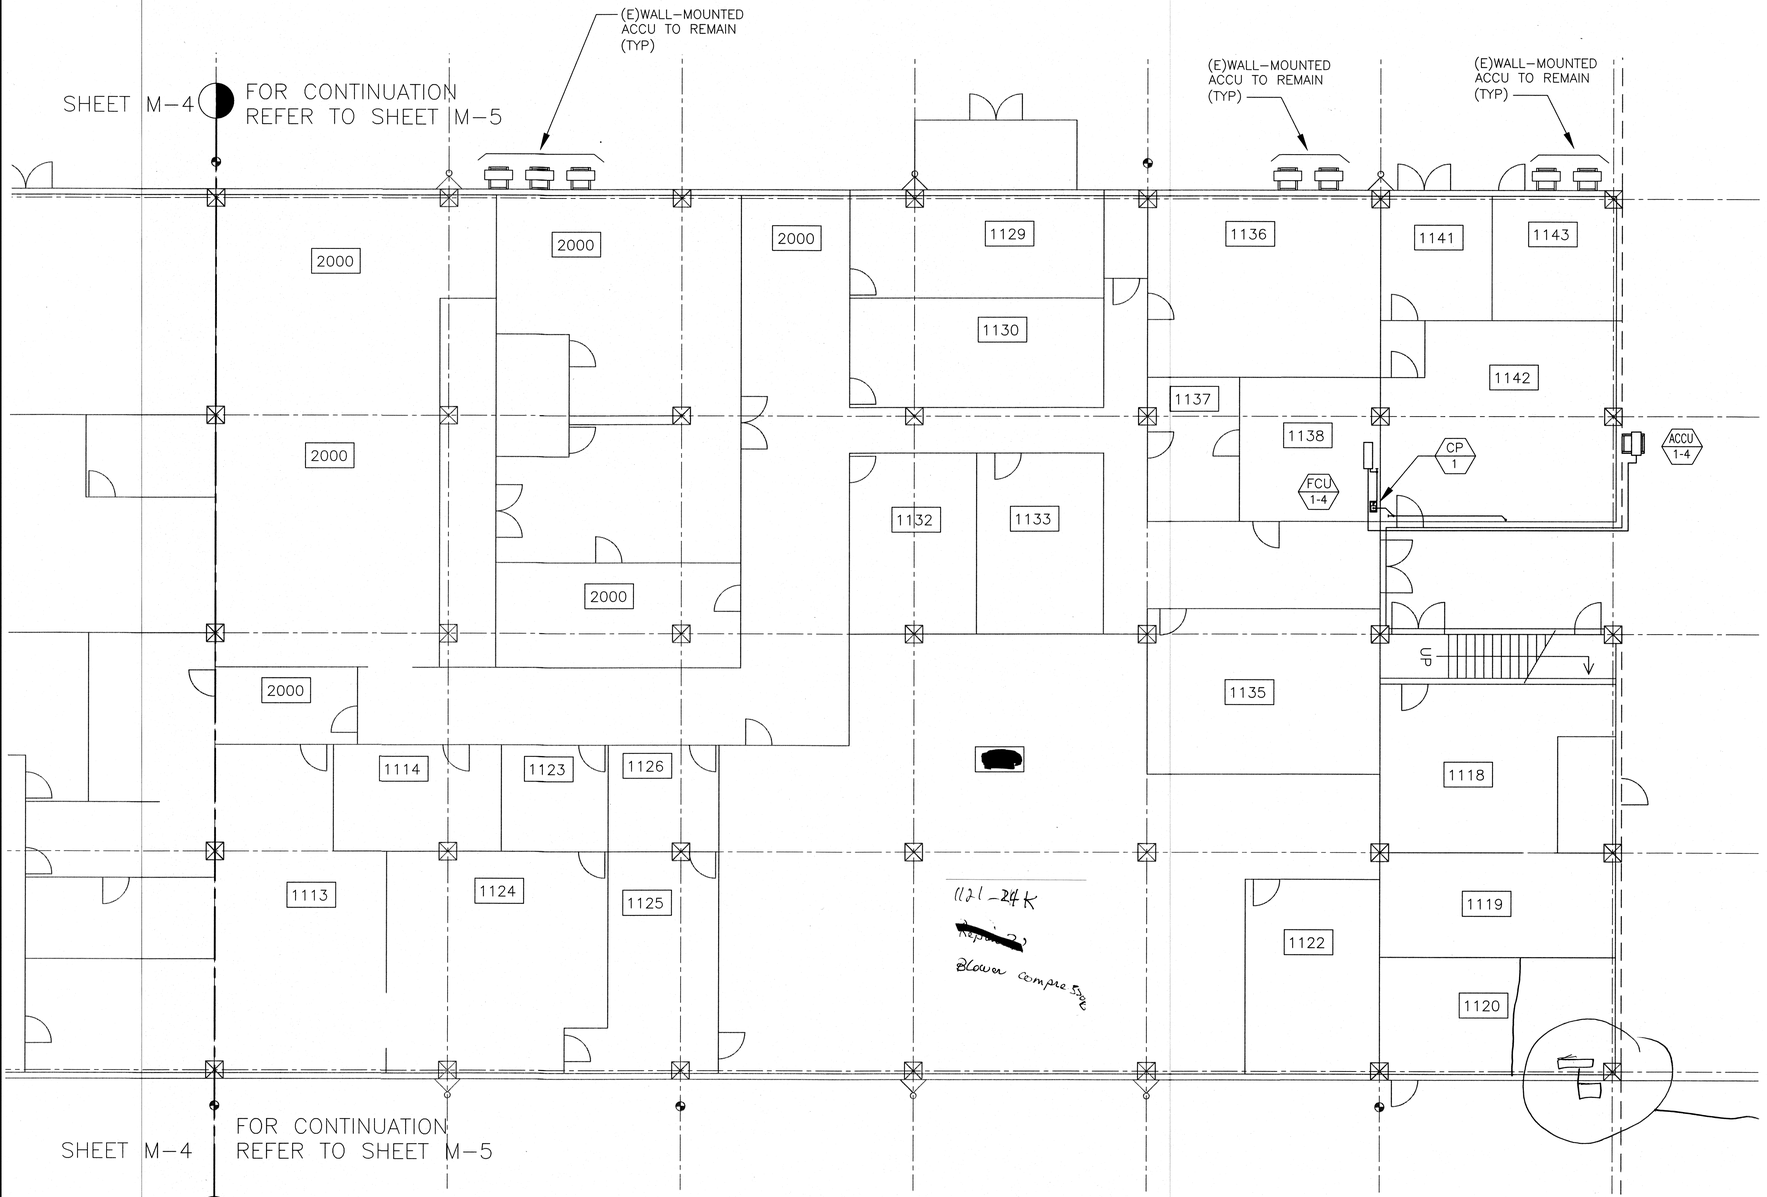

1/M-5 PARTIAL 1ST FLOOR A/C PLAN

SCALE: 1/8" = 1' - 0"

1 ADD 1/2" TREATED PLYWOOD PER DETAIL 2/M-9.

POINT OF CONNECTION (NEW TO EXISTING)

1/8"=1'-0" 4' 0 10' 20'

100% SUBMITTAL

CONFIDENTIALITY CLAUSE

THIS DESIGN IS BASED ON ECONOMY PLUMBING AND SHEETMETAL'S DESIGN COMCEPT AND SHALL NOT BE SHARED WITH ANY THIRD PARTY.

BUILDING 282 HIARNG FACILITIES KALEALOA
INSTALLATION OF ENERGY EFFICIENT DUCTLESS SPLIT AIR CONDITIONING SYSTEM
KAPOLEI, OAHU, HAWAII

CONTRACT NO.:	TASK ORDER NO.:
SCALE AS NOTED	APPROVED BY
DRAWN BY MC	
DATE 6/22/2012	Job No. CA-1216

PARTIAL 1ST FLOOR A/C PLAN

ECONOMY PLUMBING & SHEETMETAL, Inc.
1029 ULUPONO STREET (SAND ISLAND)
HONOLULU, HAWAII 96819

DRAWING NUMBER M-5

REMOVE (E)WAC SHOWN DASHED. ~~RECOVER REFRIGERANT PER EPA GUIDELINES~~ (TYPICAL)

NEW WALL-MOUNTED DUCTLESS FAN COIL UNIT (TYPICAL)

(E)WALL-MOUNTED ACCU TO REMAIN (TYP)

(E)6"FS RISER

(E)6"DS

REMOVE (E)WAC SHOWN DASHED. ~~RECOVER REFRIGERANT PER EPA GUIDELINES~~ (TYPICAL)

(E)6"DS

(E)WALL-MOUNTED ACCU TO REMAIN (TYP)

(E)6"DS

NEW WALL-MOUNTED DUCTLESS FAN COIL UNIT (TYPICAL)

(E)6"FS RISER

(E)WALL-MOUNTED ACCU TO REMAIN (TYP)

(E)WAC TO REMAIN

(E)6"DS

SHEET M-6 FOR CONTINUATION REFER TO SHEET M-7

2001 2003 2004 2005 2006 2007 2008 2009 2010 2011 2012 2013 2014

FCU 2-1K FCU 2-1L FCU 2-1G FCU 2-1H FCU 2-2D FCU 2-2C

2017 2001 2021 2022 2023 2024 2025 2026 2001 2032 2033

FCU 2-1J FCU 2-1M CP 1

2000

2001 WOMENS 2001 MENS 2040 2047 2028 2035 2036 2041 2042 2043 2044 2045 2050

FCU 2-1N CP 1 CP 1 FCU 2-1E FCU 2-1F FCU 2-1D

DN

took parts to fix 2053

Fixed

NEW WALL-MOUNTED DUCTLESS FAN COIL UNIT (TYPICAL)

2057 2058 2059 2060 2061 2062 2063 2064 2065 2066 2067 2068 2069

FCU 2-1A FCU 2-1B FCU 2-1C FCU 2-2A FCU 2-2B

(E)WAC TO REMAIN

(E)6"DS

(E)6"FS RISER

(N)~~WALL MOUNTED~~ ACCU 1-1 SERVING 1ST FLOOR

(E)WALL-MOUNTED ACCU TO REMAIN (TYP)

ACCU 2-1

NEW AIR-COOLED INVERTER-DRIVEN CONDENSING UNITS ~~MOUNTED ON NEW WALL SUPPORTS~~

(E)6"DS

(N)~~WALL MOUNTED~~ ACCU 1-2 SERVING 1ST FLOOR

(E)WALL-MOUNTED ACCU TO REMAIN (TYP)

(E)6"FS RISER

NEW AIR-COOLED INVERTER-DRIVEN CONDENSING UNIT ~~MOUNTED ON NEW WALL SUPPORT~~

ACCU 2-2

(E)6"DS

FOR CONTINUATION REFER TO SHEET M-7

SHEET M-6

100% SUBMITTAL

REMOVE (E)WAC SHOWN DASHED. ~~RECOVER REFRIGERANT PER EPA GUIDELINES~~ (TYPICAL)

TURN IN ALL WINDOW AC TO USER

1/M-6 PARTIAL 2ND FLOOR A/C PLAN

SCALE: 1/8" = 1'-0"

POINT OF CONNECTION (NEW TO EXISTING)

1 ADD 1/2" TREATED PLYWOOD PER DETAIL 2/M-9.

1/8"=1'-0" 4' 0 10' 20'

BUILDING 282 HIARNG FACILITIES KALEALOA
INSTALLATION OF ENERGY EFFICIENT DUCTLESS SPLIT AIR CONDITIONING SYSTEM
KAPOLEI, OAHU, HAWAII

CONTRACT NO.:	TASK ORDER NO.:
SCALE AS NOTED	APPROVED BY
DRAWN BY MC	
DATE 6/22/2012	Job No. CA-1216

PARTIAL 2ND FLOOR A/C PLAN

ECONOMY PLUMBING & SHEETMETAL, Inc.
1029 ULUPONO STREET (SAND ISLAND)
HONOLULU, HAWAII 96819

DRAWING NUMBER M-6

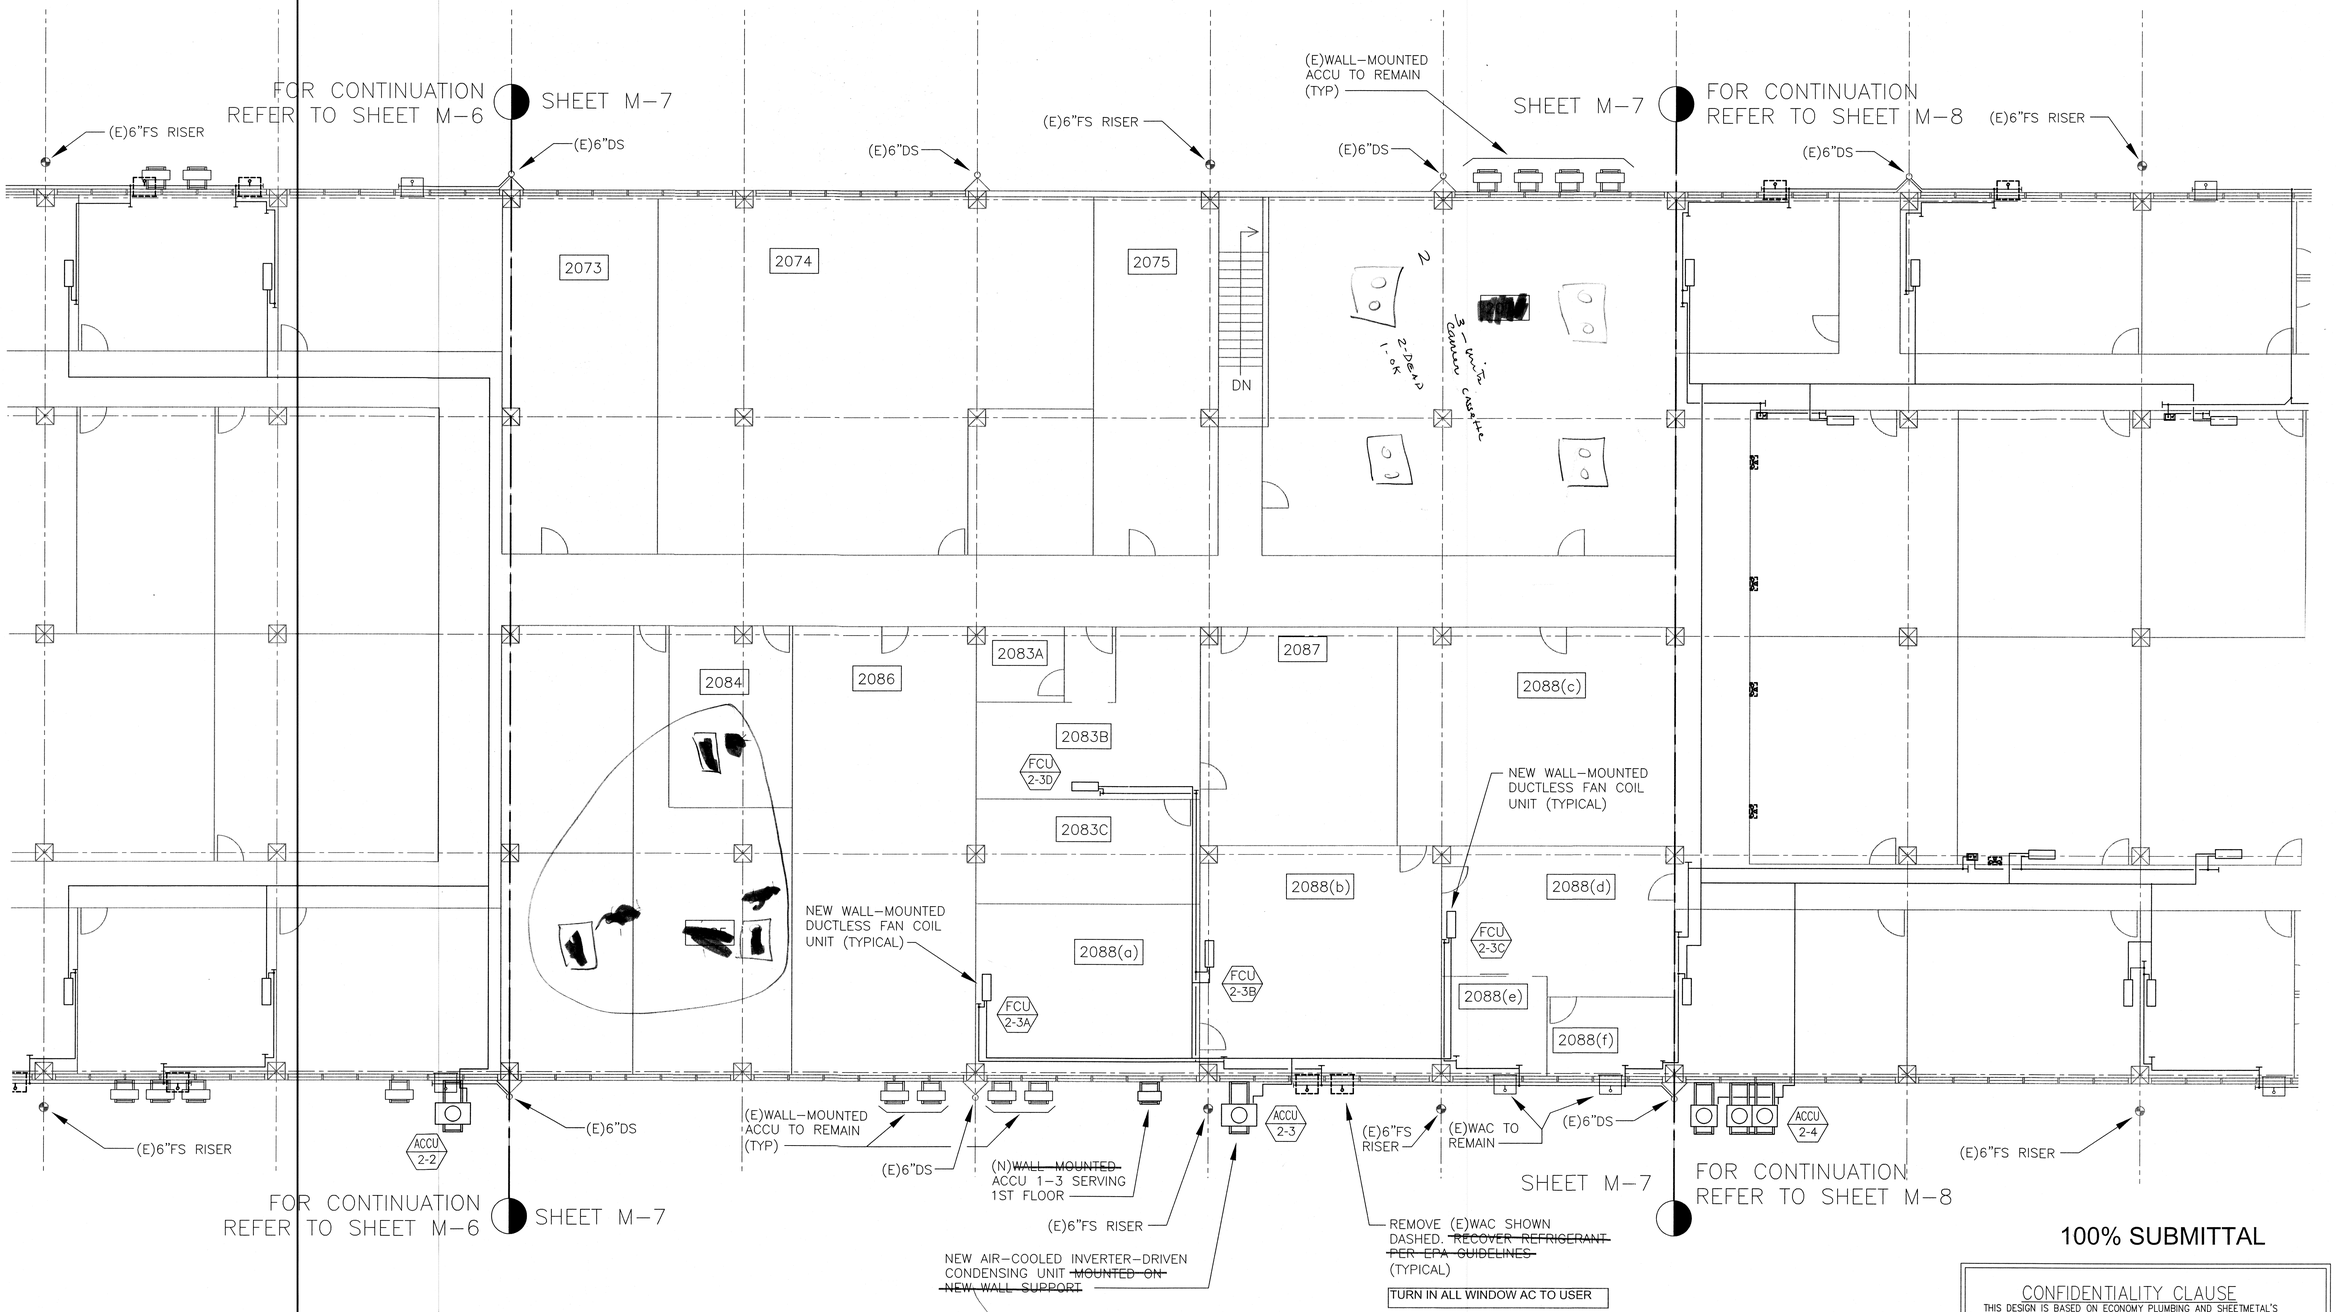

1 / M-7 PARTIAL 2ND FLOOR A/C PLAN

SCALE: 1/8" = 1' - 0"

⊕ POINT OF CONNECTION (NEW TO EXISTING)

1 ADD 1/2" TREATED PLYWOOD PER DETAIL 2/M-9.

1/8"=1'-0" 4' 0 10' 20'

100% SUBMITTAL

BUILDING 282 HIARNG FACILITIES KALEALOA
INSTALLATION OF ENERGY EFFICIENT
DUCTLESS SPLIT AIR CONDITIONING SYSTEM
KAPOLEI, OAHU, HAWAII

CONTRACT NO.:	TASK ORDER NO.:
SCALE AS NOTED	APPROVED BY
DRAWN BY MC	
DATE 6/22/2012	Job No. CA-1216

PARTIAL 2ND FLOOR A/C PLAN

ECONOMY PLUMBING & SHEETMETAL, Inc.
1029 ULUPONO STREET (SAND ISLAND)
HONOLULU, HAWAII 96819

DRAWING NUMBER M-7

FOR CONTINUATION
REFER TO SHEET M-7

SHEET M-8

REMOVE (E)WAC SHOWN DASHED. ~~RECOVER REFRIGERANT~~ TURN IN ALL WINDOW AC TO USER (TYPICAL)

(E)6"DS

NEW WALL-MOUNTED DUCTLESS FAN COIL UNIT (TYPICAL)

(E)6"FS RISER

(E)WAC TO REMAIN

(E)WALL-MOUNTED ACCU TO REMAIN (TYP)

NEW WALL-MOUNTED DUCTLESS FAN COIL UNIT (TYPICAL)

REMOVE (E)WAC SHOWN DASHED. ~~RECOVER REFRIGERANT PER EPA GUIDELINES~~ (TYPICAL)

(E)WALL-MOUNTED ACCU TO REMAIN (TYP)

2091 2092 2093 2095 2097 2098 2099 2100 2102 2103

2094

FCU 2-4F FCU 2-4H FCU 2-5K FCU 2-5L

2105 2106 2107 2108 2109 2110 2112 2113 2114 2115 2116 2117 2118 2119 2120 2121 2135

CP 1 FCU 2-4G FCU 2-4J FCU 2-5J

REMOVE (E)WALL FAN (TYPICAL)

2123 2125 2126 2127 2128 2130 2132 2133

DEAD

NEW WALL-MOUNTED DUCTLESS FAN COIL UNIT (TYPICAL)

FCU 2-4E FCU 2-5H

2136 2137 2138 2139 2140 2141 2143

FCU 2-5D FCU 2-5E FCU 2-5C

2144 2145 2146 2147 2148 2149 2150 2151 2152 2154 2155 2156

FCU 2-4A FCU 2-4D FCU 2-4B FCU 2-5A FCU 2-5B FCU 2-5G

ACCU 2-4 ACCU 2-5

(E)6"DS (E)6"FS RISER (E)WAC TO REMAIN (E)6"DS (E)6"FS RISER (E)6"DS (E)WAC TO REMAIN (TYP) (E)6"FS RISER (E)WAC TO REMAIN (TYP)

NEW AIR-COOLED INVERTER-DRIVEN CONDENSING UNITS ~~MOUNTED ON NEW WALL SUPPORTS~~

REMOVE (E)WAC SHOWN DASHED. ~~RECOVER REFRIGERANT PER EPA GUIDELINES~~ (TYPICAL) TURN IN ALL WINDOW AC TO USER

NEW AIR-COOLED INVERTER-DRIVEN CONDENSING UNITS ~~MOUNTED ON NEW WALL SUPPORTS~~

REMOVE (E)WAC SHOWN DASHED. ~~RECOVER REFRIGERANT PER EPA GUIDELINES~~ (TYPICAL)

FOR CONTINUATION
REFER TO SHEET M-7

SHEET M-8

1 / M-8 PARTIAL 2ND FLOOR A/C PLAN

SCALE: 1/8" = 1' - 0"

1 ADD 1/2" TREATED PLYWOOD PER DETAIL 2/M-9.

POINT OF CONNECTION (NEW TO EXISTING)

1/8"=1'-0" 4' 0 10' 20'

100% SUBMITTAL

CONFIDENTIALITY CLAUSE

THIS DESIGN IS BASED ON ECONOMY PLUMBING AND SHEETMETAL'S DESIGN COMCEPT AND SHALL NOT BE SHARED WITH ANY THIRD PARTY.

BUILDING 282 HIARNG FACILITIES KALEALOA
INSTALLATION OF ENERGY EFFICIENT DUCTLESS SPLIT AIR CONDITIONING SYSTEM
KAPOLEI, OAHU, HAWAII

CONTRACT NO.:	TASK ORDER NO.:
SCALE AS NOTED	APPROVED BY
DRAWN BY MC	
DATE 6/22/2012	Job No. CA-1216

PARTIAL 2ND FLOOR A/C PLAN

ECONOMY PLUMBING & SHEETMETAL, Inc.
1029 ULUPONO STREET (SAND ISLAND)
HONOLULU, HAWAII 96819

DRAWING NUMBER M-8

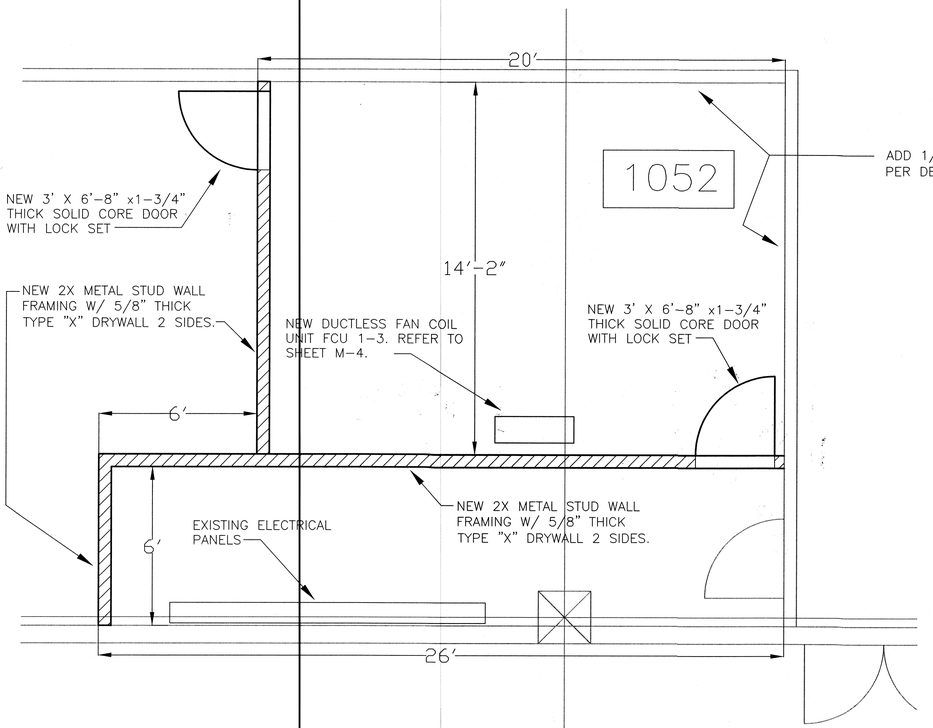

1 M-9 NEW FLOOR PLAN (ROOM 1052)

SCALE: 3/8" = 1' - 0"

3/8"=1'-0" 2' 0 5' 10'

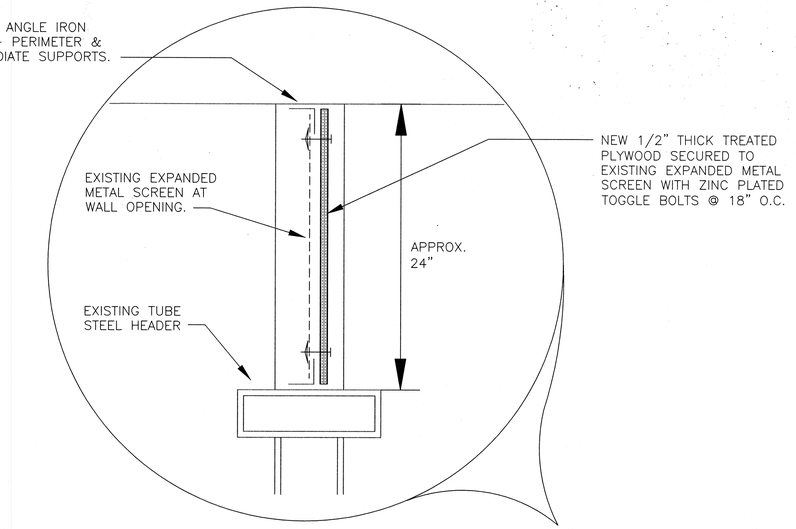

2 M-9 NEW PLYWOOD AT SCREENED WALL OPENING DETAIL

SCALE: 1/2" = 1' - 0"

100% SUBMITTAL

CONFIDENTIALITY CLAUSE

THIS DESIGN IS BASED ON ECONOMY PLUMBING AND SHEETMETAL'S DESIGN COMCEPT AND SHALL NOT BE SHARED WITH ANY THIRD PARTY.

BUILDING 282 HIARNG FACILITIES KALEALOA INSTALLATION OF ENERGY EFFICIENT DUCTLESS SPLIT AIR CONDITIONING SYSTEM

KAPOLEI, OAHU, HAWAII

CONTRACT NO.:	TASK ORDER NO.:
SCALE AS NOTED	APPROVED BY
DRAWN BY MC	
DATE 6/22/2012	Job No. CA-1216

NEW FLOOR PLAN (RM 1052) & MISCELLANEOUS DETAILS

ECONOMY PLUMBING & SHEETMETAL, Inc.
1029 ULUPONO STREET (SAND ISLAND)
HONOLULU, HAWAII 96819

DRAWING NUMBER M-9

DUCTLESS DIRECT EXPANSION FAN COIL UNIT:

WALL-MOUNTED DIRECT EXPANSION FAN COIL UNIT CONSISTING OF HIGH IMPACT POLYMER CABINET, MULTI-SPEED CENTRIFUGAL BLOWER, R-410A REFRIGERANT, COPPER TUBE / ALUMINUM FIN DIRECT EXPANSION COOLING COIL, MINIMUM SYSTEM PERFORMANCE OF 15.0 SEER. PROVIDE WITH HARD-WIRED CONTROLLER. DISCONNECT SWITCH BY ELECTRICIAN.

QUAN.	FCU	TYPE	TBTUH	SBTUH	CFM			ENT AIR		SST	POWER SUPPLY				REFRIG PIPING (FLARE)		MITSUBISHI MODEL PKFY-	REMARKS
					HIGH	MED	LOW	°FDB	°FWB		WATTS	AMPS	MOCP	VOLT/PH/HZ	LIQUID	GAS		
5	2-1E, 2-1F, 2-1J, 2-1N, 2-5E, ~~2-5F~~ DELETED	WALL-MOUNTED	8,000	5,440	210	190	170	80.0	67.0	40F	30	0.15	15	208-230/1/60	1/4"	1/2"	P08NBMU-E	PROVIDE CONDENSATE PUMP IF REQUIRED TO GET CONDENSATE TO BUILDING EXTERIOR.
2	2-1K, 2-1M	WALL-MOUNTED	12,000	8,160	390	355	320	80.0	67.0	40F	30	0.30	15	208-230/1/60	1/4"	1/2"	P12NHMU-E	PROVIDE CONDENSATE PUMP IF REQUIRED TO GET CONDENSATE TO BUILDING EXTERIOR.
2	2-5D, 2-5H	WALL-MOUNTED	15,000	10,200	415	370	320	80.0	67.0	40F	30	030	15	208-230/1/60	1/4"	1/2"	P15NHMU-E	PROVIDE CONDENSATE PUMP IF REQUIRED TO GET CONDENSATE TO BUILDING EXTERIOR.
6	2-1A, 2-1D, 2-4F, 2-5C, 2-5G, 2-5J	WALL-MOUNTED	18,000	12,240	425	370	320	80.0	67.0	40F	30	0.30	15	208-230/1/60	1/4"	1/2"	P18NHMU-E	PROVIDE CONDENSATE PUMP IF REQUIRED TO GET CONDENSATE TO BUILDING EXTERIOR.
1	1-3*	WALL-MOUNTED	18,000	12,240	425	370	320	80.0	67.0	40F	30	0.33	15	208-230/1/60*	1/4"	1/2"	PKA-A18HA4	PROVIDE CONDENSATE PUMP IF REQUIRED TO GET CONDENSATE TO BUILDING EXTERIOR.
16	2-1C, 2-1H, 2-2A, 2-2B, 2-2C, 2-2D, 2-3A, 2-3C, 2-3D, 2-4A, 2-4B, 2-4D, 2-4E, 2-4H, 2-4J, 2-5A	WALL-MOUNTED	24,000	16,320	710	-	570	80.0	67.0	40F	40	0.29	15	208-230/1/60	3/8"	5/8"	P24NKMU-E	PROVIDE CONDENSATE PUMP IF REQUIRED TO GET CONDENSATE TO BUILDING EXTERIOR.
3	1-1,* 1-2,* 1-4 *	WALL-MOUNTED	24,000	18,480	775	705	635	80.0	67.0	40F	56	0.36	15	208-230/1/60*	3/8"	5/8"	PKA-A24KA4	PROVIDE CONDENSATE PUMP IF REQUIRED TO GET CONDENSATE TO BUILDING EXTERIOR.
9	2-1B, 2-1G, 2-1L, 2-3B, 2-4C, 2-4G, 2-5B, 2-5K, 2-5L	WALL-MOUNTED	30,000	20,400	850	-	710	80.0	67.0	40F	60	0.43	15	208-230/1/60	3/8"	5/8"	P30NKMU-E	PROVIDE CONDENSATE PUMP IF REQUIRED TO GET CONDENSATE TO BUILDING EXTERIOR.
44	TOTAL FCU'S																	

* INDOOR DUCTLESS FAN COIL UNITS RECEIVE POWER FROM THEIR RESPECTIVE OUTDOOR CONDENSING UNITS THROUGH FIELD-INSTALLED INTERCONNECTED WIRING.

AIR-COOLED CONDENSING UNIT:

FACTORY ASSEMBLED AIR-COOLED CONDENSING UNIT COMPLETE WITH POWDER COATED GALVANIZED STEEL CABINET, COPPER TUBE/ALUMINUM FIN CONDENSER COIL, VARIABLE SPEED TEFC CONDENSER FAN MOTOR, REMOVABLE ACCESS PANELS, INVERTER-DRIVEN SCROLL OR ROTARY COMPRESSOR, R-410A REFRIGERANT, CONTROL SYSTEM SHALL INCLUDE HIGH PRESSURE SWITCH AND LOW PRESSURE SWITCH, FIVE-YEAR WARRANTY ON PARTS AND SEVEN-YEAR WARRANTY ON COMPRESSOR. CABINETS SHALL BE RECEIVE SEACOAST PROTECTION ABLE TO WITHSTAND 960 HOURS PER ASTM B117 CRITERIA, CONDENSER COIL SHALL BE FACTORY-COATED WITH BLUE FIN ANTI-CORROSION PROTECTION. PROVIDE NEOPRENE VIBRATION ISOLATION PADS. DISCONNECT SWITCHES BY ELECTRICIAN.

ACCU	TOTAL CAPACITY (BTU/HR)	AMB	SOUND PRESSURE LEVEL	COMPRESSOR						CONDENSER				POWER SUPPLY				MITSUBISHI MODEL	WEIGHT	SEER (MINIMUM)	REMARKS
				QTY	TYPE	WATTS	RLA	LRA	VOLT/PH/HZ	QTY	WATTS	FLA	VOLT/PH/HZ	AMPS	MCA	MOCP	VOLT/PH/HZ				
1-1	24,000	95F	48 dB(A)	1	TWIN-ROTARY	2200	12.0	14.0	208-230/1/60	1	75	0.75	208-230/1/60	12.8	18.0	30	208-230/1/60	PUY-A24NHA4-(BS)	163 LBS.	15.0	
1-2	24,000	95F	48 dB(A)	1	TWIN-ROTARY	2200	12.0	14.0	208-230/1/60	1	75	0.75	208-230/1/60	12.8	18.0	30	208-230/1/60	PUY-A24NHA4-(BS)	163 LBS.	15.0	
1-3	18,000	95F	48 dB(A)	1	TWIN-ROTARY	2200	12.0	14.0	208-230/1/60	1	40	0.35	208-230/1/60	12.4	13.0	20	208-230/1/60	PUY-A18NHA4-(BS)	89 LBS.	15.0	
1-4	24,000	95F	48 dB(A)	1	TWIN-ROTARY	2200	12.0	14.0	208-230/1/60	1	75	0.75	208-230/1/60	12.8	18.0	30	208-230/1/60	PUY-A24NHA4-(BS)	163 LBS.	15.0	
2-1	216,000	95F	62.5 dB(A)	1	SCROLL	6800	19.0	22.2	208-230/3/60	1	920	2.60	208-230/1/60	24.5	36.0	50	208-230/3/60	PUHY-P216TSJMU-A-(BS)***	497 LBS.	15.0	
				1	SCROLL	8100	22.5	26.3	208-230/3/60	2	920	2.60	208-230/1/60	30.5	49.0	70	208-230/3/60		629 LBS.		
2-2	96,000	95F	58 dB(A)	1	SCROLL	6800	19.0	22.2	208-230/3/60	1	920	2.60	208-230/1/60	24.5	36.0	50	208-230/3/60	PUHY-P96TJMU-A-(BS)	497 LBS.	15.0	
2-3	96,000	95F	58 dB(A)	1	SCROLL	6800	19.0	22.2	208-230/3/60	1	920	2.60	208-230/1/60	24.5	36.0	50	208-230/3/60	PUHY-P96TJMU-A-(BS)	497 LBS.	15.0	
2-4	216,000	95F	62.5 dB(A)	1	SCROLL	6800	19.0	22.2	208-230/3/60	1	920	2.60	208-230/1/60	24.5	36.0	50	208-230/3/60	PUHY-P216TSJMU-A-(BS)***	497 LBS.	15.0	
				1	SCROLL	8100	22.5	26.3	208-230/3/60	2	920	2.60	208-230/1/60	30.5	49.0	70	208-230/3/60		629 LBS.		
2-5	192,000	95F	62.5 dB(A)	1	SCROLL	5100	14.2	16.6	208-230/3/60	1	920	2.60	208-230/1/60	16.2	25.0	30	208-230/3/60	PUHY-P192TSJMU-A-(BS)**	441 LBS.	15.0	
				1	SCROLL	8100	22.5	26.3	208-230/3/60	2	920	2.60	208-230/1/60	30.5	49.0	70	208-230/3/60		629 LBS.		

** MODEL PUHY-P192TSJMU-A-(BS) IS COMPRISED ON ONE (1) MODEL PUHY-P72TJMU-A-(BS) & ONE (1) MODEL PUHY-P120TJMU-A-(BS) CONDENSING UNITS. EACH CONDENSING UNIT NEEDS TO BE PROVIDED WITH SEPARATE POWER SUPPLY.

*** MODEL PUHY-P216TSJMU-A-(BS) IS COMPRISED ON ONE (1) MODEL PUHY-P96TJMU-A-(BS) & ONE (1) MODEL PUHY-P120TJMU-A-(BS) CONDENSING UNITS. EACH CONDENSING UNIT NEEDS TO BE PROVIDED WITH SEPARATE POWER SUPPLY.

A/C CONDENSATE PUMP:

AUTOMATIC CONDENSATE PUMP UNIT, CENTRIFUGAL PUMP, 3/8" DISCHARGE WITH CHECK VALVE, 1/2 GALLON TANK CAPACITY, PROVIDE SAFETY SWITCH AND THERMAL OVERLOAD PROTECTION. INTERLOCK TO SHUT-DOWN A/C UNIT IF OVERFILL SAFETY SWITCH IS ACTIVATED.

QUAN.	CP	GPH	TDH	HP	WATTS	VOLT/PH/HZ	LITTLE GIANT MODEL NO.	REMARKS
14	1	70	5.0 FT	1/30	115	208-230/1/60	VCMA-20	POWER FROM NEAREST FAN COIL UNIT DISCONNECT SWITCH

100% SUBMITTAL

CONFIDENTIALITY CLAUSE
THIS DESIGN IS BASED ON ECONOMY PLUMBING AND SHEETMETAL'S DESIGN COMCEPT AND SHALL NOT BE SHARED WITH ANY THIRD PARTY.

BUILDING 282 HIARNG FACILITIES KALEALOA
INSTALLATION OF ENERGY EFFICIENT DUCTLESS SPLIT AIR CONDITIONING SYSTEM
KAPOLEI, OAHU, HAWAII

CONTRACT NO.: | TASK ORDER NO.:
SCALE AS NOTED | APPROVED BY | DRAWN BY MC
DATE 6/22/2012 | Job No. CA-1216

EQUIPMENT SCHEDULE

ECONOMY PLUMBING & SHEETMETAL, Inc.
1029 ULUPONO STREET (SAND ISLAND)
HONOLULU, HAWAII 96819

DRAWING NUMBER M-12

DEMOLITION NOTES

1. EXISTING PLANS DO NOT INDICATE COMPLETE EXISTING WIRING CONDITIONS. CONTRACTOR SHALL VERIFY EXISTING CONDITIONS PRIOR TO START OF WORK.

2. BEFORE ANY WIRING IS CUT, CONTRACTOR SHALL VERIFY USAGE OF WIRING TO BE CUT TO ASSURE THAT SERVICES REQUIRED ARE NOT DISCONTINUED. PROVIDE ADDITIONAL WIRING DEVICES AND OTHER ACCESSORIES TO ENSURE CONTINUITY OF SERVICE TO OTHER PARTS OF INSTALLATION TO REMAIN.

3. REMOVE ALL EXISTING WIRING NOT TO REMAIN IN SERVICE.

4. REMOVE ALL CONDUITS NO LONGER REQUIRED.

5. PHASE WORK TO ASSURE CONTINUITY OF ELECTRICAL, TELEPHONE AND SIGNAL SERVICES TO PARTS OF FACILITIES THAT WILL REMAIN IN USE.

6. REMOVE ALL EXISTING LIGHTING FIXTURES, RECEPTACLES AND SWITCHES INDICATED TO BE REMOVED OR NO LONGER REQUIRED. BLANK OUTLETS AND PLUG ALL HOLES IN BOXES AND CABINETS.

7. ABANDON CONDUITS BELOW GRADE NO LONGER REQUIRED. PULL OUT ALL WIRES IN ABANDONED CONDUITS.

ELECTRICAL SPECIFICATIONS

1. ENTIRE INSTALLATION TO CONFORM TO THE PROVISIONS OF THE NATIONAL ELECTRICAL CODE, LOCAL ELECTRIC BUREAU AND LOCAL UTILITY COMPANIES. OBTAIN AND PAY FOR PERMITS AND DELIVER CERTIFICATES OF COMPLETION AND INSPECTION TO ARCHITECT.

2. MATERIALS AND WORKMANSHIP TO BE VERY BEST QUALITY OF ITS KIND.

3. SUBSTITUTE MATERIALS TO BE EQUAL IN QUALITY TO SPECIFIED ITEM. IF SUBSTITUTE MATERIALS ARE PROPOSED, SUBMIT SIX (6) COPIES OF SHOP DRAWINGS FOR APPROVAL PRIOR TO ORDERING. PROVIDE SAMPLES OF SUBSTITUTE MATERIALS, IF REQUESTED TO EVALUATE EQUALITY OF PROPOSED SUBSTITUTION.

4. GUARANTEE – THE ENTIRE INSTALLATION SHALL BE GUARANTEED FOR ONE YEAR AFTER ACCEPTANCE BY THE OWNER AGAINST DEFECTIVE MATERIALS AND WORKMANSHIP. WHEN NOTIFIED BY THE OWNER OF FAILURE OF ANY PART OF THE INSTALLATION DURING THE GUARANTEE PERIOD, CONTRACTOR SHALL REPAIR OR REPLACE THE DEFECTIVE PART AT HIS OWN EXPENSE TO THE SATISFACTION OF THE OWNER.

5. TESTING: AN OPERATIONAL TEST SHALL BE PERFORMED AFTER THE COMPLETION OF THE INSTALLATION, TO ASSURE PROPER OPERATION OF ALL ITEMS OF THE WORK.

6. INSTALLATION AND WORKMANSHIP:

   A. ALL WORK SHALL BE NEATLY EXECUTED, WORKMANLIKE IN APPEARANCE, SYMMETRICAL, PLUMB, UNIFORM, PROPERLY ALIGNED AND SECURED IN PLACE.

   B. WIRING METHODS:

      (1) USE EMT, IMC, OR CONDUIT IN DRY INTERIOR LOCATIONS AND USE CONDUIT IN DAMP LOCATIONS.

      (2) USE SEALTITE FLEX FOR CONNECTIONS TO EQUIPMENT.

      (3) ATTACH TO CONCRETE AND MASONRY WITH EXPANSION ANCHORS AND TO WOOD WITH WOOD SCREWS.

      (4) SUPPORT RACEWAYS PER NEC.

      (5) DO NOT SUPPORT RACEWAYS AND BOXES FROM AND ON MECHANICAL SYSTEM.

      (6) CABLES WILL NOT BE PERMITTED.

   C. CONDUCTORS:

      (1) CRIMP CONNECT ALL WIRES.

      (2) TAPE ALL SPLICES WITH SCOTCH NO. 33 VINYL TAPE OR EQUAL.

      (3) FORM WIRE NEATLY IN ENCLOSURES.

      (4) IDENTIFY CONDUCTORS BY COLOR CODE – NEUTRAL WIRE TO BE WHITE AND GROUND WIRE TO BE GREEN.

   D. CUT, DRILL AND PATCH AS REQUIRED. REPAIR ANY SURFACES DAMAGED OR MARRED–CUTTING, REPAIRS AND REFINISHING SHALL BE SUBJECT TO THE APPROVAL OF THE ARCHITECT.

   E. CLEAN ALL SURFACES TO RECEIVE PAINT. PAINT ANY SURFACE DAMAGED DURING INSTALLATION.

   F. REPAIR ALL SURFACES DAMAGED DURING THE INSTALLATION OF THE WORK SUBJECT TO THE APPROVAL OF THE ARCHITECT.

   G. COORDINATE WIRING REQUIREMENTS OF EQUIPMENT FURNISHED BY OTHERS PRIOR TO ROUGH–IN WORK. PROVIDE PROPER SIZE WIRING AND CONNECTIONS FOR ALL EQUIPMENT AS REQUIRED. PROVIDE DISCONNECTS FOR ALL MOTORIZED EQUIPMENT. PROVIDE STARTERS WITH OVERLOAD PROTECTION ON EACH LINE FOR ALL MOTORIZED EQUIPMENT FOR WHICH STARTERS ARE NOT PROVIDED BY OTHER TRADES.

7. MATERIALS:

   A. CONDUIT – RIGID GALVANIZED STEEL, 3/4" MINIMUM.

   B. EMT – GALVANIZED STEEL, 3/4" MINIMUM.

   C. INTERMEDIATE METALLIC CONDUIT, 3/4" MINIMUM.

8. CONDUCTORS:

   A. MINIMUM SIZE – NO. 12 AWG COPPER, 600V.

   B. COPPER TYPE XHHW, TW OR THWN – BRANCH CIRCUITS.

   C. COPPER TYPE THW, XHHW – FEEDERS, GUTTERS.

9. WIRING DEVICES:

   A. SWITCHES: 20A – POLES AS INDICATED 120/277V. AC – ARROW NO. 199X SERIES COLOR TO MATCH DEVICE PLATE.

   B. RECEPTACLES: DUPLEX – 3W20A, 125V. – ARROW #5362 COLOR TO MATCH DEVICE PLATE.

10. PANELBOARD: CIRCUIT BREAKER TYPE. BREAKER COMPLEMENT AS INDICATED. PROVIDE TYPED CIRCUIT DIRECTORY. HALF WIDTH PLUG–IN BREAKERS NOT PERMITTED. GENERAL ELECTRIC, CUTLER HAMMER, SIEMENS, SQUARE D OR WESTINGHOUSE.

11. DEVICE PLATES – PLASTIC – COLOR TO MATCH SURROUNDING FINISH.

12. OUTLETS – PROVIDE OUTLET BOXES TO SUIT CONDITIONS ENCOUNTERED. BOXES TO BE AMPLE SIZE TO ACCOMMODATE CONDUCTORS PER NEC. MINIMUM SIZE OF BOX FOR USE WITH RACEWAY SYSTEMS TO BE 4" SQUARE BY 1–1/2" DEEP.

13. CIRCUIT BREAKERS AND SAFETY SWITCHES – GENERAL ELECTRIC, SQUARE D, SIEMENS, WESTINGHOUSE OR CUTLER HAMMER. SAFETY SWITCH – HEAVY DUTY TYPE.

14. PULLBOXES, CABINETS AND GUTTER – CODE GAGE GALVANIZED SHEET STEEL.

15. TRANSFORMER SHALL BE DRY TYPE, NEMA SOUND RATING, STANDARD TAPS, UL WITH EXTERNAL VIBRATION ISOLATION MOUNTING. HEVI–DUTY, SIEMENS, CUTLER HAMMER, GENERAL ELECTRIC OR WESTINGHOUSE.

16. SUBMIT FOLLOWING EQUIPMENT FOR APPROVAL AND RESUBMIT UNTIL APPROVAL IS RECEIVED.

    CIRCUIT BREAKERS
    PANELBOARDS AND DISCONNECT SWITCHES
    TRANSFORMERS
    ANY BUILT–TO–ORDER EQUIPMENT

ELECTRICAL SYMBOLS

	EXISTING CEILING FLUORESCENT LUMINAIRE
	EXISTING CEILING FLUORESCENT LUMINAIRE TO BE REMOVED
$\not{S}$	EXISTING SWITCH TO BE REMOVED
S	SWITCH, 1P20A, +4'–0" UNLESS OTHERWISE NOTED
S_2	SWITCH, 2P20A, HORSEPOWER RATED
	DUPLEX CONVENIENCE OUTLET, 3W20A, GROUNDING TYPE, +18" UNLESS OTHERWISE NOTED
	DUPLEX CONVENIENCE OUTLET, 3W20A, GROUND FAULT INTERRUPTER TYPE, +18" UNLESS OTHERWISE NOTED
	EXISTING PANELBOARD
	PANELBOARD
	EXISTING TRANSFORMER
T	TRANSFORMER
M	MOTOR OUTLET
	MOTOR CONTROLLER
	SAFETY SWITCH
WP	WEATHERPROOF

– – – – – – WIRING IN EXPOSED RACEWAY

———— WIRING IN RACEWAY CONCEALED IN WALL OR CEILING

NOTES:
1. ANY CIRCUIT WITH NO FURTHER DESIGNATION INDICATES A TWO WIRE CIRCUIT. CIRCUITS WITH ADDITIONAL WIRES ARE INDICATED AS FOLLOWS: –//– , 3 WIRES: –///– , 4 WIRES, ETC.
2. GROUND WIRE PER NATIONAL ELECTRICAL CODE INDICATED AS FOLLOWS; —⏚— .
3. ALL EXPOSED CONDUIT AND BOXES SHALL BE PAINTED TO MATCH ADJACENT WALL OR CEILING SURROUNDING.

JASON YOGI
LICENSED PROFESSIONAL ENGINEER
No. 9062–E
HAWAII, U.S.A.

THIS WORK WAS PREPARED BY ME OR UNDER MY SUPERVISION AND CONSTRUCTION OF THIS PROJECT WILL BE UNDER MY SUPERVISION.

SIGNATURE 04/30/14 EXP. DATE

100% SUBMITTAL

BUILDING 282 HIARNG FACILITIES KALEALOA
INSTALLATION OF ENERGY EFFICIENT
DUCTLESS SPLIT AIR CONDITIONING SYSTEM
KAPOLEI, OAHU, HAWAII

CONTRACT NO.:		TASK ORDER NO.:
SCALE AS NOTED	APPROVED BY	DRAWN BY ESB
DATE 10/30/2012		Job No. CA–1216

DEMOLITION NOTES, ELECTRICAL SPECIFICATIONS, ELECTRICAL SYMBOLS

ECONOMY PLUMBING & SHEETMETAL, Inc.
1029 ULUPONO STREET (SAND ISLAND)
HONOLULU, HAWAII 96819

DRAWING NUMBER E-1

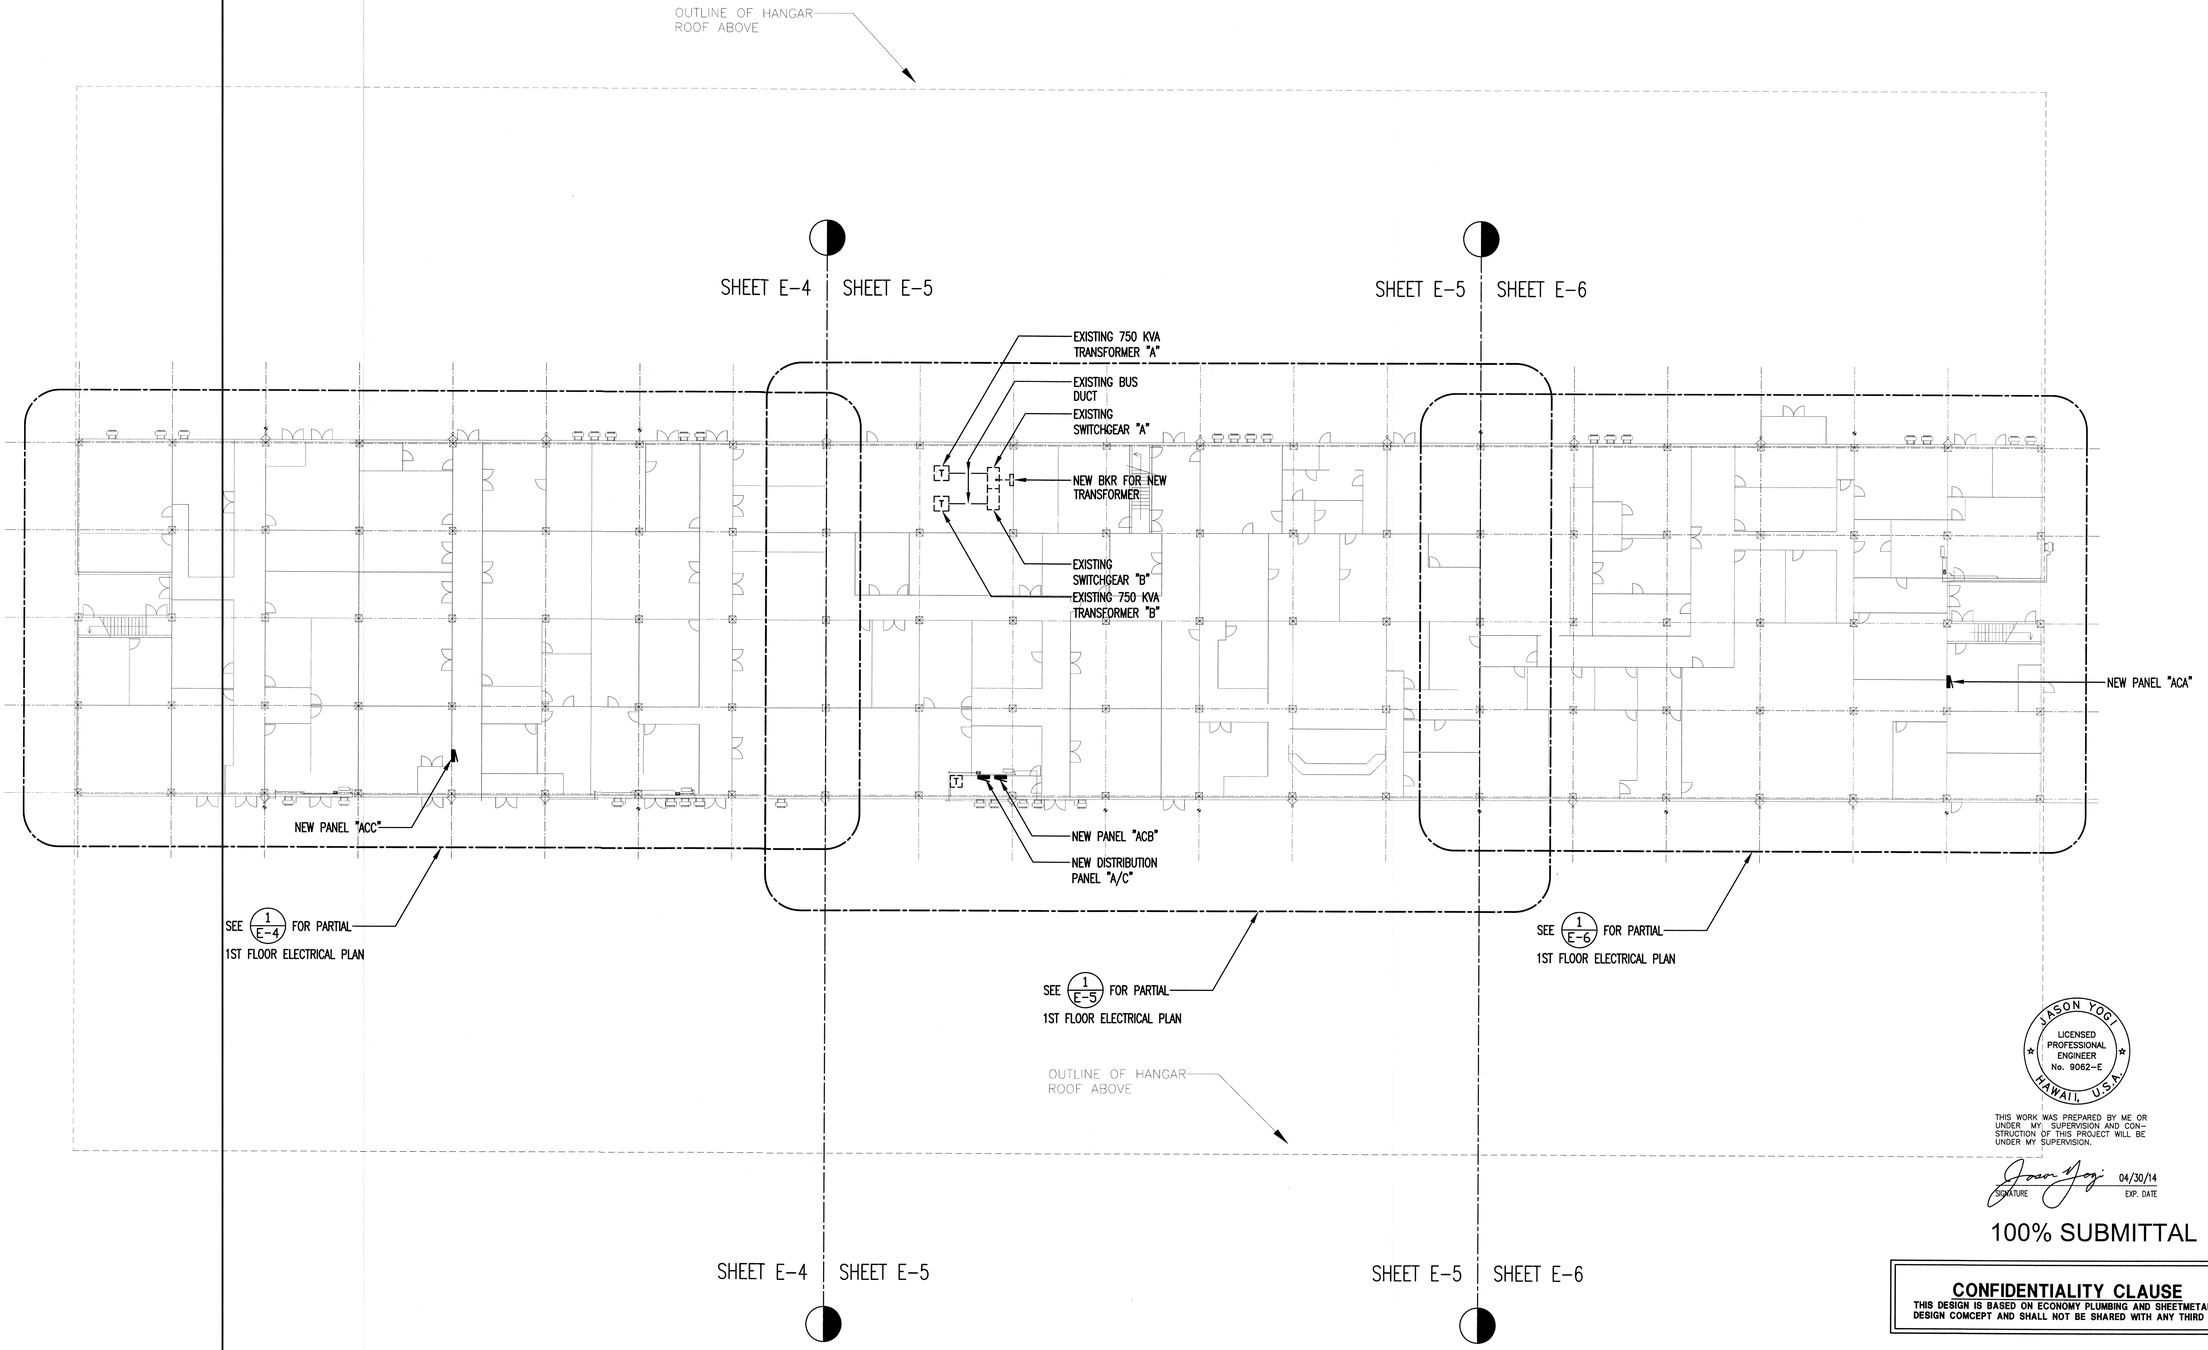

1/E-2 OVERALL 1ST FLOOR ELECTRICAL PLAN

SCALE: 1" = 20' - 0"

1"=20'-0" 10' 0 20' 40'

JASON YOGI
LICENSED PROFESSIONAL ENGINEER
No. 9062-E
HAWAII, U.S.A.

THIS WORK WAS PREPARED BY ME OR UNDER MY SUPERVISION AND CONSTRUCTION OF THIS PROJECT WILL BE UNDER MY SUPERVISION.

SIGNATURE 04/30/14 EXP. DATE

100% SUBMITTAL

CONFIDENTIALITY CLAUSE

THIS DESIGN IS BASED ON ECONOMY PLUMBING AND SHEETMETAL'S DESIGN COMCEPT AND SHALL NOT BE SHARED WITH ANY THIRD PARTY.

BUILDING 282 HIARNG FACILITIES KALEALOA INSTALLATION OF ENERGY EFFICIENT DUCTLESS SPLIT AIR CONDITIONING SYSTEM

KAPOLEI, OAHU, HAWAII

CONTRACT NO.:	TASK ORDER NO.:
SCALE AS NOTED	APPROVED BY
DATE 10/30/2012	DRAWN BY ESB
	Job No. CA-1216

OVERALL 1ST FLOOR ELECTRICAL PLAN

ECONOMY PLUMBING & SHEETMETAL, Inc.
1029 ULUPONO STREET (SAND ISLAND)
HONOLULU, HAWAII 96819

DRAWING NUMBER E-2

OUTLINE OF HANGAR ROOF ABOVE

SHEET E-7 | SHEET E-8

SHEET E-8 | SHEET E-9

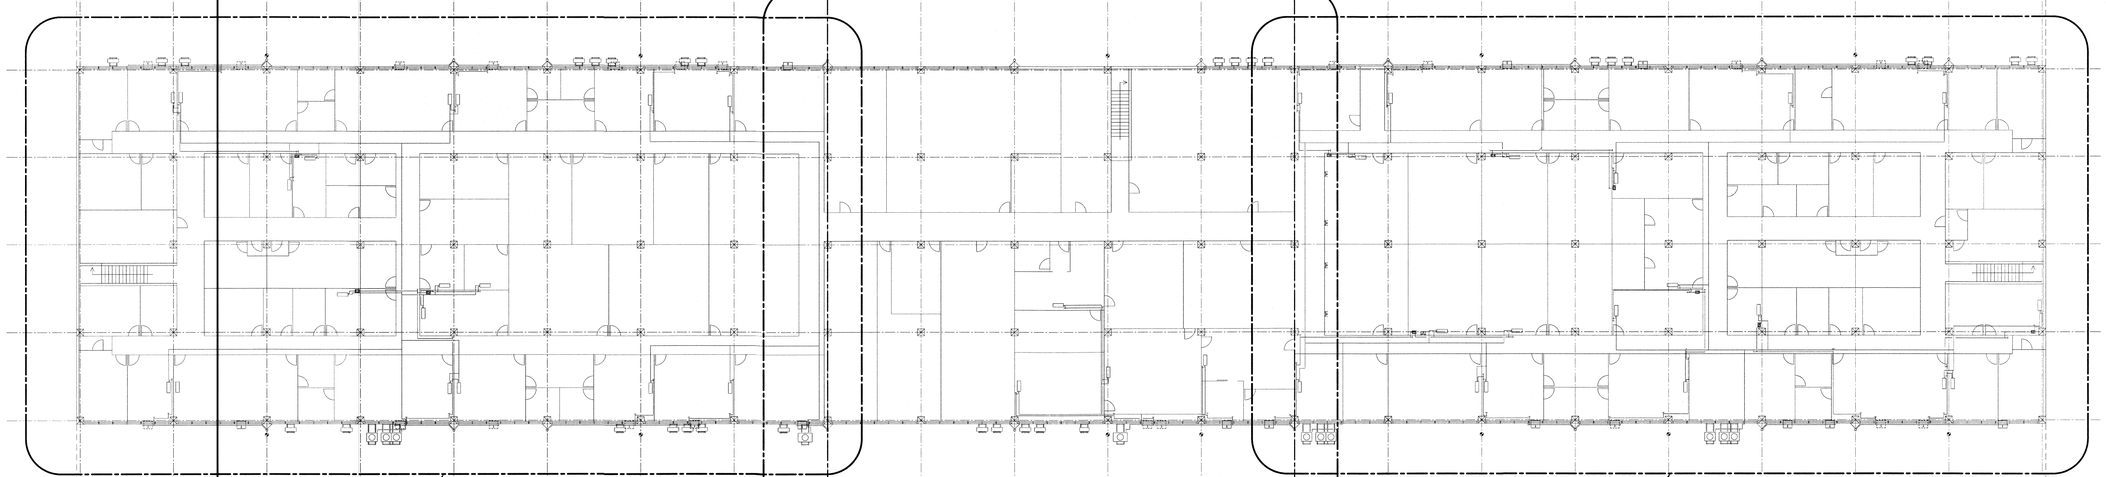

SEE (1/E-7) FOR PARTIAL 2ND FLOOR ELECTRICAL PLAN

SEE (1/E-8) FOR PARTIAL 2ND FLOOR ELECTRICAL PLAN

SEE (1/E-9) FOR PARTIAL 2ND FLOOR ELECTRICAL PLAN

OUTLINE OF HANGAR ROOF ABOVE

SHEET E-7 | SHEET E-8

SHEET E-8 | SHEET E-9

(1/E-3) OVERALL 2ND FLOOR ELECTRICAL PLAN

SCALE: 1" = 20' - 0"

1"=20'-0" 10' 0 20' 40'

JASON YOGI
LICENSED PROFESSIONAL ENGINEER
No. 9062-E
HAWAII, U.S.A.

THIS WORK WAS PREPARED BY ME OR UNDER MY SUPERVISION AND CONSTRUCTION OF THIS PROJECT WILL BE UNDER MY SUPERVISION.

SIGNATURE 04/30/14 EXP. DATE

100% SUBMITTAL

CONFIDENTIALITY CLAUSE
THIS DESIGN IS BASED ON ECONOMY PLUMBING AND SHEETMETAL'S DESIGN COMCEPT AND SHALL NOT BE SHARED WITH ANY THIRD PARTY.

BUILDING 282 HIARNG FACILITIES KALEALOA
INSTALLATION OF ENERGY EFFICIENT DUCTLESS SPLIT AIR CONDITIONING SYSTEM
KAPOLEI, OAHU, HAWAII

CONTRACT NO.:		TASK ORDER NO.:	
SCALE AS NOTED	APPROVED BY	DRAWN BY ESB	
DATE 10/30/2012		Job No. CA-1216	

OVERALL 2ND FLOOR ELECTRICAL PLAN

ECONOMY PLUMBING & SHEETMETAL, Inc.
1029 ULUPONO STREET (SAND ISLAND)
HONOLULU, HAWAII 96819

DRAWING NUMBER E-3

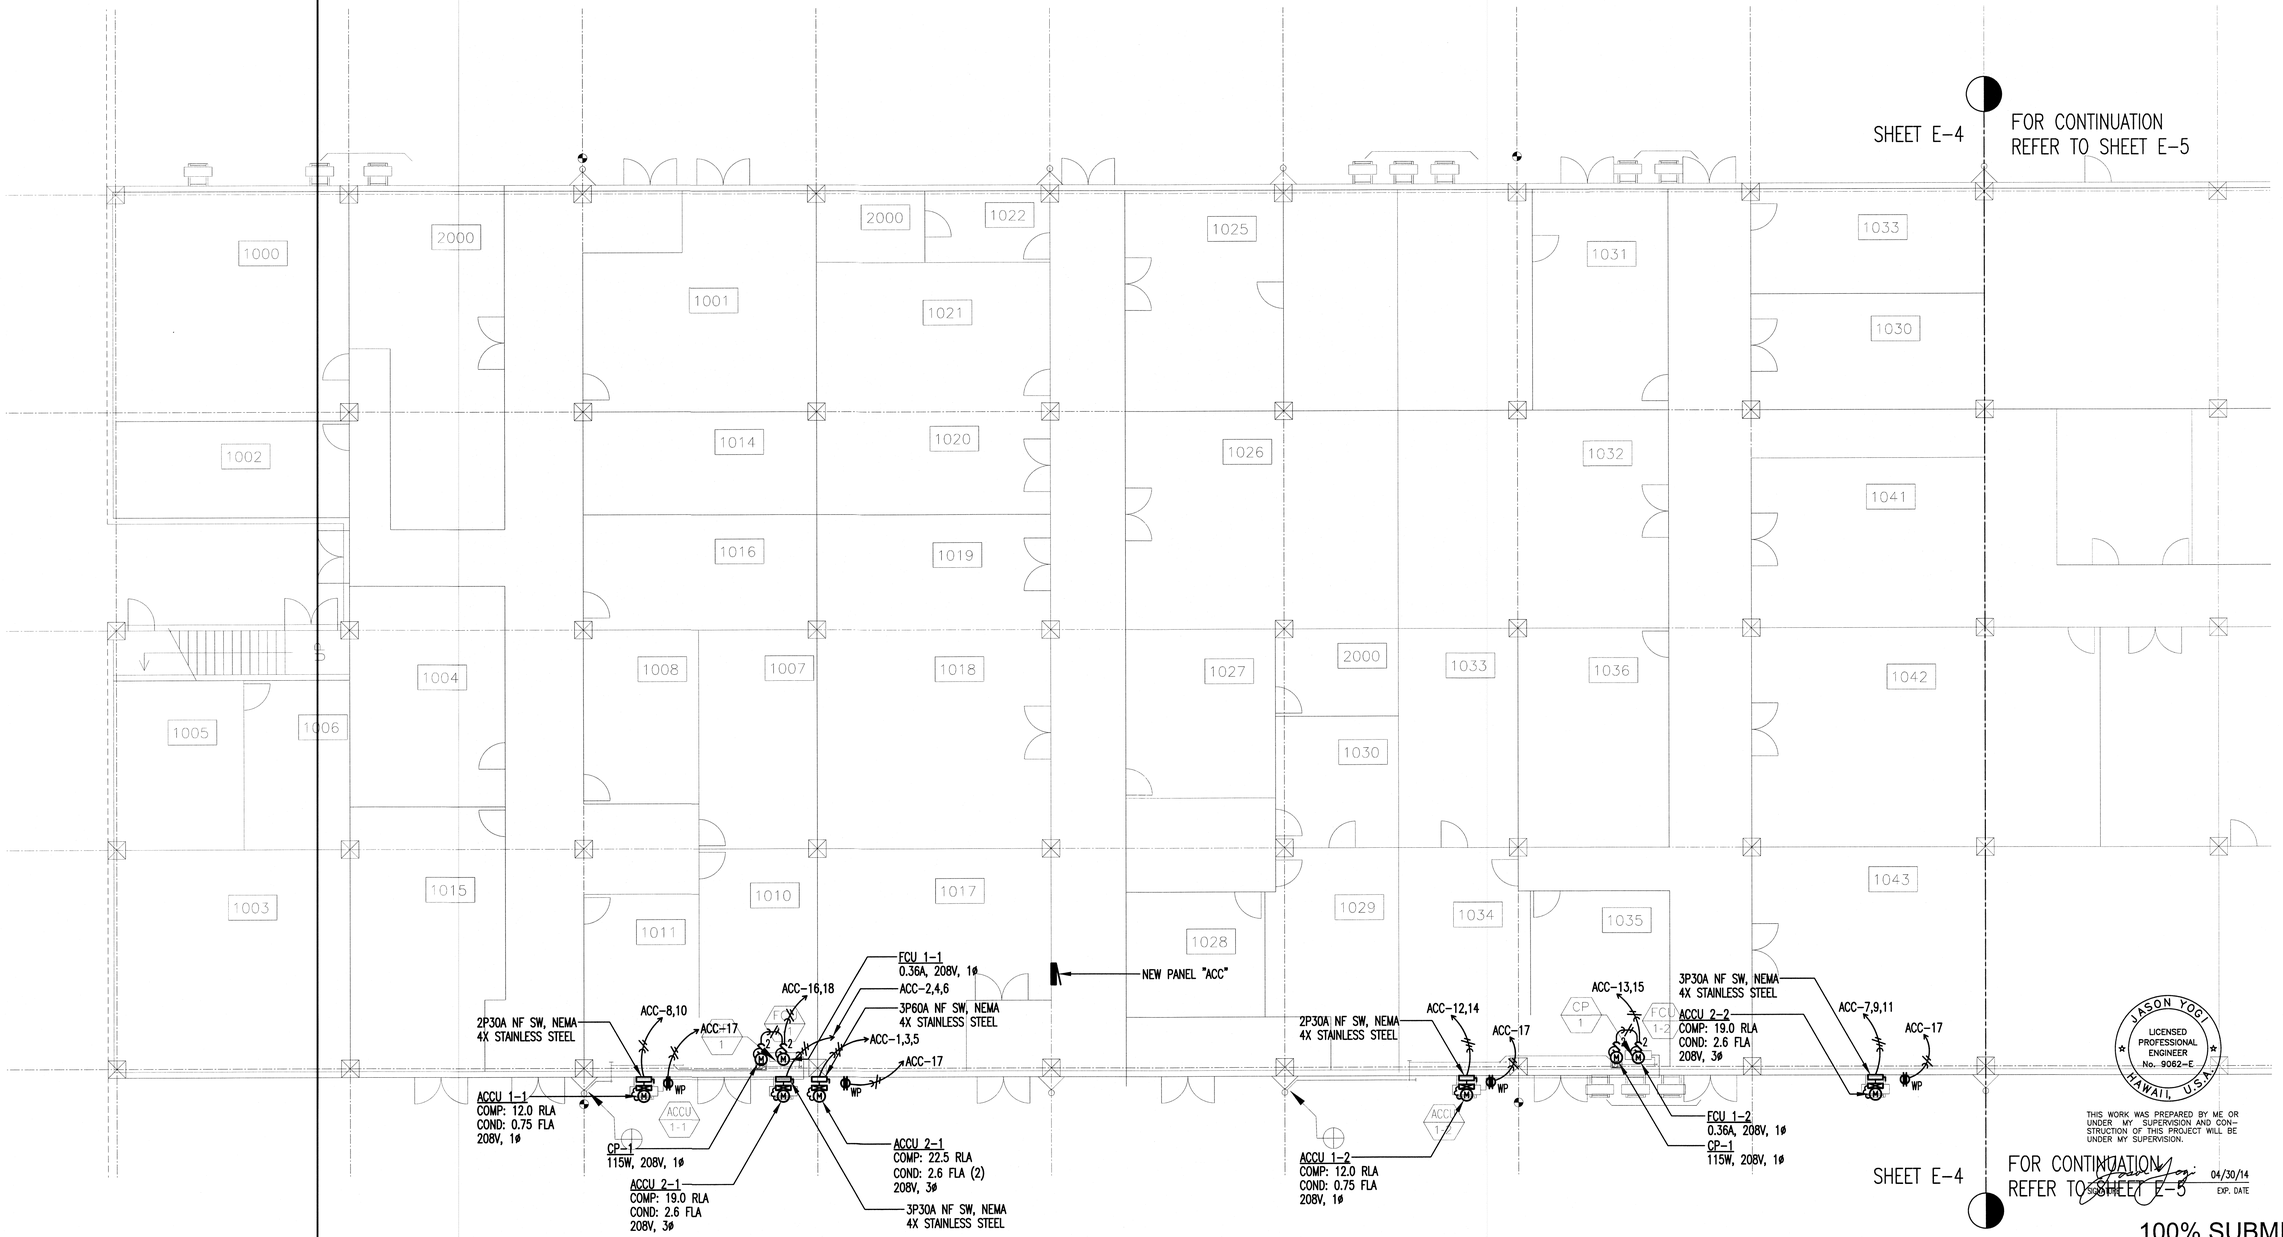

1 / E-4 PARTIAL 1ST FLOOR ELECTRICAL PLAN

SCALE: 1/8" = 1' - 0"

1/8"=1'-0" 4' 0 10' 20'

JASON YOGI
LICENSED PROFESSIONAL ENGINEER
No. 9062-E
HAWAII, U.S.A.

THIS WORK WAS PREPARED BY ME OR UNDER MY SUPERVISION AND CONSTRUCTION OF THIS PROJECT WILL BE UNDER MY SUPERVISION.

04/30/14
EXP. DATE

100% SUBMITTAL

CONFIDENTIALITY CLAUSE

THIS DESIGN IS BASED ON ECONOMY PLUMBING AND SHEETMETAL'S DESIGN COMCEPT AND SHALL NOT BE SHARED WITH ANY THIRD PARTY.

BUILDING 282 HIARNG FACILITIES KALEALOA
INSTALLATION OF ENERGY EFFICIENT DUCTLESS SPLIT AIR CONDITIONING SYSTEM
KAPOLEI, OAHU, HAWAII

CONTRACT NO.:	TASK ORDER NO.:
SCALE AS NOTED	APPROVED BY
DRAWN BY ESB	
DATE 10/30/2012	Job No. CA-1216

PARTIAL 1ST FLOOR ELECTRICAL PLAN

ECONOMY PLUMBING & SHEETMETAL, Inc.
1029 ULUPONO STREET (SAND ISLAND)
HONOLULU, HAWAII 96819

DRAWING NUMBER E-4

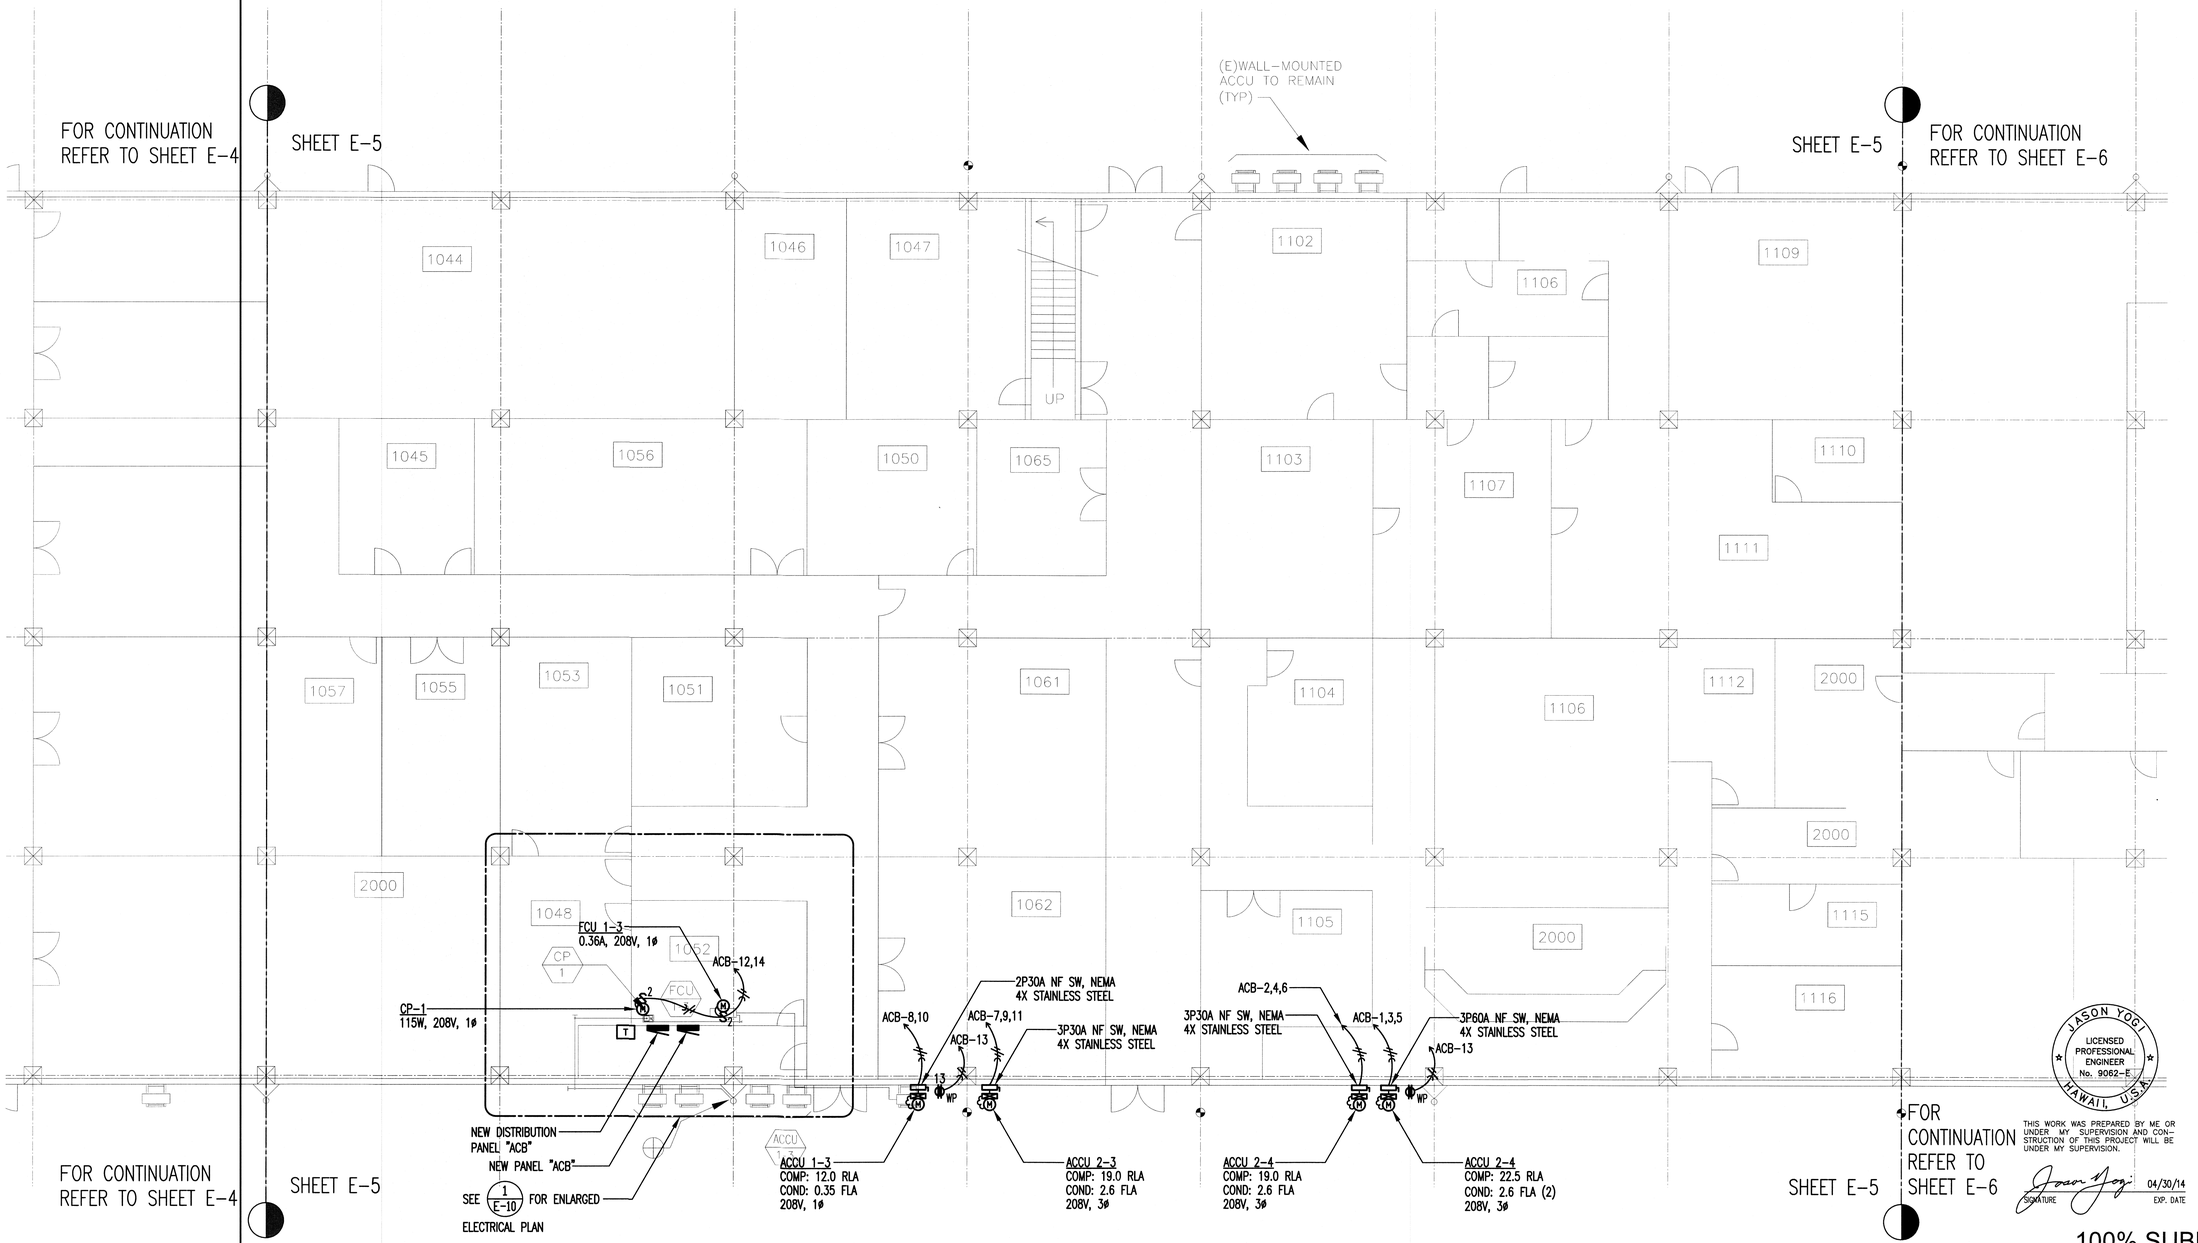

1/E-5 PARTIAL 1ST FLOOR ELECTRICAL PLAN

SCALE: 1/8" = 1' - 0"

1/8"=1'-0" 4' 0 10' 20'

JASON YOGI
LICENSED PROFESSIONAL ENGINEER
No. 9062-E
HAWAII, U.S.A.

THIS WORK WAS PREPARED BY ME OR UNDER MY SUPERVISION AND CONSTRUCTION OF THIS PROJECT WILL BE UNDER MY SUPERVISION.

SIGNATURE 04/30/14 EXP. DATE

100% SUBMITTAL

CONFIDENTIALITY CLAUSE

THIS DESIGN IS BASED ON ECONOMY PLUMBING AND SHEETMETAL'S DESIGN COMCEPT AND SHALL NOT BE SHARED WITH ANY THIRD PARTY.

BUILDING 282 HIARNG FACILITIES KALEALOA
INSTALLATION OF ENERGY EFFICIENT DUCTLESS SPLIT AIR CONDITIONING SYSTEM
KAPOLEI, OAHU, HAWAII

CONTRACT NO.:	TASK ORDER NO.:
SCALE AS NOTED	APPROVED BY
DRAWN BY ESB	
DATE 10/30/2012	Job No. CA-1216

PARTIAL 1ST FLOOR ELECTRICAL PLAN

ECONOMY PLUMBING & SHEETMETAL, Inc.
1029 ULUPONO STREET (SAND ISLAND)
HONOLULU, HAWAII 96819

DRAWING NUMBER E-5

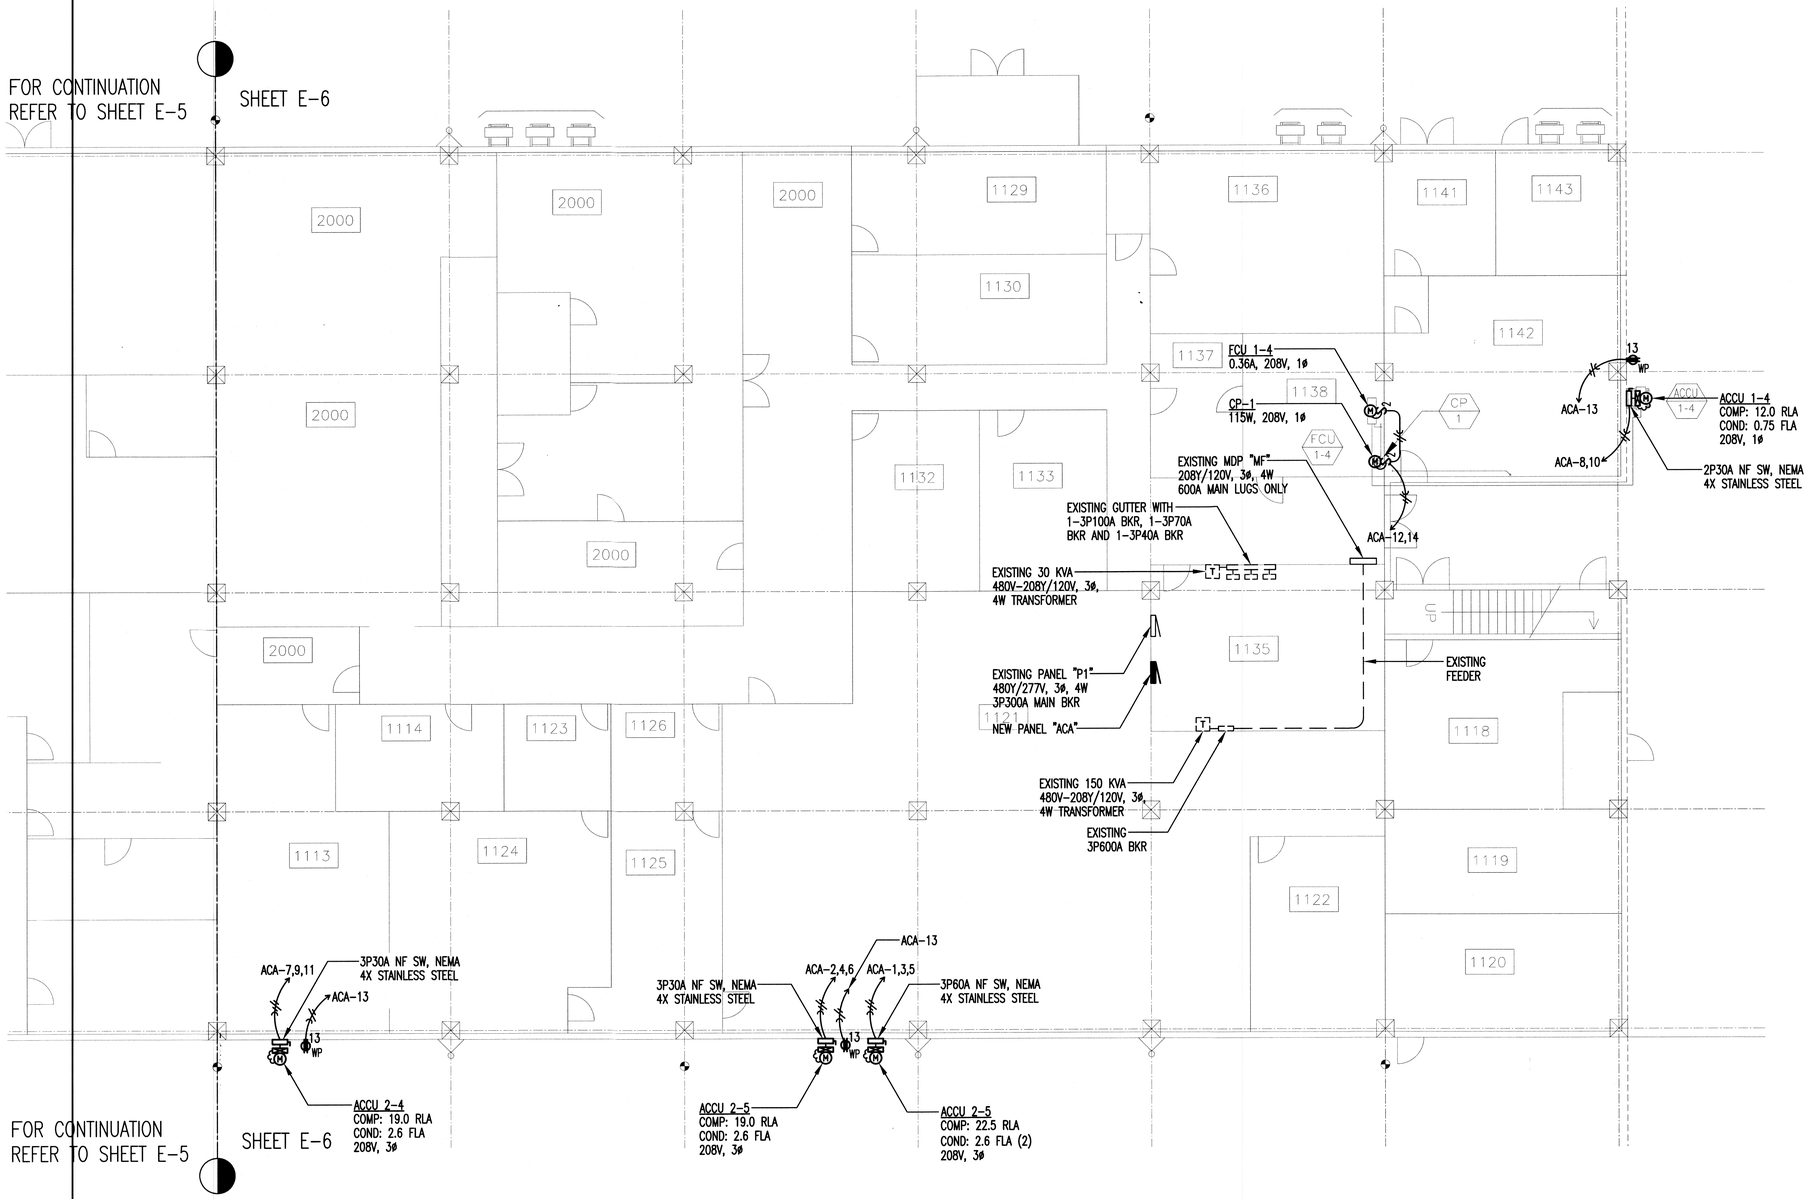

1/E-6 PARTIAL 1ST FLOOR ELECTRICAL PLAN

SCALE: 1/8" = 1' - 0"

1/8"=1'-0" 4' 0 10' 20'

JASON YOGI
LICENSED PROFESSIONAL ENGINEER
No. 9062-E
HAWAII, U.S.A.

THIS WORK WAS PREPARED BY ME OR UNDER MY SUPERVISION AND CONSTRUCTION OF THIS PROJECT WILL BE UNDER MY SUPERVISION.

SIGNATURE 04/30/14 EXP. DATE

100% SUBMITTAL

CONFIDENTIALITY CLAUSE

THIS DESIGN IS BASED ON ECONOMY PLUMBING AND SHEETMETAL'S DESIGN COMCEPT AND SHALL NOT BE SHARED WITH ANY THIRD PARTY.

BUILDING 282 HIARNG FACILITIES KALEALOA
INSTALLATION OF ENERGY EFFICIENT DUCTLESS SPLIT AIR CONDITIONING SYSTEM
KAPOLEI, OAHU, HAWAII

CONTRACT NO.:	TASK ORDER NO.:
SCALE AS NOTED	APPROVED BY
DRAWN BY ESB	
DATE 10/30/2012	Job No. CA-1216

PARTIAL 1ST FLOOR ELECTRICAL PLAN

ECONOMY PLUMBING & SHEETMETAL, Inc.
1029 ULUPONO STREET (SAND ISLAND)
HONOLULU, HAWAII 96819

DRAWING NUMBER E-6

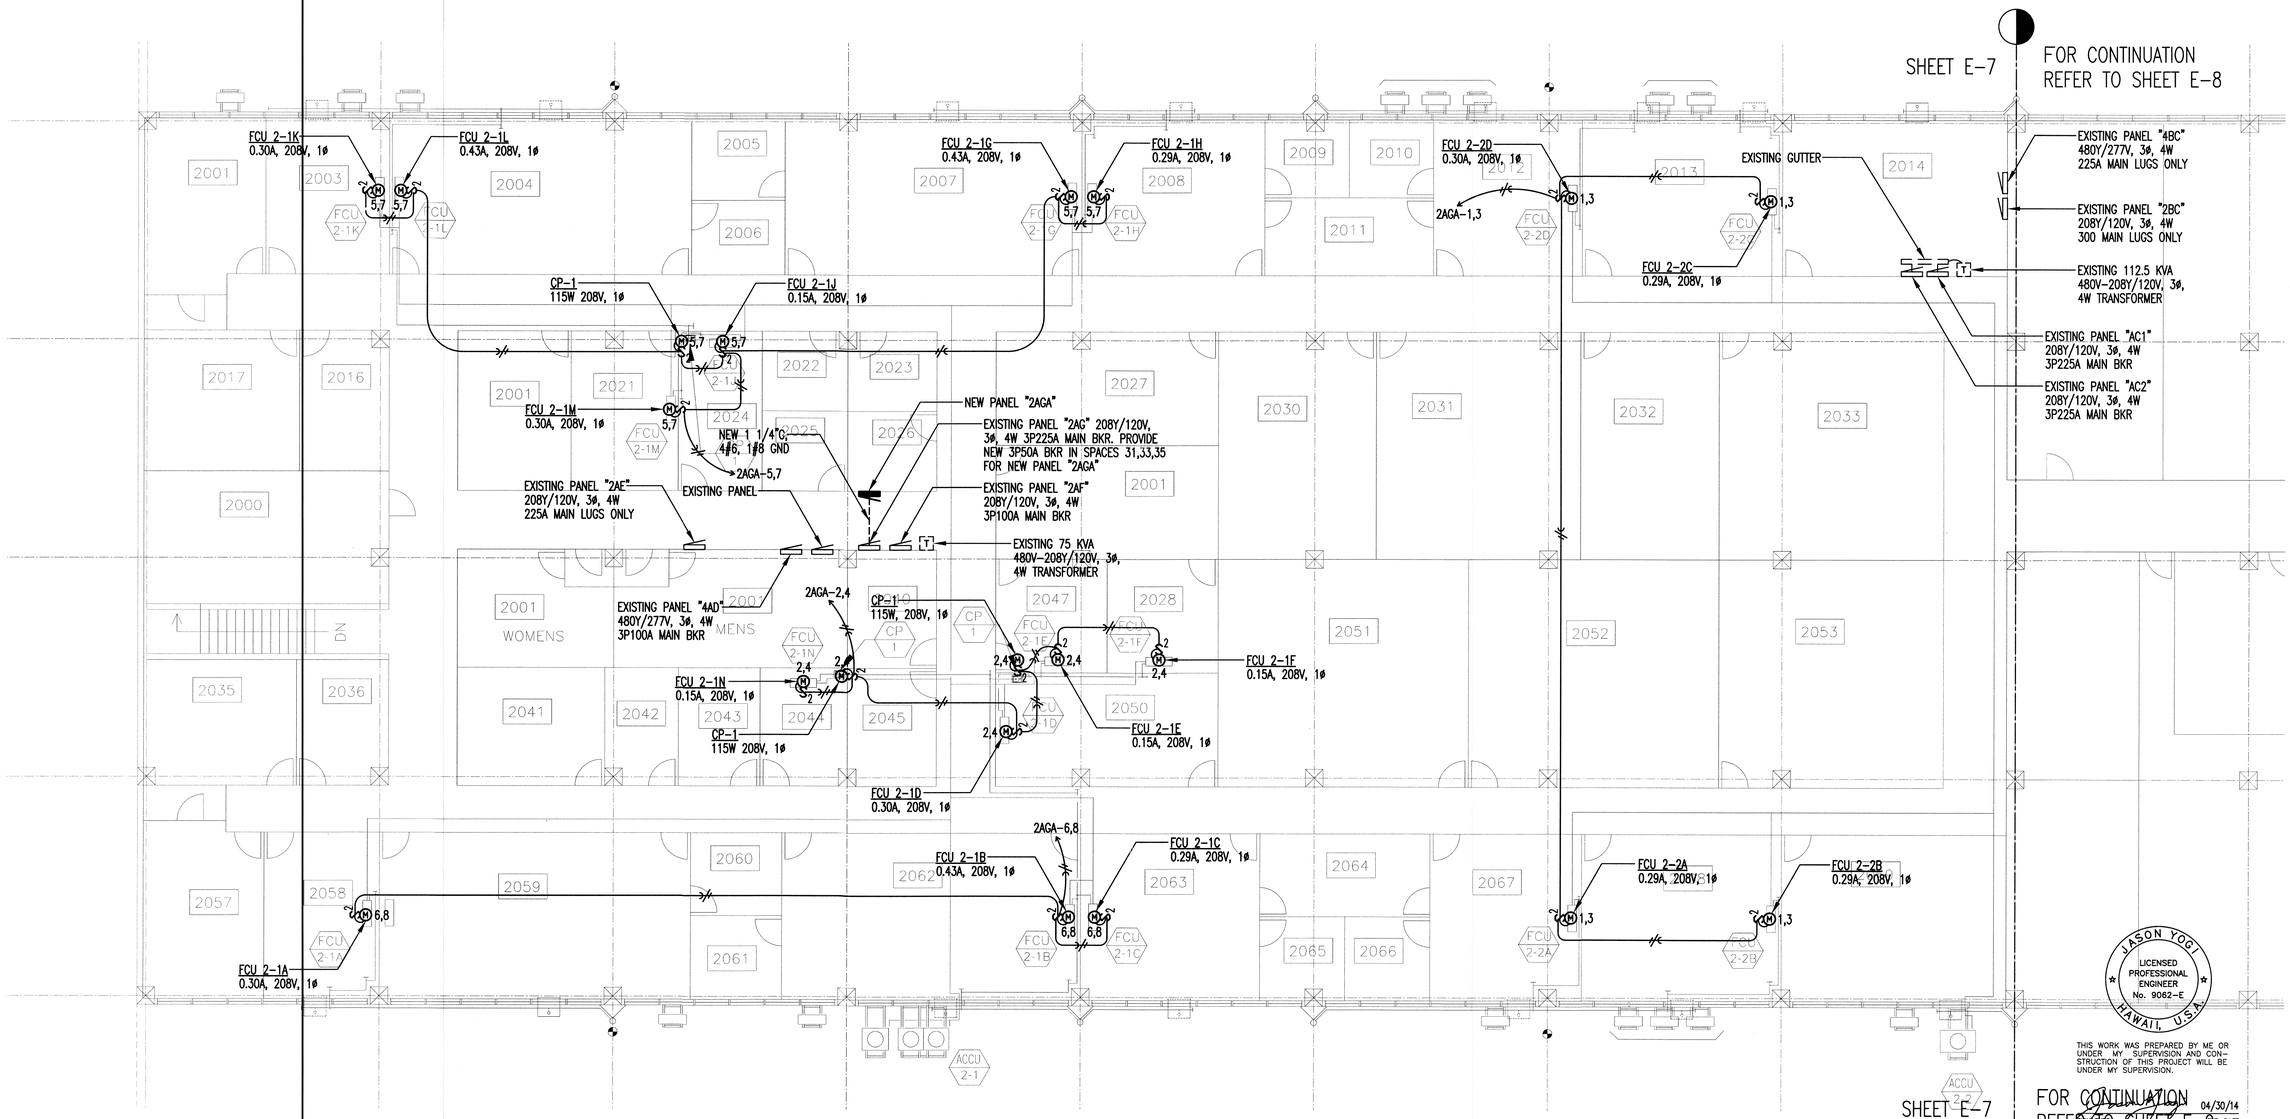

1 / E-7 PARTIAL 2ND FLOOR ELECTRICAL PLAN

SCALE: 1/8" = 1' - 0"

1/8"=1'-0" 4' 0 10' 20'

JASON YOGI
LICENSED PROFESSIONAL ENGINEER
No. 9062-E
HAWAII, USA

THIS WORK WAS PREPARED BY ME OR UNDER MY SUPERVISION AND CONSTRUCTION OF THIS PROJECT WILL BE UNDER MY SUPERVISION.

04/30/14
EXP. DATE

100% SUBMITTAL

CONFIDENTIALITY CLAUSE

THIS DESIGN IS BASED ON ECONOMY PLUMBING AND SHEETMETAL'S DESIGN COMCEPT AND SHALL NOT BE SHARED WITH ANY THIRD PARTY.

BUILDING 282 HIARNG FACILITIES KALEALOA
INSTALLATION OF ENERGY EFFICIENT DUCTLESS SPLIT AIR CONDITIONING SYSTEM
KAPOLEI, OAHU, HAWAII

CONTRACT NO.:		TASK ORDER NO.:
SCALE AS NOTED	APPROVED BY	DRAWN BY ESB
DATE 10/30/2012		Job No. CA-1216

PARTIAL 2ND FLOOR ELECTRICAL PLAN

ECONOMY PLUMBING & SHEETMETAL Inc.
1029 ULUPONO STREET (SAND ISLAND)
HONOLULU, HAWAII 96819

DRAWING NUMBER E-7

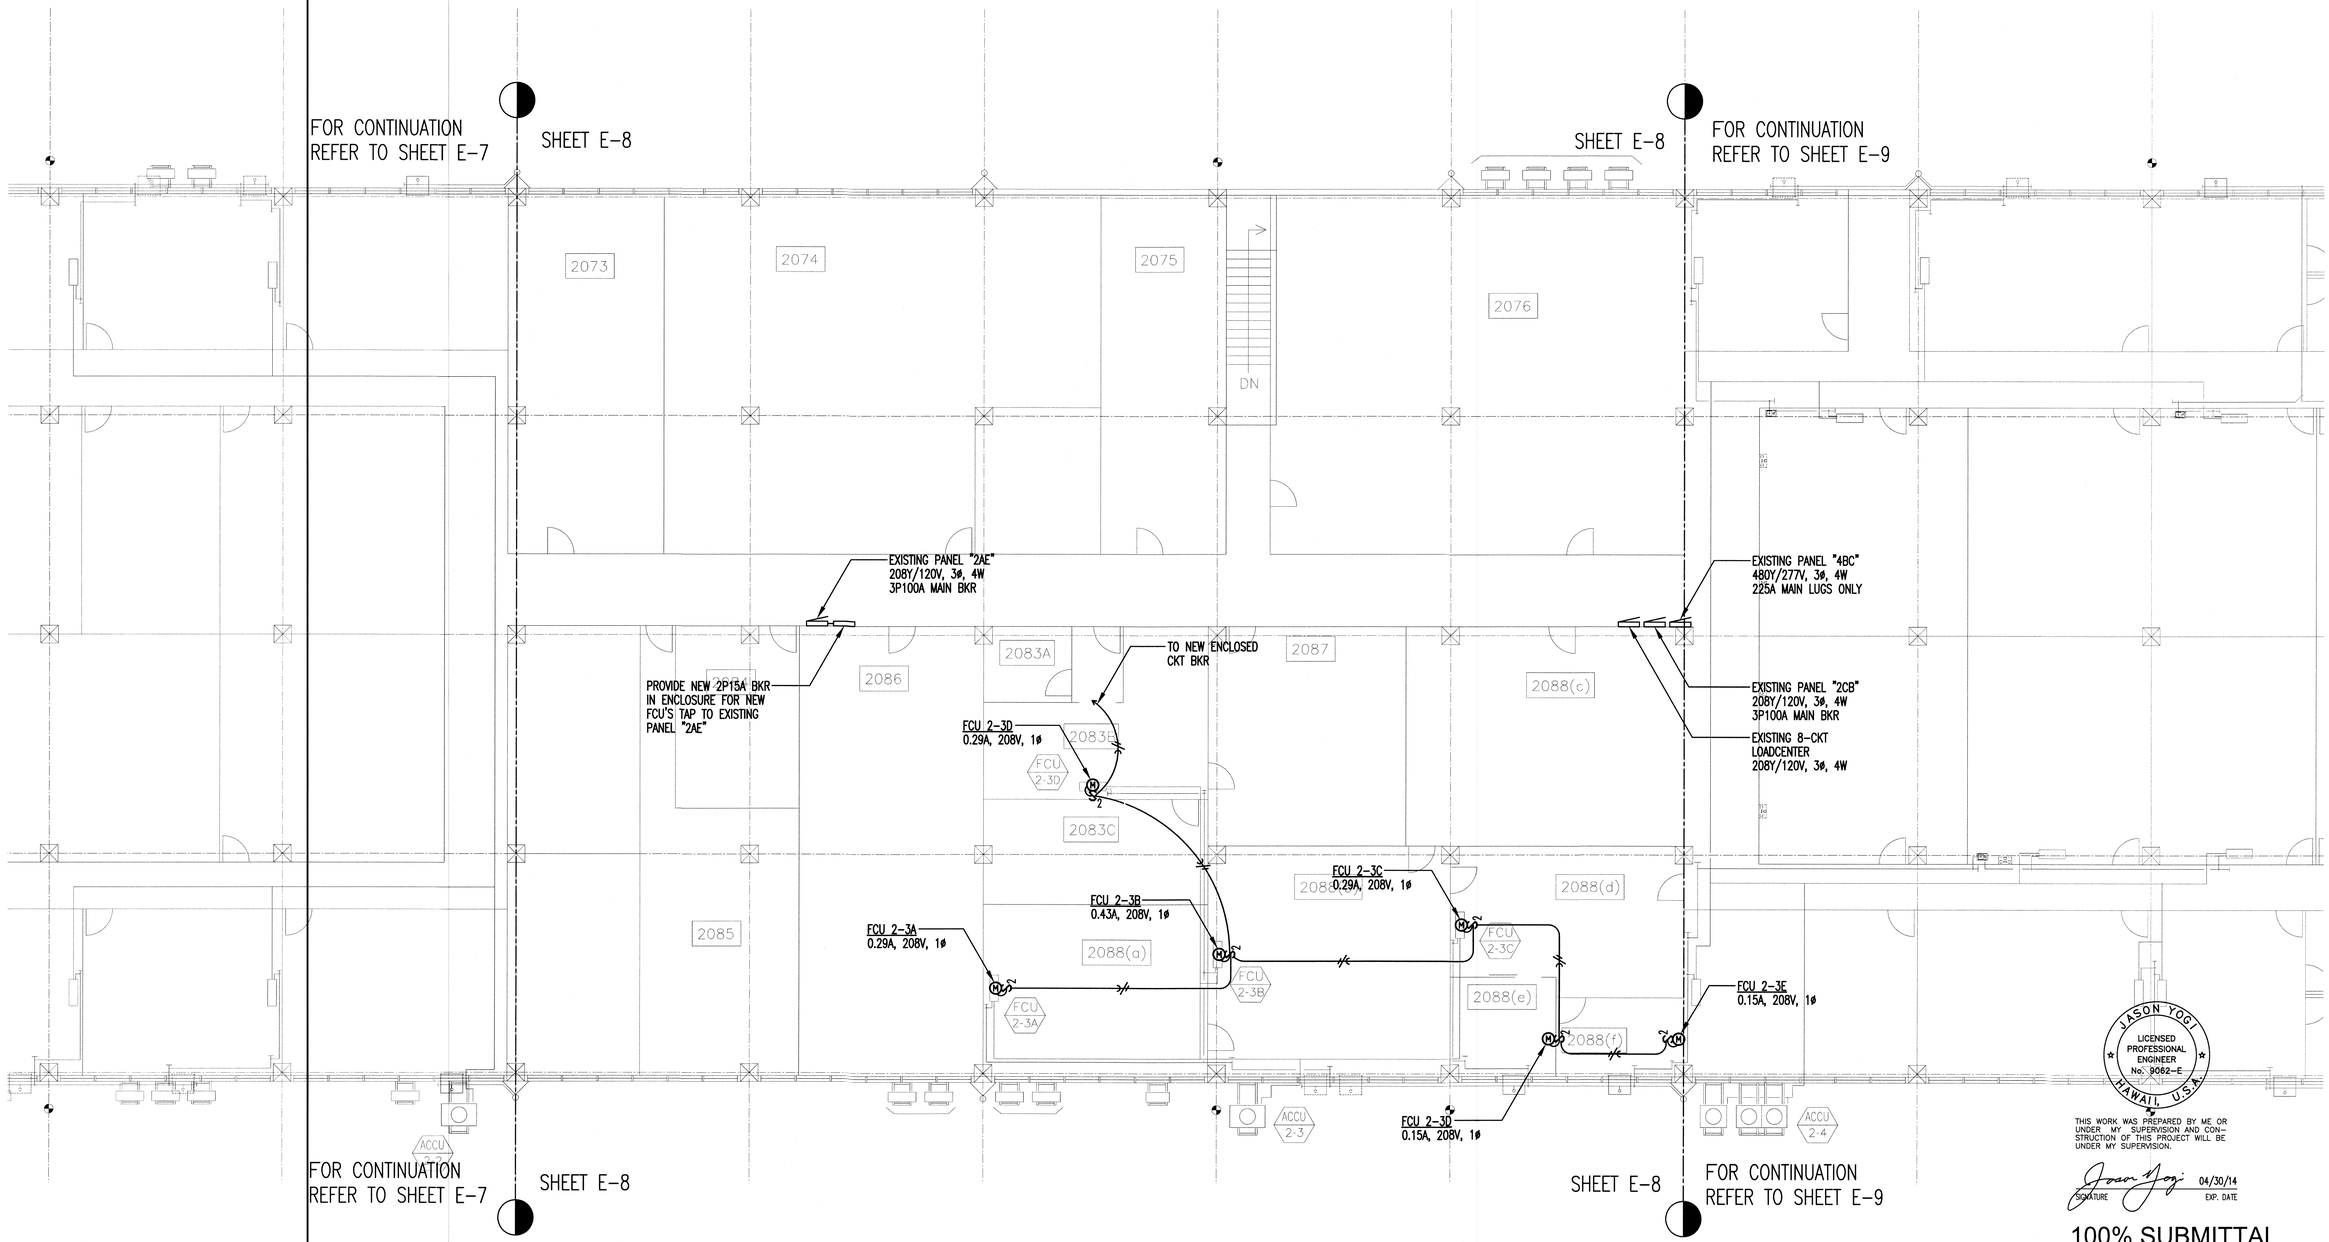

1/E-8 PARTIAL 2ND FLOOR ELECTRICAL PLAN

SCALE: 1/8" = 1' - 0"

1/8"=1'-0" 4' 0 10' 20'

JASON YOGI
LICENSED PROFESSIONAL ENGINEER
No. 9062-E
HAWAII, U.S.A.

THIS WORK WAS PREPARED BY ME OR UNDER MY SUPERVISION AND CONSTRUCTION OF THIS PROJECT WILL BE UNDER MY SUPERVISION.

SIGNATURE 04/30/14 EXP. DATE

100% SUBMITTAL

CONFIDENTIALITY CLAUSE

THIS DESIGN IS BASED ON ECONOMY PLUMBING AND SHEETMETAL'S DESIGN COMCEPT AND SHALL NOT BE SHARED WITH ANY THIRD PARTY.

BUILDING 282 HIARNG FACILITIES KALEALOA
INSTALLATION OF ENERGY EFFICIENT DUCTLESS SPLIT AIR CONDITIONING SYSTEM
KAPOLEI, OAHU, HAWAII

CONTRACT NO.:	TASK ORDER NO.:
SCALE AS NOTED	APPROVED BY
DRAWN BY ESB	
DATE 10/30/2012	Job No. CA-1216

PARTIAL 2ND FLOOR ELECTRICAL PLAN

ECONOMY PLUMBING & SHEETMETAL, Inc.
1029 ULUPONO STREET (SAND ISLAND)
HONOLULU, HAWAII 96819

DRAWING NUMBER E-8

FOR CONTINUATION
REFER TO SHEET E-8

SHEET E-9

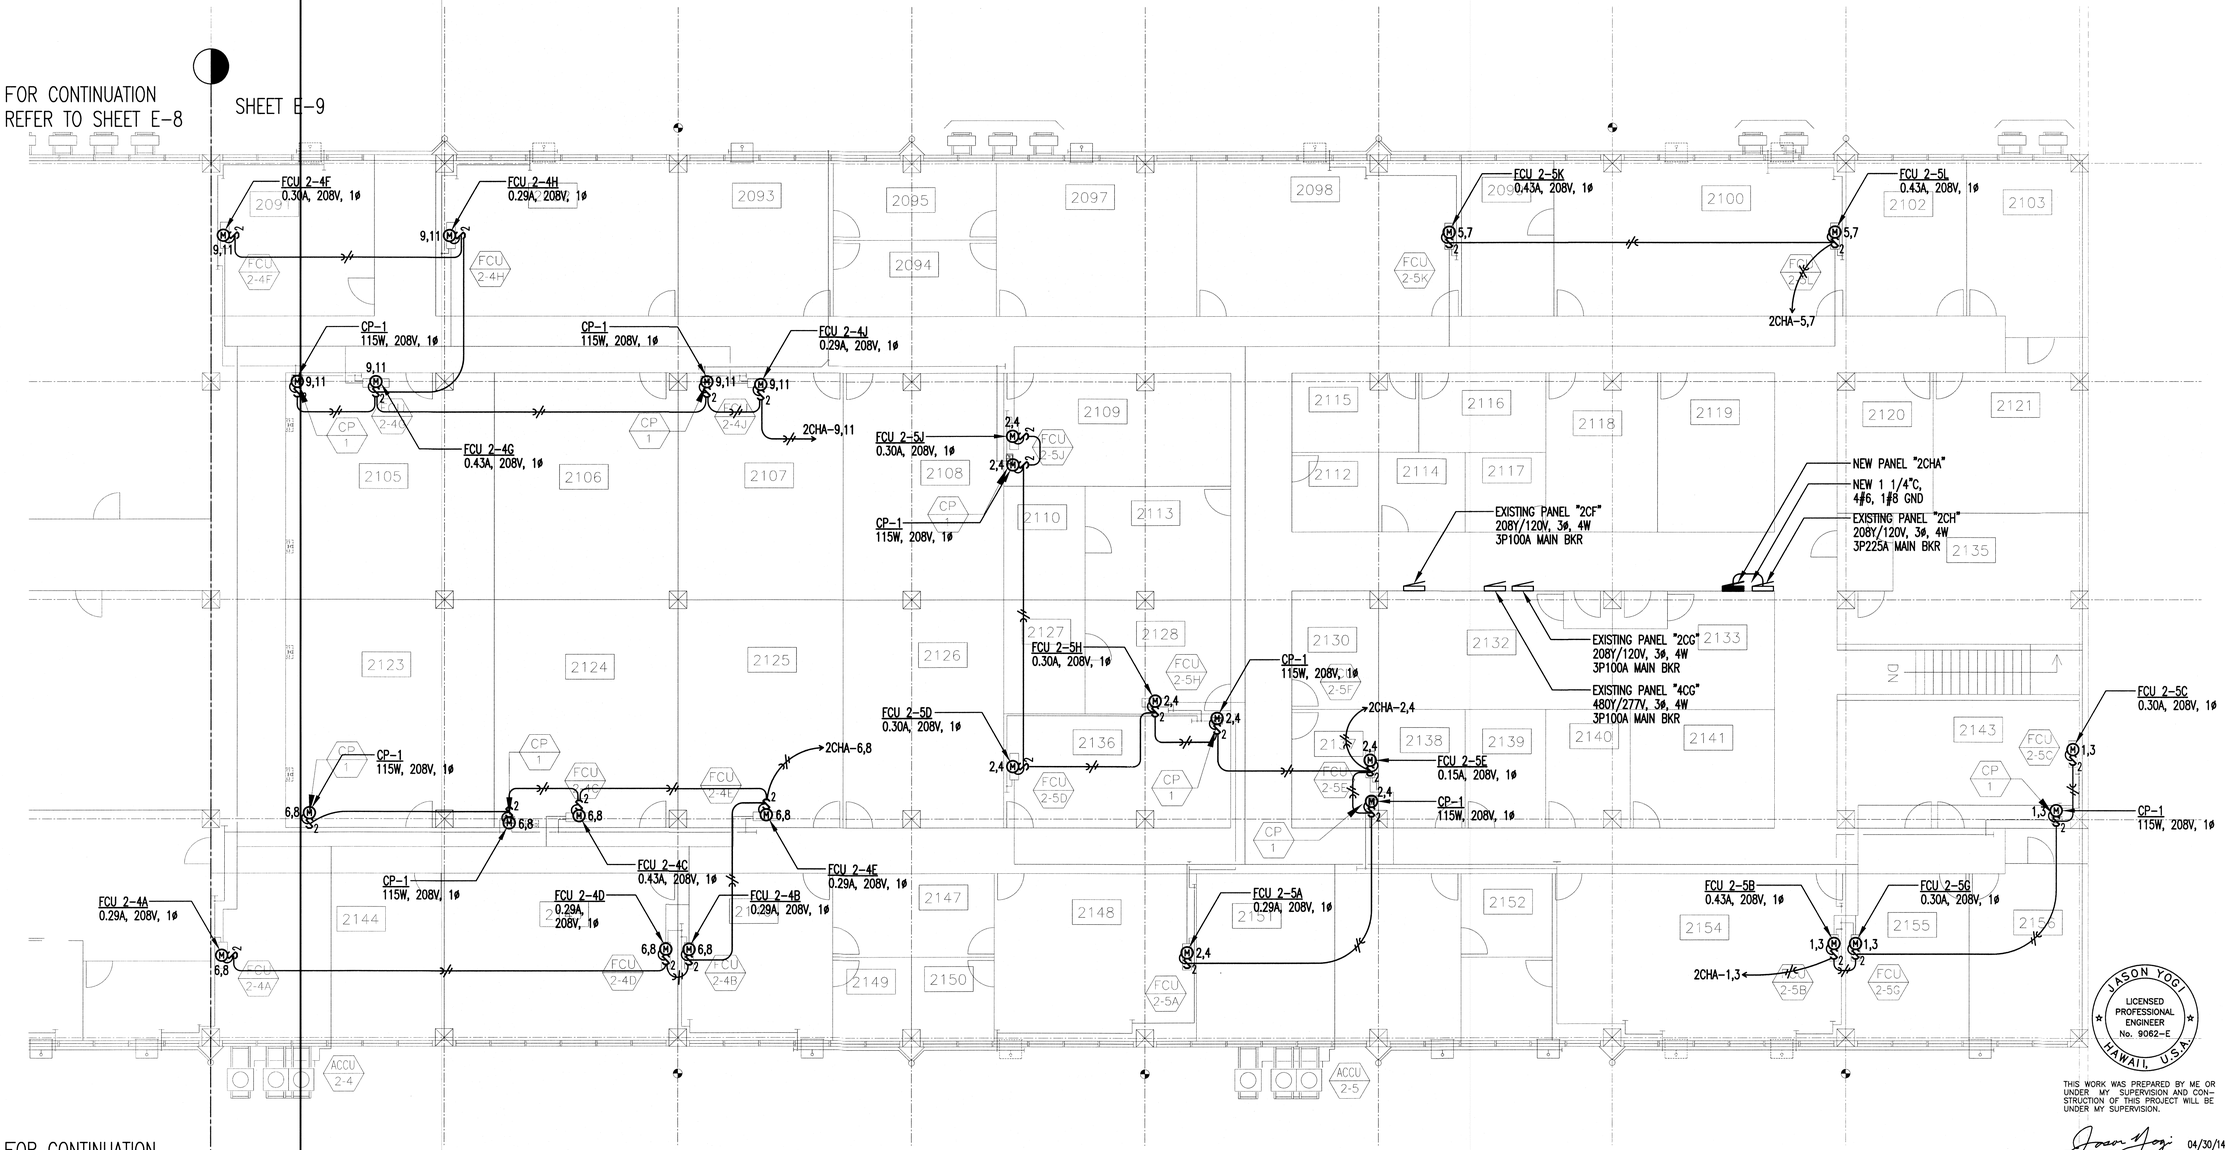

FOR CONTINUATION
REFER TO SHEET E-8

SHEET E-9

1/E-9 PARTIAL 2ND FLOOR ELECTRICAL PLAN

SCALE: 1/8" = 1' - 0"

1/8"=1'-0" 4' 0 10' 20'

JASON YOGI
LICENSED PROFESSIONAL ENGINEER
No. 9062-E
HAWAII, U.S.A.

THIS WORK WAS PREPARED BY ME OR UNDER MY SUPERVISION AND CONSTRUCTION OF THIS PROJECT WILL BE UNDER MY SUPERVISION.

SIGNATURE 04/30/14 EXP. DATE

100% SUBMITTAL

CONFIDENTIALITY CLAUSE
THIS DESIGN IS BASED ON ECONOMY PLUMBING AND SHEETMETAL'S DESIGN COMCEPT AND SHALL NOT BE SHARED WITH ANY THIRD PARTY.

BUILDING 282 HIARNG FACILITIES KALEALOA
INSTALLATION OF ENERGY EFFICIENT DUCTLESS SPLIT AIR CONDITIONING SYSTEM
KAPOLEI, OAHU, HAWAII

CONTRACT NO.:	TASK ORDER NO.:
SCALE AS NOTED	APPROVED BY
DRAWN BY ESB	
DATE 10/30/2012	Job No. CA-1216

PARTIAL 2ND FLOOR ELECTRICAL PLAN

ECONOMY PLUMBING & SHEETMETAL, Inc.
1029 ULUPONO STREET (SAND ISLAND)
HONOLULU, HAWAII 96819

DRAWING NUMBER E-9

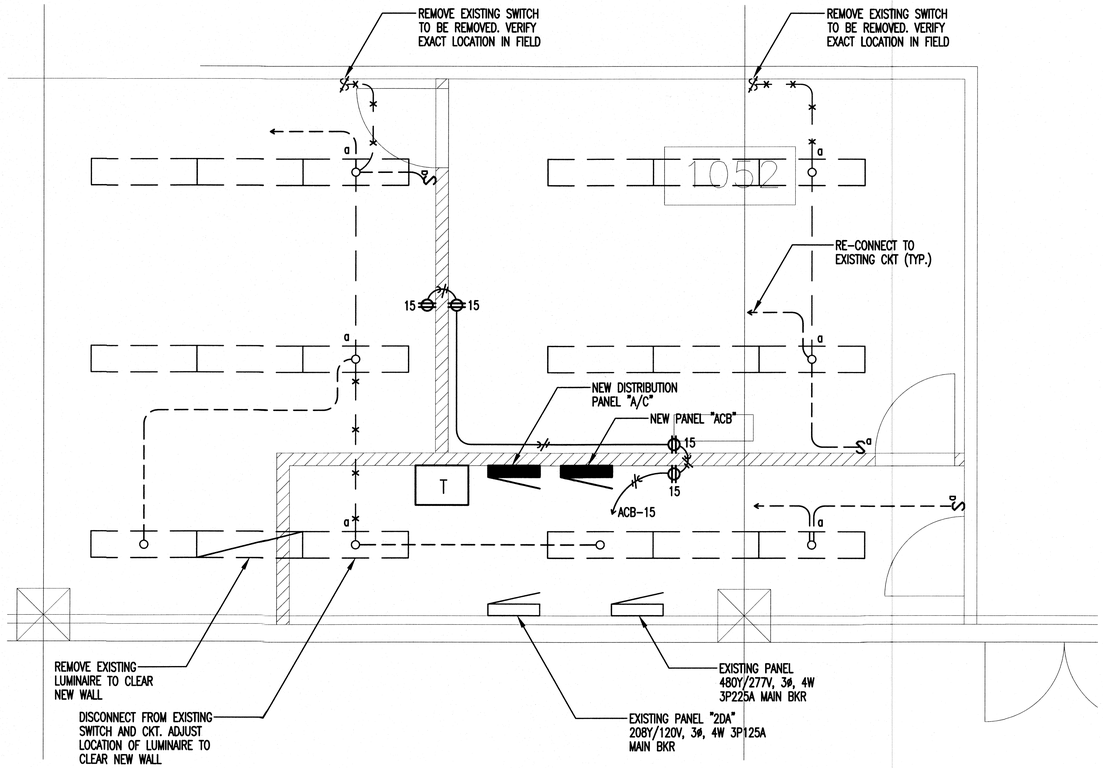

1 / E-8 ELECTRICAL PLAN (ROOM 1052)

SCALE: 3/8" = 1' - 0"

3/8"=1'-0" 2' 0 5' 10'

JASON YOGI
LICENSED PROFESSIONAL ENGINEER
No. 9062-E
HAWAII, U.S.A.

THIS WORK WAS PREPARED BY ME OR UNDER MY SUPERVISION AND CONSTRUCTION OF THIS PROJECT WILL BE UNDER MY SUPERVISION.

SIGNATURE 04/30/14 EXP. DATE

100% SUBMITTAL

CONFIDENTIALITY CLAUSE

THIS DESIGN IS BASED ON ECONOMY PLUMBING AND SHEETMETAL'S DESIGN COMCEPT AND SHALL NOT BE SHARED WITH ANY THIRD PARTY.

BUILDING 282 HIARNG FACILITIES KALEALOA
INSTALLATION OF ENERGY EFFICIENT DUCTLESS SPLIT AIR CONDITIONING SYSTEM
KAPOLEI, OAHU, HAWAII

CONTRACT NO.:		TASK ORDER NO.:
SCALE AS NOTED	APPROVED BY	DRAWN BY ESB
DATE 10/30/2012		Job No. CA-1216

ELECTRICAL PLAN (ROOM 1052)

ECONOMY PLUMBING & SHEETMETAL, Inc.
1029 ULUPONO STREET (SAND ISLAND)
HONOLULU, HAWAII 96819

DRAWING NUMBER E-10

NEW DIST PANEL "A/C" 208Y/120 VOLTS 3ø, 4WSN
3P400A MAIN BKR BRANCH BKR I.C. 10,000 AMPS
SURFACE, 20" WIDE CABINET, INDUSTRIAL-BOLTED

CKT NO.	BKR	LOAD	KVA A	KVA B	KVA C	WIRE
1,3,5	3P100A	NEW PANEL "ACA"	10.5	9.8	8.6	#1/0
2,4,6	3P100A	NEW PANEL "ACB"	10.3	10.6	8.6	#1/0
7,9,11	3P125A	NEW PANEL "ACC"	11.2	8.7	10.7	#1/0
8,10,12	3P100A	P F B				
13,15,17	3P100A	P F B				
14,16,18	3P100A	P F B				
19,21,23	3P100A	P F B				
20,22,24	3P100A	P F B				
TOTAL			32.0	29.1	27.9	

NEW PANEL "ACA" 208Y/120 VOLTS 3ø, 4WSN
3P100A MAIN BKR BRANCH BKR I.C. 10,000 AMPS
SURFACE, 20" WIDE CABINET, INDUSTRIAL-BOLTED

CKT NO.	BKR	LOAD	KVA A	KVA B	KVA C	WIRE
1,3,5	3P50A	ACCU 2-5	3.3	3.3	3.3	6
2,4,6	3P40A	ACCU 2-5	2.6	2.6	2.6	6
7,9,11	3P40A	ACCU 2-4	2.6	2.6	2.6	6
8,10,12	3P20A	ACCU 1-4	1.3	1.3		10
12,14	2P15A	FCU 1-4/CP-1	0.1		0.1	12
13	1P20A	RECEP	0.6			12
15	1P	P F B				
16						
17						
18						
19						
20						
21						
22						
23						
24						
TOTAL			10.5	9.8	8.6	

NEW PANEL "ACB" 208Y/120 VOLTS 3ø, 4WSN
100A MAIN LUGS ONLY BRANCH BKR I.C. 10,000 AMPS
SURFACE, 20" WIDE CABINET, INDUSTRIAL-BOLTED

CKT NO.	BKR	LOAD	KVA A	KVA B	KVA C	WIRE
1,3,5	3P50A	ACCU 2-4	3.3	3.3	3.3	6
2,4,6	3P40A	ACCU 2-4	2.6	2.6	2.6	6
7,9,11	3P40A	ACCU 2-3	2.6	2.6	2.6	6
8,10,12	3P20A	ACCU 1-3	1.3	1.3		10
12,14	2P15A	FCU 1-3/CP-1	0.1		0.1	12
13	1P20A	RECEP	0.4			12
15	1P20A	RECEP		0.8		12
16	1P	P F B				
17						
18						
19						
20						
21						
22						
23						
24						
TOTAL			10.3	10.6	8.6	

NEW PANEL "ACC" 208Y/120 VOLTS 3ø, 4WSN
3P125A MAIN BKR BRANCH BKR I.C. 10,000 AMPS
SURFACE, 20" WIDE CABINET, INDUSTRIAL-BOLTED

CKT NO.	BKR	LOAD	KVA A	KVA B	KVA C	WIRE
1,3,5	3P50A	ACCU 2-1	3.3	3.3	3.3	6
2,4,6	3P40A	ACCU 2-1	2.6	2.6	2.6	6
7,9,11	3P40A	ACCU 2-2	2.6	2.6	2.6	6
8,10,12	2P20A	ACCU 1-1	1.3			10
12,14	2P20A	ACCU 1-2	1.3		1.3	10
13,15	2P15A	FCU 1-2/CP-1	0.1	0.1		12
16	2P15A	FCU 1-1/CP-1		0.1	0.1	12
17	1P20A	RECEP			0.8	12
18	1P	P F B				
19						
20						
21						
22						
23						
24						
25						
26						
27						
28						
29						
30						
TOTAL			11.2	8.7	10.7	

NEW PANEL "2AGA" 208Y/120 VOLTS 3ø, 4WSN
100A MAIN LUGS ONLY BRANCH BKR I.C. 10,000 AMPS
SURFACE, 20" WIDE CABINET, INDUSTRIAL-BOLTED

CKT NO.	BKR	LOAD	KVA A	KVA B	KVA C	WIRE
1,3	2P15A	FCU'S 2-2A TO 2-2D	0.2	0.2		12
2,4	2P15A	FCU'S 2-1D TO 2-1F, 2-1M/CP-1	0.2	0.2		12
5,7	2P15A	FCU'S 2-1G TO 2-1H, 2-1J TO 2-1M/CP-1	0.3		0.3	12
6,8	2P15A	FCU'S 2-1A TO 2-1B	0.1		0.1	12
9	1P	P F B				
10						
11						
12						
TOTAL			0.8	0.4	0.4	

NEW PANEL "2CHA" 208Y/120 VOLTS 3ø, 4WSN
3P50A MAIN BKR BRANCH BKR I.C. 10,000 AMPS
SURFACE, 20" WIDE CABINET, INDUSTRIAL-BOLTED

CKT NO.	BKR	LOAD	KVA A	KVA B	KVA C	WIRE
1,3	2P15A	FCU'S 2-5B, 2-5G, 2-5C/CP-1	0.2	0.2		12
2,4	2P15A	FCU'S 2-5A, 2-5D, 2-5E, 2-5J/CP-1	0.3	0.3		12
5,7	2P15A	FCU'S 2-5K, 2-5L	0.1		0.1	12
6,8	2P15A	FCU'S 2-4A, 2-4E/CP-1	0.3		0.3	12
9,11	2P15A	FCU'S 2-4F, 2-4G, 2-4H, 2-4J/CP-1		0.3	0.3	12
10	1P	P F B				
12	1P	P F B				
TOTAL			0.9	0.8	0.7	

JASON YOGI
LICENSED PROFESSIONAL ENGINEER
No. 9062-E
HAWAII, U.S.A.

THIS WORK WAS PREPARED BY ME OR UNDER MY SUPERVISION AND CONSTRUCTION OF THIS PROJECT WILL BE UNDER MY SUPERVISION.

SIGNATURE 04/30/14 EXP. DATE

100% SUBMITTAL

CONFIDENTIALITY CLAUSE
THIS DESIGN IS BASED ON ECONOMY PLUMBING AND SHEETMETAL'S DESIGN COMCEPT AND SHALL NOT BE SHARED WITH ANY THIRD PARTY.

BUILDING 282 HIARNG FACILITIES KALEALOA
INSTALLATION OF ENERGY EFFICIENT
DUCTLESS SPLIT AIR CONDITIONING SYSTEM
KAPOLEI, OAHU, HAWAII

CONTRACT NO.: TASK ORDER NO.:
SCALE AS NOTED APPROVED BY DRAWN BY ESB
DATE 10/30/2012 Job No. CA-1216

PANEL SCHEDULES

ECONOMY PLUMBING & SHEETMETAL, Inc.
1029 ULUPONO STREET (SAND ISLAND)
HONOLULU, HAWAII 96819

DRAWING NUMBER E-11

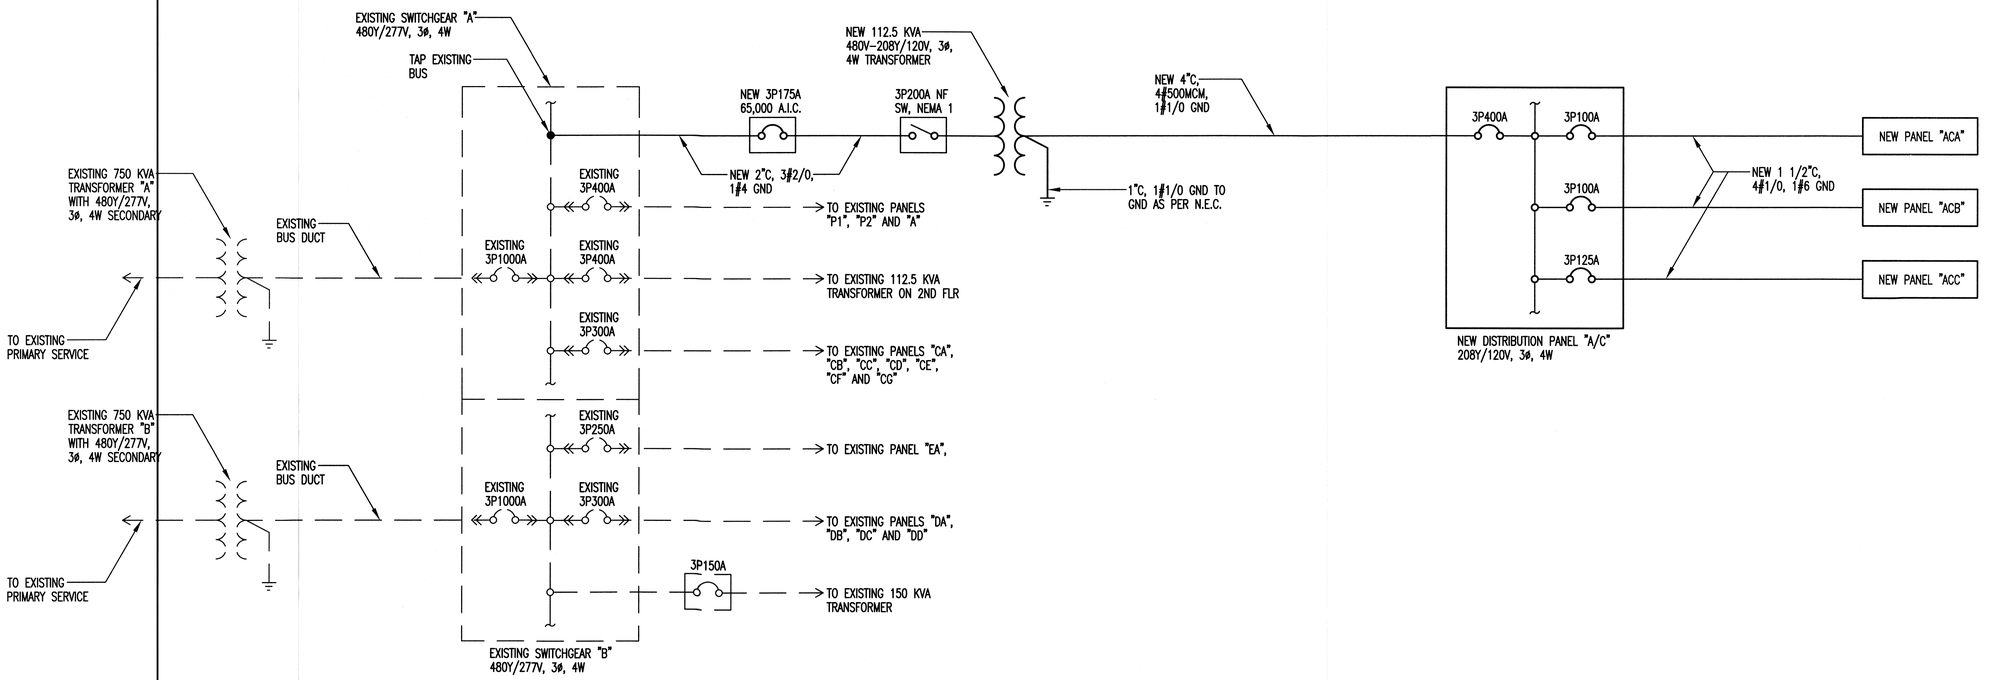

NOTES:

1. CONTRACTOR SHALL COORDINATE ALL OUTAGES WITH THE GOVERNMENT.

SINGLE LINE DIAGRAM

JASON YOGI
LICENSED PROFESSIONAL ENGINEER
No. 9062-E
HAWAII, U.S.A.

THIS WORK WAS PREPARED BY ME OR UNDER MY SUPERVISION AND CONSTRUCTION OF THIS PROJECT WILL BE UNDER MY SUPERVISION.

SIGNATURE 04/30/14 EXP. DATE

100% SUBMITTAL

CONFIDENTIALITY CLAUSE
THIS DESIGN IS BASED ON ECONOMY PLUMBING AND SHEETMETAL'S DESIGN COMCEPT AND SHALL NOT BE SHARED WITH ANY THIRD PARTY.

BUILDING 282 HIARNG FACILITIES KALEALOA
INSTALLATION OF ENERGY EFFICIENT
DUCTLESS SPLIT AIR CONDITIONING SYSTEM
KAPOLEI, OAHU, HAWAII

CONTRACT NO.:	TASK ORDER NO.:	
SCALE AS NOTED	APPROVED BY	DRAWN BY ESB
DATE 10/30/2012		Job No. CA-1216

SINGLE LINE DIAGRAM

ECONOMY PLUMBING & SHEETMETAL, Inc.
1029 ULUPONO STREET (SAND ISLAND)
HONOLULU, HAWAII 96819

DRAWING NUMBER E-12