

STATE OF HAWAII
DEPARTMENT OF DEFENSE
ENGINEERING OFFICE
3949 DIAMOND HEAD ROAD
HONOLULU, HAWAII 96816-4495

MARCH 25, 2024

ADDENDUM NO. 1

TO CONSTRUCT **BIRKHIMER EMERGENCY OPERATIONS CENTER (EOC)
UPGRADES AND IMPROVEMENTS
PROJECT NO.: CA-202313-C
TAX MAP KEY: 3-1-042:600
Honolulu, Oahu, HAWAII**

FOR THE **DEPARTMENT OF DEFENSE
ENGINEERING OFFICE
STATE OF HAWAII**

ISSUED BY **STATE OF HAWAII DEPARTMENT OF DEFENSE 3949
DIAMOND HEAD ROAD, HONOLULU, HAWAII
96816-4495
TELEPHONE: 808-369-3567**

This addendum modifies the original Solicitation Documents for the Project dated March 1, 2024. The items in this addendum shall govern the work, taking precedence over previously issued specifications and drawings governing the items mentioned. Acknowledge receipt of this Addendum in the space provided on the Solicitation, Offer and Contract Form.

A. **CHANGES TO SPECIFICATIONS:** The following pages of the Solicitation Documents are revised:

1. Revised Text:

1. Replace the following sections in their entirety:
 - i. SECTION 08410 – ALUMINUM FRAMED STOREFRONT
 - ii. SECTION 08810 – GLAZING
 - iii. OFFER FORM (OF 1-11)
 - iv. SECTION 00010 – TABLE OF CONTENTS
 - v. SECTION 01100 – PROJECT REQUIREMENTS
 - vi. SECTION 15606 – POL SYSTEMS
 - vii. SECTION 15607 – NONMETALLIC UNDERGROUND PIPING FOR PETROLEUM
- b. Make the following updates:
 - i. SECTION SN, Page SN-10, Replace “After the contract” with “Sometime after the contract”.
 - ii. SECTION 01100, Page 01100-10, Paragraph 1.12.A, Replace “Allowance i: Include” with “Bid Allowance will include”

B. **CHANGES TO PLANS:** The following items are revised:

1. The following previously issued drawing set dated March 1, 2024, are replaced in their entirety. Significant changes to the drawings are listed below.

Sheet Group	Sheet No.	Sheet Name, Description
SHEET TITLE	001	Updated TMK to 3-1-042:006 Updated zip code to 96816
SHEET TITLE	ALL SHEETS	TITLE BLOCK Inserted new TMK and zip code

ARCHITECTURAL	AA101	<p>OVERALL FLOOR AND CEILING DEMO</p> <p>Revised demolition keynote to include “salvage and store existing window screen and associated frame for reinstallation.”</p>
ARCHITECTURAL	AA701	<p>SCHEDULE TYPES AND DETAILS</p> <ul style="list-style-type: none"> • Added “ASTM E 1996/1886 large missile impact (windborne debris)” to window schedule remarks. • Revised window detail graphics to represent new window • Revised existing frame graphics to more accurately represent existing condition • Revised window screen keynote to “Reinstall existing window screen, clips, and frame to match existing adjacent” • Revised window height in schedule.
ARCHITECTURAL	AB102	<p>OVERALL FLOOR PLAN AND CEILING</p> <p>Added note to temporarily remove door frame for AHU-2 installation.</p>
ARCHITECTURAL	AB103	<p>GENERATOR ROOM ROOF PLAN</p> <ul style="list-style-type: none"> • Relocated mechanical equipment off the roof, revised note to include support posts • Removed built out concrete pad and associated notes and dimensions
CIVIL	C001	Added Geotechnical report reference
CIVIL	C101	<p>Added soils Borehole locations</p> <p>Shifted new fuel tank to the north</p> <p>Added removal of existing 18” storm drain pipe</p>
CIVIL	CS101	<p>Revised limits of re-paving</p> <p>Added spot elevations for pavement</p> <p>Revised grading at ADA parking area</p> <p>Added sediment removal from existing drain inlet</p> <p>Added pavement removal and re-pave detail</p>

CIVIL	CS501	Add pavement structure detail Added wheel stop detail Added sign post detail Added stair detail
CIVIL	CS502	Revised gate detail to pedestrian gate
CIVIL	CG101	Revised tank location and retaining walls Elevate platform and added concrete steps
CIVIL	CG301	Revised platform elevation and retaining walls
CIVIL	CG302	Revised wall elevation
CIVIL	CP502	Revised paving limits
CIVIL	CU100	Shift fuel tank location north Revised 3" waterline alignment
CIVIL	CU100	Revised 3" waterline alignment Added backflow preventer on Waterline 1 Added backflow preventor on CWR line Added Detail A at water supply connection
CIVIL	CU202	Added drain line profile
CIVIL	CU203	Revised profiles
STRUCTURAL	S-101	Revised roof shoring note
STRUCTURAL	S-501	Revised repair notes
MECHANICAL	MB102	MECHANICAL ROOF PLANS Revised location of ACCU-2.
MECHANICAL	MB202	ENLARGED FLOOR PLAN AREA 2_5 – DEMO Revised note to temporarily remove the door frame for the closet serving AHU-2 during construction.
MECHANICAL	MB214	ENLARGED FLOOR PLAN AREA 4 – NEW Added notes for contractor to provide signage inside of the mech room.
MECHANICAL	MB502	MECHANICAL DETAILS Added detail for ACCU support post.

PLUMBING	P-001	<p>PLUMBING LEGEND</p> <p>The following abbreviations and descriptions have been added:</p> <ul style="list-style-type: none"> • DWP – DOMESTIC WATER BOOSTER PUMP • ET – WATER HEATER EXPANSION TANK • FMP – FUEL MONITORING PANEL • FD – FLOOR DRAIN • MFP – MANUAL FUEL PORT • PRV – PRESSURE RELIEF VALVE • RPBP – REDUCED PRESSURE BACKFLOW PREVENTER • UWST – UNDERGROUND WATER STORAGE TANK • WFS – WATER FILTRATION SKID
PLUMBING	PA202	<p>ENLARGED FLOOR PLAN – NEW</p> <p>Revised fuel supply and return piping size to 1-½".</p>
PLUMBING	PA401	<p>PIPING DIAGRAMS</p> <p>Revised fuel supply and return piping size to 1-½" for isometric and pol system piping diagram.</p> <p>Revised pol system piping sequence of operations.</p>
PLUMBING	PA601	<p>PLUMBING SCHEDULES</p> <p>Revised schedule notes to add "Provide fuel level gauge probe."</p>
PLUMBING	PB100	<p>OVERALL FLOOR PLAN</p> <p>Added references to plumbing views in mechanical room.</p>
PLUMBING	PB104	<p>ENLARGED FLOOR PLAN – NEW</p> <ul style="list-style-type: none"> • Revised u/g water tank size to be based on 15,000 gallons, previously 20,000 gallons. • Added RPBP locations

PLUMBING	PB105	<p>ENLARGED FLOOR PLAN – DEMO</p> <ul style="list-style-type: none"> • Revised phasing notes to include temporary fuel tank (AST-3) and fuel pump (FP-1) • Added location of temporary fuel tank (AST-3) and fuel pump (FP-1) to drawings. • Revised existing leak detection cable note • Revised drawings to show removal of the existing fuel monitoring panel • Added reference to civil for traffic control measure for the temporary fuel tank. • Added location of (E)fuel pump control panel for reference.
PLUMBING	PB106	<p>ENLARGED FLOOR PLAN – NEW</p> <ul style="list-style-type: none"> • Removed redundant fuel monitoring panel, revised drawings to show (1) new panel. • Added callout for transition sump • Added callout for reference to structural for AST-2 concrete pad • Revised location of AST-2
PLUMBING	PB401	<p>WATER STORAGE SYSTEM SCHEMATIC</p> <ul style="list-style-type: none"> • Revised WFS-1 sequence of operation • Revised UWST-1 schematic to include RPBP • Revised POL piping schematic. • Added sequence of installation for temporary fuel tank and fuel pump. • Revised sequence of operation for AST-2 to match the existing sequence.

PLUMBING	PB501	<p>PLUMBING DETAILS</p> <ul style="list-style-type: none"> Revised u/g water tank detail dimensions to be based on 15,000 gallons, previously 20,000 gallons. Changed water tank access to bolt on cofferdam instead of manhole cover. Added manufacturer's recommendations references to gravel/infill type for the u/g water tank
PLUMBING	PB601	<p>PLUMBING SCHEDULES</p> <ul style="list-style-type: none"> Revised u/g water tank schedule to be based on 15,000 gallons, previously 20,000 gallons. Revised numbering of AST, MFP, and FMS.
PLUMBING	PB107	<p>PLUMBING ROOF PLAN – NEW</p> <p>Added location of (E)fuel pump control panel for reference</p>
PLUMBING	PB903	<p>FUEL ISOMETRIC DIAGRAM</p> <p>Revised location of AST-2 and pipe route</p>
ELECTRICAL	E-001	Added room controller symbol to electrical symbol list.
ELECTRICAL	EA105	<p>Added 120V power for smart water meter</p> <p>Added 1" C comm with pullstring for smart water meter</p> <p>Changed wire count for ACCU feeder</p>
ELECTRICAL	EA106	<p>Added keynote #2 to call out "INTERCEPT EXISTING CIRCUIT VIA A JUNCTION BOX AND EXTEND TO NEW LIGHTS"</p> <p>Revised keynote callouts</p> <p>Removed occupancy sensor from switch in State Warning Point room due to lights being on 100%.</p>
ELECTRICAL	EA503	Revised wire count in duct schedule
ELECTRICAL	EA602	Revised wire count for ACCU feeder in one-line
ELECTRICAL	EA702	Add circuit to Panel PP schedule for smart water meter.

ELECTRICAL	EB102	Revised location of ACCU-2 and orientation of ACCU-1 due to structural concerns.
ELECTRICAL	EB201	Revised circuiting for the light fixtures, lighting controls and receptacle Added New Work Note #1: "Intercept existing circuit via a junction box and extend to room controller and new lights."
ELECTRICAL	EB202	Added keynote #2 to "EXISTING PUMP CONTROL PANEL" callout. Hatched out the existing pump control panel.
ELECTRICAL	EB203	Added 120V power for smart water meter Added Duct Section #2 (1"C comm with pull string) for smart water meter that leads to a junction box located in the storage room. Added (2) handholes.
ELECTRICAL	EB204	Added 120V power for the fuel supply pump that will be mounted on and used for the temporary tank. Added (1) handhole. Added new "MECH 2" panel to the sheet Added phasing note P1: "NEW PANELS "MECH 1" AND "MECH 2" TO BE INSTALLED PRIOR TO THE INSTALLATION OF TEMPORARY TANK MOUNTED FUEL SUPPLY PUMP AND OTHER PLUMBING EQUIPMENT. PROVIDE 120V POWER AND SUPPORTING CONDUCTORS VIA NEW "MECH 2" PANEL, TO (1) TANK MOUNTED FUEL SUPPLY PUMP. REMOVE TEMPORARY BRANCH CIRCUITING, DISCONNECT SWITCHES, AND EQUIPMENT CONNECTIONS WHEN THE TEMPORARY TANK IS REMOVED."
ELECTRICAL	EB501	Added duct section 2 to the duct schedule: -Description: 1"C PVC SCHEDULE 40, DATA -Conductors/Cables: Pull String
ELECTRICAL	EB701	Revised Type G general description in the luminaire schedule.

ELECTRICAL	EB702	Added 120V power for the Temporary fuel supply pump. (Panel "MECH-2" Ckt. 17)
------------	-------	---

C. PRE-BID CONTRACTOR QUESTIONS AND RESPONSES:

1. A Pre-bid site visit was conducted on March 19th, 2024. Below are the questions and responses.

QUESTIONS	RESPONSES
1. Is there a tank permit for the existing 6K tank at Birkhimer? If yes, can it be provided?	Yes. See Attachment #1 for a copy of the existing u/g tank permit.
2. Can A/E provide as-builts for existing 6K-gal. underground storage tank for Berkhimer?	See Attachment #2a for as-builts of the 6k gallon fuel tank replacement. Also see Attachment #2b for as-builts of the fuel return line addition.
3. Is there any kind of anchoring pad or deadman strapping down tank?	Fuel tank anchoring to be in conformance with the manufacturer's requirements
4. Is this a Buy American Project?	No
5. Section 13200 Storage Tanks	
3.02 A-B. For bidding purposes if excavation material is positive. Will there be an allowance number or estimated quantity in cubic yards or tons to dispose of material?	For Bidding purposes, Assume that excavation material is negative. No, there will be no allowance regarding this
3.06 and 3.07 Can government provide estimated quantities for furnishing imported fill material incase need to haul contaminated material?	No
3.08 E Will government require rush turn around sample time or will standard 2-weeks be sufficient ?	Standard lab analysis will be sufficient.
3.07 C can contaminated material be placed and 10-mil polyethylene plastic and covered with the same type of plastic?	Contaminated or potentially contaminated material, such as soil and waste, shall be placed on an impermeable liner or device, such as 20-mil plastic sheeting, surrounded with impermeable lined berms and covered with impermeable sheeting. Please refer to the Attachment #5; Cotnaminated soil and waste management
6. Drawing PB105 Phase Notes 1.	
How much down time do we have to switch existing tank to new tank at the POC?	Downtime between switch over from existing tank to the temporary and/or new fuel tank shall be based on the capacity of the Daytanks located inside of the Birkhimer building (appx. 10 hours).
7. Drawing PB105 Key Notes Continued 5. Section 13200 Part 3.02.	

Can you confirm what we are doing with fuel from existing tank?	Fuel from existing storage tank shall be recovered and reused in the new AST.
Can you provide estimated gallons to keep and reuse if fuel is not contaminated?	Approximately 4000 gallons
8. Section 13200 Part 3.08 Backfill.	
If excavated material is negative, can we reuse material to backfill tank hole?	Yes, If all of COPCs are below the Tier 1 EALs, soil can be reused onsite.
9. Section 15606 Part 2.01 and 3.01 A7 Building 303 and Birkhimer	
Building 303: can you confirm what piping we will go with for aboveground piping? It calls for DoubleTrac and for steel piping 2" and smaller threaded pipe. Preference is steel piping.	Steel piping is acceptable
Can pipe be reduced, 2" and that close of run might be overkill?	Yes, fuel piping for B303 will be revised to 1-1/2"
Birkhimer: site visit piping appears to steel pipe (cannot confirm underground) in a double wall FRP containment pipe. Specs call for different types of pipe. What section do we follow as there is multiple descriptions? Preference will be to follow existing fuel piping system.	Match existing fuel piping type at Birkhimer. Spec section will be revised to include FRP section.
Do we need to test existing double wall fuel lines before connecting back with POC before hooking it to new fuel lines? Not sure if existing secondary lines will hold.	Yes, connection to any existing secondary lines shall require testing. Refer to spec section 15606 3.02.A for testing.
10. Section 15606 Part 2.02 AST	
From supplier. Distributors that we have worked with sold their license and we are currently looking for other manufactures to produce Convault Tanks. If supplier cannot find another distributor, would we be able to substitute tank with Super Vault or Fireguard tanks?	Alternate fuel tanks are acceptable as long as the UL 142 and 2085 ratings as specified are met.
If so, can we get an extension on bid due date?	No extension is considered at this time
If we have to go with Convault, the spec calls for a finish color to be Prairie Dusk. If Convault does not offer this color, can we go with Convault standard finish?	Standard finish is acceptable for the fuel tank at B303. For the fuel tank at Birkhimer, finish shall be as close as possible to the Prairie Dusk color. Alternate colors shall be sent to the engineer for approval.
2.02A-1 specs call for a 5 gallon overfill containment box. Can we remove this as we will have remote fill that will need to be piped to tank?	Overfill containment box will be removed from Section 2.02.A.1
2.01N-1 can remote fill box be post mounted instead of wall mounted, as we are not allowed to drill any holes on the tank's exterior?	Post mounted remote fill box is acceptable

2.01G Dielectric Unions – is this section a typo as it talks about dielectric unions and then to check valves calling out for a OPW #821 solenoid valve?	Check valve spec should be listed separately from Dielectric unions. Spec section will be revised.
11. Section 15606 2.01M Fuel Monitoring	
Veeder Root 350 is obsolete, can we replace Veeder Root 350 with Veeder Root 450?	Replace fuel monitoring system with current models
This section calls for stainless steel enclosure. Does the console need to be stainless steel or can the console be put into a 3 rd party stainless steel enclosure?	3rd party stainless steel enclosure is acceptable.
12. Drawing PB401 Existing Fuel Monitoring Panel and New Fuel Monitoring Panel.	
What is the purpose of (2) fuel monitoring systems. Can you identify leak detection cable?	Existing console will be replaced with new. 2nd fuel monitoring console will not be required. Refer to Addendum 1 drawings.
Is this leak cable a communication wire for a sump sensor that will detect leaks in the sump? From site visit we did not see any monitoring “J” wells for low point of fuel lines so we suspect that the sump has a leak sensor.	2012 as-built drawings indicate a provision of a leak detection sensor at the low point of the underground pipe for the fuel return piping next to the fuel tank. See Attachment #2b.
13. Drawings PB401 Underground Fuel Lines Birkhimer New AST.	
Is a transition sump required to go from aboveground to underground piping? We can add a leak sensor so we can monitor underground fuel piping.	Provide a transition sump at the low point of the underground piping for fuel leak detection
14. Drawings PA202 and PB106 Fuel Storage Tank Naming	
Fuel equipment to be installed at both Building 303 and Birkhimer have identical ID tags (AST-1, FMS-1, etc.) which will cause some confusion when identifying a specific piece of equipment at a particular area. Could the equipment be assigned individual ID tags to avoid any mix ups?	Fuel tank equipment at Birkhimer will be renamed to avoid confusion with equipment at B303.
15. Section 15606 Part 2.02.A.1 and A11	
Both drawings and specification sections 15606, paragraphs 2.02.A1 and A11 call for an overfill spill containment to be supplied on top of the AST however the design calls for a manual fuel port to be installed at grade level. The fill piping from the manual fill port will need to be routed to a fitting directly on top of the tank and cannot be connected to the fitting inside of a spill containment on top of the AST. Can this section of the specs be deleted?	Overfill containment box will be removed from Section 2.02.A.1

16. Drawings PB106 Fuel monitoring console	
Plans call for the existing fuel monitoring console at the Birkhimer Building to remain for reuse in addition to the new console that is to be furnished and installed. Please clarify what the existing console and new console will be monitoring.	Existing console will be replaced with new. 2nd fuel monitoring console will not be required. Refer to Addendum 1 drawings.
17. Section 15606 Part 2.01.M.5 Fuel Monitoring	
Specification section 15606, paragraph 2.01.M.5 calls for the new fuel monitoring system to be a Veeder Root TLS-350 plus. This model has been discontinued. Current models available include TLS-4B or TLS-450 Plus. Please advise which current model is to be used for this project.	Smaller monitoring system with 6 probe and sensor points is adequate
18. Section OF-2	
Project duration is 400 calendar days from NTP. Project has many long lead items that will take 6 months or longer to receive. Request longer project duration.	Upon award, the Bidder is allowed to procure long lead times. See Section 1100 for further information.
19. Section 13200 Storage Tanks	
If contaminated soil is discovered after existing underground fuel tank at Birkhimer building is removed, please confirm that removal and disposal of contaminated soil will be a mod.	For Bidding purposes, assume that excavation material is negative. No, there will be no allowance regarding this
20. Sheets CG101, CG301, and CG302	
Sheets CG101, CG301 and CG302 of the project drawings show a retaining wall for the fuel tank slab. We could not find a structural detail showing footing, wall type or reinforcing steel, if any. Would appreciate those details or pointing out where we may find them.	Refer to Addendum 1 drawings for added details

D. SUBSTITUTION REQUEST

1. Below are the contractor substitution request and responses:

Section/Item	Specified Brand	Substitute or Alternate Brand	Response
15606 2.02	Calls for concrete encased tank	Modern Welding Fireguard	Refer to Addendum 1
15606 1.03 Warranty	All work under this section shall be under warranty for a period of two years.	Warranties offered will be each Manufacturers warranties only. Most Manufacturers have a one year limited warranty, replacing defective parts or replacing at it's discretion.	Provide two years warranty
15606 2.01 C. Weather Proof Vent Cap	Weather Proof Vent Cap	Please clarify what is meant by "increaser fitting"?	Deleted "increaser"
15606 2.01 F. Anti-Siphon Valve	"Tank supplier shall provide UL listed bronze bodied angle check valve"	Please clarify, anti-siphon valve or check valve?	This section is for Anti-siphon valve
15606 2.01 G. Dielectric Unions	1. Says "Check valve, swing check, 150# Class...OPW 821 or approved equivalent".	OPW 821 is a solenoid valve, not a check valve. Either has nothing to do with Dielectric Unions	Refer to Addendum 1
15606 2.01 J. 4. Foot Valve		Can bronze body be substituted with brass? Petroleum manufacturers do not make bronze foot valves.	No exceptions taken
15606 2.01 M. 5.	Veeder Root TLS-350 Plus	TLS-350 Plus is obsolete. Substitute with TLS-450 Plus. 15606 2.03 calls for spare I/O options, Modbus and Ethernet network compatible 4-20mA output. Relay dry contacts output. These are available only with the TLS-450 Plus as options. If the above are not needed, TLS4 or TLS4B could be substituted.	Refer to Addendum 1

16510 2.02 Luminaires	Columbia, Finelite, Startek, Evolve, Hubbell, Pinnacle	HE Williams, Day-O-Lite, Precision Architectural, AFX, Olympia, Ligman Solar, ABL, Alight, HILA, Pinnacle	Refer to sheets EA701, EB701, and EC701. Make and model are provided. Accepted equivalents are allowed and will be reviewed when equipment submittals are provided.
16510 2.05 Lighting Controls	Wattstopper	AVI-ON, Acuity	Refer to sheets EA505 and EB503. Make and model are provided. Accepted equivalents are allowed and will be reviewed when equipment submittals are provided.
16530 2.01 LED Luminaires	Selux	Ligman Solar, SOL	Refer to sheets EA701. Make and model are provided. Accepted equivalents are allowed and will be reviewed when equipment submittals are provided.

E. PRE-BID MEETING MINUTES

1. Please see Attachment C

ATTACHMENT A

DIVISION 8 - DOORS AND WINDOWS

SECTION 08410 - ALUMINUM-FRAMED STOREFRONT

PART 1 - GENERAL

1.01 SUMMARY

- A. Section includes:
 - 1. Aluminum-Framed Storefront

1.02 REFERENCES

- A. American Architectural Manufacturers Association (AAMA)
- B. American Society for Testing and Materials (ASTM)
- C. Aluminum Association (AA)

1.03 SYSTEM DESCRIPTION

- A. General: In addition to requirements shown or specified, comply with:
 - 1. Applicable provisions of AAMA Aluminum Storefront and Entrance Manual for design, materials, fabrication and installation of component parts.
- B. Design Requirements: Arcadia IP2551 Series is a framing system suitable for outside or inside glazing.
- C. Performance Requirements:
 - 1. Conformance to ASTM 1886/1996 (Small Missile & Large Missile) & AAMA/NWWDA 101/I I.S. 2-97 (Non Impact).
 - 2. Limit air leakage through assembly to 0.06 CFM/min/sq. ft. (.00003 m3/sm2) of wall area at 6.24 PSF (300 Pa) as measured in accordance with ASTM E283.
 - 3. Water Resistance: No water leakage when measured in accordance with ASTM E331 with a static test pressure of 15 PSF(384 Pa).
 - 4. Limit mullion windload deflection of L/175 with full recovery of glazing materials, when measured in accordance with ASTM E 330.
 - 5. System shall not deflect more than 1/8" at the center point, or 1/16" at the center point of a horizontal member, once deadload points have been established.
 - 6. System shall accommodate expansion and contraction movement due to surface temperature differential of 180 degrees F.
 - 7. Seismic testing shall conform to AAMA recommended static test method for evaluating performance of curtain walls and storefront wall systems due to horizontal displacements associated with seismic movements and building sway.

1.04 QUALITY ASSURANCE

- A. Single Source Responsibility:
 - 1. Obtain entrances, storefronts, ribbon walls, window walls, curtain walls, window systems, and finish through one source from a single manufacturer.
- B. Provide test reports from AAMA accredited laboratories certifying the performances as specified in 1.03.

1.05 WARRANTY

- A. System shall be warranted against failure and/or deterioration of metals due to manufacturing process for a period of two (2) years.

PART 2 - PRODUCTS

2.01 MANUFACTURERS

- A. Acceptable Manufacturers:
 - 1. Arcadia, Inc., 2301 East Vernon, Vernon, CA. Telephone 323/269-7300, Fax 323/269-7390.
- B. Acceptable Products:
 - 1. Arcadia Inc., IP2551 Series, 2 1/2" x 5" center glazed system for 1 5/16" glass (screw spline system).

2.02 FRAMING MATERIALS AND ACCESSORIES

- A. Framing members, transition members, mullions, adaptors, and mounting: Extruded 6063-T6 aluminum alloy (ASTM B221 - Alloy G.S. 10a T6).
- B. Screws, fastening devices, and internal components: Aluminum, stainless steel, or zinc-plated steel in accordance with ASTM.A-164. Perimeter anchors shall be aluminum or steel, providing the steel is properly isolated from aluminum.
- C. Glazing Gasket
 - 1. Compression-type design, replaceable, molded or extruded santoprene, polyvinyl chloride (PVC), or ethylene propylene diene monomer (EPDM).
 - 2. Shall be of type that locks securely into the glazing reglet to prevent glazing gaskets from disengaging.

2.03 FINISH

- A. Finish all exposed areas of aluminum and components as indicated.
 - 1. An Architectural Class II or I color anodic coating conforming with AA-M12C22A34/AA-M12C22A44.
 - a. Anodized finish color shall be Colornodic _____. (AB1 Light Champagne, AB2 Champagne, AB3 Light Bronze, AB4 Medium Bronze, AB5 Standard Medium Bronze, AB6 Dark Bronze, AB7 Standard Dark Bronze, AB8 Black.)
 - 2. An Architectural Class II or I anodic coating conforming with AA-M12C22A31/AA-M12C22A41.

- a. Anodize finish color shall be Colornodic _____ (#11 Clear)
- 3. Fluorocarbon Coating: AAMA 2605.2.
 - a. Resin: 70% PVDF Kynar 500/Hylar 5000.
 - b. Substrate: cleaned and pretreated with chromium phosphate.
 - c. Primer: Manufacturer's standard resin base compatible coating. Dry film thickness.
 - 1) Extrusion: Minimum 0.20 mil.
 - d. Color Coat: 70% PVDF, dry film thickness.
 - 1) Extrusion: 1.0 mil.
 - e. Color: As selected by Architect.
 - f. Acceptable Coatings Manufacturers:
 - 1) PPG Industries, Inc.
 - 2) Valspar Corporation
 - 3) BASF

2.04 SYSTEM FABRICATION

- A. Continuous sub-sill shall be provided under sill members to collect water infiltration and divert from the interior of the system.
- B. Framing members shall be internally reinforced and secured at head and sill as necessary for structural performance requirements, for hardware attachment, and as indicated.
- C. Fasteners shall be so located as to ensure concealment from view in the final assembly.

PART 3 - EXECUTION

3.01 EXAMINATION

- A. Examine conditions and verify substrate conditions are acceptable for product installation.

3.02 INSTALLATION

- A. Install in accordance with approved shop drawings and manufacturers installation instructions.

3.03 FIELD QUALITY CONTROL

- A. Test the storefront for water leaks in accordance with AAMA 501.2. Conduct test in the presence of the Architect. Correct deficiencies observed as a result of this test.

END OF SECTION

SECTION 08810 - GLAZING

PART 1 - GENERAL

1.01 SECTION INCLUDES

- A. Glazing units, glass for interior storefront.
- B. Glazing compounds.

1.02 RELATED REQUIREMENTS

- A. SECTION 08410 - ALUMINUM-FRAMED STOREFRONTS.

1.03 REFERENCE STANDARDS

- A. 16 CFR 1201 - Safety Standard for Architectural Glazing Materials Current Edition.
- B. ANSI Z97.1 - American National Standard for Safety Glazing Materials Used in Buildings - Safety Performance Specifications and Methods of Test 2015 (Reaffirmed 2020).
- C. ASTM C864 - Standard Specification for Dense Elastomeric Compression Seal Gaskets, Setting Blocks, and Spacers 2005 (Reapproved 2019).
- D. ASTM C920 - Standard Specification for Elastomeric Joint Sealants 2018.
- E. ASTM C1036 - Standard Specification for Flat Glass 2021.
- F. ASTM C1048 - Standard Specification for Heat-Strengthened and Fully Tempered Flat Glass 2018.
- G. ASTM C1193 - Standard Guide for Use of Joint Sealants 2016 (Reapproved 2023).
- H. ASTM C1172 - Standard Specification for Laminated Architectural Flat Glass.
- I. ASTM C1376 - Standard Specification for Pyrolytic and Vacuum Deposition Coatings on Glass.
- J. ASTM E1300 - Standard Practice for Determining the Minimum Thickness and Type of Glass Required to Resist a Specified Load.
- K. CPSC 16 CFR 1201 - Safety Standard for Architectural Glazing Materials.
- L. Insulating Glass Manufacturers Alliance (IGMA) - Glazing Guidelines.
- M. GANA (SM) - GANA Sealant Manual.
- N. GANA Laminated Glass Design Guide; Glass Association of North America.

1.04 SUBMITTALS

- A. See SECTION 01300 - SUBMITTALS.

- B. Product Data on Glazing Unit Glazing Types: Provide structural, physical and environmental characteristics, size limitations, special handling and installation requirements.
- C. Product Data on Glazing Compounds and Accessories: Provide chemical, functional, and environmental characteristics, limitations, special application requirements, and identify available colors.

1.05 WARRANTY

- A. See SECTION 01300 - SUBMITTALS for additional warranty requirements.

PART 2 - PRODUCTS

2.01 MANUFACTURERS

- A. Float Glass Manufacturers:
 - 1. Guardian Glass, LLC: www.guardianglass.com/#sle.
 - 2. Pilkington North America Inc: www.pilkington.com/na/#sle.
 - 3. Vitro Architectural Glass (formerly PPG Glass): www.vitroglazings.com/#sle, or approved equal.

2.02 GLASS MATERIALS

- A. Float Glass: Provide float glass based glazing unless otherwise indicated.
 - 1. Kind FT - Fully Tempered Type: Complies with ASTM C1048.
- B. Heat treated float glass: ASTM C 1048, Type I (transparent flat glass), Quality-Q3; of class indicated, of kind and condition indicated. All heat strengthening and tempering shall be by the horizontal process, with IG units fabricated in such a manner as to have all roller distortion in a horizontal direction as installed in the building.
 - 1. The minimum surface and edge compression shall comply with requirements of ASTM C 1048. Fully Tempered glass shall conform to ANSI Z97.1
- C. Windborne-Debris Impact Resistant Laminated Glass
 - 1. Laminated Glass: ASTM C1172. Use materials that have a proven record of no tendency to bubble, discolor, or lose physical and mechanical properties after fabrication and installation.
 - a. Manufacturers: subject to compliance with requirements, provide products by one of the following:
 - 1) Eastman Chemical Company
 - 2) Kuraray America, Inc, or approved equal.
 - b. Construction: Laminate glass with polyvinyl butyral interlayer or ionoplast interlayer as recommended by the manufacturer that meets performance requirements.

- c. Interlayer Thickness: Provide thickness not less than that indicated and as needed to comply with requirements.
- d. Interlayer Color: Clear unless otherwise indicated.

2.03 GLAZING UNITS

- A. Double-Glazed Sputter-Coated Insulating Glass Units:
 - 1. Outboard Lite: Sputter-coated Clear Float glass.
 - a. Clear Float Glass: ASTM C1036, Type 1, Class 1, Quality q3.
 - b. Coating on Surface No. 2: Guardian SunGuard SunGuard® SNX 51/23, or approved equal.
 - c. Glass Thickness: 1/4" (6mm).
 - d. Heat Treatment: Kind FT; CPSC 16CFR-1201; ANSI Z 97.1 as necessary to meet applicable codes and performance requirements.
 - 2. Air Space: 12.7mm wide, hermetically sealed, dehydrated 90% Argon space.
 - 3. Inboard Laminated Glass Unit:
 - a. Conformance: ASTM C 1172, CPSC 16CFR-1201
 - b. Inner Lite:
 - 1) Clear Float Glass: ASTM C 1036, Type 1, Class 1, Quality q3.
 - 2) Coating on No. 3 surface: [None].
 - 3) Glass Thickness: 6 mm (1/4 inch).
 - 4) Heat Treatment: Tempered; ASTM C 1048, Kind FT; CPSC 16CFR-1201.
 - c. Interlayer: Polyvinyl butyral (PVB) plastic interlayer, clear, 0.060 inch thick.
 - d. Inboard Lite
 - 1) Clear Float Glass: ASTM C 1036, Type 1, Class 1, Quality q3.
 - 2) Vacuum Deposition Sputtered Coating: ASTM C 1376.
 - 3) Coating on No. 6 surface: SunGuard IS 20, or approved equal.
 - 4) Glass Thickness: 6 mm (1/4 inch).
 - 5) Heat-Treatment: Tempered; ASTM C 1048, Kind FT; CPSC 16CFR-1201.
 - 4. Glass Unit Performance Characteristics:
 - a. Visible Light Transmittance: 48 %
 - b. Visible Light Reflectance Outdoors: 14 %

- c. Winter U-Value Nighttime: 0.238 Btu/hr·ft²·F
 - d. Summer U-Value Daytime: 0.209 Btu/hr·ft²·F
 - e. Solar Heat Gain Coefficient: 0.23
- B. Edge Seals: ASTM E 2188, with aluminum spacers, dual-sealed with a primary seal of polyisobutylene and a secondary seal of silicone sealant for glass-to-spacer seals.

2.04 GLAZING COMPOUNDS

- A. Polyurethane Sealant: Single component, chemical curing, nonstaining, nonbleeding; ASTM C920 Type S, Grade NS, Class 25, Uses M, A, and G; with cured Shore A hardness range of 20 to 35; color as selected.
- B. Silicone Sealant: Single component; neutral neutral curing; capable of water immersion without loss of properties; nonbleeding, nonstaining; ASTM C920 Type S, Grade NS, Class 25, Uses M, A, and G; ; ASTM C920 Type S, Grade NS, Class 25, Uses M, A, and G; with cured Shore A hardness range of 15 to 25 15 to 25; color as selected color as selected.

2.05 ACCESSORIES

- A. Setting Blocks: Silicone, with 80 to 90 Shore A durometer hardness; ASTM C864 Option II. Length of 0.1 inch for each square foot (25 mm for each square meter) of glazing or minimum 4 inch (100 mm) by width of glazing rabbet space minus 1/16 inch (1.5 mm) by height to suit glazing method and pane weight and area.
- B. Glazing Tape, Back Bedding Mastic Type: Preformed, butyl-based, 100 percent solids compound with integral resilient spacer rod applicable to application indicated; 5 to 30 cured Shore A durometer hardness; coiled on release paper; black color.
 - 1. Width: As required for application.
 - 2. Thickness: As required for application.
 - 3. Spacer Rod Diameter: As required for application.
- C. Glazing Tape: Closed cell polyvinyl chloride (PVC) foam, coiled on release paper over adhesive on two sides, maximum water absorption by volume of 2 percent, designed for compression of 25 percent to effect an air barrier and vapor retarder seal.

PART 3 - EXECUTION

3.01 VERIFICATION OF CONDITIONS

- A. Verify that openings for glazing are correctly sized and within tolerances, including those for size, squareness, and offsets at corners.
- B. Verify that surfaces of glazing channels or recesses are clean, free of obstructions that may impede moisture movement, weeps are clear, and support framing is ready to receive glazing system.

3.02 INSTALLATION, GENERAL

- A. Install glazing sealants in accordance with ASTM C1193, GANA (SM), and manufacturer's instructions.

3.03 INSTALLATION - WET/DRY GLAZING METHOD (TAPE AND SEALANT)

- A. Application - Interior Glazed: Set glazing infills from the interior of the building.
- B. Cut glazing tape to length and install against permanent stops, projecting 1/16 inch (1.6 mm) above sight line.
- C. Place setting blocks at 1/4 points with edge block no more than 6 inch (152 mm) from corners.
- D. Rest glazing on setting blocks and push against tape to ensure full contact at perimeter of pane or unit.
- E. Install removable stops, spacer shims inserted between glazing and applied stops at 24 inch (610 mm) intervals, 1/4 inch (6 mm) below sight line.
- F. Fill gaps between pane and applied stop with sealant to depth equal to bite on glazing, to uniform and level line.
- G. Carefully trim protruding tape with knife.

3.04 FIELD QUALITY CONTROL

- A. Glass and Glazing product manufacturers to provide field surveillance of the installation of their products.
- B. Monitor and report installation procedures and unacceptable conditions.

3.05 CLEANING

- A. Remove excess glazing materials from finish surfaces immediately after application using solvents or cleaners recommended by manufacturers.
- B. Remove nonpermanent labels immediately after glazing installation is complete.
- C. Clean glass and adjacent surfaces after sealants are fully cured.
- D. Clean glass on both exposed surfaces not more than 4 days prior to Date of Substantial Completion in accordance with glass manufacturer's written recommendations.

3.06 PROTECTION

- A. After installation, mark pane with an 'X' by using removable plastic tape or paste.
- B. Remove and replace glass that is damaged during construction period prior to Date of Substantial Completion.

END OF SECTION

Birkhimer Emergency Operation Center (EOC) UPGRADES AND IMPROVEMENTS
State of Hawai'i, Department of Defense,
Job No. CA-202313-C

Adjutant General
State Department of Defense
3949 Diamond Head Road
Honolulu, Hawai'i 96816-4495

Dear Sir:

The undersigned has carefully read and understands the terms and conditions specified in the Specifications, and all documents attached hereto, and hereby submits the following offer to perform the work specified herein, all in accordance with the true intent and meaning thereof. The undersigned further understands and agrees that by submitting this offer, 1) he/she is declaring his/her offer is not in violation of Chapter 84, Hawai'i Revised Statutes, concerning prohibited State contracts, and 2) he/she is certifying that the price(s) submitted was (were) independently arrived at without collusion.

The undersigned represents: **(Check ✓ one only)**

- ☐ A **Hawai'i business** incorporated or organized under the laws of the State of Hawai'i, **OR**
☐ A **Compliant Non-Hawai'i business** not incorporated or organized under the laws of the State of Hawai'i. Business shall be registered prior to award at the State of Hawai'i Department of Commerce and Consumer Affairs Business Registration Division to do business in the State of Hawai'i. State of incorporation: _____

Offeror is:

- ☐ Sole Proprietor ☐ Partnership ☐ Corporation ☐ Joint Venture
☐ Other _____

Federal I.D. No.: _____
Hawai'i General Excise Tax License I.D. No.: _____

Payment address (other than street address below): _____
City, State, Zip Code: _____

Business address (street address): _____
City, State, Zip Code: _____

Respectfully submitted:

(x) _____
Authorized (Original) Signature (*1)

Date: _____

Telephone No.: _____

Name and Title (Please Type or Print)

* _____
Exact Legal Name of Company (Offeror) (*2)

Fax No.: _____

(*2) If Offeror is a "dba" or a "division" of a corporation, furnish the exact legal name of the corporation under which the awarded contract will be executed:

E-mail Address: _____

(*1)

Original signature in ink. If unsigned or the affixed signature is a facsimile or a photocopy, the offer shall be automatically rejected unless accompanied by other material, containing an original signature, indicating the Offeror's intent to be bound.

The undersigned has carefully examined the attached plans and specifications and hereby proposes to furnish at his own expense all labor, materials, tools and equipment necessary to construct all work as shown and called for, in strict accordance with the specifications, schedules and drawings pertaining thereto, all for the LUMP SUM of:

_____ DOLLARS (\$_____).

(Including the cost of delivery, unloading, freight charges, all applicable taxes, and other cost involved) and will fully complete all the work under this contract within 400 consecutive calendar days from the date of commencement specified by the written order of the Adjutant General including the date of said order.

The undersigned hereby provides a breakdown of the LUMP SUM amount of the base bid items and bid alternates.

Base Bid Item	Base Bid Item	Cost/Month	Cost
1	Lump Sum Base Bid (excluding base bid items 2 & 3)	N/A	
2	Warranty for Div 15 & 16 for 24 months.		
3	Allowance for one work stoppage up to 14 consecutive calendar days for an emergency event that might require the full, uninterrupted use of the Birkhimer Tunnel, PSB, and B303 facilities, including use of the access roads and parking lot, by HI-EMA.	N/A	55,300

Bid Alternates (see section 01230 – ALTERNATES for description)		
Bid Alternate No	Description	Cost
A	All work associated with light fixture replacement in the Admin section of building B303	
B	All work associated with the installation of the new smart electric meter	
C	All work associated with the installation of the new smart water meter	

NOTE:

1. State wage rates apply to this contract.
2. Evaluating Bids: The lowest responsive, responsible bid is determined by the following procedures:
 - A. Chapter 103D, HRS, which provides for the preferences, shall apply.
 - B. The total lump sum bid price is adjusted to reflect the applicable preferences. For projects with alternates, the total lump sum base bid price and alternates will be adjusted to reflect the applicable preferences.
 - C. Project control budget is established prior to the submission of bids.
 - D. If there is more than one alternate for a project, the State will determine the precedence of the alternates for each project prior to the submission of bids.
 - E. The project will be evaluated based on the adjusted bid price.
 - F. The State reserves the right to determine the extent of the contract by selecting and/or omitting bid items (not necessarily in sequence) to the extent required to come within the funds available for the project. The award of the contract shall be made to the responsible bidder whose total bid is the lowest.
3. The Surety shall not be held liable beyond two (2) years of the project acceptance date.
4. Should the State delete work from the contract scope to bring the project within the available funding in order to make an award, and should additional funding become available at any time after the award, the scope deleted from the contract scope at the prices negotiated, which had been previously deleted from the contract scope, may be restored back into the contract scope by the state, at its discretion, as the additional funding may accommodate. The Contractor shall not be entitled to any price increases from the original prices negotiated.
5. Contractor shall submit long lead items upon contract Award. See Section 01100 for further information.

HAWAI'I PRODUCTS PREFERENCE

In accordance with ACT 175, SLH 2009 the Hawai'i Products preference is applicable to this solicitation. Hawai'i products may be available for those items noted on the offer form.

The Hawai'i Products List is available on the State Procurement Office (SPO) website at <http://spo.hawaii.gov/> search for "Hawai'i Product Preferences".

Offeror offering a Hawai'i Product (HP) shall identify the HP on the solicitation offer pages. Any person desiring a Hawai'i product preference shall have the product(s) certified and qualified if not currently on the Hawai'i Products list, prior to the deadline for receipt of offer(s) specified in the procurement notice and solicitation. The responsibility for certification and qualification shall rest upon the person requesting the preference.

Persons desiring to qualify their product(s) not currently on the Hawai'i Product list shall complete form SPO-38, *Certification for Hawai'i Product Preference*, and submit to the Department of Defense, Contracting Officer, and provide all additional information required by the Contracting Officer no later than 4:30pm, fifteen (15) calendar days prior to the bid opening date. For each product, one form shall be completed and submitted (i.e. 3 products should have 3 separate forms completed). The form is available on the SPO webpage at <http://spo.hawaii.gov/> search for "Forms" and select form SPO-38.

Late submittals for this project will not be reviewed by the Department.

Change in Availability of Hawai'i Product

In the event of any change that materially alters the offeror's ability to supply Hawai'i Products, the offeror shall immediately notify the Contracting Officer in writing and the parties shall enter into discussions for the purposes of revising the contract or terminating the contract for convenience.

Offerors shall indicate in the Hawai'i Product Schedule below whether the pre-approved Hawai'i Products are offered. Offerors offering a Hawai'i Product shall fill-in the quantity, unit measure, unit price and total price for the Hawai'i Product they desire to be considered for preference. Products not pre-approved shall not be considered. Hawai'i Products not meeting the requirements of the specification shall not be considered.

Offerors selecting the Hawai'i Product preference may be required to submit additional information on the cost basis of their selected Hawai'i Product preference items when requested after the bid opening to verify cost of the Hawai'i Products, including the computations for the estimated quantities, manufacturer's or supplier's quotations, and delivered material cost Free on Board (FOB) at the jobsite. The Hawai'i Product Cost shall not include installation costs.

Hawai'i Products available for this project are as follows:

Product Description	Class I, II or III	Manufacturer	Cost
			\$
			\$
			\$
			\$
			\$
			\$
			\$

APPRENTICESHIP AGREEMENT PREFERENCE

The estimated value of the public works contract is \$250,000 or more and the apprenticeship agreement preference pursuant to Hawai'i Revised Statutes §103-55.6 (Act 17, SLH 2009) **shall apply**.

1. If applicable to this project, any bidder seeking the preference must be a party to an apprenticeship agreement registered with the State Department of Labor and Industrial Relations (DLIR) at the time the bid is submitted for each apprenticeable trade the bidder will employ to construct the project. "Employ" means the employment of a person in an employer-employee relationship.
 - a. The apprenticeship agreement shall be registered with the DLIR and conform to the requirements of Hawai'i Revised Statutes Chapter 372.
 - b. Subcontractors do not have to be a party to an apprenticeship agreement for the bidder to obtain the preference.
 - c. The bidder is not required to have apprentices in its employ at the time the bid is submitted to qualify for the preference.
2. A bidder seeking the preference must state the apprenticeable trade the bidder will employ for each trade to be employed to perform the work by submitting a completed **signed original** *Certification of Bidder's Participation – Form 1* verifying participation in an apprenticeship program registered with the DLIR. "Apprenticeable

trade” shall have the same meaning as “apprenticeable occupation” pursuant to Hawai‘i Administrative Rules (HAR) §12-30-5.

- a. The *Certification of Bidder’s Participation – Form 1* shall be authorized by an apprenticeship sponsor listed on the DLIR list of registered apprenticeship programs. “Sponsor” means an operator of an apprenticeship program and in whose name the program is approved and registered with the DLIR pursuant to HAR §12-30-1.
 - b. The authorization shall be an original signature by an authorized official of the apprenticeship sponsor.
 - c. The completed *Certification of Bidder’s Participation – Form 1* for each trade must be submitted with the bid. A facsimile or copy is acceptable to be submitted with the bid, however the signed original must be submitted within five (5) working days of the bid open date. If the signed original is not received within this timeframe, the preference may be denied. Previous certifications shall not apply.
 - d. When filling out the *Certification of Bidder’s Participation – Form 1*, the name of Apprenticeable Trade and Apprenticeship Sponsor must be the same as recorded in the List of Construction Trades in Registered Apprenticeship Programs that is posted on the State Department of Labor and Industrial Relations website. “Registered apprenticeship program” means a construction trade program approved by and registered with the DLIR pursuant to HAR § 12-30-1 and §12-30-4.
 - e. The *Certification of Bidder’s Participation – Form 1* and the List of Construction Trades in Registered Apprenticeship Programs is available on the DLIR website at: <http://hawaii.gov/labor/wdd>
3. Upon receiving the *Certification of Bidder’s participation – Form 1*, the Procurement Officer will verify that the apprenticeship program is on the List of Construction Trades in Registered Apprenticeship Programs and that the form is signed by an authorized official of the Apprenticeship Program Sponsor. If the programs and signature are not confirmed by the DLIR, the bidder will not qualify for the preference.
 4. If the bidder is certified to participate in an apprenticeship program for each trade which will be employed by the bidder for the project, a preference will be applied to decrease the bidder’s bid amount by five (5) percent for evaluation purposes.
 5. Should the bidder qualify for other preferences (for example, Hawai‘i Products), all applicable preference shall be applied to the bid price.
 6. If the winning bidder has submitted Form 1 with his bid packet, the Form 2 will be required the first week of each month for the prior month beginning with the month of the start of work.

CHARACTER OF WORKERS OR EQUIPMENT

The Contractor shall perform with his own organization, work amounting to not less than twenty percent (20%) of the total contract cost. The Engineer may require the Contractor to verify the percentage of work he will be providing with his own organization by furnishing pertinent information such as all of the actual subcontractor(s)' quotations he received for the bid. If requested, the Contractor shall provide such verification within 5 working days of the request.

CERTIFICATION FOR SAFETY AND HEALTH PROGRAM FOR BIDS IN EXCESS OF \$100,000

In accordance with HRS 396-18, by submitting this proposal, the undersigned certifies that his company will have a written safety and health plan for this project that will be available and implemented by the Notice to Proceed date of this project. Details of the requirements of this plan may be obtained from the Department of Labor and Industrial Relations, Occupational Safety and Health Division (HIOSH).

TAX CLEARANCES FROM THE STATE DIRECTOR OF TAXATION AND INTERNAL REVENUE SERVICE

Contractors are required to provide a state and federal tax clearance as a prerequisite to entering into a public contract of \$2,500 or more. To meet this requirement, all bidders shall submit valid tax clearances with their bid proposals when the bid is \$2,500 or more.

Failure to submit the required tax clearance may be sufficient grounds for the State to refuse to receive or consider the prospective bidder's proposal.

In accordance with Act 190 Amendment to HRS 103D-310©, required as a prerequisite to entering into a contract, the contractor shall register on the Hawai'i Compliance Express web site for all tax clearances by going to <http://vendors.ehawaii.gov> and registering there.

A Certificate of Vendor Compliance generated from this website should be included with their bid proposal. A Compliant status is required prior to awarding the contract.

LICENSE

Due to the nature of the work contemplated, bidder must possess a valid State of Hawai'i Contractor's license in the appropriate classification.

1. The Adjutant General or his designated representative reserves the right to reject any and/or all bids and waive any defects when, in his opinion, such rejection or waiver will be in the best interest of the State.

2. The award of the contract shall be conditioned upon funds being made available for these projects and further upon the right of the Adjutant General or his designated representative to hold all bids received for a period of one hundred eighty (180) days from the date of the opening thereof, unless otherwise required by law, during which time no bid may be withdrawn.
3. The liquidated damages per working day for failure to complete the work on time shall be **\$2,600 per working day** or as stipulated in the General Conditions, whichever is higher.
4. By submitting this proposal, the undersigned is declaring his firm has not been assisted or represented on this matter by an individual who has, in a State capacity, been involved in the subject matter of this contract in the past two years.
5. Upon the acceptance of the proposal by the Adjutant General or his designated representative, the undersigned must enter into and execute a contract for the same and furnish a bond, as required by law. This bond shall conform to the provisions of Section 103D-324 of the Hawai'i Revised Statutes and any law applicable thereto.
6. If the lowest bid received by the State exceeds the funds available for this project, the State reserves the right to negotiate with the lowest responsible bidder as permitted under Section 103D-302, Hawai'i Revised Statutes, as amended, to reduce the scope of work and award a contract therefore.

Receipt of the following addenda issued by the Department is acknowledged by the day(s) of the receipt indicated below:

Addendum No. 1 _____ Addendum No. 2 _____
 Date
Addendum No. 3 _____ Addendum No. 4 _____

It is understood that failure to receive any such addendum shall not relieve the Contractor from any obligation under this Proposal as submitted. (See Special Notice to Bidders for information regarding addenda.)

ALL JOINT CONTRACTORS & SUBCONTRACTORS TO ENGAGE ON THIS PROJECT

The bidder certifies that the following is a complete listing of all joint contractors or subcontractors covered under Chapter 444, Hawai'i Revised Statutes, who will be engaged by the bidder on this project to perform the nature and scope of work indicated pursuant to Section 103D-302, Hawai'i Revised Statutes, and understands that failure to comply with this requirement shall be just cause for rejection of the bid.

The bidder further certifies that only those joint contractors or subcontractors listed shall be allowed to perform work on this project and that all other work necessary shall be performed by the bidder with his own employees. If no joint contractor or subcontractor is listed, it shall be construed that all of the work shall be performed by the bidder with his own employees.

All bidders must be sure that they possess and that the subcontractors listed in the proposal possess all the necessary specialty licenses needed to perform the work for this project. The bidder shall be solely responsible for assuring that all of the specialty licenses required to perform the work is covered in his bid.

The bidder shall include the license number of the joint contractors or subcontractors listed below. Failure to provide the correct names and license numbers as registered with the Contractor's Licensing Board may cause rejection of the bid submitted.

Complete Firm Name of Joint Contractor or Subcontractor for Lump Sum Bid	License Number	Nature and Scope of Work to be performed

Enclosed herewith as required by law:

Surety Bond

Certificate of Deposit

Certified Check

Cashier's Check

Share Certificate

Legal Tender

(Cross Out Those Not Applicable)

_____ DOLLARS (\$ _____).

*Signature

HAWAI'I GENERAL EXCISE TAX

Title _____

I.D. NO. _____

Name of Company

Address

LICENSE CLASSIFICATION
AND/OR SUBCLASSIFICATION
NO.

Telephone _____

Date _____

(CORPORATE SEAL)

*Please attach to this page evidence of the authority of this officer to submit bids on behalf of the Company, and also the names and residence addresses of all officers of the Company.

NOTE: Fill in all blank spaces with the information asked for or bid may be invalidated.
PROPOSAL PAGES MUST BE INTACT; MISSING PAGES MAY INVALIDATE YOUR BID.

SECTION 00010 - TABLE OF CONTENTS

DIVISION 0 - INTRODUCTORY, BIDDING AND CONTRACTING REQUIREMENTS

I.	Offer Form	1 - 10
II.	Corporate Resolution.....	1 - 1
III.	Special Notice to Bidders.....	1 - 10
IV.	Special Provisions	1 - 7
V.	Form 1	1 - 1
VI.	Certification of Compliance for Employment of State Residents	1 - 1
VII.	Surety Bid Bond	1 - 1
VIII.	General Conditions Table of Contents	1 - 3
IX.	General Conditions.....	1 - 52
X.	Additional General Conditions	1 - 3
XI.	Request for Substitution	1 - 1
XII.	Weekly Quality Control Report.....	1 - 1

DIVISION 1 - GENERAL REQUIREMENTS

Section 01100	Project Requirements.....	1 - 9
	Exhibit A: Outage Request Form	10
Section 01190	General Requirements for Commissioning	1 - 21
Section 01230	Alternates	1 - 2
Section 01300	Submittals	1 - 8
Section 01310	Project Management and Coordination	1 - 5
Section 01400	Quality Requirements.....	1 - 7
Section 01500	Temporary Facilities and Controls	1 - 15
Section 01700	Execution Requirements	1 - 7
Section 01715	Existing Conditions - Asbestos / Lead / Hazardous Material Survey.....	1 - 2
	<i>Attachment: Targeted Hazardous Material Survey Report for Birkhimer EOC Upgrades and Improvements Honolulu, Hawaii 96813 Dated November 22, 2023 (57 pages)</i>	

DIVISION 2 - SITE CONSTRUCTION

Section 02050	Site Demolition	1 - 2
Section 02100	Site Preparation	1 - 3
Section 02210	Earthworks	1 - 9
Section 02444	Chain Link Fence	1 - 3
Section 02500	Water Distribution	1 - 4
Section 02530	Sanitary Sewerage	1 - 3
Section 02700	Base Courses	1 - 2
Section 02740	Flexible Pavement	1 - 3
Section 02780	Curbs and Gutters.....	1 - 5
Section 02800	Pavement Markings.....	1 - 1

DIVISION 3 - CONCRETE

Section 03300	Cast-in-Place Concrete	1 - 15
---------------	------------------------------	--------

DIVISION 4 - 6 (Not Used)

DIVISION 07 - THERMAL MOISTURE PROTECTION

Section 07920	Joint Sealants.....	1 - 6
---------------	---------------------	-------

DIVISION 08 - DOORS AND WINDOWS

Section 08410	Aluminum Framed Storefronts.....	1 - 4
Section 08810	Glazing.....	1 - 5

DIVISION 09 - FINISHES

Section 09110	Non-Structural Metal Framing	1 - 3
Section 09250	Gypsum Board Assemblies	1 - 4
Section 09300	Tiling	1 - 5
Section 09911	Exterior Painting.....	1 - 4
Section 09912	Interior Painting.....	1 - 5

DIVISION 10 - 11 - (Not Used)**DIVISION 12 - FURNISHINGS**

Section 12490	Window Shades	1 - 4
---------------	---------------------	-------

DIVISION 13 - SPECIAL CONSTRUCTION

Section 13200	Storage Tanks.....	1 - 6
Section 13283	Lead Hazard Control	1 - 15
Section 13288	Asbestos Testing and Monitoring	1 - 4

DIVISION 14 - CONVEYING SYSTEMS (Not Used)**DIVISION 15 - MECHANICAL**

Section 15000	General Mechanical Requirements	1 - 12
Section 15140	Supports, Anchors, and Seals	1 - 11
Section 15190	Mechanical Identification	1 - 3
Section 15400	Plumbing, General Purpose	1 - 10
Section 15606	POL Systems	1 - 7
Section 15607	Nonmetallic Underground Piping for Petroleum.....	1 - 8
Section 15650	Air Conditioning and Ventilation	1 - 28
Section 15920	Maintenance Service for Air Handling and Ventilation Systems...	1 - 16
Section 15950	Testing, Adjusting and Balancing	1 - 4
Section 15995	Mechanical HVAC Commissioning.....	1 - 15

DIVISION 16 - ELECTRICAL

Section 16011	General Electrical Requirements.....	1 - 10
Section 16100	Electrical Work	1 - 21
Section 16208	Engine Generator Set.....	1 - 25
Section 16301	Underground Electrical Work.....	1 - 11
Section 16510	Interior Lighting	1 - 12
Section 16530	Exterior Lighting	1 - 9

SECTION 15606 - POL SYSTEMS

PART 1 - GENERAL

1.01 SUMMARY

- A. This section includes all fuel oil piping and related auxiliary equipment for diesel generator. General requirements include those specified in SECTION 15000 - GENERAL MECHANICAL REQUIREMENTS.

1.02 SUBMITTALS

- A. Submittals shall be provided in accordance with SECTION 01300 - SUBMITTALS.
- B. Manufacturer's Data:
 - 1. Fuel Pipe and Fittings.
 - 2. Valves.
 - 3. Piping Accessories.
 - 4. Concrete Encased Aboveground Fuel Storage Tank
 - 5. Fuel Monitoring Accessories
 - 6. Manual Fuel Port Accessories
- C. Shop Drawings: Piping system and pipe supports.

1.03 WARRANTY

- A. All work in this Section shall be under warranty for a period of 2 years from the date of acceptance of the work as a whole by The State. Should any equipment or material fall within this period, the Contractor shall replace or repair that item at no cost for material and/or services, if such is due to faulty workmanship or quality of material furnished.
- B. The Contractor shall be responsible for all damage to any part of the premises caused by failure in the equipment furnished under this section for a period of 2 years after the final acceptance of the work as a whole.

PART 2 - PRODUCTS

2.01 MATERIALS AND EQUIPMENT

- A. Fuel Oil Piping and Accessories:
 - 1. All pipe and fittings shall be UL 971A listed flexible double wall piping system. Product shall be DoubleTrac by OmegaFlex. Inner layer shall be zero-permeation, corrugated stainless steel pipe with hand extruded polyethylene jacket used for diesel #2. At every bend, provide 45-deg or 90-deg bend fittings. A long radius turn installation without an elbow fitting is not allowed.

2. Steel Piping: Steel piping 2-inches and smaller shall be threaded. Piping joints shall conform to ANSI B31.4.
 3. Fuel Oil Piping and Accessories: Aboveground pipe shall conform to ASTM A-53, Schedule 40 black steel seamless pipe. Fittings shall be butt-welded type, ASME B16.3, Class 150. Backing rings shall conform to ASME B31.3 and be compatible with materials being welded. Flanges and flange fittings shall be ASME B16.5, steel flanges or convoluted steel flanges which meet the criteria of ASME BPVC VIII D1. Flange faces shall have integral grooves of rectangular cross section which afford containment for self-energizing gasket material.
- B. Valves: Ball valve, 150# class, socket weld, API 607 fire safe, Apollo 83-400 series, Jomar Model S-CS-2001N-SS-4B or approved equivalent.
 - C. Weatherproof Vent Cap: Cast- or malleable-iron with corrosion-resistant wire screen, with free area at least equal to cross-sectional area of connecting pipe and threaded-end connection.
 - D. Fuel Oil Vent Piping and Accessories: ASTM A 53 standard weight, zinc coated steel with zinc-coated malleable iron fittings ASME B16.3.
 - E. Air Vent and Low Point Drain Valves: 1/2" ball valve, Class 150, MSS SP-72 for flanged or butt-welded ends. Stockham or equal.
 - F. Anti-Siphon Valves: Tank manufacturer shall provide UL listed bronze-bodied angle check valve with pressure relief, sized per tank manufacturer's recommendations. Provide with strainer upstream of anti-siphon valve.
 - G. Dielectric Unions: Provide dielectric unions between ferrous and non-ferrous piping, Class 150.
 - H. Check Valve: Swing check, 150# Class, threaded ends.
 - I. Gaskets and Seals: All gaskets and seals in contact with fuel shall be non-asbestos material.
 - J. Watertight Link Seal: Provide belt of linking rubber sections to form a mechanical seal between pipes and conduit penetrating retaining walls, floors, or tanks. Belt is to provide a watertight seal to withstand up to 20 PSIG. Proper size model and number of sections are to be chosen for application, and rubber to be made from EPDM or Nitrile. Metal hardware in galvanized carbon steel or 316 stainless steel.
 - K. Piping Accessories:
 1. Flexible Fuel Hose: Flexible metal hose, corrugated type with braided wire sheath covering, close-pitch annular corrugations, rated for a working pressure of at least 125 psig, 8-inch minimum live length, flanged end connections, UL Listed for flammable liquid service. Metal for hose and braided wire sheath shall be stainless steel, any type of ASTM 300 Series.

2. Unions: ANSI B16.39, 150 lb and 250 lb.
 3. Hangers and Supports: MSS SP-58, types as required by MSS SP-69. Hanger rods shall be galvanized.
 4. Foot Valve: self-activating, double-poppet, shutoff type that prevents fuel flow from reversing. Valve shall conform to NFPA 30. Valve body shall be constructed of either cast steel or aluminum. Valve shall be provided with a minimum 20 mesh stainless steel screen on the intake. Valve seats shall be the replaceable type. Valve shall be capable of passing through a 75 mm 3 inches pipe or tank flange.
 5. Strainer - bottom clean-out Y-type line strainers with 304 SS gasket and 20 mesh screen.
- L. Overfill Prevention Valve:
1. Install at the fill port of AST-1
 2. Top fill set up.
 3. Coordinate with AST-1 supplier for fitting size.
 4. Morrison Bro. Company Model 9095A-AV
- M. Solenoid Valve:
1. Aluminum body with Viton diaphragm, Seals, and Disc, Stainless Steel springs, comparable with Diesel #2.
 2. POW 821 Solenoid Valve.
- N. Fuel Monitoring System:
1. Automatic Tank Gauge System for complete fuel management. Minimum of 6 tank probes and 6 sensor inputs. Delivery detection and reporting.
 2. Provide NEMA 4R Stainless steel enclosure.
 3. Provide Ethernet IP module.
 4. See drawings for sensors and fuel level management and alarm.
- O. Manual Fuel Port System with Tank Alarm Panel:
1. Provide Fuel Port with flush wall-mounting flange.
 2. Provide with weatherproof, lockable box with spill containment.
 3. Provide with quick disconnect hose coupling with dust plug.
 4. Provide with hand pump for spill containment, with shutoff and check valve.

5. Provide with Tank Alarm Panel in NEMA-4R, lockable enclosure with hinged door.

2.02 ABOVEGROUND PRIMARY CONTAINED STEEL TANK WITH INSULATED SECONDARY CONTAINMENT

- A. Primary Contained Steel Tank with Insulated Secondary Containment:
 1. Provide a factory-assembled unit that includes a primary storage tank. Tank assembly shall be in accordance with NFPA 30 and NFPA 30A and be designed and manufactured for a rectangular installation. The concrete encased secondary fuel containment aboveground storage tank shall conform to UL 2085. The primary storage tank shall be factory-welded, steel that conforms to UL 142. Tank assembly shall be mounted on the tank manufacturer's standard UL listed support skid that elevates the tank assembly above the underlying concrete slab a minimum (4 inches). Clearance allows for lifting straps for tank relocation.
 2. The primary steel tank shall be pressure tested at 5 psig for 24 to 48 hours.
 3. The primary steel tank shall have "emergency vent" system as per NFPA 30 Code requirements.
 4. The protected and insulated AST systems shall have a thru-tank leak detector tube to allow for physical checkup and monitoring capability between the primary and the secondary containment.
 5. The primary steel tank shall be pressurized at 5 psig during concrete encasement.
 6. The outer surface of the primary steel tank shall be covered by a minimum of 1/4" thick (6.4 mm) Styrofoam insulation panels.
 7. The primary steel tank shall be encased in six inches of monolithic reinforced concrete, with minimum design strength of 4,000 and 5,000 psi at 28 days depending on the tank size. The concrete design shall include the following for long-term durability: air entrainment, water reducing admixture, and steel reinforcement. Concrete encasements with seams will not be approved.
 8. The protected and insulated AST systems shall be of concrete exterior and a continuous and visually verifiable monolithic (seamless) pour on top, bottom, ends, and sides and contain no cold joints or heat sinks (heat transfer points). The AST must be shop fabricated and tested in accordance with the UL listings. Designs that use two layers of steel with insulation material between them will not be approved.
 9. No steel or insulating material shall come in contact with the concrete or other corrosive material.
 10. All openings shall be from the top only. All exposed metal with the exception of stainless steel must be powder coated to inhibit corrosion.

11. The protected and insulated AST systems shall include a 7 or 15-gallon powder coated or stainless steel, UL listed spill containment, and shall include normally closed valve to release spilled product into the primary steel tank. Spill containment which route the spilled product into interstitial area will not be approved
12. The protected and insulated AST systems shall have a coated concrete exterior to resist weather and reflect sunlight. Models with steel exteriors will not be approved.
13. The protected and insulated AST systems shall have a warranty of 30 years for systems 2,000 gallon capacity and larger and 20 years for systems 1,000 gallon capacity and smaller with optional 30-year warranty.
14. The protected and insulated AST systems design shall have been in use for a minimum of 20 years. The manufacturer must stipulate no reportable AST containment system failure in 30,000 units produced.
15. The protected and insulated AST systems shall have 2 bolts for connecting grounding conductors for lightning protection in accordance with NFPA 780.
16. All fittings shall be of stainless steel.
17. Provide an additional layer of tank coating.
18. Provide with NFPA compliant Hazmat signage.
19. Provide prefabricated tank access ladder or steps.
20. Provide with a manufacturer provided exterior color finish of Prairie Dusk 9242-M with smooth texture (For AST on Birkhimer Building only).
21. Provide with a manufacturer provided exterior color finish of Alpine White 9100-P with smooth texture (For AST on Building 303 only).

2.03 FUEL TANK CONTROL AND MONITORING

- A. Control and Monitoring Digital Display Panel:
 1. UL508 listed. Type 3R Enclosure for outdoor usage.
 2. PLC based, 6-inch touch-panel operator interface.
 3. Network capable, IP address capable.
 4. Spare I/O for options, MODBUS and Ethernet network compatible 4-20 mA loop output.
 5. Relay dry contact outputs.
 6. Provide with digital fuel tank level gauge for AST-1.

PART 3 - EXECUTION

3.01 INSTALLATION

A. General Installation Requirements for Piping:

1. Piping: Install piping in out-of-the way locations. Piping shall be free from traps and shall drain toward tank and equipment. Installation of oil piping and equipment in buildings shall conform to NFPA 31, except as indicated or specified herein. Feed line to equipment shall have a gate valve located near tank. Piping shall follow the general arrangement shown. Cut piping accurately to measurements established for the work. Work piping into place without springing or forcing, except where cold-springing is specified. Piping and equipment within buildings shall be entirely out of the way of lighting fixtures and doors, windows and other openings. Locate overhead piping in buildings in the most inconspicuous positions. Do not bury or conceal piping until it has been inspected, tested and approved. Where pipe passes through building structure, pipe joints shall not be concealed, but shall be located where they may be readily inspected and building structure shall not be weakened. Avoid interference with other piping, conduit or equipment. Except where specifically shown otherwise, vertical piping shall run plumb and straight and parallel to walls. Piping connected to equipment shall be installed to provide flexibility for vibration. Adequately support and anchor piping so that strain from weight of piping is not imposed on the equipment.
2. Fittings: Use long radius ells where appropriate to reduce pressure drops. Mitering of pipe to form elbows, notching straight runs to form full sized tees or any similar construction shall not be used.
3. Cleaning: Before jointing and erection of piping thoroughly clean interiors of pipe sections and components. In steel pipe, loosen scale and other foreign matter by rapping sharply and expel by wire brush and swab. Blow out both steel pipe and components with compressed air at 100 psig or more. Maintain cleanliness by closure of pipe openings with caps or plugs. Before making final terminal connections, blow out complete system with compressed air at 100 psig or more.
4. Changes in Pipe Size: Use reducing fittings for changes in pipe size. The use of bushings will not be permitted.
5. Pipe Sleeves: Provide pipe sleeves where pipes and tubing pass through masonry or concrete walls. Sleeves in outside walls above grade shall be steel pipe. Space between pipe, tubing, or insulation and the sleeve shall be not less than 5-inch. Hold sleeves securely in proper position and location before and during construction. Provide sleeves of sufficient length to pass through entire thickness of walls. Extend sleeves in floor slabs 1/2-inch above finished floor. Firmly pack space between the pipe or tubing and sleeve with oakum, and calk on both ends of sleeve with elastic cement.
6. Wall Plates: Secure plates to pipes at sleeves in buildings. All plates shall be painted cast-iron, malleable iron, or steel.

7. Steel Piping: Steel piping 2-inches and smaller shall be threaded. Piping joints shall conform to ANSI B31.4.
8. Screwed Joints in Piping: Use cylinder oil and graphite or graphite pipe-joint compound applied to male threads only for making up screwed joints. Red or white lead and zinc compound may be used. Lubricate threaded pipe joints, as well as bolts and studs used on high temperature pipe joints up to 1050°F, with anti-seize compound. Piping shall be free from fins and burrs. Ream or file out pipe ends to size of bore and remove chips.
9. Unions: Place unions where necessary to permit easy disconnection of piping and apparatus. Each connection having a screw end valve shall have a union. Unions shall be as specified.
10. Valves: Install valves in positions accessible for operation and repair.
11. Install Double Trac double wall pipe in accordance with manufacturer's instructions.

3.02 FIELD TESTS

- A. Tests: Prior to application of test pressure, install a currently calibrated test gage in the system and remove or valve off piping components which may be damaged by test. Maintain test pressure for at least one-hour. In the event of leakage, locate and repair leak and repeat test. Submit 3 copies of test reports to the Contracting Officer for all tests.
 1. Piping Test: Perform hydrostatic test of fuel oil piping with diesel fuel-oil at 1-1/2 times system pressure or 100 psig whichever is greater.

3.03 SHOP DRAWING

- A. Provide shop drawing for engineer's review and approval prior to commencing anyway work.
 1. Clearly indicate route of piping, fuel tank, and other equipment
 2. Include phasing, and sequence of work.

END OF SECTION

SECTION 15607 - NONMETALLIC UNDERGROUND PIPING FOR PETROLEUM

PART 1 - GENERAL

1.01 RELATED DOCUMENTS

- A. The General Provisions of the contract, including General and Special Provisions and General Requirements of the Specifications, apply to the work specified in this section.
 - 1. SECTION 15606 - POL SYSTEMS.
- B. References:
 - 1. AMERICAN PETROLEUM INSTITUTE (API)
 - a. API Spec 6D: (2002; Errata 2005) Specification for Pipeline Valves
 - b. API 1615 (R2001)
 - 2. ASTM INTERNATIONAL (ASTM)
 - a. ASTM A 53/A 53M: (2007) Standard Specification for Pipe, Steel, Black and Hot-Dipped, Zinc-Coated, Welded and Seamless
 - b. ASTM C 920: (2005) Standard Specification for Elastomeric Joint Sealants
 - c. ASTM C 94/C 94M: (2007) Standard Specification for Ready-Mixed Concrete
 - 3. MANUFACTURERS STANDARDIZATION SOCIETY OF THE VALVE AND FITTINGS INDUSTRY (MSS)
 - a. MSS SP-72: (1999) Standard for Ball Valves with Flanged or Butt-Welding Ends for General Service

1.02 DESCRIPTION OF WORK

- A. This specification covers the requirements for design, installation, and testing of buried coaxial nonmetallic fiberglass piping for petroleum products in underground locations.

1.03 QUALITY ASSURANCE

- A. Submit a manufacturer's certification that the fiberglass piping systems products are qualified to accommodate and operate on diesel oil #2, jet fuel, conforming to ASTM D1655, and biodiesel, conforming to ASTM D6751-07b.
- B. Submit a manufacturer's certified list of contractor personnel qualified to install and join the fiberglass piping. Personnel not on the list will not be permitted to install and join fiberglass piping.
- C. Upon completion of the project and before final acceptance, deliver a statement signed by the principal officer of the contracting firm stating that the installation is

satisfactory and in complete accordance with the contract plans and specifications and the fiberglass pipe manufacturer's prescribed procedures and techniques.

- D. The pipe and fittings shall be free from defects including delaminations, indentations, pinholes, foreign inclusions, bubbles and resin-starved areas which, due to their nature, degree or extent, detrimentally affect the strength and serviceability of pipe or fittings. The pipe and fittings shall be as uniform as commercially practicable in color, opacity, density and other physical properties.

1.04 SUBMITTALS

- A. Submit in accordance with SECTION 01300 - SUBMITTALS.
- B. Provide product data for the following in accordance with manufacturer's standards:
 - 1. Fiberglass pipe and fittings.
 - 2. Adhesive.
 - 3. Valves.
- C. Provide shop drawing for the piping system.
- D. Provide the following test reports:
 - 1. Initial pneumatic tests.
 - 2. Second pneumatic tests.
 - 3. Hydrostatic test.
 - 4. Hydrostatic cycle test.
 - 5. Operational test.
- E. Provide the list of qualified installers for the fiberglass piping system.

PART 2 - PRODUCTS

2.01 MATERIALS

- A. General: Fiberglass piping system shall conform to the respective specifications and standards and to the requirements specified herein. Pipe, fittings, and joint adhesives shall be supplied by the same manufacturer.
- B. Fiberglass Pipe: All filament-wound pipe shall contain a resin-rich inner liner with a minimum thickness of 0.015 inches. The liner resin system shall be a chemically resistant epoxy resin that has been demonstrated to be satisfactory for the intended service.
 - 1. Structural Wall: The resins, reinforcements, colorants and other materials when combined as a composite laminate structure shall meet the

performance requirements of this specification. Glass fiber reinforcement shall be Type E glass with an epoxy-compatible finish. Glass fiber content shall not be less than 60% by weight of the reinforced structural wall.

2. Exterior Coating: The pipe exterior shall have a 0.005-inch (0.13 mm) thick resin-rich coating with an organic fibrous reinforcement.
 3. Pipe Dimensions: Pipe shall be manufactured to steel pipe outside diameters for all sizes. Pipe outside diameter tolerances shall not exceed $\pm 1\%$.
 4. Wall Thickness: The total wall thickness of pipe furnished under this specification shall not at any point be greater than 120% nor less than 87.5% of the nominal thickness.
 5. Joining Methods:
 - a. Tapered Bell X Spigot Adhesive-Bonded Joints: Pipe and fittings shall be joined by means of a matching taper adhesive joint. Adhesives used for joining components shall be compatible with all intended fluids. The adhesive systems shall be used in accordance with the manufacturer's recommendations.
 - b. Adapters and Crossovers: The following adapters and crossovers shall be provided as required:
 - Bell 2" NPP threaded female
 - Bell 2" NPT threaded male
 - Spigot 2" NPT threaded female
 - Spigot 2" NPT threaded male
 6. Flanges: Flanges shall be two-piece type with raised grooves on the sealing face. Fiberglass-reinforced stub ends are to be adhesive bonded to the pipe of fitting.
 7. O-rings, seals, gaskets, hoses and other elastomers shall be Viton, and if not, then must be diesel, biodiesel, and Jet-A fuel compatible material.
- C. Fittings: Fittings material shall be compression-molded and filament-wound fiberglass reinforced epoxy.
- D. Vent and Drain Valves: Stainless steel or aluminum construction.
- E. Valve Boxes: For each buried valve provided cast-iron, ductile-iron, or plastic box of a suitable size. Provide cast-iron, ductile-iron, or plastic cover for the box with "FUEL OIL" cast on the cover. Plastic boxes shall be constructed of ABS plastic or inorganic fiber-reinforced black polyolefin plastic. Coat cast-iron and ductile-iron boxes with bituminous paint.

PART 3 - EXECUTION

3.01 FIBERGLASS PIPING FIELD ASSEMBLY

- A. Fiberglass piping field assembly shall be in accordance with the manufacturer's written instructions and installation procedures as approved by the government. Submit design and installation drawings that indicate and detail recommended installation procedures including provisions for expansion, anchors, thrust blocks, supports, vent, and drain connections.
1. Inspection: Prior to preparation and assembly, the Contractor shall inspect pipe for physical damage and make repairs in accordance with the manufacturer's written instructions, except over wrapping the damaged or faulty area with any type patch or other material will not be permitted.
 2. Adhesive Mixing and Application: Adhesive materials, mixing, and application shall be in accordance with manufacturer's instructions including limitations on adhesive shelf life and pot life.
 3. Assembly and Alignment: Assemble fiberglass pipe and fittings according to manufacturer's instructions. Proper alignment must be maintained during assembly so that twisting or straightening is not required after joining. Misalignment shall not exceed 1/16 inch or one degree prior to application of adhesive.
 4. Curing: Cure fiberglass pipe joints and fitting joints according to the manufacturer's instructions. Heating devices shall be as recommended by the fiberglass pipe manufacturer. Do not move, vibrate, or otherwise disturb joints during curing of adhesive.
 5. Connections to Metal Pipe: Use flanged connections between fiberglass pipe and metal pipe with the metal pipe anchored within 5 feet of the connection. Do not transmit expansion and load forces of metal piping to the fiberglass pipe. Do not bury metal-to-fiberglass connections. Install washers under bolt heads and nuts on flanges, and torque bolts in accordance with manufacturer's requirements.
 6. Air Vents and Low Point Drains: Install hand operated air vent valves at all high points in the piping. Install hand operated low point drain valves at low points in the piping.
 7. Pitch: Pitch horizontal buried fuel piping, unless otherwise indicated, with a downward grade of not less than one inch in 50 feet in the direction of low point drains.
- B. Fiberglass Pipe Installation:
1. Pipe Assembly: Visually inspect the inside of each length of pipe to ensure that it is clear and clean prior to installation. Not more than 40 foot lengths of fiberglass pipe can be assembled over or beside the trench. Assemble greater lengths in the trench. Assemble outside the trench on timbers with the pipe blocked to hold alignment. Lower pipe into the trench in accordance with the manufacturer's recommendations. Lowering operation shall not

move or disturb fiberglass pipe where joints are being assembled and cured. Block and support fiberglass pipe assembled in the trench with bedding to hold alignment.

2. Bending of Fiberglass Pipe: Limit bending of pipe to follow ditch contours to long trench curvatures and do not permit abrupt changes in pipeline direction. Bending radii shall not be less than shown in the manufacturer's installation instructions. Do not make bends until all joints in the section of pipe to be bent are cured.
 3. Open Ends of the Pipe System: Close the open ends of the pipe system at the end of each day's work or when work is not in progress and keep closed until work is resumed.
- C. Manholes and Wall Penetrations: Where an fiberglass pipe penetrates manhole, concrete, masonry, or metal walls, provide a Schedule 40 steel pipe sleeve 2 inches larger than the pipe in accordance with ASTM A 53/A 53M. Each steel pipe sleeve shall be given a coat of bituminous paint. Calk opening between sleeve and pipe with sealing compounds conforming to ASTM C 920, Type S or M, Grade NS, Class 25, use M or FS TT-S-001543, Type Non-Sag, Class A. Install in-line thrust or anchor blocks at least 5 feet outside of manhole or wall penetration.
- D. Line Valves: Install line valves with stems vertically up. Provide individual supports and anchors for line valves. Sealed valve box or pit shall prevent soil and moisture contact with valve.
- E. Flushing: Prior to hydrostatic testing, flush the fiberglass pipe system with water until piping is free of dirt and foreign matter.
- F. Field Inspection and Tests: Furnish everything required for performing inspections and tests. Correct defects and repeat the respective inspections and tests.
1. Test Gages: Use pressure test gages certified as being accurate to within one percent of their full scale. Use gages with maximum scale between 1 1/2 and 2 times the test pressure.
 2. Field Inspections: Prior to initial operation, inspect piping system for conformance to drawings, specifications, and manufacturer's submittals.
 3. Field Tests:
 - a. initial Pneumatic Tests: Pneumatically test all fiberglass pipe and fittings and all fiberglass pipe to metal fittings at a pressure of 15 psig for at least 4 hours during which time brush each joint with a soap solution and examine for leaks. Maintain 15 psig pressure throughout test period. The piping may be tested in sections, but test the entire installation at 15 psig prior to the hydrostatic test. Contractor shall furnish all necessary air compressors, gages, and other equipment necessary for carrying out the tests. No taps in the line are permitted. Isolate equipment such as pumps and filter-separators from the fiberglass piping system during the

test. Prior to starting any pneumatic testing of buried fiberglass pipe, portions of the pipe between all joints must be backfilled in place 24 inches over the top of the pipe as a safety measure.

- b. Second Pneumatic Tests: Increase pneumatic pressure on all fiberglass pipe and fittings to 50 psig. Hold pressure for at least 4 hours without a drop in pressure. An allowance of 5 psi may be made for gage error and thermal expansion and contraction. To reduce effects of solar load, begin testing near sundown or provide shade for exposed piping. During 4 hour pressure holding period, valve off system and disconnect method of system pressurization. Rely only on gage pressure for leak detection and provide signs warning personnel to stay clear of trenches during testing.
- c. Hydrostatic Test: Hydrostatically pressure test all fiberglass pipe and fittings and all fiberglass pipe to metal fittings using potable water to 1-1/2 times the maximum operating pressure or 225 psig whichever is greater for a period of 4 hours prior to placement of sand bedding and backfill, except as required by paragraph entitled "Initial Pneumatic Test." The operating pressure shall be the sum of the static head pressure, pressure required to overcome friction losses, and any required back pressure. Provide controls and protective equipment so that the level of pressure rise above operating pressure due to surges and other variations from normal operation shall not exceed the test pressure at any point in the piping system. Limit pressure rise to 100 psi per minute at beginning of test and pressure drop to 00 psi per minute at conclusion of test. Air or vapor at all high points in the system must be replaced by the test fluid before testing. Pressure must hold for a minimum of 4 hours with a 4 psi maximum drop. After 4 hours at test pressure and with pressure still applied, visually inspect all pipe, fittings, and joints for indications of weeping or leaking. Repair any weeping or leaking condition discovered in accordance with paragraph entitled "Field Repairs of Pipe and Joints." During 4 hour pressure holding period, valve off system and disconnect method of pressurization.
- d. Hydrostatic Cycle Test: Pressure cycle test system at 275 psig or 1-1/2 times the maximum operating pressure, whichever is greater, for 10 cycles. Each cycle shall consist of a one-minute period at 275 psig or 1-1/2 times the maximum operating pressure and a 4 minute period when the pressure is dropped at least 40 percent. Examine system for leaks and porosity, repair in accordance with paragraph entitled "Field Repairs of Pipe and Joints," and repeat test until system is proven tight. After successful completion of hydrostatic test series, cast concrete thrust blocks around fiberglass pipe in accordance with paragraph entitled "Thrust Blocks." After casting thrust blocks, backfill and compact bedding around center portions of fiberglass pipe with thrust blocks and joints clear for observation. Fiberglass pipe must be held in place during operational tests after thrust blocks are installed. The expansion of fiberglass pipe must be absorbed by the fiberglass pipe itself. No expansion will be absorbed by changes in direction of the pipe or by expansion joints in buried systems.

- e. Operational Test: Thoroughly dry system of all water and fill with fuel. Verify operation of surge absorbers and system relief valves. Operate complete system as in service with fuel at design flow rates for 48 hours with fuel flowing through the system for 8 hours and flow stopped for 8 hours. Examine system for leaks and porosity. Repair leaks, replace porous pipe, and repeat test until system is proven tight. After successful completion of the test series, backfill trench.
- f. Additional Flushing: Flush or re-circulate aviation fuel dispensing system with design specification fuel until station fuel lab tests indicate fuel quality at dispensing point meets cleanliness use limits of:

Particulate matter 8.0 mg/gal
Free water 20 ppm

- g. Disposal of Hydrostatic Test Water:
 - 1) Apply for Temporary Industrial Waste Water Permit (IWDP) prior to any hydrostatic test, and within (20) twenty calendar days of the completion of the discharge event.
 - 2) Notify State twenty-one (21) calendar days prior to the test and disposition of the water.
 - 3) Perform the required tests.
 - 4) Sample the water, and conduct necessary tests to ensure that the effluent complies with the Revised Ordinances of Honolulu (ROH) 14-1.9, as amended, applicable City, State and Federal regulations.
 - 5) Dispose the water, and complete a self-monitoring report certifying the Row rate of discharge, the exact time and date(s) of discharge, the duration of discharge and total volume of discharge.
 - 6) Provide one copy of the temporary industrial waste water permit, self-monitoring report, and water sample test results to State, if testing is necessary.
 - 7) See SECTION 15606 - POL SYSTEMS for other hydrostatic test and procedures to dispose of water.

- 4. Field Repairs of Pipe and Joints: The Contractor shall be responsible for the repair of all leaks or other deficiencies caused by faulty workmanship or materials. Make repairs to leaking pipe or joints, whatever the cause, by removing and replacing the faulty section or a short length containing the fault. Over wrapping the fault with any type of patch or other material will not be permitted. If a joint is damaged during the laying operation, it can be cut off and a coupling bonded to the cutoff end and laid in the line as a normal pipe. If damage occurs to a pipe after it has been laid, the damaged section

shall be cut out and replaced with a new pipe section in accordance with the manufacturer's instruction.

END OF SECTION

D

C

B

A

CONSTRUCTION NOTES:

- 1

2

3

4

5
- ALL CONSTRUCTION WORK SHALL BE DONE IN ACCORDANCE WITH STANDARD SPECIFICATIONS FOR PUBLIC WORKS CONSTRUCTION, SEPTEMBER 1986, AND STANDARD DETAILS FOR PUBLIC WORKS CONSTRUCTION, SEPTEMBER 1984, AS AMENDED, OF THE DEPARTMENTS OF PUBLIC WORKS, CITY & COUNTY OF HONOLULU, AND THE COUNTIES OF KAUAI, MAUI, AND HAWAII AND THE STANDARD PLANS OF THE STATE OF HAWAII, DEPARTMENT OF TRANSPORTATION, HIGHWAYS DIVISION, INCLUSIVE DATED JULY 1, 1986, AS AMENDED AND PARK STANDARD DETAILS FOR PARKS AND RECREATION CONSTRUCTION, MAY 1990, AS AMENDED, OF THE DEPARTMENT OF PARKS AND RECREATION, CITY & COUNTY OF HONOLULU.
 - THE CONTRACTOR SHALL PROVIDE ACCESS TO AND FROM PUBLIC STREETS AT ALL TIMES.
 - WHEN TRENCH EXCAVATION IS ADJACENT TO OR UNDER EXISTING STRUCTURES OR FACILITIES, THE CONTRACTOR SHALL BE RESPONSIBLE FOR PROPERLY SHEETING AND BRACING THE EXCAVATION AND STABILIZING THE EXISTING GROUND TO RENDER IT SAFE AND SECURE FROM POSSIBLE SLIDES, CAVE-INS AND SETTLEMENT AND FOR PROPERLY SUPPORTING EXISTING STRUCTURES AND FACILITIES WITH BEAMS, STRUTS OR UNDER- PINNING TO FULLY PROTECT THEM FROM DAMAGE.
 - BACKFILL UNDER EXISTING STRUCTURES OR FACILITIES SHALL BE SANDY OR GRANULAR MATERIAL COMPLETELY PLACED AS SOON AS THE PIPE IS LAID AND TESTED. THE BACKFILL MATERIAL SHALL BE RAMMED WITH PROPER TOOLS UNTIL COMPACTED TO A MINIMUM OF 90 PERCENT OF ITS MAXIMUM DENSITY.
 - ALL EXCAVATION WORK CALLED FOR ON THE PLANS AND NOT ITEMIZED IN THE PROPOSAL AND ALL EXCAVATION WORK NOT CALLED FOR BUT REQUIRED FOR THE CONSTRUCTION OF THIS PROJECT SHALL BE CONSIDERED INCIDENTAL TO UNCLASSIFIED TRENCH EXCAVATION.
 - ALL ABANDONED PIPE OPENINGS SHALL BE PLUGGED WITH CLASS DWS 2000 CONCRETE TO A DEPTH OF 1-1/2 TIMES THE DIAMETER OF THE PIPE.
 - VERIFY AND CHECK ALL DIMENSIONS AND DETAILS SHOWN ON THE DRAWINGS PRIOR TO THE START OF CONSTRUCTION. ANY DISCREPANCY SHALL BE IMMEDIATELY BROUGHT TO THE ATTENTION OF THE ENGINEER FOR DIRECTION.
 - NO CONTRACTOR SHALL PERFORM ANY CONSTRUCTION ACTIVITY SO AS TO CAUSE FALLING ROCK, SOIL OR DEBRIS IN ANY FORM TO FALL, SLIDE OR FLOW ONTO ADJOINING PROPERTIES, STREETS OR NATURAL WATER COURSES. SHOULD SUCH VIOLATIONS OCCUR, THE COSTS INCURRED FOR ANY REMEDIAL ACTION SHALL BE PAYABLE BY THE CONTRACTOR.
 - THE UNDERGROUND PIPES, CABLES OR DUCTLINES KNOWN TO EXIST BY THE ENGINEER FROM HIS SEARCH OF RECORDS ARE INDICATED ON THE PLANS. THE CONTRACTOR SHALL VERIFY THE LOCATIONS AND DEPTHS OF THE FACILITIES AND EXERCISE PROPER CARE IN EXCAVATING IN THE AREA. ALL DAMAGED PORTIONS SHALL BE REPLACED IN ACCORDANCE WITH THE STANDARDS AND SPECIFICATIONS OF THE AFFECTED UTILITY COMPANY AND SHALL BE THE CONTRACTORS RESPONSIBILITY. PERSONAL INJURY RESULTING FROM CONTACT WITH EXISTING UTILITIES SHALL BE THE CONTRACTORS RESPONSIBILITY. WHEREVER CONNECTIONS OF NEW UTILITIES TO EXISTING UTILITIES ARE SHOWN ON THE PLANS, THE CONTRACTOR SHALL EXPOSE THE EXISTING LINES AT THE PROPOSED CONNECTIONS TO VERIFY THEIR LOCATIONS AND DEPTHS PRIOR TO EXCAVATION FOR NEW LINES.
 - THE CONTRACTOR SHALL BE RESPONSIBLE FOR CONFORMANCE WITH THE APPLICABLE PROVISIONS OF CHAPTER 54, WATER QUALITY STANDARDS, AND CHAPTER 55, WATER POLLUTION CONTROL, OF TITLE 11, ADMINISTRATIVE RULES OF THE STATE DEPARTMENT OF HEALTH.
 - THE CONTRACTOR SHALL NOTIFY ALL AGENCIES TO VERIFY THE ACTUAL LOCATIONS OF ALL UTILITIES IN THE PROJECT AREA PRIOR TO EXCAVATING. THE CONTRACTOR SHALL COORDINATE ALL WORK.
 - THE CONTRACTOR SHALL RESTORE TO THEIR ORIGINAL CONDITION OR BETTER, ALL IMPROVEMENTS DAMAGED AS A RESULT OF THE CONSTRUCTION, INCLUDING PAVEMENTS, EMBANKMENTS, CURBS, SIGNS, LANDSCAPING, STRUCTURES, UTILITIES, WALLS, FENCES, ETC. UNLESS PROVIDED FOR SPECIFICALLY IN THE PROPOSAL. DEMOLITION AND RESTORATION OF EXISTING ITEMS SHALL BE INCIDENTAL AND INCLUDED WITHIN THE AMOUNT PAID FOR UNCLASSIFIED TRENCH EXCAVATION.
 - CONTRACTOR SHALL EXERCISE EXTREME CAUTION TO PRESERVE STREET MONUMENTS.
 - WHENEVER THE CENTER OF A STREET SURVEY MONUMENT IS LESS THAN THREE (3) FEET AWAY FROM THE EDGE OF TRENCH, THE CONTRACTOR SHALL RETAIN A LICENSED LAND SURVEYOR TO REFERENCE THE LOCATION OF SAID STREET MONUMENT. ALL REFERENCING WORK SHALL BE SUBMITTED TO THE DEPARTMENT OF DESIGN AND CONSTRUCTION, SURVEY BRANCH (527-5329), FOR REVIEW AND APPROVAL BEFORE COMMENCEMENT OF CONSTRUCTION ADJACENT TO STREET MONUMENT.
 - STREET MONUMENTS THAT ARE DISTURBED SHALL BE RESTORED UNDER THE LICENSED LAND SURVEYOR'S DIRECTION. ANY NEW DATA SUCH AS ELEVATIONS SHALL BE CERTIFIED BY THE SURVEYOR, AND SUBMITTED TO THE DEPARTMENT OF PLANNING AND PERMITTING.
 - THE CONTRACTOR SHALL BE RESPONSIBLE FOR REPLACING/RECONSTRUCTING ALL CONCRETE CURBS AND GUTTERS, CONCRETE SWALES, DRIVEWAYS AND SIDEWALKS DAMAGED DURING CONSTRUCTION.
 - DURING NON-WORKING HOURS, THE TRENCHES SHALL BE COVERED WITH NON-SKID STEEL PLATES AND ALL LANES MAINTAINED OPEN FOR TRAFFIC.
 - THE CONTRACTOR SHALL PROVIDE ACCESS TO AND FROM DRIVEWAYS AND PUBLIC STREETS AT ALL TIMES EXCEPT AS NOTED ON THE PLAN.
 - EXISTING TOPOGRAPHIC DATA WAS TAKEN FROM TOPOGRAPHIC MAP PREPARED BY CONTROL POINT SURVEYING, INC, DATED JANUARY 16, 2024.

CONSTRUCTION NOTES CONTINUED:

- 1

2

3

4

5
- ALL WORK CALLED FOR ON THE PLANS AND NOT ITEMIZED IN THE PROPOSAL AND ALL WORK NOT CALLED FOR BUT REQUIRED FOR THE CONSTRUCTION OF THIS PROJECT, SHALL BE CONSIDERED INCIDENTAL.
 - UTILITIES SHALL BE INSTALLED PURSUANT TO THE PROVISIONS OF ORDINANCE NO. 2875 AS AMENDED BY ORDINANCE NO. 3357 (UNDERGROUND UTILITIES).
 - NO BLASTING SHALL BE ALLOWED ON THIS PROJECT.
 - THE CONTRACTOR SHALL NOTIFY THE ONE CALL CENTER AT (866) 423-7287 AT LEAST 5 DAYS PRIOR TO THE START OF EXCAVATION OR TRENCHING.
 - PURSUANT TO CHAPTER 14, ARTICLE 15, OF THE REVISED ORDINANCES OF HONOLULU 1990 AS AMENDED, THE PERMITTEE/CONTRACTOR SHALL RETAIN THE SERVICES OF:
 - A LICENSED PROFESSIONAL ENGINEER TO BE RESPONSIBLE DURING CONSTRUCTION AND PREPARE THE CERTIFICATION AND REPORT AFTER GRADING.
 - A LICENSED LAND SURVEYOR TO PERFORM A SURVEY OF THE FINISHED GRADING FOR THE PREPARATION OF AN AS BUILT GRADING PLAN IF REQUIRED BY DPP.

EROSION CONTROL NOTES AND BEST MANAGEMENT PRACTICES (BMPS):

- 1

2

3

4

5
- CONTRACTOR SHALL REFER TO THE CITY AND COUNTY OF HONOLULU STORMWATER BEST MANAGEMENT PRACTICE, MANUAL, CONSTRUCTION DATED NOVEMBER 2011 FOR BEST MANAGEMENT PRACTICES DETAILS AND SPECIFICATIONS.
 - MEASURES TO CONTROL EROSION AND OTHER POLLUTANTS SHALL BE IN PLACE BEFORE ANY CLEARING AND GRUBBING WORK IS INITIATED. THESE MEASURES SHALL BE PROPERLY CONSTRUCTED AND MAINTAINED THROUGHOUT THE CONSTRUCTION PERIOD.
 - CONSTRUCTION SHALL BE SEQUENCED TO MINIMIZE THE EXPOSURE TIME OF CLEARED SURFACE AREA.
 - ALL CONTROL MEASURES SHALL BE CHECKED AND REPAIRED AS NECESSARY.
 - PROVIDE CONSTRUCTION ENTRANCE FOR EACH INGRESS AND EGRESS.
 - PRE-CONSTRUCTION VEGETATIVE GRADE COVER SHALL NOT BE DESTROYED, REMOVED OR DISTURBED MORE THAN TWENTY (20) CALENDAR DAYS PRIOR TO SITE DISTURBANCE.
 - TEMPORARY SOIL STABILIZATION WITH APPROPRIATE VEGETATION SHALL BE APPLIED ON AREAS THAT WILL REMAIN UNFINISHED FOR MORE THAN FOURTEEN (14) CALENDAR DAYS.
 - STORM WATER FLOWING TOWARD THE CONSTRUCTION AREA SHALL BE DIVERTED BY USING APPROPRIATE CONTROL MEASURES AS PRACTICAL.
 - ALL BMPs SHALL BE CONSTRUCTED AND OPERATIONAL PRIOR TO GRADING PHASE.
 - ADDITIONAL DUST FENCE MAY BE REQUIRED AND THAT SPECIFIC LOCATIONS SHALL BE DETERMINED AT THE TIME THE PRE-CONSTRUCTION MEETING IS HELD.
 - CONTRACTOR SHALL PROVIDE TEMPORARY PROTECTION FOR EXISTING CATCH BASINS, DURING CONSTRUCTION AND UNTIL CONSTRUCTION AREA IS STABILIZED AND FINAL GRADES ARE ACHIEVED.
 - STOCKPILES SHALL NOT BE LOCATED IN DRAINAGE WAYS OR OTHER AREAS OF CONCENTRATED FLOWS. DURING PERIODS OF WET WEATHER, SUCH AS THE RAINY SEASON, STOCKPILES SHALL BE STABILIZED. COVER STOCKPILES IN PLASTIC WHEN NOT IN USE.
 - DUST CONTROL SHOULD BE APPLIED TO REDUCE DUST EMISSIONS. CONTRACTOR TO SPRAY WATER AS NECESSARY.
 - SEDIMENT TRAPPING DEVICES SUCH AS FENCES, TRAPS, BASINS OR BARRIERS SHALL BE USED DOWN SLOPE OF ALL DISTURBED AREAS AND AROUND THE BASE OF ALL MATERIAL STOCKPILES. COVER STOCKPILES WITH PLASTIC.
 - SURFACE FLOW FROM ABOVE AN EXPOSED SLOPE SHALL NOT BE ALLOWED TO FLOW OVER THE SLOPE WITHOUT PROTECTION. SLOPE PROTECTION SHALL BE USED ON AREAS WITH SLOPES GREATER THAN 50% AND ON AREAS OF MODERATE SLOPES THAT ARE PRONE TO EROSION. SLOPE PROTECTION SHALL ALSO BE USED ON GROUND SURFACES AND STOCKPILES EXPOSED DURING WET WEATHER. ANCHOR PLASTIC OVER RETAINING WALL EXCAVATION.
 - ALL STORM DRAIN INLETS ON SITE, AND THOSE OFFSITE WHICH MAY RECEIVE RUNOFF FROM THE SITE SHALL USE AN INLET PROTECTION DEVICE.
 - ALL DISTURBED AREAS SHALL BE PERMANENTLY STABILIZED PRIOR TO REMOVING EROSION AND SEDIMENT MEASURES. ALL TEMPORARY EROSION AND SEDIMENT MEASURES SHALL BE REMOVED WITHIN 30 DAYS AFTER FINAL SITE STABILIZATION OR AFTER THE TEMPORARY MEASURES ARE NO LONGER NEEDED. TRAPPED SEDIMENT AND AREAS OF DISTURBED SOIL WHICH RESULT FROM THE REMOVAL OF THE TEMPORARY MEASURES SHALL BE IMMEDIATELY PERMANENTLY STABILIZED.
 - AREAS TO BE PERMANENTLY SEEDED/MULCHED WITHIN 14 DAYS OR FINAL GRADE EXCEPT HOUSE AREA WHICH WILL BE FORMED AND SLABBED WITHIN 14 DAYS.
 - CONTRACTOR TO PROVIDE TEMPORARY INLET PROTECTION UPON INSTALLATION OF DRAINAGE IMPROVEMENTS.

EROSION CONTROL NOTES AND BEST MANAGEMENT PRACTICES (BMPS) CONTINUED:

- 1

2

3

4

5
- DISTURBED AREAS OF CONSTRUCTION SITES THAT WILL NOT BE REDISTURBED FOR TWENTY-ONE DAYS OR MORE WILL BE STABILIZED (GRASSED OR GRAVELED) BY NO LATER THAN THE FOURTEENTH DAY AFTER LAST DISTURBANCE.
 - CONTRACTOR SHALL COMPLETE THE CITY AND COUNTY OF HONOLULU "CONSTRUCTION SITE BMPs WEEKLY CHECKLIST" FORM EACH WEEK AND SUBMIT THE FORM TO THE DEPARTMENT OF PLANNING AND PERMITTING CIVIL ENGINEER BRANCH (CEB) INSPECTOR AT THE END OF EACH WEEK FOR ALL GRADING, GRUBBING AND STOCKPILING PERMITS THAT RESULT IN THE DISTURBANCE OF ONE ACRE OR MORE OF TOTAL LAND AREA. REQUESTS FOR ADJUSTMENTS TO SUBMISSION SCHEDULE SHALL BE COORDINATED WITH THE CEB INSPECTOR. THE FORM SUBMITTAL CONCLUDES WHEN THE CEB INSPECTOR DETERMINES THAT THE WORK UNDER THE PERMIT IS COMPLETE.

PUBLIC HEALTH SAFETY AND CONVENIENCE NOTES:

- 1

2

3

4

5
- CONTRACTOR SHALL OBSERVE AND COMPLY WITH ALL FEDERAL, STATE, AND LOCAL LAWS REQUIRED FOR THE PROTECTION OF PUBLIC HEALTH, SAFETY AND ENVIRONMENTAL QUALITY.
 - THE CONTRACTOR AT HIS/HER EXPENSE, SHALL KEEP THE PROJECT AREA AND SURROUNDING AREA FREE FROM RUBBISH, DUST, NOISE, EROSION, ETC. THE WORK SHALL BE DONE IN CONFORMANCE WITH THE AIR AND WATER POLLUTION CONTROL STANDARDS AND REGULATIONS OF THE STATE DEPARTMENT OF HEALTH.
 - NO CONTRACTOR SHALL PERFORM ANY CONSTRUCTION OPERATION SO AS TO CAUSE FALLING ROCKS, SILT OR DEBRIS IN ANY FORM TO FALL, SLIDE OR FLOW ONTO ADJOINING PROPERTIES, STREETS OR NATURAL WATERCOURSES. SHOULD SUCH VIOLATIONS OCCUR, THE CONTRACTOR MAY BE CITED AND THE CONTRACTOR SHALL IMMEDIATELY MAKE ALL REMEDIAL ACTIONS AS NECESSARY.
 - THE CONTRACTOR SHALL PROVIDE, INSTALL AND MAINTAIN ALL NECESSARY SIGNS, LIGHTS, FLARES, BARRICADES, MARKERS, CONES, AND OTHER PROTECTIVE FACILITIES AND SHALL TAKE ALL NECESSARY PRECAUTIONS FOR THE PROTECTION, CONVENIENCE AND SAFETY OF THE PUBLIC.
 - THE CONTRACTOR'S ATTENTION IS DIRECTED TO CHAPTER 46, PUBLIC HEALTH REGULATIONS, DEPARTMENT OF HEALTH, STATE OF HAWAII, "COMMUNITY NOISE CONTROL," IN WHICH MAXIMUM PERMISSIBLE NOISE LEVELS HAVE BEEN SET. IF THE CONSTRUCTION WORK REQUIRES A PERMIT FROM THE DIRECTOR OF HEALTH, THE CONTRACTOR SHALL OBTAIN A COPY OF CHAPTER 46 AND BECOME FAMILIAR WITH THE NOISE LEVEL RESTRICTIONS AND THE PROCEDURES FOR OBTAINING A PERMIT FOR THE CONSTRUCTION ACTIVITIES. APPLICATION AND INFORMATION ON VARIANCES ARE AVAILABLE FROM THE ENVIRONMENTAL PROTECTION AND HEALTH SERVICES DIVISION, 1250 PUNCHBOWL ST., HONOLULU, HI 96813 OR BY TELEPHONE (548-6455).

GRADING NOTES:

- 1

2

3

4

5
- ALL GRADING WORK SHALL BE DONE IN ACCORDANCE WITH CHAPTER 14, ARTICLES 13, 14, 15 AND 16, AS RELATED TO GRADING, SOIL EROSION AND SEDIMENT CONTROL OF THE REVISED ORDINANCES OF HONOLULU, 1990, AS AMENDED, AND SOILS REPORT BY HIRATA & ASSOCIATES DATED 3/21/24.
 - NO CONTRACTOR SHALL PERFORM ANY GRADING OPERATION SO AS TO CAUSE FALLING ROCKS, SOIL OR DEBRIS IN ANY FORM TO FALL, SLIDE OR FLOW ONTO ADJOINING PROPERTIES, STREETS OR NATURAL WATERCOURSES. SHOULD SUCH VIOLATIONS OCCUR, THE CONTRACTOR MAY BE CITED AND THE CONTRACTOR SHALL IMMEDIATELY MAKE ALL REMEDIAL ACTIONS NECESSARY.
 - THE CONTRACTOR, AT HIS OWN EXPENSE, SHALL KEEP THE PROJECT AREA AND SURROUNDING AREA FREE FROM DUST NUISANCE. THE WORK SHALL BE IN CONFORMANCE WITH THE AIR POLLUTION CONTROL STANDARDS CONTAINED IN THE HAWAII ADMINISTRATIVE RULES, TITLE 11, CHAPTER 60.1, "AIR POLLUTION CONTROL".
 - THE UNDERGROUND PIPES, CABLES OR DUCTLINES KNOWN TO EXIST BY THE ENGINEER FROM HIS SEARCH OF RECORDS ARE INDICATED ON THE PLANS. THE CONTRACTOR SHALL VERIFY THE LOCATIONS AND DEPTHS OF THE FACILITIES AND EXERCISE PROPER CARE IN EXCAVATING IN THE AREA. WHEREVER CONNECTIONS OF NEW UTILITIES ARE SHOWN ON THE PLANS, THE CONTRACTOR SHALL EXPOSE THE EXISTING LINES AT THE PROPOSED CONNECTIONS TO VERIFY THEIR LOCATIONS AND DEPTHS PRIOR TO EXCAVATION FOR THE NEW LINES.
 - ADEQUATE PROVISIONS SHALL BE MADE TO PREVENT SURFACE WATERS FROM DAMAGING THE CUT FACE OF AN EXCAVATION OR THE SLOPED SURFACES OF A FILL. FURTHERMORE, ADEQUATE PROVISIONS SHALL BE MADE TO PREVENT SEDIMENT-LADEN RUNOFF FROM LEAVING THE SITE.
 - ALL SLOPES AND EXPOSED AREAS SHALL BE SODDED OR PLANTED AS SOON AS FINAL GRADES HAVE BEEN ESTABLISHED. PLANTING SHALL NOT BE DELAYED UNTIL ALL GRADING WORK HAS BEEN COMPLETED. GRADING TO FINAL GRADE SHALL BE CONTINUOUS, AND ANY AREA WITHIN WHICH WORK HAS BEEN INTERRUPTED OR DELAYED SHALL BE PLANTED.
 - FILLS ON SLOPES STEEPER THAN 5:1 SHALL BE KEYED.
 - THE CITY SHALL BE INFORMED OF THE LOCATION OF THE BORROW/DISPOSAL SITE FOR THE PROJECT WHEN THE APPLICATION FOR A GRADING PERMIT IS MADE. THE BORROW/DISPOSAL SITE MUST ALSO FULFILL THE REQUIREMENTS OF THE GRADING ORDINANCE.
 - NO GRADING WORK SHALL BE DONE ON SATURDAYS, SUNDAYS AND HOLIDAYS AT ANY TIME WITHOUT PRIOR NOTICE TO THE DIRECTOR, D.P.P., PROVIDED SUCH GRADING WORK IS ALSO IN CONFORMANCE WITH THE COMMUNITY NOISE CONTROL STANDARDS CONTAINED IN THE HAWAII ADMINISTRATIVE RULES, TITLE 11, CHAPTER 46, "COMMUNITY NOISE CONTROL".

GRADING NOTES CONTINUED:

- 1


2

3

4

5
- THE LIMITS OF THE AREA TO BE GRADED SHALL BE FLAGGED BEFORE THE COMMENCEMENT OF THE GRADING WORK.
 - THE CONTRACTOR/DEVELOPER/OWNER OF THE PROJECT SHALL BE RESPONSIBLE FOR ALL GRADING OPERATIONS TO BE PERFORMED IN CONFORMANCE WITH APPLICABLE PROVISIONS OF THE HAWAII ADMINISTRATIVE RULES, TITLE 11, CHAPTER 54, "WATER QUALITY STANDARDS," AND TITLE 11, CHAPTER 55, "WATER POLLUTION CONTROL", AS WELL AS CHAPTER 14 OF THE REVISED ORDINANCES OF HONOLULU, AS AMENDED. BEST MANAGEMENT PRACTICES SHALL BE EMPLOYED AT ALL TIMES DURING CONSTRUCTION.

IF REQUIRED, THE CONTRACTOR SHALL OBTAIN NATIONAL POLLUTANT DISCHARGE ELIMINATION SYSTEM (NPDES) PERMIT COVERAGE(S) FOR THE FOLLOWING:
 - DISCHARGES OF HYDROTESTING EFFLUENT, DEWATERING EFFLUENT, AND WELL DRILLING EFFLUENT TO STATE WATERS.
 - IN ACCORDANCE WITH STATE LAW, ALL DISCHARGES RELATED TO PROJECT CONSTRUCTION OR OPERATIONS ARE REQUIRED TO COMPLY WITH STATE WATER QUALITY STANDARDS (HAWAII ADMINISTRATIVE RULES, CHAPTER 11-54). BEST MANAGEMENT PRACTICES SHALL BE USED TO MINIMIZE OR PREVENT THE DISCHARGE OF SEDIMENT, DEBRIS, AND OTHER POLLUTANTS TO STATE WATERS. PERMIT COVERAGE IS AVAILABLE FROM THE DEPARTMENT OF HEALTH, CLEAN WATER BRANCH AT HTTP://HEALTH.HAWAII.GOV/CWB. THE OWNER/DEVELOPER/CONTRACTOR IS RESPONSIBLE FOR OBTAINING OTHER FEDERAL, STATE, OR LOCAL AUTHORIZATIONS AS REQUIRED BY LAW.
 - WHERE APPLICABLE AND FEASIBLE THE MEASURES TO CONTROL EROSION AND OTHER POLLUTANTS SHALL BE IN PLACE BEFORE ANY EARTH MOVING PHASE OF THE GRADING IS INITIATED.
 - TEMPORARY EROSION CONTROLS SHALL NOT BE REMOVED BEFORE PERMANENT EROSION CONTROLS ARE IN-PLACE AND ESTABLISHED.
 - TEMPORARY EROSION CONTROL PROCEDURES SHALL BE SUBMITTED FOR APPROVAL PRIOR TO APPLICATION FOR GRADING PERMIT.
 - IF THE GRADING WORK INVOLVES CONTAMINATED SOIL, THEN ALL GRADING WORK SHALL BE DONE IN CONFORMANCE WITH APPLICABLE STATE AND FEDERAL REQUIREMENTS.
 - BUILDING PERMIT FOR RETAINING WALLS SHALL BE OBTAINED PRIOR TO COMMENCEMENT OF GRADING WORK ON SITE.
 - FOR NON-CITY PROJECTS, THE CONTRACTOR SHALL NOTIFY THE CIVIL ENGINEERING BRANCH, D.P.P. AT 768-8084 TO ARRANGE FOR INSPECTIONAL SERVICES AND SUBMIT TWO (2) SETS OF APPROVED CONSTRUCTION PLANS SEVEN (7) DAYS PRIOR TO COMMENCEMENT OF CONSTRUCTION WORK. FOR CITY PROJECTS, THE CONTRACTOR SHALL COORDINATE INSPECTIONAL SERVICES WITH THE RESPONSIBLE CITY AGENCY.
 - PURSUANT TO CHAPTER 6E, HRS, IN THE EVENT ANY ARTIFACTS OR HUMAN REMAINS ARE UNCOVERED DURING CONSTRUCTION OPERATIONS, THE CONTRACTOR SHALL IMMEDIATELY SUSPEND WORK AND NOTIFY THE HONOLULU POLICE DEPARTMENT, THE STATE DEPARTMENT OF LAND AND NATURAL RESOURCES-HISTORIC PRESERVATION DIVISION (692-8015). IN ADDITION, FOR NON-CITY PROJECTS, THE CONTRACTOR SHALL INFORM THE CIVIL ENGINEERING BRANCH, D.P.P. (768-8084); AND FOR CITY PROJECTS, NOTIFY THE RESPONSIBLE CITY AGENCY.
 - FOR ALL PROJECTS, WHICH WILL DISTURB ONE (1) ACRE OR MORE OF LAND, THE CONTRACTOR SHALL NOT START CONSTRUCTION UNTIL A NOTICE OF GENERAL PERMIT COVERAGE (NGPC) IS RECEIVED FROM THE DEPARTMENT OF HEALTH, STATE OF HAWAII, AND HAS SATISFIED ANY OTHER APPLICABLE REQUIREMENTS OF THE NPDES PERMIT PROGRAM. ALSO, FOR NON-CITY AND OTHER NON-GOVERNMENTAL AGENCY PROJECTS, THE CONTRACTOR SHALL PROVIDE A WRITTEN COPY OF THE NGPC TO THE PERMITTING AND INSPECTION SECTION, CIVIL ENGINEERING BRANCH, D.P.P., AT LEAST SEVEN (7) CALENDAR DAYS BEFORE THE START OF THE CONSTRUCTION. FOR CITY OR OTHER GOVERNMENTAL PROJECTS, THE CONTRACTOR SHOULD PROVIDE A WRITTEN COPY OF THE NGPC TO THE APPROPRIATE CITY DEPARTMENT OR GOVERNMENTAL AGENCY PER THEIR REQUIREMENTS.
 - ALL GRADING AND CONSTRUCTION WORK SHALL IMPLEMENT MEASURES TO ENSURE THAT THE DISCHARGE OF POLLUTANTS FROM THE CONSTRUCTION SITE WILL BE REDUCED TO THE MAXIMUM EXTENT PRACTICABLE AND WILL NOT CAUSE OR CONTRIBUTE TO AN EXCEEDANCE OF WATER QUALITY STANDARDS.
 - NON-COMPLIANCE TO ANY OF THE ABOVE REQUIREMENTS SHALL MEAN IMMEDIATE SUSPENSION OF ALL WORK, AND REMEDIAL WORK SHALL COMMENCE IMMEDIATELY. ALL COSTS INCURRED SHALL BE BILLED TO THE VIOLATOR. FURTHERMORE, VIOLATORS SHALL BE SUBJECTED TO ADMINISTRATIVE, CIVIL AND/OR CRIMINAL PENALTIES.

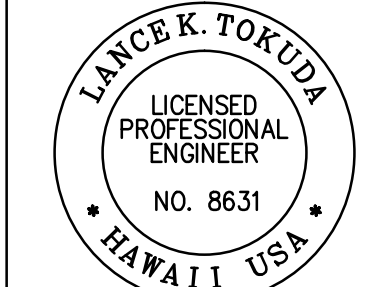

THIS WORK WAS PREPARED BY ME OR UNDER MY SUPERVISION
Lance K. Tokuda 4/30/2026
SIGNATURE EXPIRATION DATE

APPROX. NO. 1	DATE	SYN	DESCRIPTION
3/27/24			

SUBMITTAL PHASE
CONSTRUCTION DOCUMENTS
SUBMITTAL DATE 3/01/2024

DEPARTMENT OF DEFENSE	DIAMOND HEAD STATE MONUMENT	STATE OF HAWAII
TMK: 3-1-042:006	4204 DIAMOND HEAD RD HONOLULU, HI 96816	
BIRKHYMER EMERGENCY OPERATIONS CENTER (EOC) UPGRADES AND IMPROVEMENTS		CIVIL NOTES

SCALE:	AS NOTED
STATE JOB NO.	CA-202313-C
FEDERAL PROJECT NO.	-
SHEET	4 OF 123
C001	

1

2

3

4

5

SEWER NOTES:

1.

ALL SEWER CONSTRUCTION SHALL BE PERFORMED IN ACCORDANCE WITH THE CITY’S “STANDARD SPECIFICATIONS,” SEPT. 1986, THE DEPARTMENT OF ENVIRONMENTAL SERVICES “WASTEWATER SYSTEM DESIGN STANDARDS,” JULY 2017, AND “WASTEWATER SYSTEM STANDARD DETAILS,” JULY 2017, CURRENT CITY PRACTICES AND REVISED ORDINANCES OF HONOLULU, 1990 AS AMENDED.

2.

IN THE EVENT THAT ANY CHANGE IN ALIGNMENT OR GRADE FOR THE PROPOSED SEWERS ARE REQUIRED DUE TO UNFORESEEN CONFLICT WITH OTHER UTILITIES, THE ENGINEER IN CHARGE OR THE MAKER OF THE PLANS SHALL BE RESPONSIBLE FOR THE REQUIRED CHANGES WHICH ARE TO BE PRESENTED TO THE DEPARTMENT OF PLANNING AND PERMITTING (DPP) FOR APPROVAL.

3.

CRUSHED ROCK CRADLE IS PERMITTED WHERE SOIL IS STABLE. IN AREAS OF UNSTABLE SOIL, THE MAKER OF THE PLANS AND THE CONSTRUCTION ENGINEER WILL DETERMINE THE PIPE SUPPORT REQUIRED.

4.

THE UNDERGROUND PIPES, CABLES OR DUCTLINES KNOWN TO EXIST BY THE ENGINEER FROM HIS RESEARCH OF RECORDS ARE INDICATED ON THE PLANS. THE CONTRACTOR SHALL VERIFY THE LOCATION AND DEPTH OF THE FACILITIES, INCLUDING AND AFFECTING SEWER LINES, IN THE PRESENCE OF THE WASTEWATER INSPECTOR AND EXERCISE PROPER CARE IN EXCAVATING THE AREA. THE CONTRACTOR SHALL BE RESPONSIBLE AND SHALL PAY FOR ALL DAMAGED UTILITIES.

5.

SEWER LATERALS SHALL BE CLEAR OF AND NOT CONFLICTING WITH ANY OTHER UTILITY. MINIMUM HORIZONTAL AND VERTICAL CLEARANCE SHALL BE STRICTLY OBSERVED AND FOLLOWED.

6.

SLOPE FOR SEWER LATERALS SHALL BE A MINIMUM OF 2.00% UNLESS OTHERWISE NOTED.

7.

BUILDING PLUMBING FACILITIES SHALL BE CONTROLLED BY SEWER LATERAL INVERTS.

8.

THE CONTRACTOR SHALL BE RESPONSIBLE FOR MAINTAINING CONTINUOUS SEWER SERVICE TO ALL AFFECTED AREAS DURING CONSTRUCTION. MAXIMUM SHUTDOWN DURATION IS 6 HOURS WITH APPROVAL BY GOVERNMENT CONSTRUCTION MANAGER. PROVIDE ONE-WEEK ADVANCE NOTICE TO TENANT OPERATIONS MANAGER.

9.

THE CONTRACTOR SHALL BE RESPONSIBLE FOR ANY SEWAGE SPILLS CAUSED DURING CONSTRUCTION. THE CONTRACTOR SHALL NOTIFY THE STATE DEPARTMENT OF HEALTH AND UTILIZE APPROPRIATE SAMPLING AND ANALYZING PROCEDURES. THE CONTRACTOR SHALL BE RESPONSIBLE FOR ALL PUBLIC NOTIFICATIONS AND PRESS RELEASES.

10.

THE CONTRACTOR SHALL INSTALL “RAINSTOPPER” MANHOLE INSERTS IN ALL SEWER MANHOLES WITH TYPE “SA” FRAME AND COVER.

11.

CONFINED SPACE

FOR ENTRY BY INSPECTORS, INTO A PERMIT REQUIRED CONFINED SPACE AS DEFINED IN 29 CFR PART 1910.146(B), THE CONTRACTOR SHALL BE RESPONSIBLE FOR PROVIDING:

1.1.

ALL SAFETY EQUIPMENT REQUIRED BY THE CONFINED SPACE REGULATIONS APPLICABLE TO ALL PARTIES OTHER THAN THE CONSTRUCTION INDUSTRY, TO INCLUDE, BUT NOT LIMITED TO, THE FOLLOWING:

A.

FULL BODY HARNESSES FOR UP TO TWO PERSONNEL.

B.

LIFELINE AND ASSOCIATED CLIPS.

C.

INGRESS/EGRESS AND FALL PROTECTION EQUIPMENT.

D.

TWO-WAY RADIOS (WALKIE-TALKIES) IF OUT OF LINE-OF-SIGHT.

E.

EMERGENCY (ESCAPE) RESPIRATOR (10 MINUTE DURATION).

F.

CELLULAR TELEPHONE TO CALL FOR EMERGENCY ASSISTANCE.

G.

CONTINUOUS GAS DETECTOR (CALIBRATED) TO MEASURE OXYGEN, HYDROGEN SULFIDE, CARBON.

H.

PERSONAL MULTI-GAS DETECTOR TO BE CARRIED BY INSPECTOR.

1.2.

CONTINUOUS FORCED AIR VENTILATION ADEQUATE TO PROVIDE SAFE ENTRY CONDITIONS.

1.3.

ONE ATTENDANT/RESCUE PERSONNEL TOPSIDE (TWO, IF CONDITIONS WARRANT IT).

12.

WHEN CONNECTING TO A LIVE SEWER LINE, THE CONTRACTOR SHALL ABIDE BY ALL CONDITIONS THAT THE STATE DEPARTMENT OF HEALTH SETS FORTH TO MITIGATE ANY WASTEWATER SPILL THAT MAY OCCUR. THE CONTRACTOR SHALL INFORM THE CITY INSPECTOR FIVE (5) WORKING DAYS PRIOR TO THE ACTUAL CONNECTION. THE CONTRACTOR SHALL BE RESPONSIBLE FOR ANY FINES AND PENALTIES DUE TO ANY SPILLS RESULTING FROM THE CONNECTION.

13.

FOR SEWER MANHOLE ADJUSTMENTS UPWARD LESS THAN 3”, SEE STD. DETAIL S-28. FOR SMH ADJUSTMENTS UPWARD GREATER THAN 3” OR FOR ANY ADJUSTMENTS DOWNWARD, RECONSTRUCT SMH TOP FROM BELOW THE CONE SECTION.

14.

THE CONTRACTOR SHALL MAINTAIN VISIBILITY AND MAINTENANCE ACCESS TO LIVE SEWER MANHOLE LOCATIONS AT ALL TIMES, INCLUDING DURING NON-WORK HOURS AND PAVING OPERATIONS.

15.

THE CONTRACTOR SHALL USE A MANHOLE DEBRIS CATCHING DEVICE WHEN PERFORMING MANHOLE HEIGHT ADJUSTMENT WORK AND REMOVE ANY CONSTRUCTION DEBRIS THAT HAS FALLEN INTO THE MANHOLE. DISPOSAL OF CONSTRUCTION DEBRIS IN THE SEWER SYSTEM IS STRICTLY PROHIBITED.

16.

FOR PRECAST SEWER MANHOLES, THE CONSULTING ENGINEER SHALL SUBMIT FOUR (4) SETS OF SHOP DRAWINGS TO THE ENGINEER FOR APPROVAL.

WATER NOTES:

1.

UNLESS OTHERWISE SPECIFIED, ALL MATERIALS AND CONSTRUCTION OF WATER SYSTEM FACILITIES AND APPURTENANCES SHALL BE IN ACCORDANCE WITH THE CITY AND COUNTY OF HONOLULU, BOARD OF WATER SUPPLY’S “WATER SYSTEM STANDARDS”, VOLUME 1 DATED 1985, AND THE “APPROVED MATERIAL LIST AND STANDARD DETAILS FOR WATER SYSTEM CONSTRUCTION”, VOLUME 2, DATED 1985, AND THE “WATER SYSTEM EXTERNAL CORROSION CONTROL STANDARDS”, VOLUME 3, DATED 1991, AND ALL SUBSEQUENT AMENDMENTS AND ADDITIONS.

2.

THE CONTRACTOR SHALL NOTIFY THE ENGINEER IN WRITING ONE WEEK PRIOR TO COMMENCING WORK ON THE WATER SYSTEM.

3.

PAYMENT FOR ITEMS OF WORK CALLED FOR IN THE PLANS, SPECIAL PROVISIONS AND SPECIFICATIONS FOR WHICH PAYMENT IS NOT SPECIFIED SHALL NOT BE MADE DIRECTLY BUT SHALL BE CONSIDERED INCIDENTAL TO THE VARIOUS ITEMS OF THE PROPOSAL AND NO ADDITIONAL COMPENSATION SHALL BE MADE.

4.

THE CONTRACTOR IS ALERTED TO THE ENCOUNTERING OF OBSTACLES WHETHER SHOWN ON THE PLANS OR NOT, OR WHICH MAY DIFFER IN LOCATION FROM THAT SHOWN ON THE PLANS WHICH MAY INTERFERE WITH HIS/HER NORMAL METHOD OF OPERATIONS. THE CONTRACTOR SHALL TAKE INTO ACCOUNT ANY ADDITIONAL COSTS ANTICIPATED DUE TO THESE CONDITIONS AND SHALL HAVE THESE COSTS INCLUDED IN THE BID ITEMS WHICH HE/SHE FEELS MOST APPROPRIATE. NO SEPARATE ADDITIONAL COMPENSATION SHALL BE MADE.

5.

THE CONTRACTOR SHALL BE SOLELY RESPONSIBLE FOR ALL ASSUMPTIONS, DEDUCTIONS, OR CONCLUSIONS HE/SHE MAY MAKE OR DERIVE FROM THE SUBSURFACE INFORMATION OR DATA FURNISHED ON THE PLANS. THE CONTRACTOR MUST SATISFY HIMSELF/HERSELF THROUGH HIS/HER OWN INVESTIGATIONS AS TO WHAT SUBSURFACE CONDITIONS ARE TO BE ENCOUNTERED.

6.

PRIOR TO THE START OF EXCAVATION, THE CONTRACTOR SHALL NOTIFY ALL AGENCIES AND UTILITIES AND HAVE THEM LOCATE THEIR RESPECTIVE LINES AFFECTED. THE CONTRACTOR SHALL BE HELD RESPONSIBLE FOR ALL OF HIS/HER CONSTRUCTION AND SHALL PAY FOR ALL DAMAGES TO AND FOR THE PROTECTION OF EXISTING UTILITIES AND STRUCTURES.

7.

THE CONTRACTOR SHALL EXPOSE, VERIFY AND BACKFILL ALL EXISTING UNDERGROUND UTILITIES AND STRUCTURES AT CROSSINGS PRIOR TO EXCAVATION OF PIPELINE TRENCH. THE WATER MAIN ALIGNMENT AND GRADE MAY BE CHANGED IF THERE ARE ANY CONFLICTS WITH ANY EXISTING UNDERGROUND UTILITIES AND STRUCTURES, WHETHER SHOWN ON THE PLANS OR NOT. PAYMENT FOR WORK INCLUDED IN THIS PARAGRAPH SHALL BE CONSIDERED INCIDENTAL TO THE APPROPRIATE BID ITEMS OF THE PROPOSAL, AND NO ADDITIONAL COMPENSATION SHALL BE MADE.

8.

EXISTING UTILITIES CROSSING THE WATER MAIN ARE TO REMAIN IN SERVICE AND IN PLACE. IF RELOCATED FOR THE CONTRACTOR’S CONVENIENCE, INTERRUPTION OF SERVICE SHALL BE FOR A MINIMUM PERIOD OF TIME AND SHALL BE DONE AT THE CONTRACTOR’S EXPENSE AND ONLY WITH THE APPROVAL OF THE ENGINEER.

9.

IF THE CONTRACTOR ELECTS NOT TO EXPOSE AND VERIFY ALL EXISTING UNDERGROUND UTILITIES AND STRUCTURES AT CROSSINGS PRIOR TO PIPELINE EXCAVATION, HE/SHE FORFEITS HIS/HER RIGHTS FOR ANY CLAIMS FOR COMPENSATION CAUSED BY ANY CONFLICTS WITH EXISTING UTILITIES AND STRUCTURES.

10.

ALL A.C. AND CONCRETE PAVEMENT TO BE TRENCHED (FOR PIPELINE OR ANY WATER SYSTEM INSTALLATION) SHALL BE “SAW-CUT” TO THE REQUIRED WIDTH PRIOR TO REPAVING.

11.

RESTORATION OF PAVEMENT SHALL BE DONE IN ACCORDANCE WITH THE DETAILS SHOWN ON THE PLANS AND DONE WITH EQUIVALENT TO OR BETTER QUALITY MATERIALS.

12.

UNLESS OTHERWISE SPECIFIED, CONNECTIONS TO EXISTING WATER MAINS AND CHLORINATION OF NEW WATER MAINS SHALL BE DONE BY THE CONTRACTOR.

13.

WHENEVER CONNECTIONS TO EXISTING WATER MAINS ARE SHOWN ON THE PLANS, THE CONTRACTOR SHALL EXPOSE THE EXISTING WATER MAINS PRIOR TO EXCAVATION OF MAIN TRENCH. THE REMAINING EXCAVATION FOR THE CONNECTION SHALL BE EXCAVATED WHEN THE CONTRACTOR IS READY TO MAKE THE CONNECTION.

14.

THE BRIDGE DECKS FOR TEMPORARY BRIDGE INSTALLATIONS SHALL BE FLUSH WITH ADJOINING PAVEMENT OR SIDEWALK. NO BUMPS OR ELEVATED BRIDGE DECKS WILL BE ALLOWED.

15.

ALL WATER MAIN TRENCHES SHALL BE BACKFILLED AS CALLED FOR UNDER PART III, SECTION 1.2.2, TRENCH BACKFILL, OF THE “WATER SYSTEM STANDARDS”, DATED 1985. COMPACTION OF TRENCH BACKFILL SHALL MEET APPLICABLE REQUIREMENTS OF “THE STANDARD SPECIFICATIONS FOR PUBLIC WORKS CONSTRUCTION”, SEPTEMBER 1986, OF THE COUNTIES OF THE STATE OF HAWAII.

16.

THE CONTRACTOR SHALL BE RESPONSIBLE FOR THE PROPER DISPOSAL OF ALL EFFLUENT ASSOCIATED WITH THE CONSTRUCTION ACTIVITY AND THE DISINFECTION AND HYDROTESTING OPERATIONS TO SAFEGUARD PUBLIC HEALTH AND SAFETY IN ACCORDANCE WITH APPLICABLE DEPARTMENT OF HEALTH REQUIREMENTS. ALL PERMITS AND LICENSES FOR CONSTRUCTION WATER DISPOSAL, INCLUDING ALL APPLICATIONS, CHARGES, FEES, AND TAXES, ARE THE RESPONSIBILITY OF THE CONTRACTOR.

17.

SHOULD MAJOR TREE ROOTS 2” AND GREATER BE ENCOUNTERED DURING CONSTRUCTION THESE ROOTS SHALL BE CUT AND SEALED WITH ASPHALTIC PAINT.

18.

DURING NON-WORKING HOURS, THE TRENCHES SHALL BE COVERED WITH NON-SKID STEEL PLATES AND ALL LANES MAINTAINED OPEN FOR TRAFFIC.

WATER NOTES CONTINUED:

19.

UNLESS OTHERWISE SPECIFIED, ALL ABANDONED LINES SHALL BE CUT AND PLUGGED WITH CLASS DWS 2000 CONCRETE. PAYMENT FOR CUTTING AND PLUGGING WILL NOT BE MADE DIRECTLY BUT WILL BE CONSIDERED INCIDENTAL TO THE VARIOUS ITEMS OF THE PROPOSAL. THE CONTRACTOR SHALL VERIFY THE SIZE AND TYPE OF LINE TO BE PLUGGED.

20.

ALL WATER MAINS AND APPURTENANCES INCLUDING SERVICE LATERALS AND SERVICE CONNECTIONS SHALL BE SUBJECTED TO A HYDROSTATIC TEST PRESSURE OF 150 PSI BY THE CONTRACTOR IN THE PRESENCE OF THE ENGINEER.

21.

ALL LATERALS (1 INCH TO 2-1/2 INCHES) SHALL BE REPLACED OR RECONNECTED WITH COPPER OR PLASTIC TUBING.

22.

THE CONTRACTOR SHALL FURNISH AND INSTALL DIELECTRIC COUPLINGS FOR ALL SERVICE LATERAL CONNECTIONS. PAYMENT FOR DIELECTRIC COUPLINGS SHALL NOT BE MADE DIRECTLY, BUT SHALL BE CONSIDERED INCIDENTAL TO THE VARIOUS ITEMS OF THE PROPOSAL.

23.

PAYMENT FOR SERVICE LATERALS AND SERVICE CONNECTIONS SHALL BE MADE AT THE UNIT PRICE BID IN THE PROPOSAL. PAYMENT SHALL INCLUDE TAPS INTO MAINS, RECONNECTIONS TO EXISTING SERVICES, TRANSFERAL OF METERS, AND INSTALLING PIPE LATERALS, FITTINGS, BALL CORPS, BALL STOPS, GLOBE VALVES, METER SPLICES, BRASS PIPES, CAPS AND ALL APPURTENANCES, AS REQUIRED, IN PLACE COMPLETE. PAYMENT FOR METER BOXES, INCLUSIVE OF C.I. FRAMES AND COVERS AND TYPE “A” VALVE BOXES SHALL BE MADE AT THE RESPECTIVE UNIT PRICE BID IN THE BID.

24.

DEMOLISH AND BACKFILL ALL ABANDONED MANHOLES, VALVE BOXES AND METER BOXES. SALVAGE ALL CAST IRON FRAMES AND COVERS.

25.

AFTER INSTALLATION OF TAPPING SLEEVE AND TAPPING VALVE AND PRIOR TO TAPPING THE EXISTING WATER MAIN, THE ASSEMBLY SHALL BE PRESSURE TESTED AT 150 PSI ON BOTH SIDES OF THE VALVE AND IN ACCORDANCE WITH THE WATER SYSTEM STANDARDS DATED 1985.

26.

MECHANICAL JOINT GLANDS SHALL BE “STRAIGHT-SIDED” AND POLYGON IN SHAPE AS DESCRIBED IN AWWA C111 AND SHALL BE APPLICABLE TO BOTH CAST IRON AND DUCTILE IRON GLANDS OR AN APPROVED EQUAL ON A JOB TO JOB BASIS.

27.

ALL AIR RELIEF VALVES SHALL HAVE A MINIMUM WORKING PRESSURE RANGE OF 0 TO 150 PSI.

28.

PIPE CUSHION SHALL BE OF HIGH RESISTIVITY MATERIAL. THE CONTRACTOR SHALL SUBMIT A SOIL CERTIFICATION THAT HIGH RESISTANT CUSHION MATERIAL HAS A RESISTIVITY GREATER THAN 5,000 OHM-CM. REMAINDER OF BACKFILL MATERIAL SHALL BE AS SPECIFIED IN CITY AND COUNTY OF HONOLULU, BOARD OF WATER SUPPLY’S “WATER SYSTEM STANDARDS”, VOLUME 1, DATED 1985. PIPE CUSHION AND BACKFILL MATERIAL SHALL CONTAIN NO HAZARDOUS SUBSTANCES ABOVE REGULATORY ACTION LEVELS INCLUDING BUT NOT LIMITED TO LEAD, ASBESTOS, MERCURY, CHROMIUM, CADMIUM, ZINC, STRONTIUM, AND POLYCHLORINATED BIPHENYLS (PCB).

29.

BALL CORPS AND BALL STOPS SHALL BE INSTALLED IN LIEU OF THE CORPORATION STOPS AND STOPCOCKS, RESPECTIVELY.

30.

TRAFFIC CONTROL PLAN: AFTER THE AWARD OF THE CONSTRUCTION CONTRACT, THE CONTRACTOR SHALL SUBMIT A TRAFFIC CONTROL PLAN TO THE ENGINEER FOR REVIEW AND OBTAIN APPROVAL BEFORE COMMENCING CONSTRUCTION PAYMENT FOR THE PREPARATION AND IMPLEMENTATION OF THE APPROVED TRAFFIC CONTROL PLAN SHALL NOT BE MADE DIRECTLY BUT SHALL BE CONSIDERED INCIDENTAL TO THE VARIOUS ITEMS OF THE BID.

31.

THE CONTRACTOR SHALL COORDINATE THE SECURING OF THE EXISTING WATER SYSTEM WITH THE ENGINEER PRIOR TO EXCAVATING BEHIND OR REMOVING ANY EXISTING THRUST BLOCKS, STRUCTURAL STRUTS OR REACTION BEAMS, OR ANY FITTINGS SUCH AS TEES, PLUGS, CAPS, BENDS, OFFSETS, AND VALVES, OR ANY OTHER PIPELINE APPURTENANCE. THE CONTRACTOR SHALL BE RESPONSIBLE FOR ALL ASSOCIATED DAMAGES RESULTING FROM FAILURE TO ADEQUATELY SECURE THE EXISTING SYSTEM.

STATE OF HAWAII

DIAMOND HEAD STATE MONUMENT

4204 DIAMOND HEAD RD HONOLULU, HI 96816

TMK: 3-1-042:006

BIRKHYMER EMERGENCY OPERATIONS CENTER (EOC) UPGRADES AND IMPROVEMENTS

CIVIL NOTES

DEPARTMENT OF DEFENSE

THIS WORK WAS PREPARED BY ME OR UNDER MY SUPERVISION

LANCE K. TOKUDA

LICENSED PROFESSIONAL ENGINEER

NO. 8631

HAWAII USA

4/30/2026

4/30/2026

SUBMITTAL PHASE

CONSTRUCTION DOCUMENTS

SUBMITTAL DATE

3/01/2024

SCALE:

AS NOTED

STATE JOB NO.

CA-202313-C

FEDERAL PROJECT NO.

-

SHEET

5

OF

123



C002

APRIL

DATE

DESCRIPTION

SYN

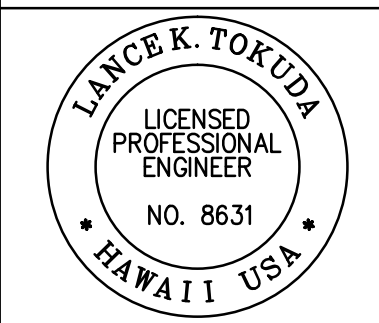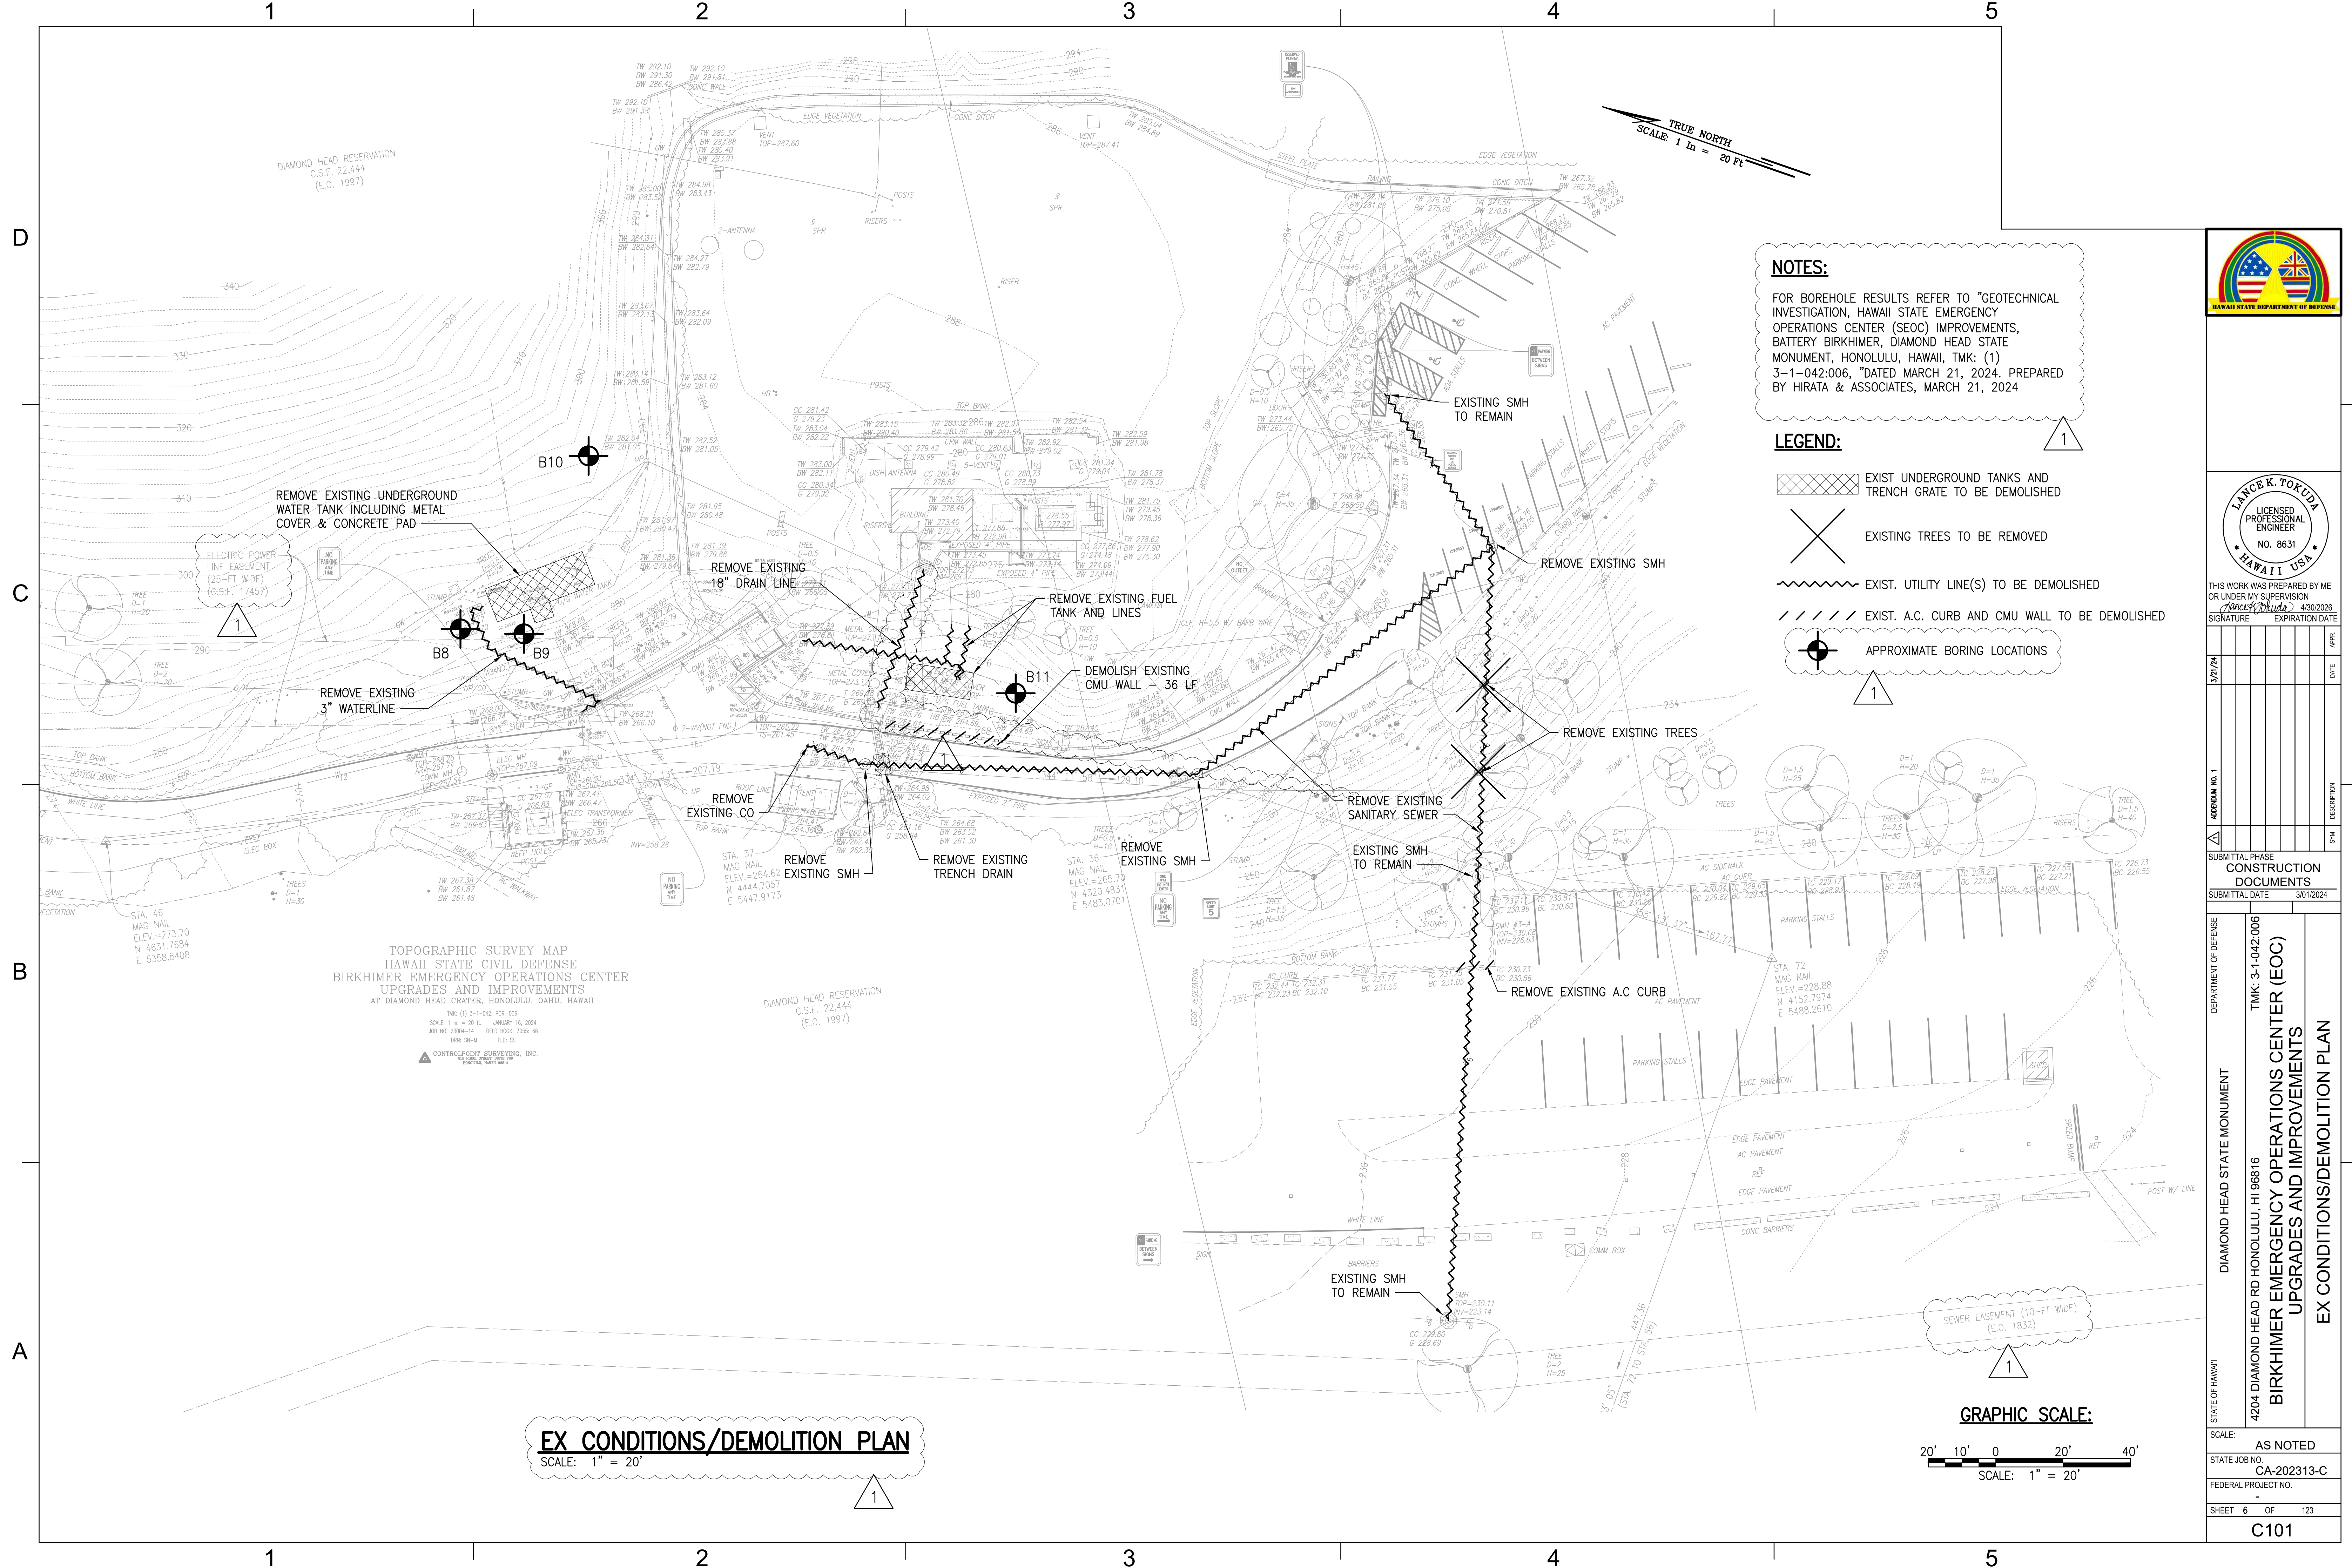

THIS WORK WAS PREPARED BY ME OR UNDER MY SUPERVISION
Signature: *Lance K. Tokuda* 4/30/2026
SIGNATURE EXPIRATION DATE

APPORUM NO. 1	DATE	APPR.	DESCRIPTION	SYN
3/2/24				

SUBMITTAL PHASE
CONSTRUCTION DOCUMENTS
SUBMITTAL DATE 3/01/2024

DEPARTMENT OF DEFENSE
DIAMOND HEAD STATE MONUMENT
STATE OF HAWAII
4204 DIAMOND HEAD RD HONOLULU, HI 96816
BIRKHIMER EMERGENCY OPERATIONS CENTER (EOC) UPGRADES AND IMPROVEMENTS
EX CONDITIONS/DEMOLITION PLAN
TMK: 3-1-042:006

SCALE: AS NOTED
STATE JOB NO. CA-202313-C
FEDERAL PROJECT NO. -
SHEET 6 OF 123
C101



LANCE K. TOKUDA
LICENSED PROFESSIONAL ENGINEER
NO. 8631
HAWAII, USA

THIS WORK WAS PREPARED BY ME OR UNDER MY SUPERVISION
Lance K. Tokuda 4/30/2026
SIGNATURE EXPIRATION DATE

APP. NO. 1	DATE	SYN	DESCRIPTION
3/2/24			

SUBMITTAL PHASE
CONSTRUCTION DOCUMENTS
SUBMITTAL DATE 3/01/2024

STATE OF HAWAII
DIAMOND HEAD STATE MONUMENT
4204 DIAMOND HEAD RD HONOLULU, HI 96816
BIRKHIRMER EMERGENCY OPERATIONS CENTER (EOC) UPGRADES AND IMPROVEMENTS
EROSION CONTROL PLAN
TMK: 3-1-042:006
SCALE: AS NOTED
STATE JOB NO. CA-202313-C
FEDERAL PROJECT NO. -
SHEET 7 OF 123
C102

1

2

3

4


5

D


C

B


A

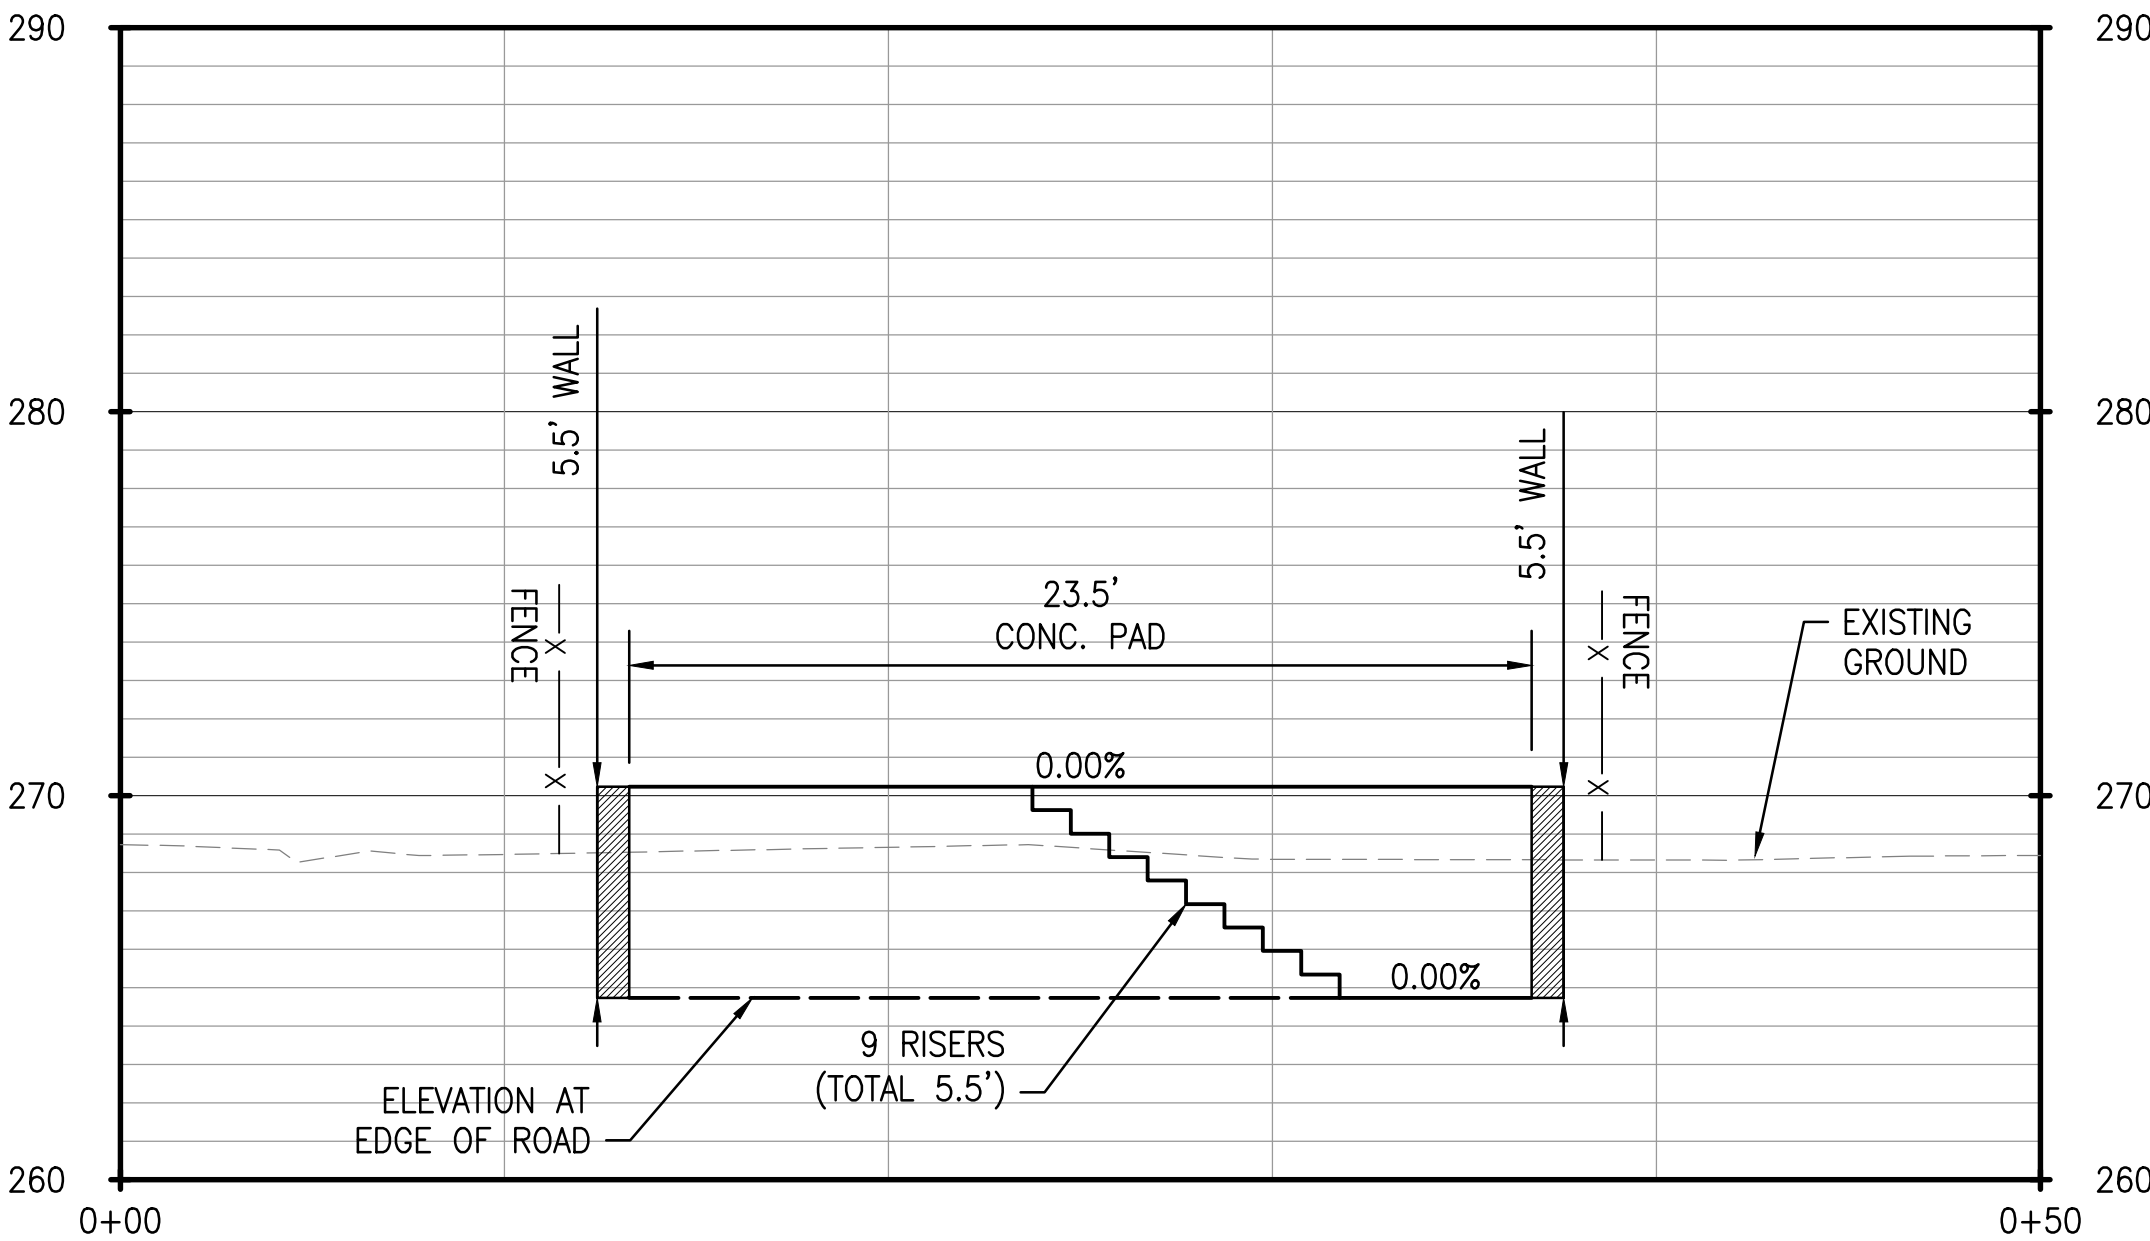


C1 GRADING SECTION
SCALE: HORIZ. 1" = 5' / VERT. 1" = 5'

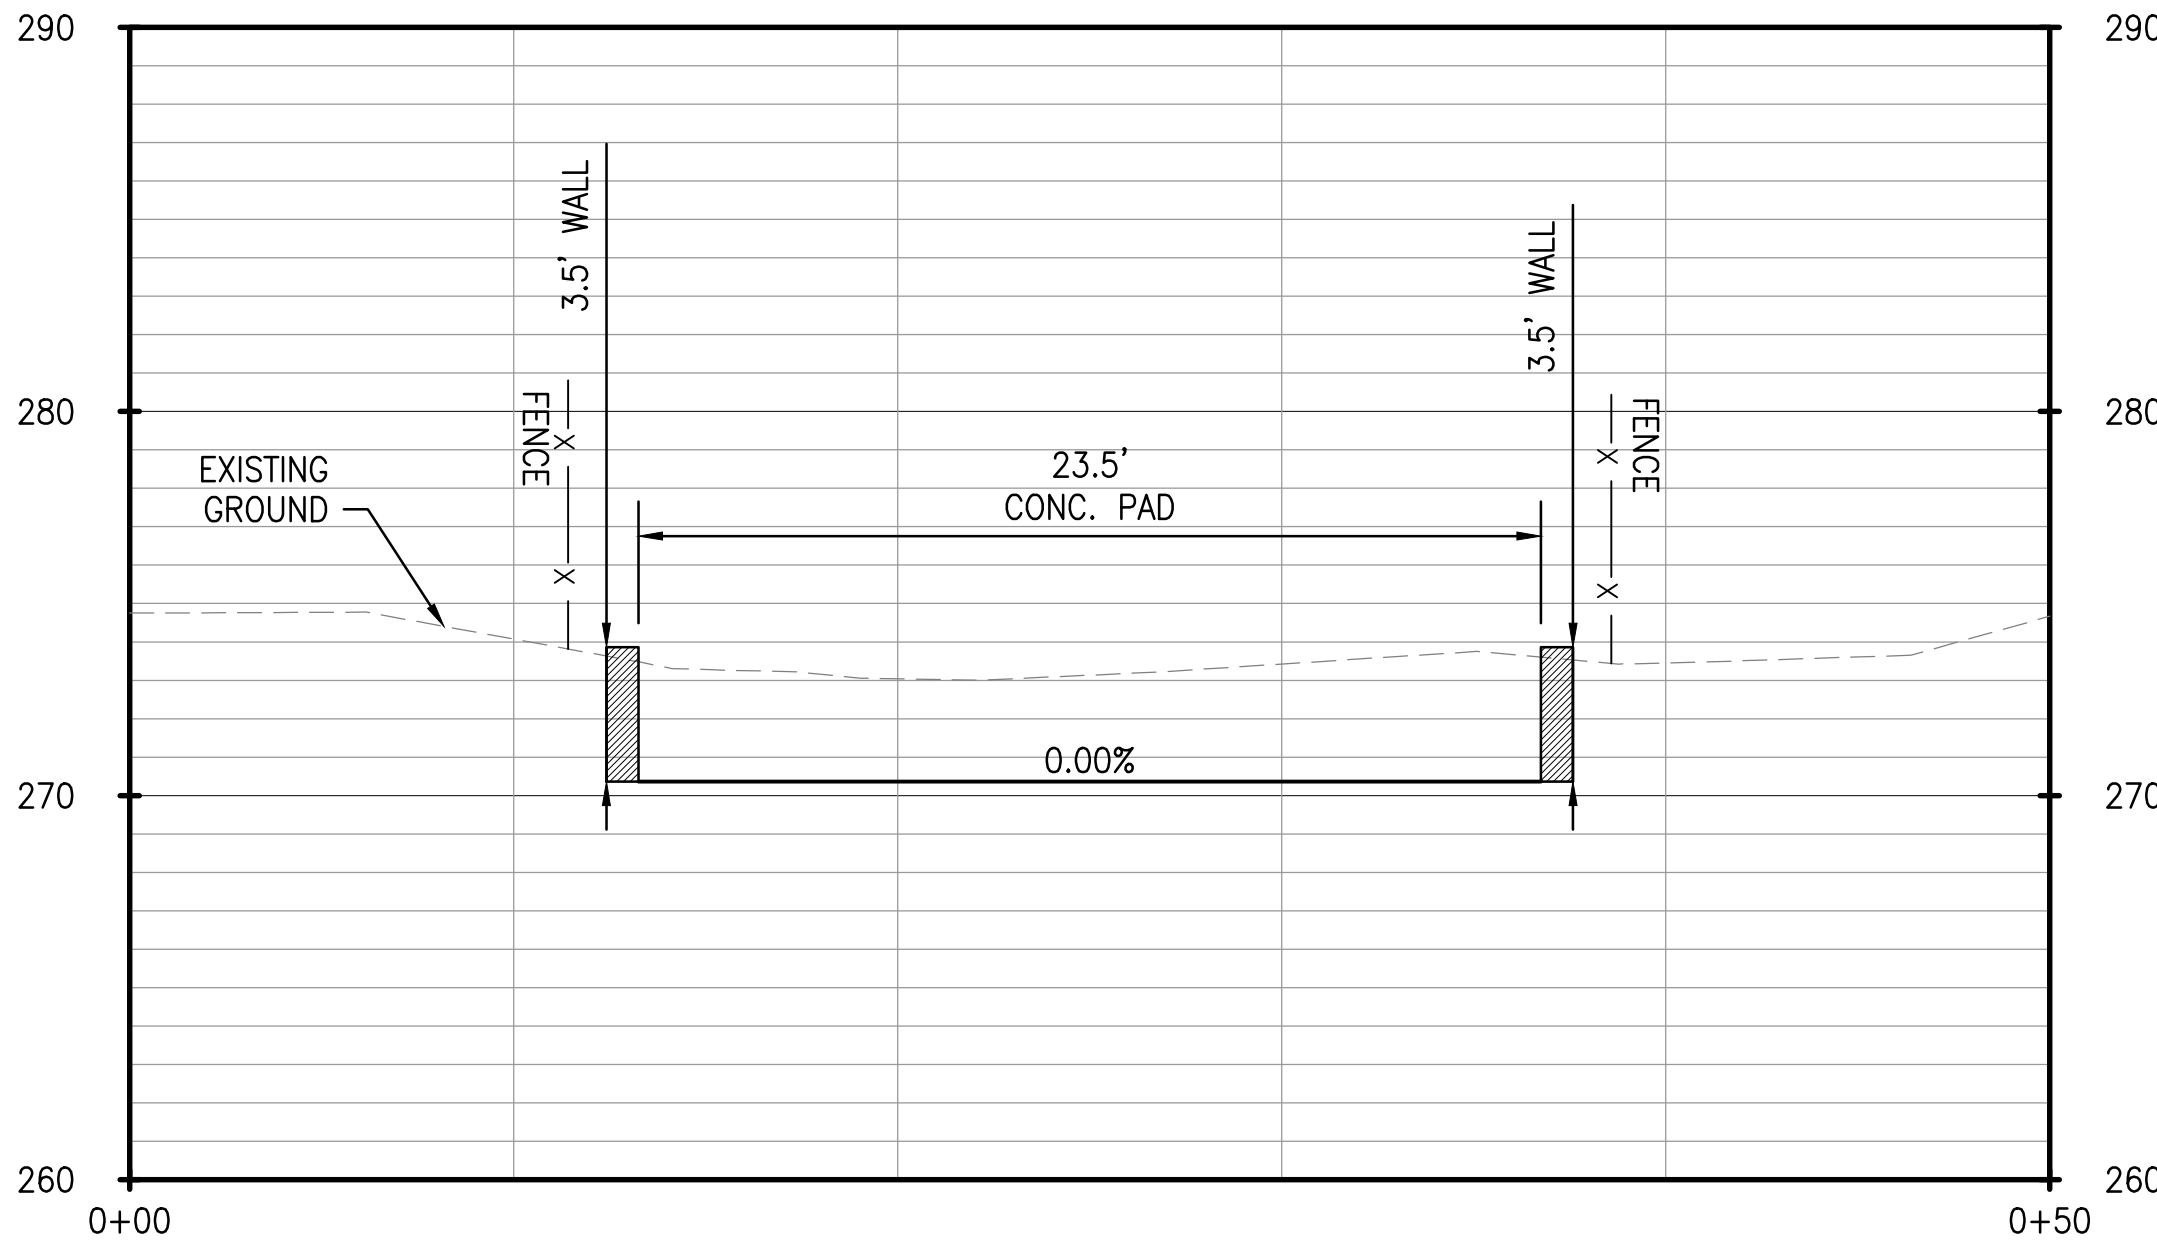

C2 GRADING SECTION
SCALE: HORIZ. 1" = 5' / VERT. 1" = 5'

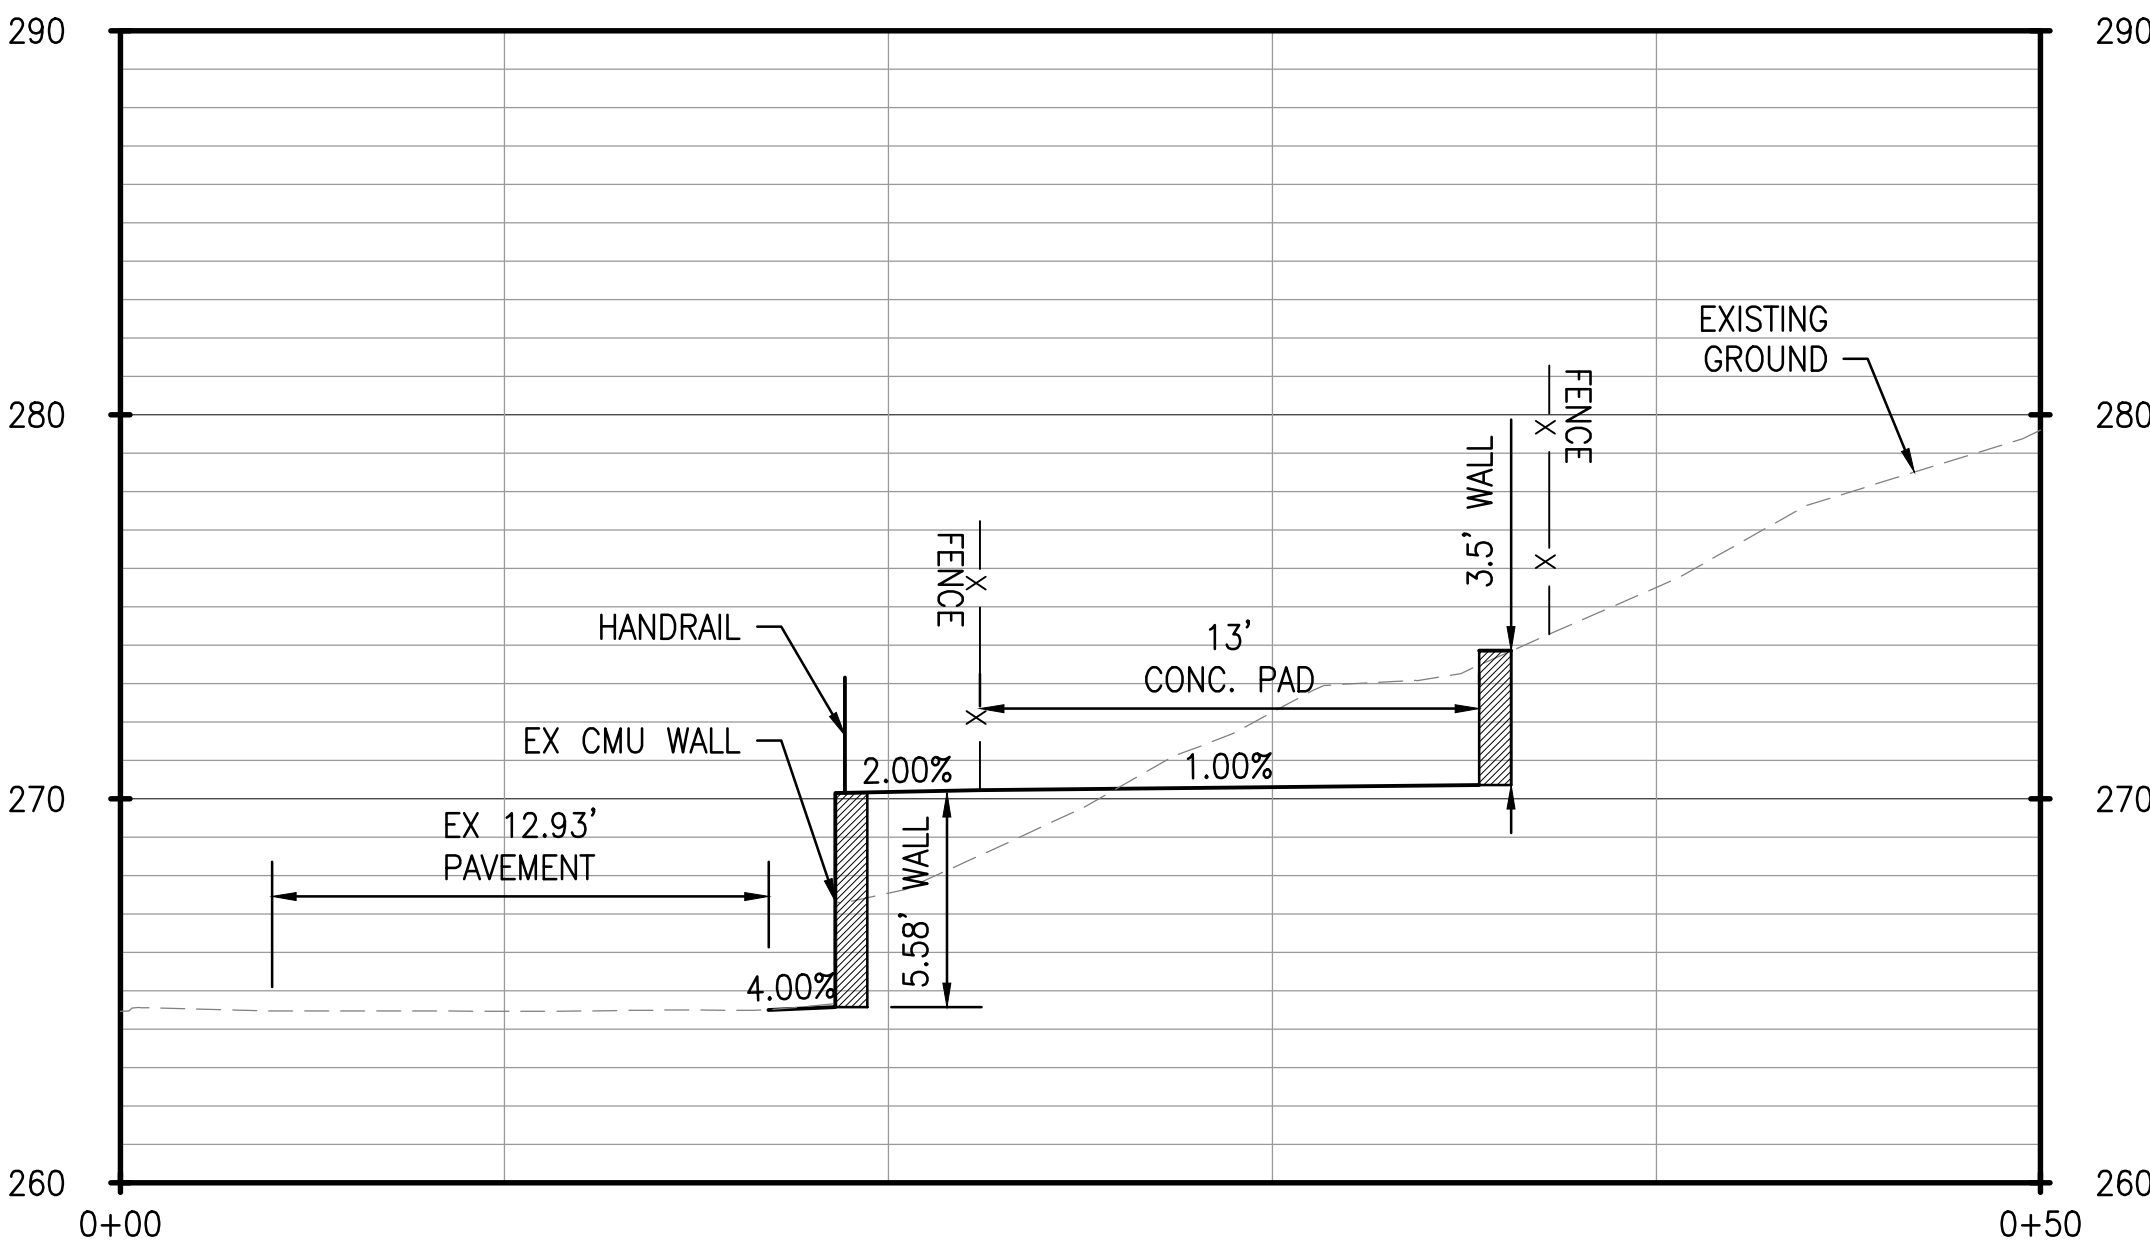

A1 GRADING SECTION
SCALE: HORIZ. 1" = 5' / VERT. 1" = 5'


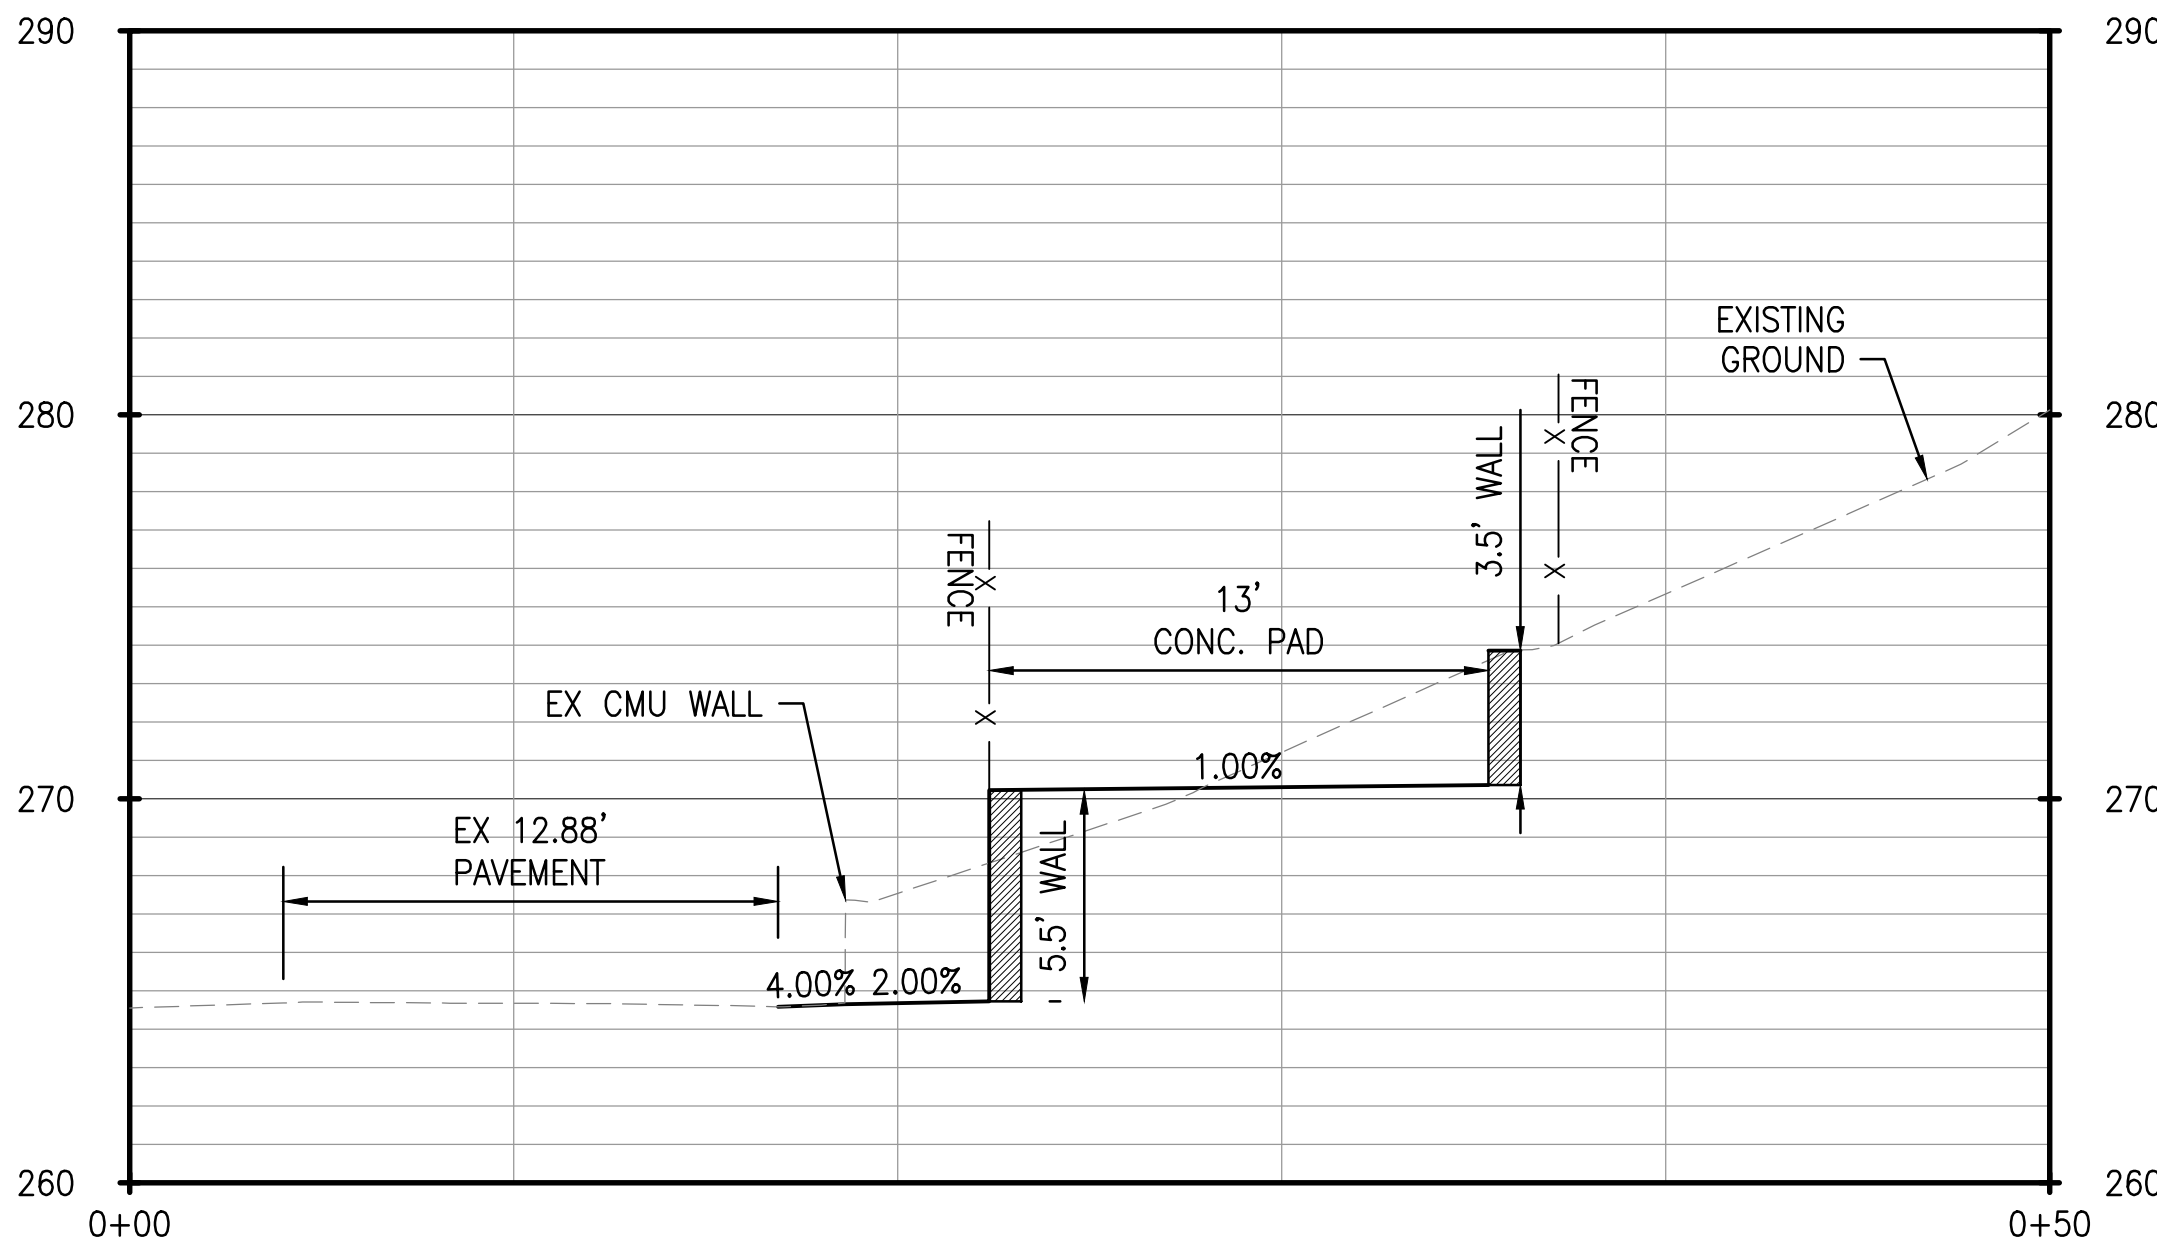


A2 GRADING SECTION
SCALE: HORIZ. 1" = 5' / VERT. 1" = 5'

NOTES:

1. SEE SHEET CG101 FOR SECTION LOCATIONS.

GRAPHIC SCALE:

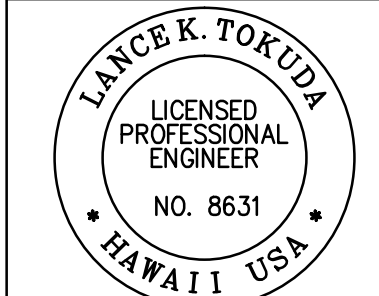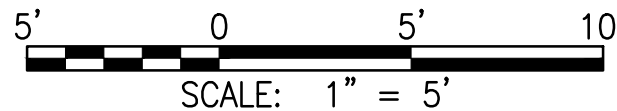



THIS WORK WAS PREPARED BY ME
OR UNDER MY SUPERVISION
Lance K. Tokuda 4/30/2026
SIGNATURE EXPIRATION DATE


APPROVAL NO. 1	DATE	DESCRIPTION	SYN
3/21/24			

SUBMITTAL PHASE
CONSTRUCTION DOCUMENTS
SUBMITTAL DATE 3/01/2024

STATE OF HAWAII	DIAMOND HEAD STATE MONUMENT	TMK: 3-1-042:006	4204 DIAMOND HEAD RD HONOLULU, HI 96816
BIRKIMER EMERGENCY OPERATIONS CENTER (EOC)		UPGRADES AND IMPROVEMENTS	
GRADING SECTIONS - AST PLATFORM			

SCALE:	AS NOTED
STATE JOB NO.	CA-202313-C
FEDERAL PROJECT NO.	-
SHEET 12 OF 123	
CG301	

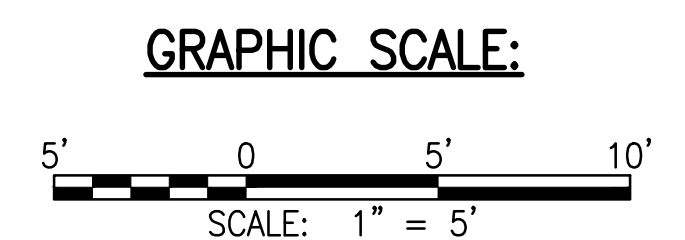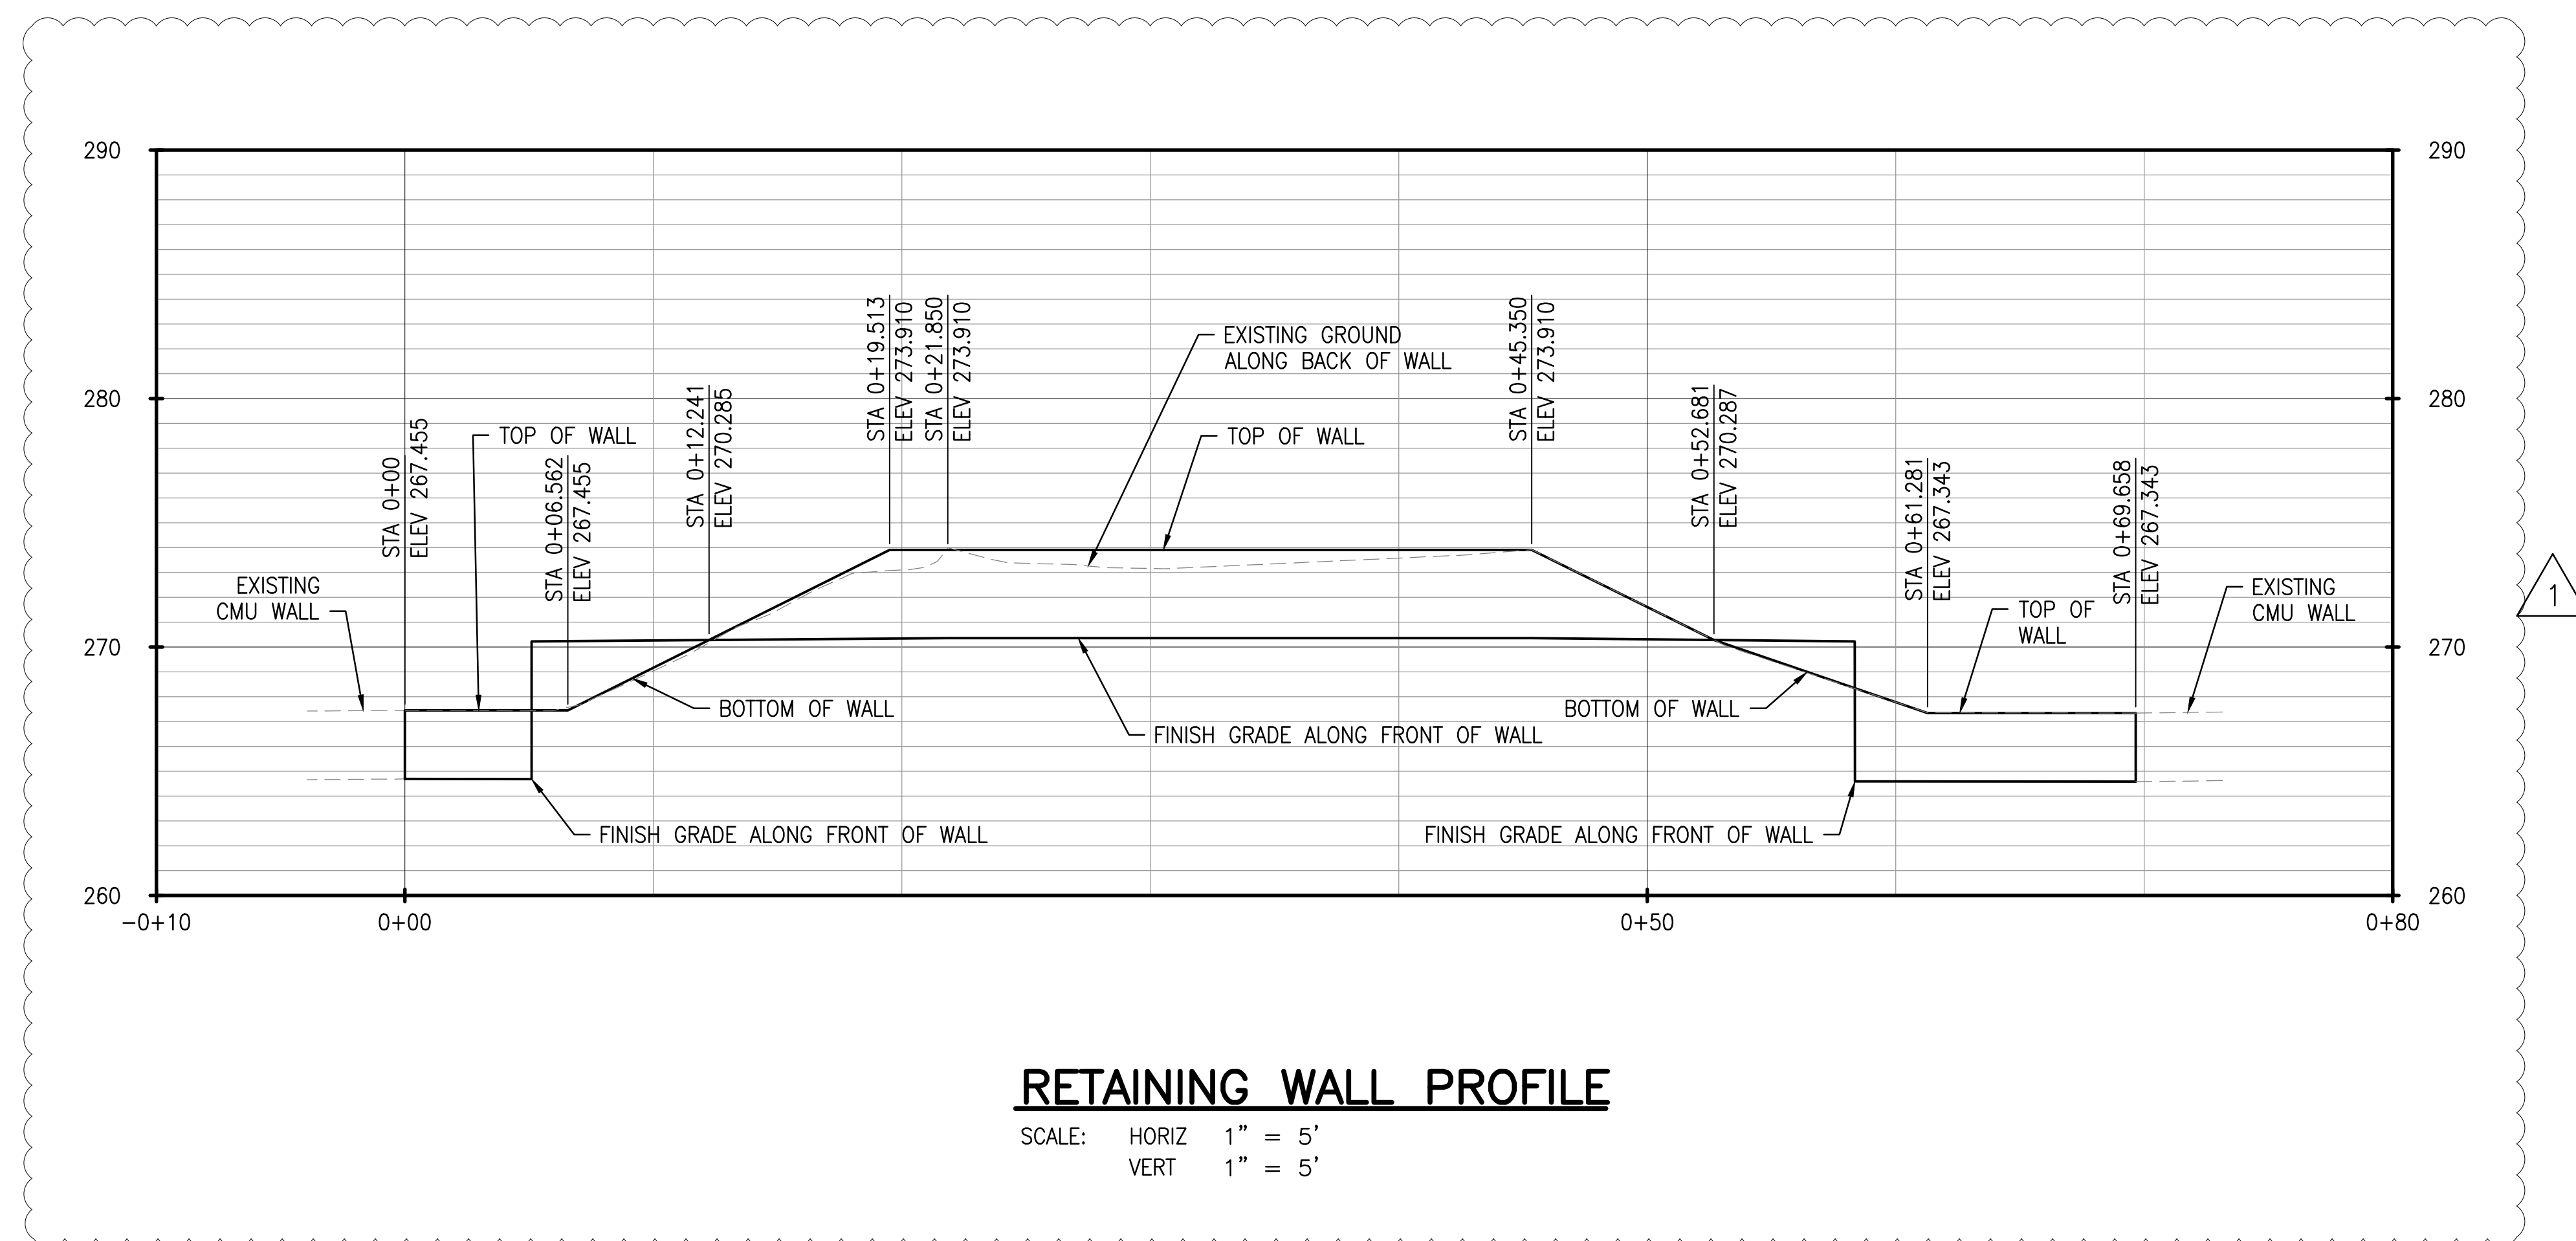

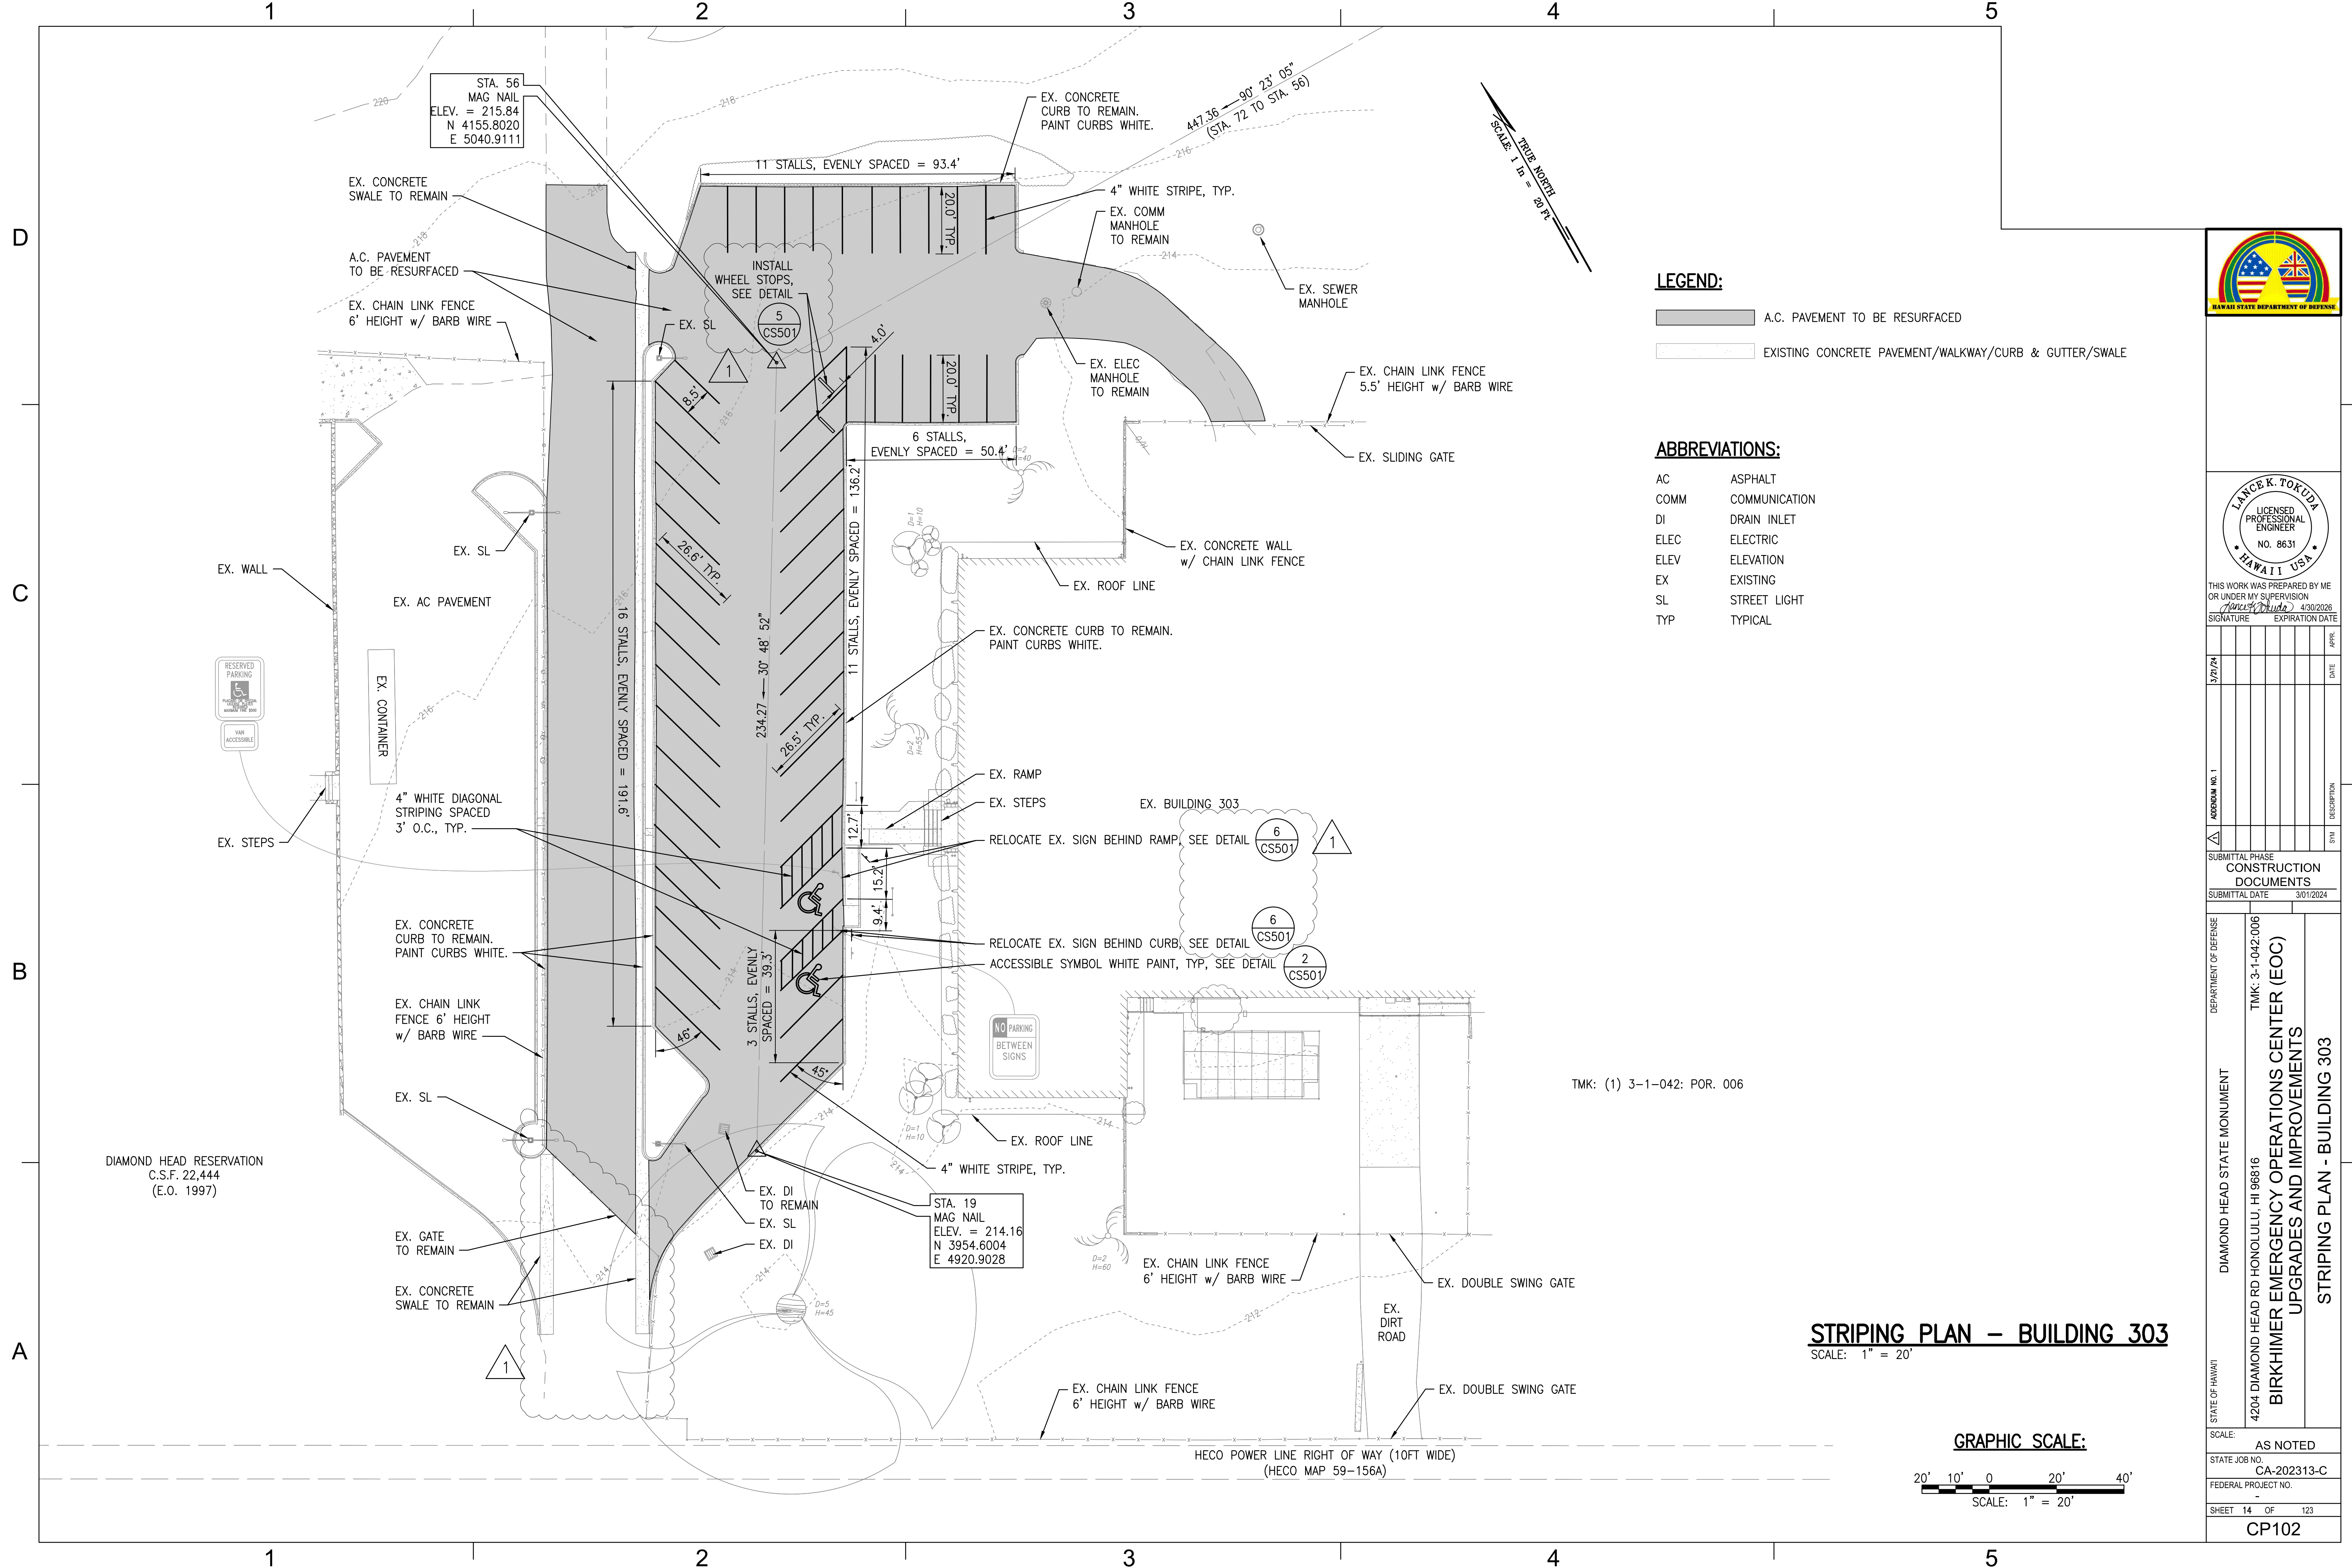



LEGEND:

- A.C. PAVEMENT TO BE RESURFACED
- EXISTING CONCRETE PAVEMENT/WALKWAY/CURB & GUTTER/SWALE

ABBREVIATIONS:

- AC ASPHALT
- COMM COMMUNICATION
- DI DRAIN INLET
- ELEC ELECTRIC
- ELEV ELEVATION
- EX EXISTING
- SL STREET LIGHT
- TYP TYPICAL

STRIPING PLAN – BUILDING 303
SCALE: 1" = 20'

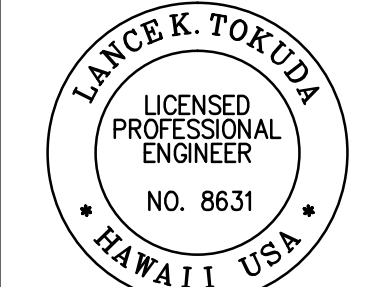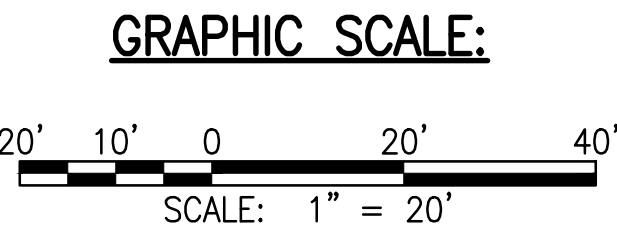

THIS WORK WAS PREPARED BY ME OR UNDER MY SUPERVISION
Signature: Lance K. Tokuda 4/30/2026
SIGNATURE EXPIRATION DATE

APPROVAL NO. 1	DATE	DESCRIPTION	SYN
3/2/24			

SUBMITTAL PHASE
CONSTRUCTION DOCUMENTS
SUBMITTAL DATE 3/01/2024

STATE OF HAWAII
DIAMOND HEAD STATE MONUMENT
4204 DIAMOND HEAD RD HONOLULU, HI 96816
TMK: 3-1-042:006
BIRKHMIR EMERGENCY OPERATIONS CENTER (EOC)
UPGRADES AND IMPROVEMENTS
STRIPING PLAN - BUILDING 303

SCALE: AS NOTED
STATE JOB NO. CA-202313-C
FEDERAL PROJECT NO. -
SHEET 14 OF 123
CP102

1


2

3

4


5

D

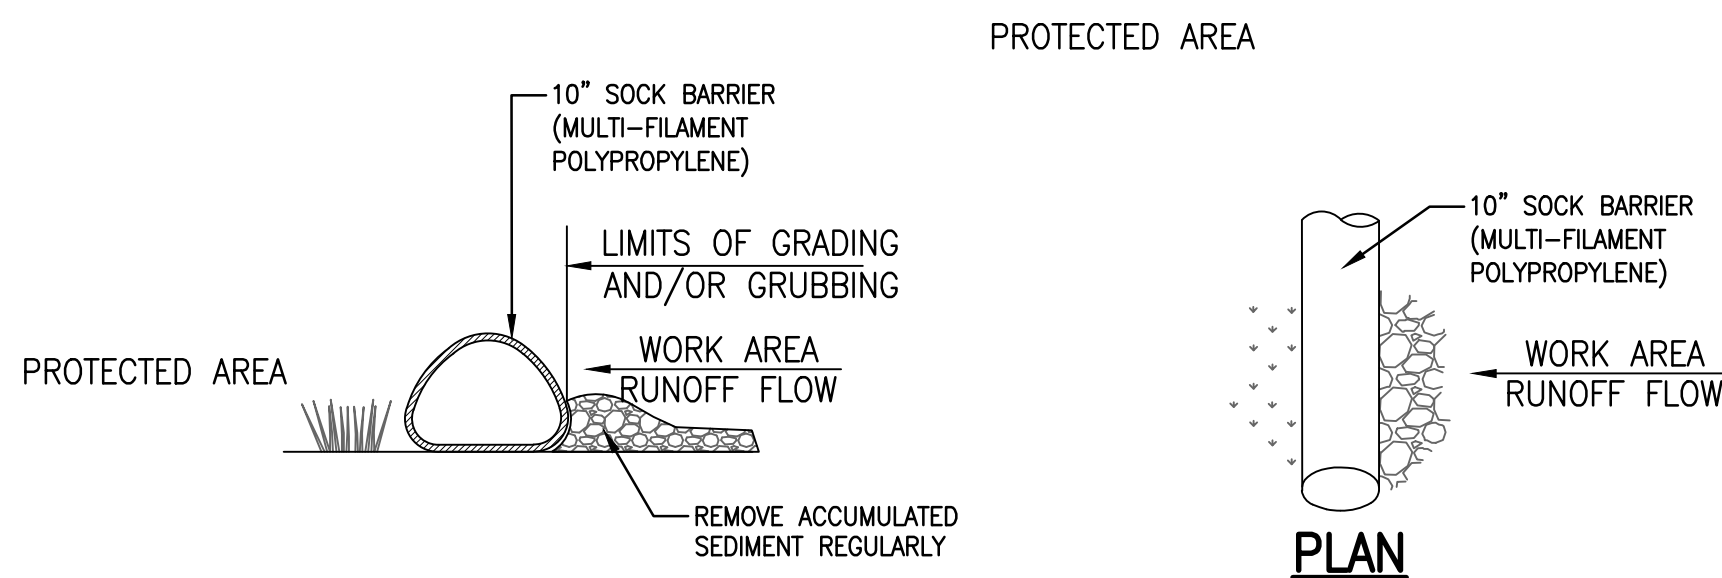

SECTION


PLAN

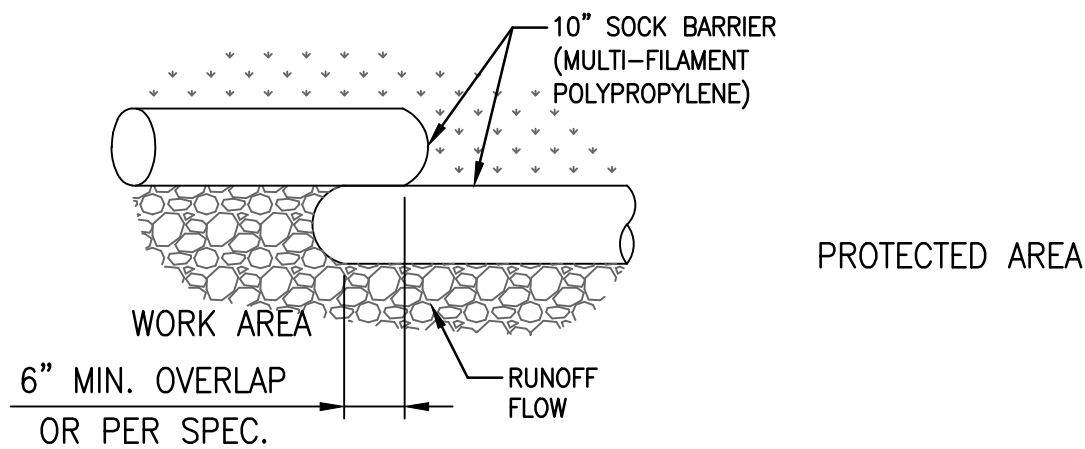


OVERLAP

1 SILT SOCK BARRIER DETAIL
CS501 NOT TO SCALE


2 ACCESSIBLE PAVEMENT MARKING
CS501 NOT TO SCALE

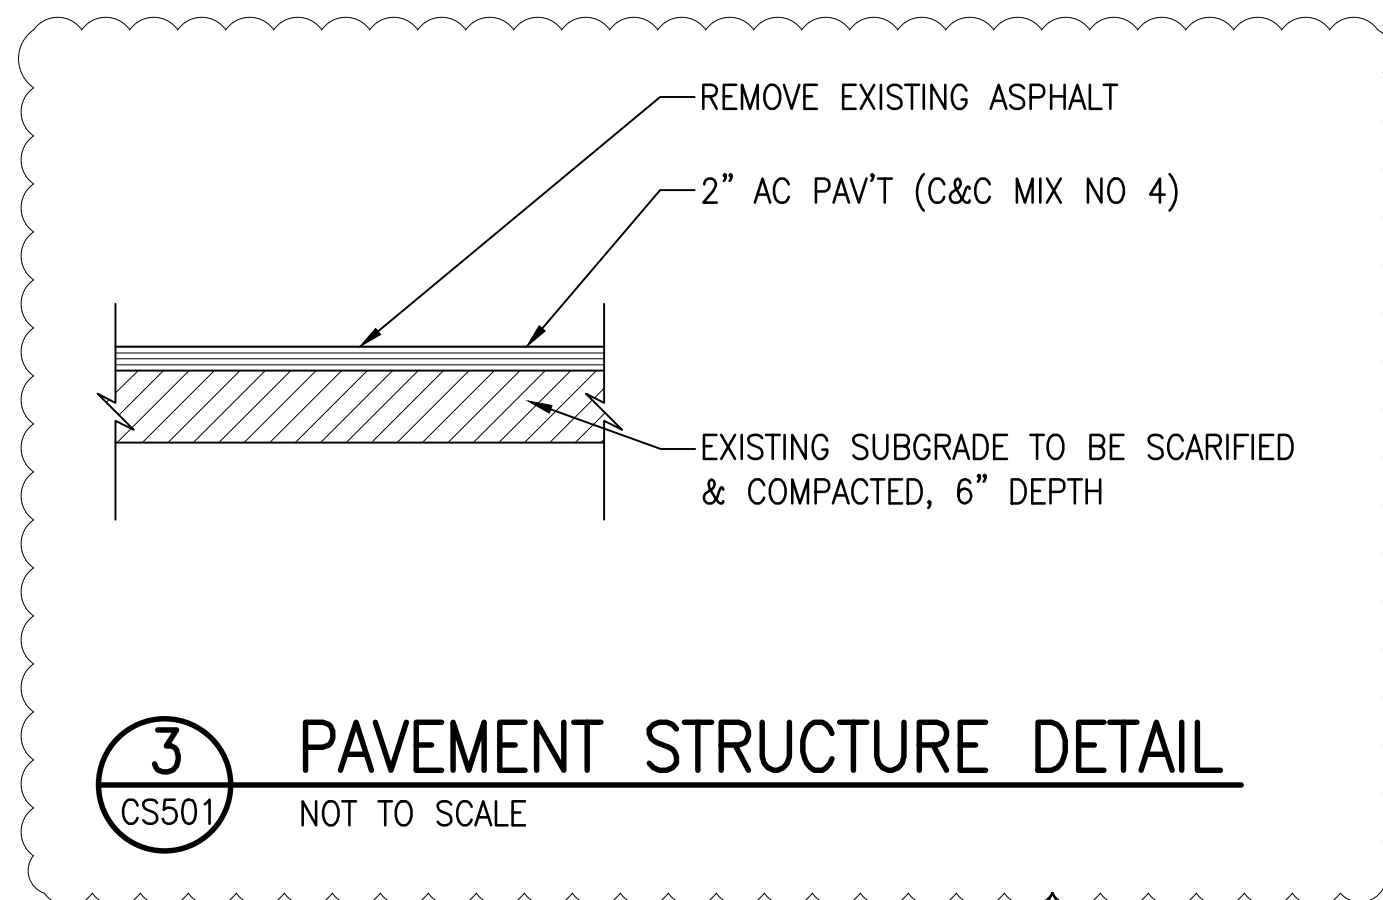

3 PAVEMENT STRUCTURE DETAIL
CS501 NOT TO SCALE

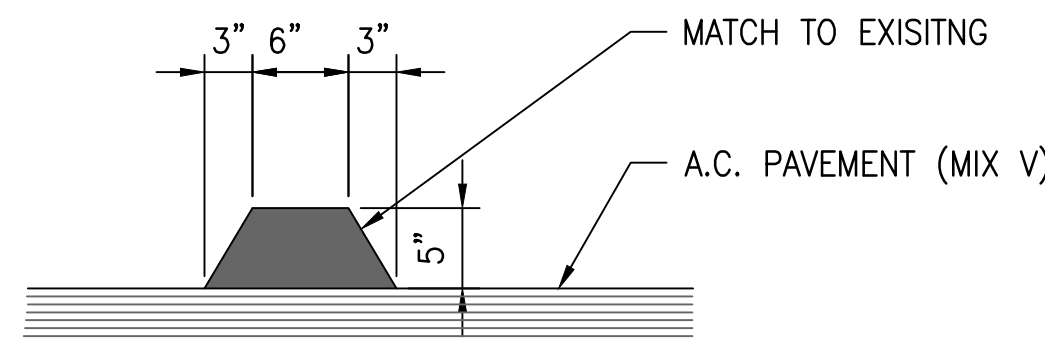

4 AC CURB RESTORATION DETAIL
CS501 NOT TO SCALE

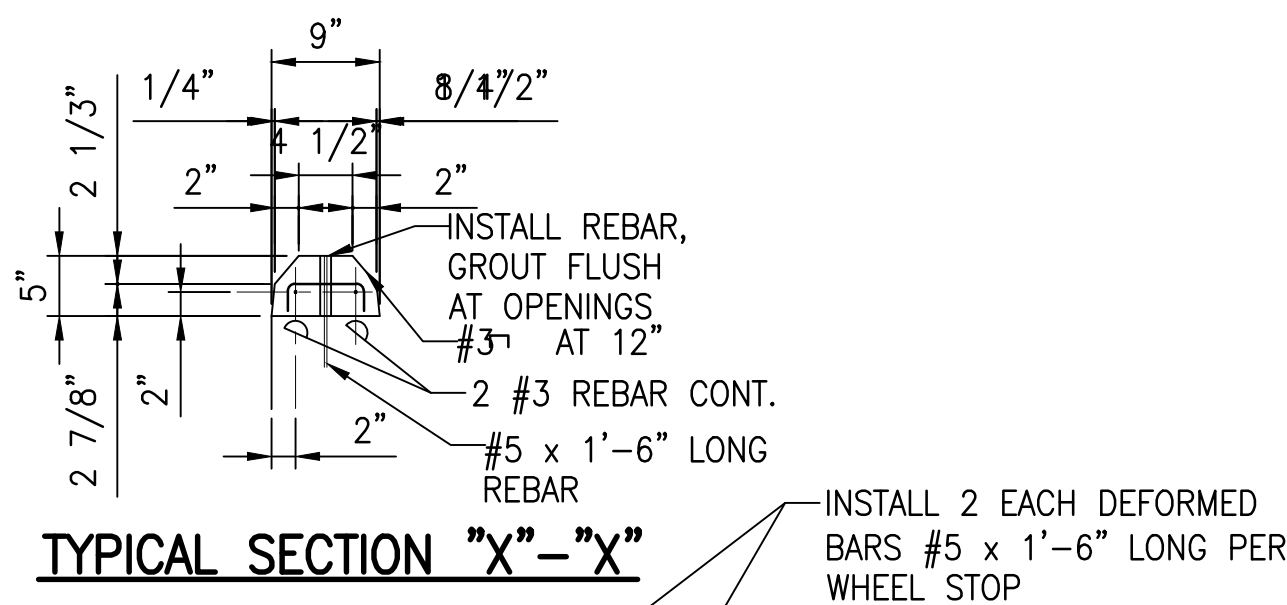

9"x 6'-0" WHEEL STOP


5 CONCRETE WHEEL STOP DETAIL
CS501 NOT TO SCALE

SIGN POST DETAIL NOTES:


1. THE INSIDE OF THE 2-1/4" ANCHOR POST MUST BE KEPT FREE OF IMPEDIMENTS TO ASSURE EASY INSERTION OF THE 2" SIGN POST.
2. SQUARE TUBE POST SHALL BE TELESCOPING PERFORATED.
3. THE 2-1/4" ANCHOR POST SHALL BE 4'-0" LONG FOR NORMAL OR POOR CONDITIONS AND 2'-6" FOR ROCKY CONDITIONS.
4. SIGN POST MUST BE FIRM AND NOT SHAKY, OTHERWISE CONCRETE MUST BE USED TO STABILIZE THE ANCHOR POST.

SIGN NOTES:

1. SIGNS SHALL CONFORM TO THE LATEST EDITION OF FHWA PUBLICATIONS "MANUAL ON UNIFORM TRAFFIC CONTROL DEVICES FOR STREETS AND HIGHWAYS", STANDARD ALPHABETS FOR HIGHWAYS SIGNS", AND THE AMERICANS WITH DISABILITIES ACCESSIBILITY GUIDELINES (ADAAG) SECTION 4.30, AND AS AMENDED.
2. SIGNS SHALL BE MINIMUM T6061 SHEET COVERED WITH ENGINEERING GRADE REFLECTIVE SHEETING.
3. ALL SIGNS SHALL HAVE 3/8" DIA BOLT HOLES PRE-DRILLED AT APPROPRIATE LOCATIONS.
4. SIGN LETTERING SHALL BE UPPERCASE LETTERS OF THE TYPE APPROVED BY THE FEDERAL HIGHWAY ADMINISTRATION.

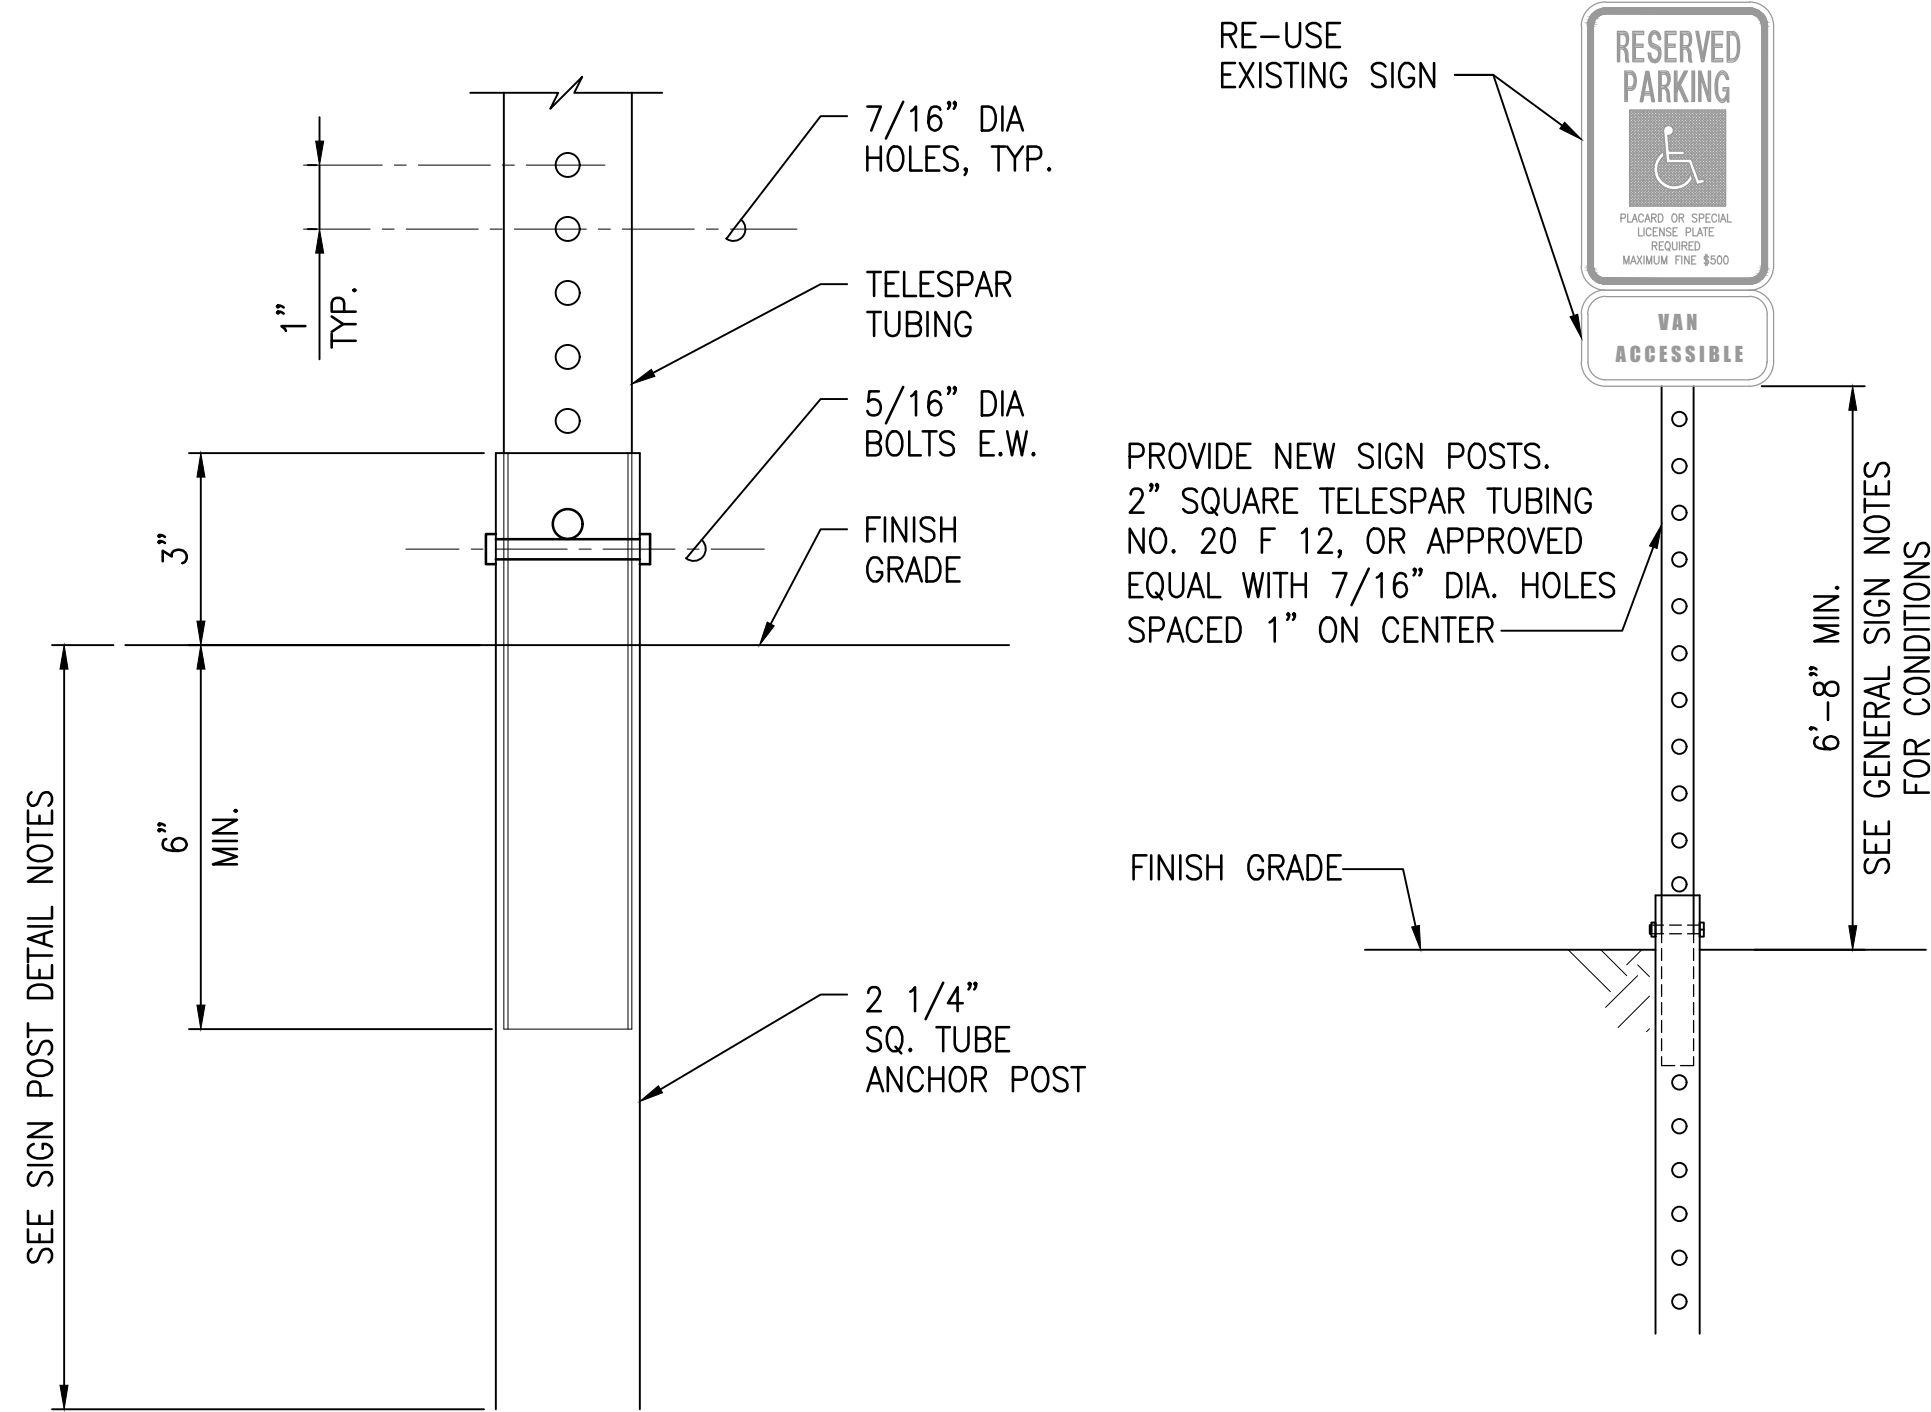

6 SIGN POST DETAIL
CS501 NOT TO SCALE

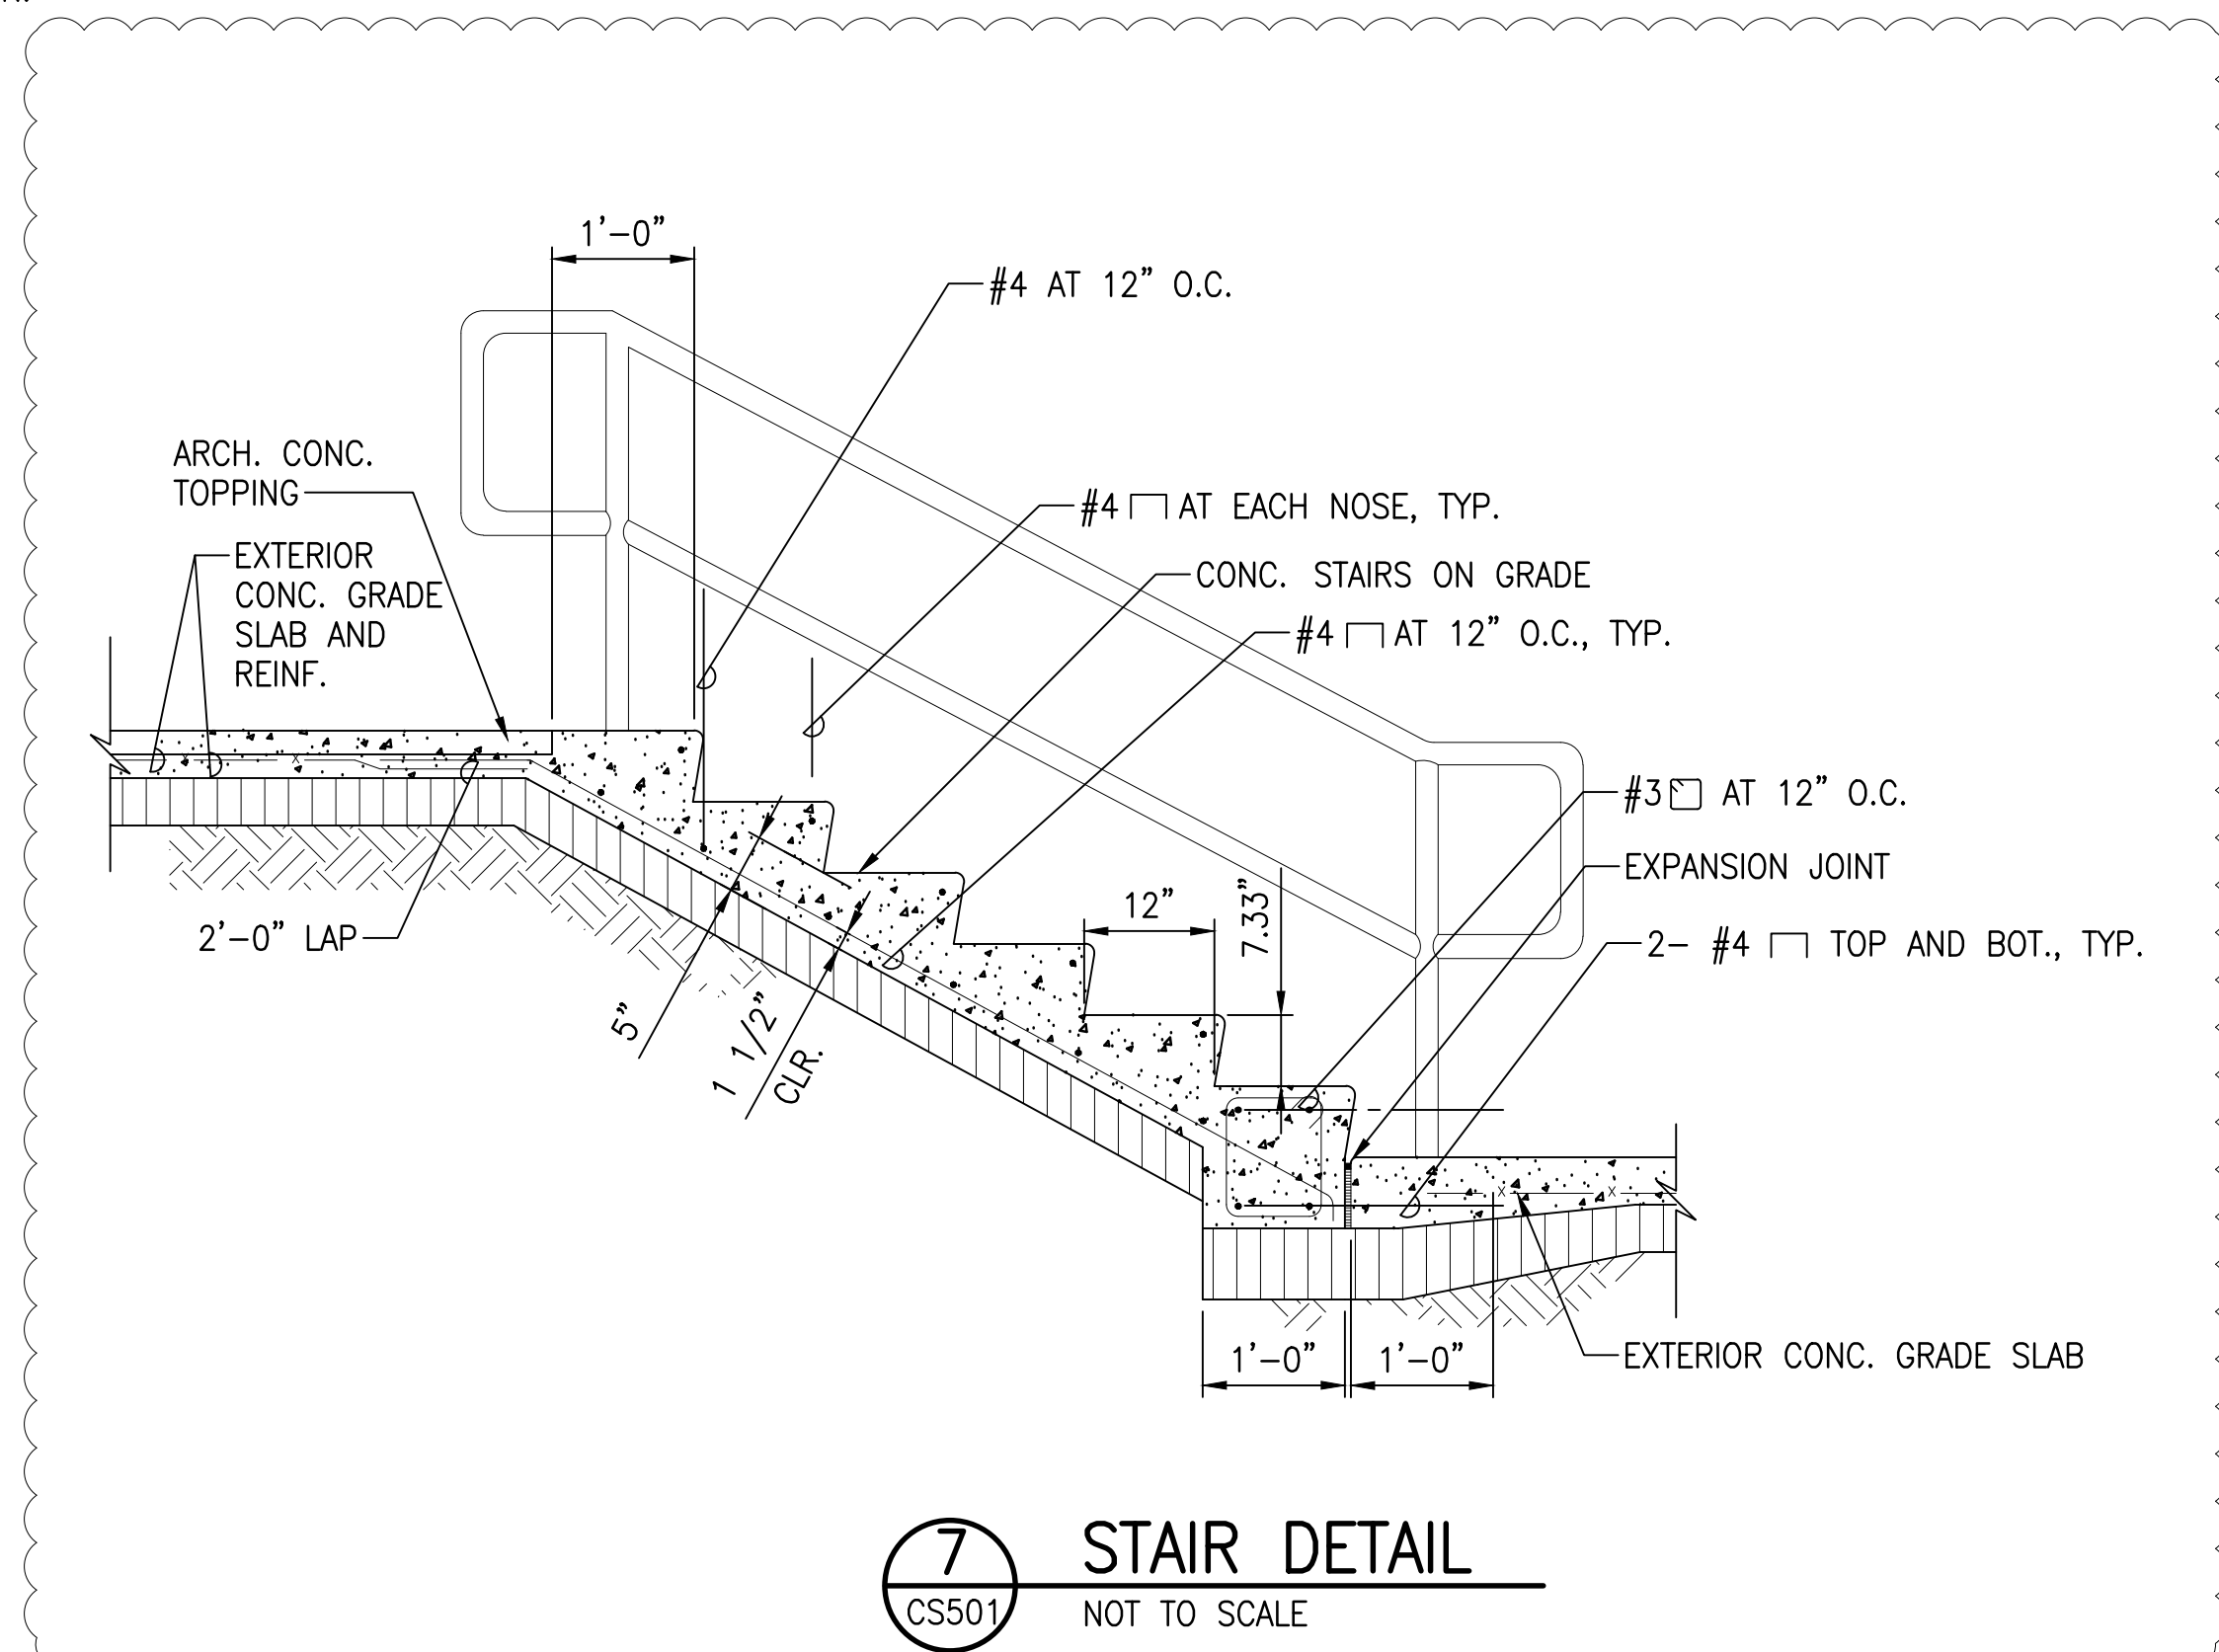


7 STAIR DETAIL
CS501 NOT TO SCALE

C

B

A

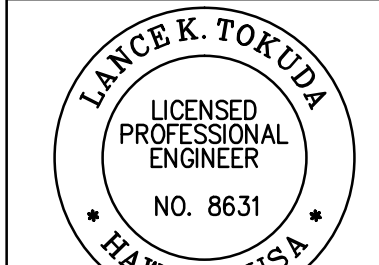


THIS WORK WAS PREPARED BY ME OR UNDER MY SUPERVISION
Signature: Lance K. Tokuda
DATE: 4/30/2026
SIGNATURE: EXPIRATION DATE

NO.	DATE	DESCRIPTION	SYN
1	3/2/24		
2			
3			
4			
5			
6			
7			
8			
9			
10			
11			
12			
13			
14			
15			
16			
17			
18			
19			
20			

SUBMITTAL PHASE
CONSTRUCTION DOCUMENTS
SUBMITTAL DATE: 3/01/2024


STATE OF HAWAII
DEPARTMENT OF DEFENSE
DIAMOND HEAD STATE MONUMENT
4204 DIAMOND HEAD RD HONOLULU, HI 96816
TMK: 3-1-042:006
BIRKHMIR EMERGENCY OPERATIONS CENTER (EOC)
UPGRADES AND IMPROVEMENTS
SITE DETAILS

SCALE: AS NOTED
STATE JOB NO. CA-202313-C
FEDERAL PROJECT NO. -
SHEET 9 OF 123
CS501

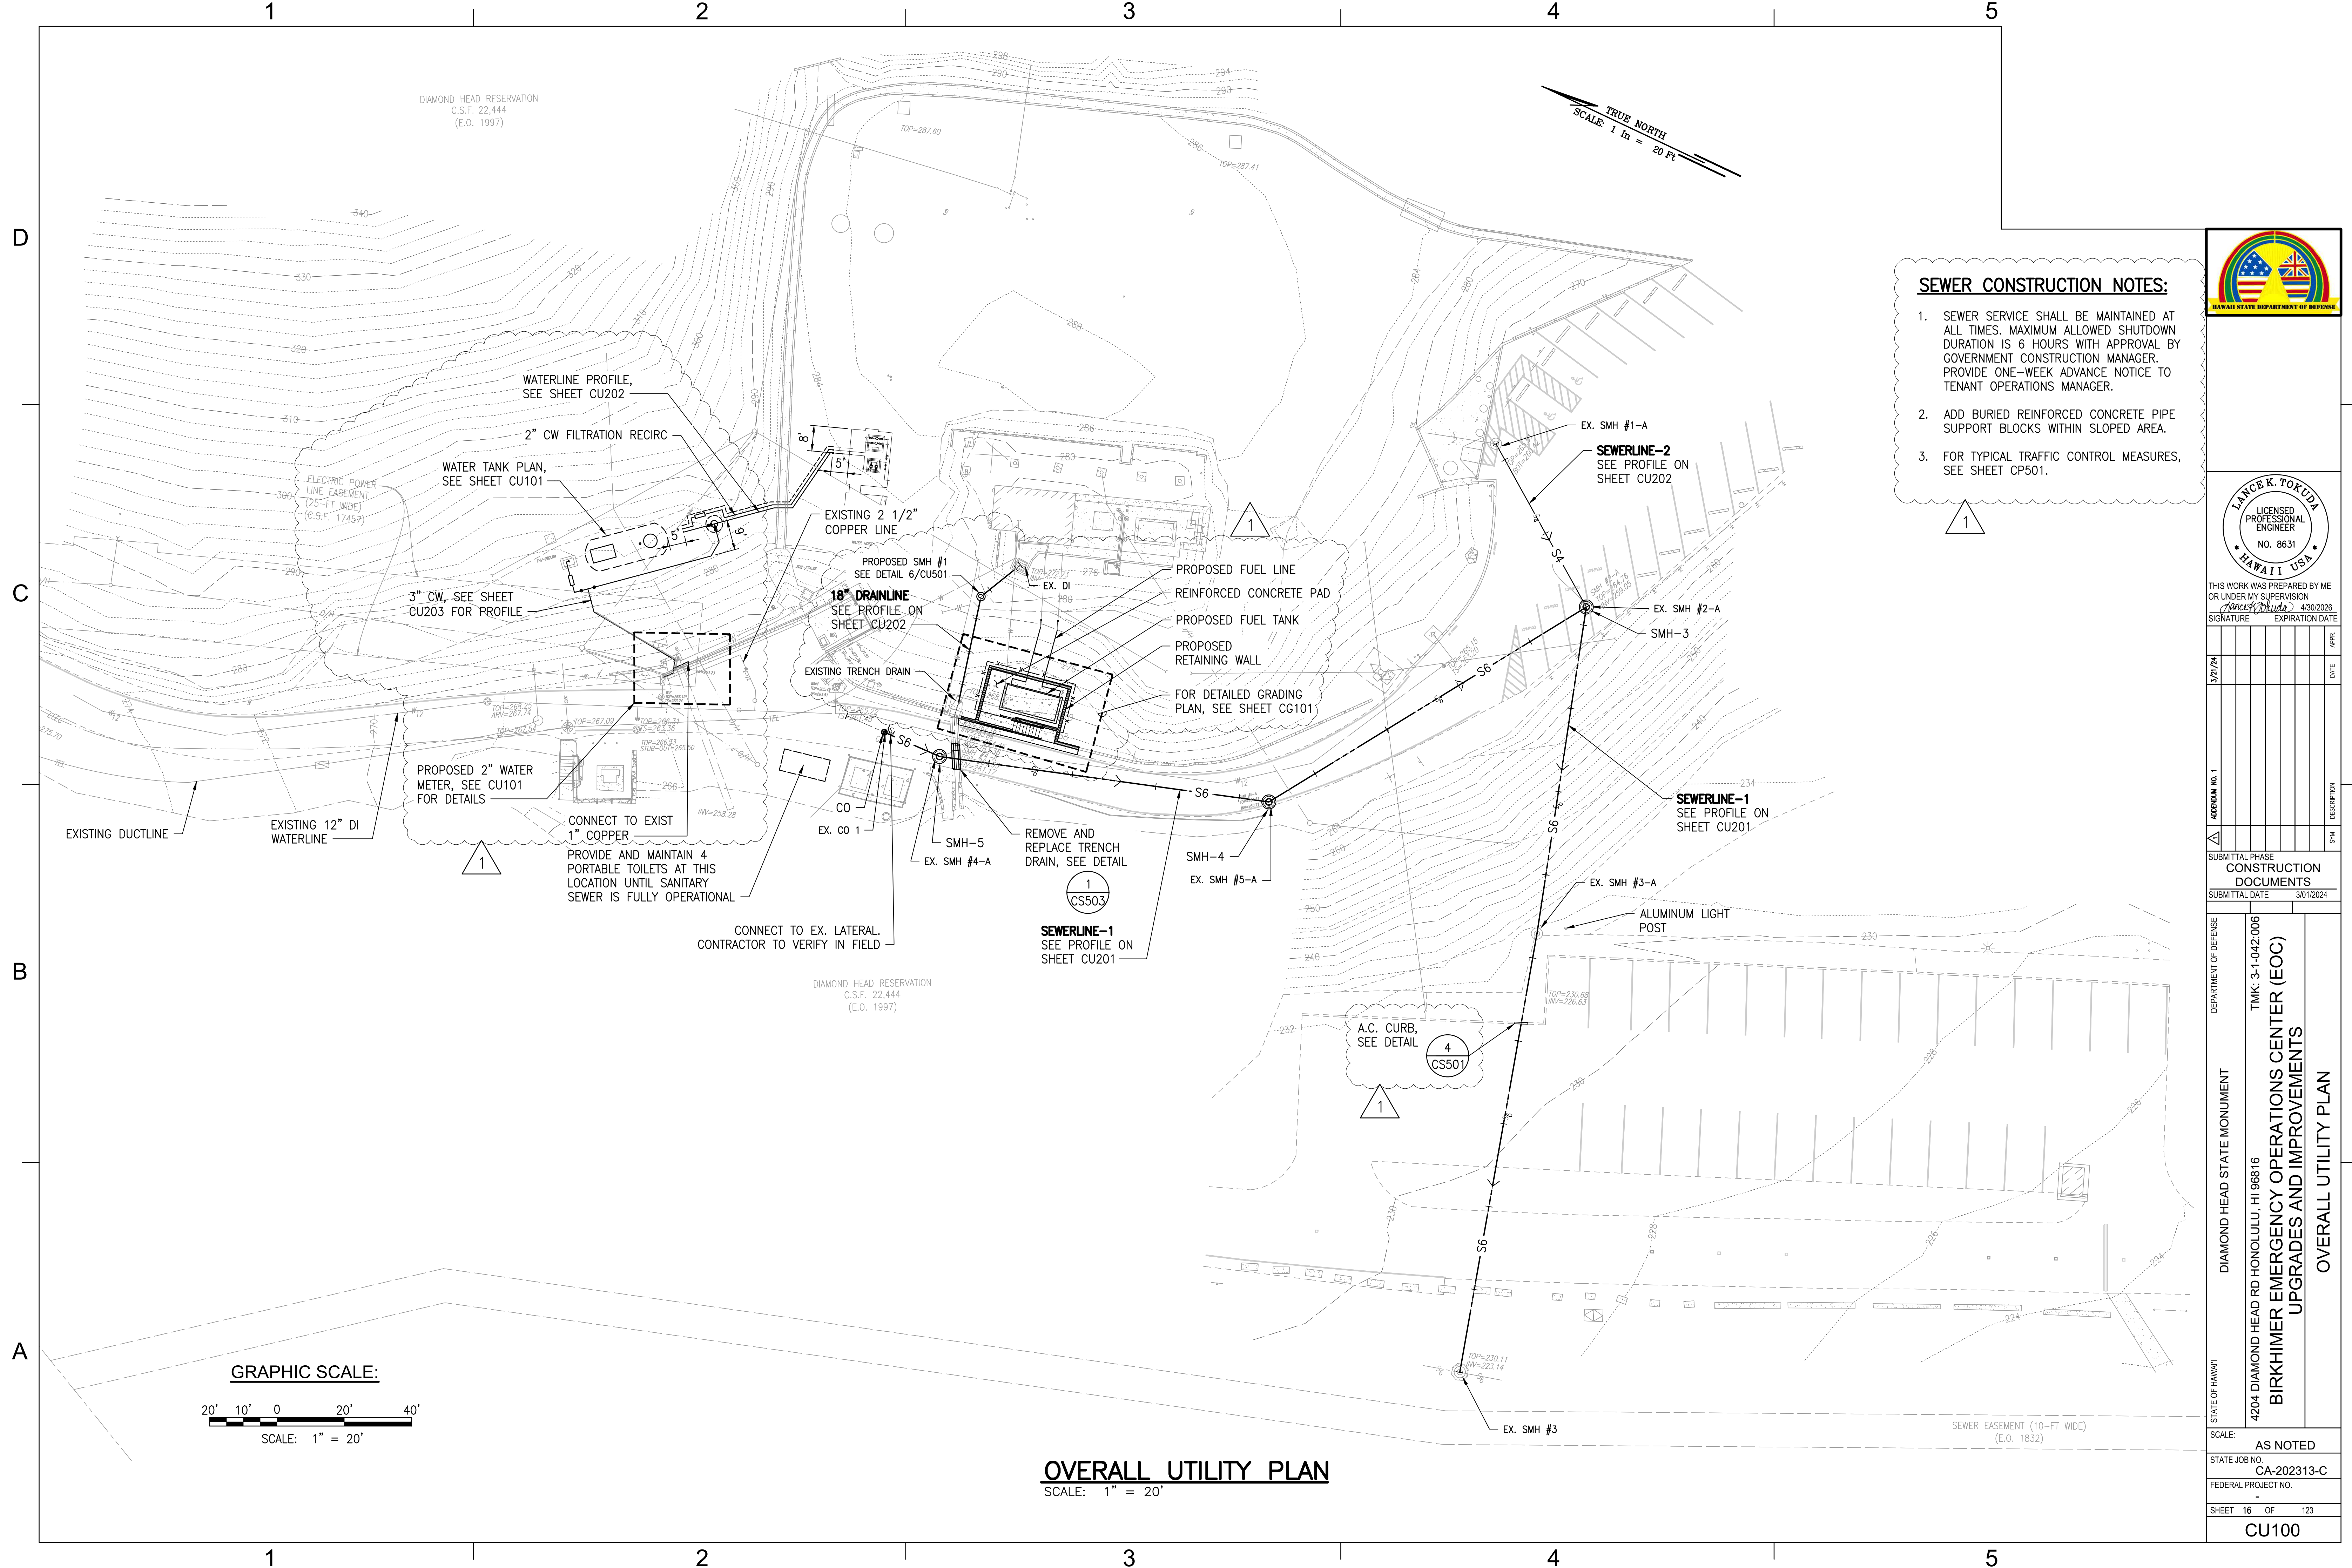

SEWER CONSTRUCTION NOTES:

1. SEWER SERVICE SHALL BE MAINTAINED AT ALL TIMES. MAXIMUM ALLOWED SHUTDOWN DURATION IS 6 HOURS WITH APPROVAL BY GOVERNMENT CONSTRUCTION MANAGER. PROVIDE ONE-WEEK ADVANCE NOTICE TO TENANT OPERATIONS MANAGER.
2. ADD BURIED REINFORCED CONCRETE PIPE SUPPORT BLOCKS WITHIN SLOPED AREA.
3. FOR TYPICAL TRAFFIC CONTROL MEASURES, SEE SHEET CP501.

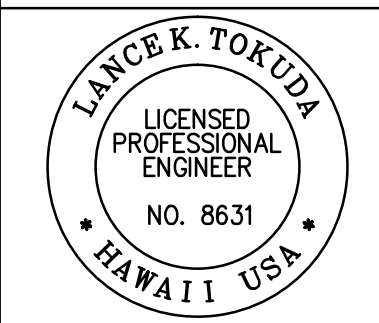

THIS WORK WAS PREPARED BY ME OR UNDER MY SUPERVISION
Signature: *Lance K. Tokuda* 4/30/2026
DATE: 4/30/2026

SUBMITTAL PHASE		CONSTRUCTION DOCUMENTS	
NO.	DATE	NO.	DATE
1	3/7/24	1	3/7/24
2		2	
3		3	
4		4	
5		5	
6		6	
7		7	
8		8	
9		9	
10		10	
11		11	
12		12	
13		13	
14		14	
15		15	
16		16	
17		17	
18		18	
19		19	
20		20	

STATE OF HAWAII	DEPARTMENT OF DEFENSE	DIAMOND HEAD STATE MONUMENT	TMK: 3-1-042:006	OVERALL UTILITY PLAN
4204 DIAMOND HEAD RD HONOLULU, HI 96816				BIRKHAMER EMERGENCY OPERATIONS CENTER (EOC) UPGRADES AND IMPROVEMENTS
SCALE: AS NOTED				CU100
STATE JOB NO. CA-202313-C				
FEDERAL PROJECT NO.				
SHEET 16 OF 123				

OVERALL UTILITY PLAN
SCALE: 1" = 20'

1

2

3

4



5

D

C

B


A

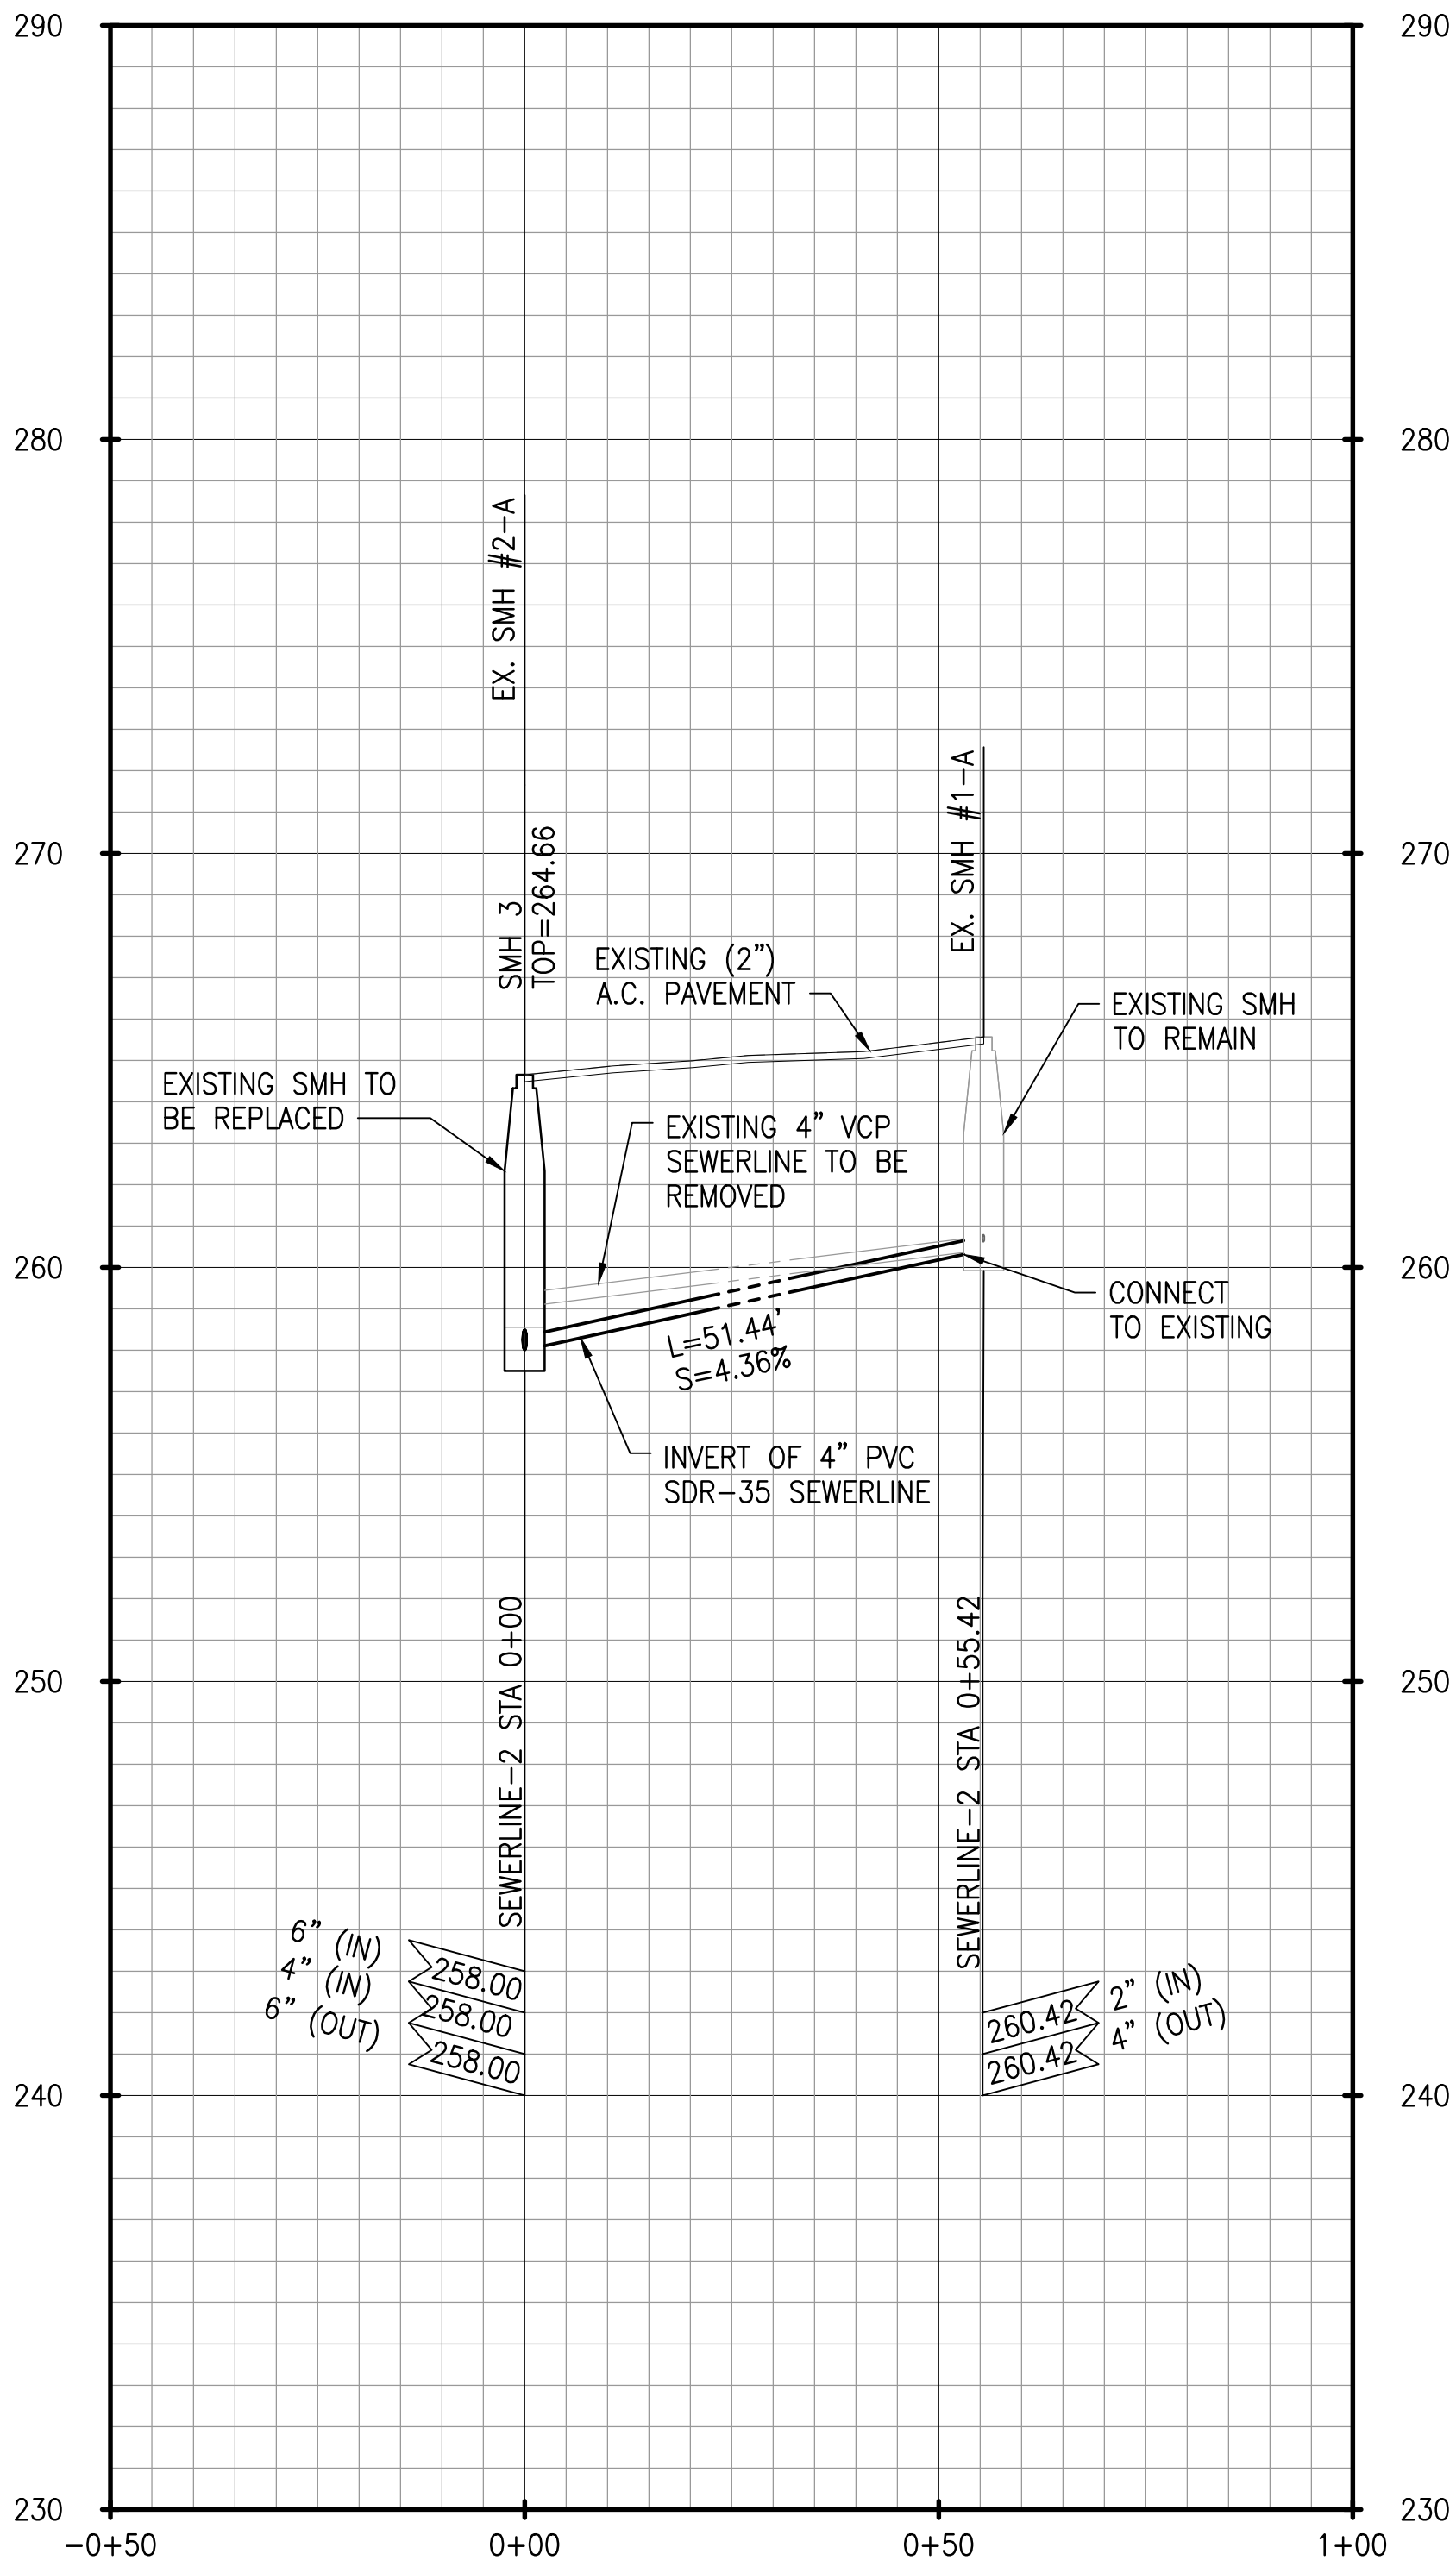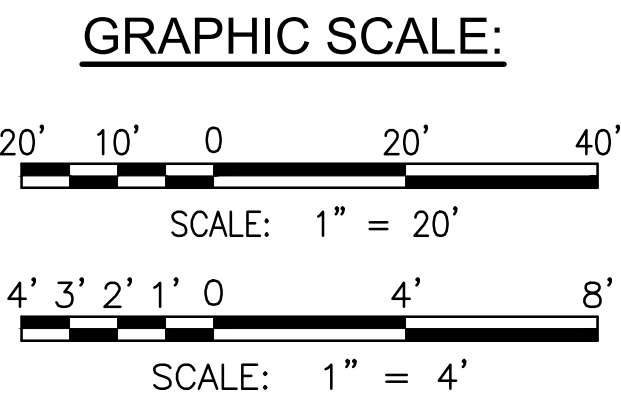

SEWERLINE-2 PROFILE


SCALE: HORIZ 1" = 20'
VERT 1" = 4'

1

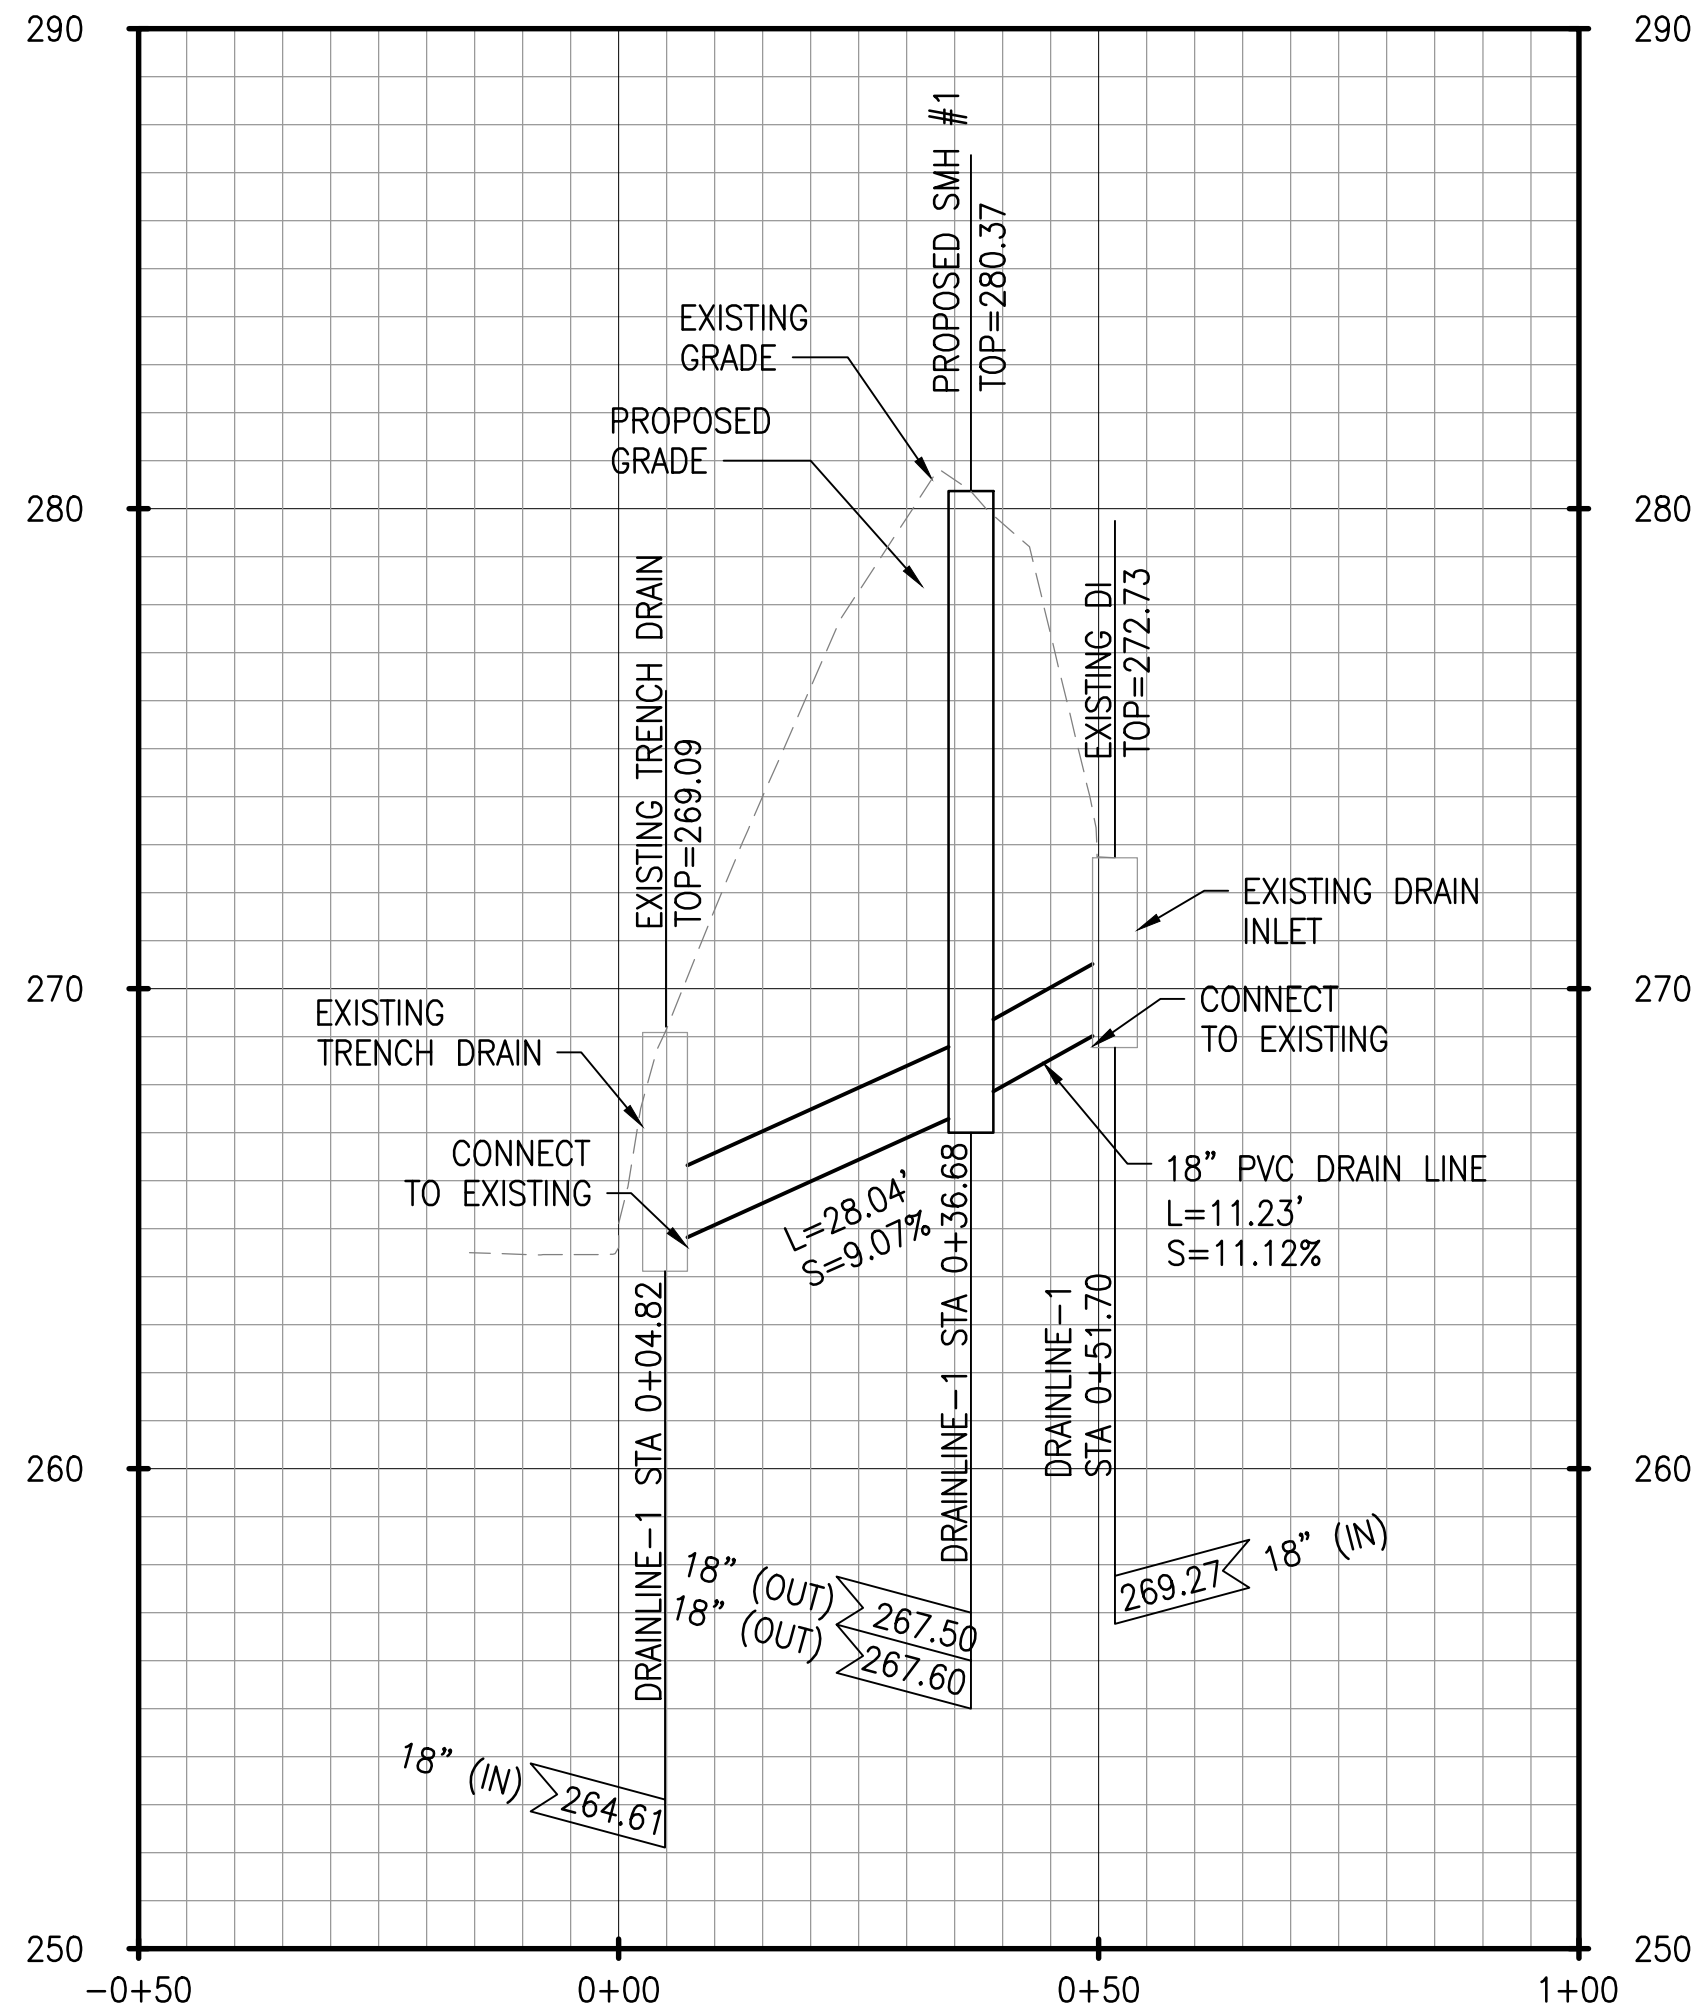

DRAINLINE PROFILE

SCALE: HORIZ 1" = 20'
VERT 1" = 4'

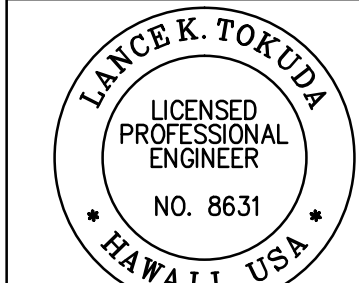

THIS WORK WAS PREPARED BY ME
OR UNDER MY SUPERVISION
Lance K. Tokuda 4/30/2026
SIGNATURE EXPIRATION DATE

APP'D	DATE	SYN	DESCRIPTION
3/2/24			
APPROVAL NO. 1			

CONSTRUCTION
DOCUMENTS
SUBMITTAL DATE 3/01/2024

STATE OF HAWAII	DIAMOND HEAD STATE MONUMENT	TMK: 3-1-042:006	4204 DIAMOND HEAD RD HONOLULU, HI 96816
BIRKHAMER EMERGENCY OPERATIONS CENTER (EOC)			UPGRADES AND IMPROVEMENTS
SEWER AND DRAIN PROFILES			

SCALE:	AS NOTED
STATE JOB NO.	CA-202313-C
FEDERAL PROJECT NO.	-
SHEET 19 OF 123	
CU202	

1

2

3

4

5

D

C

B


A

D

C


B

A

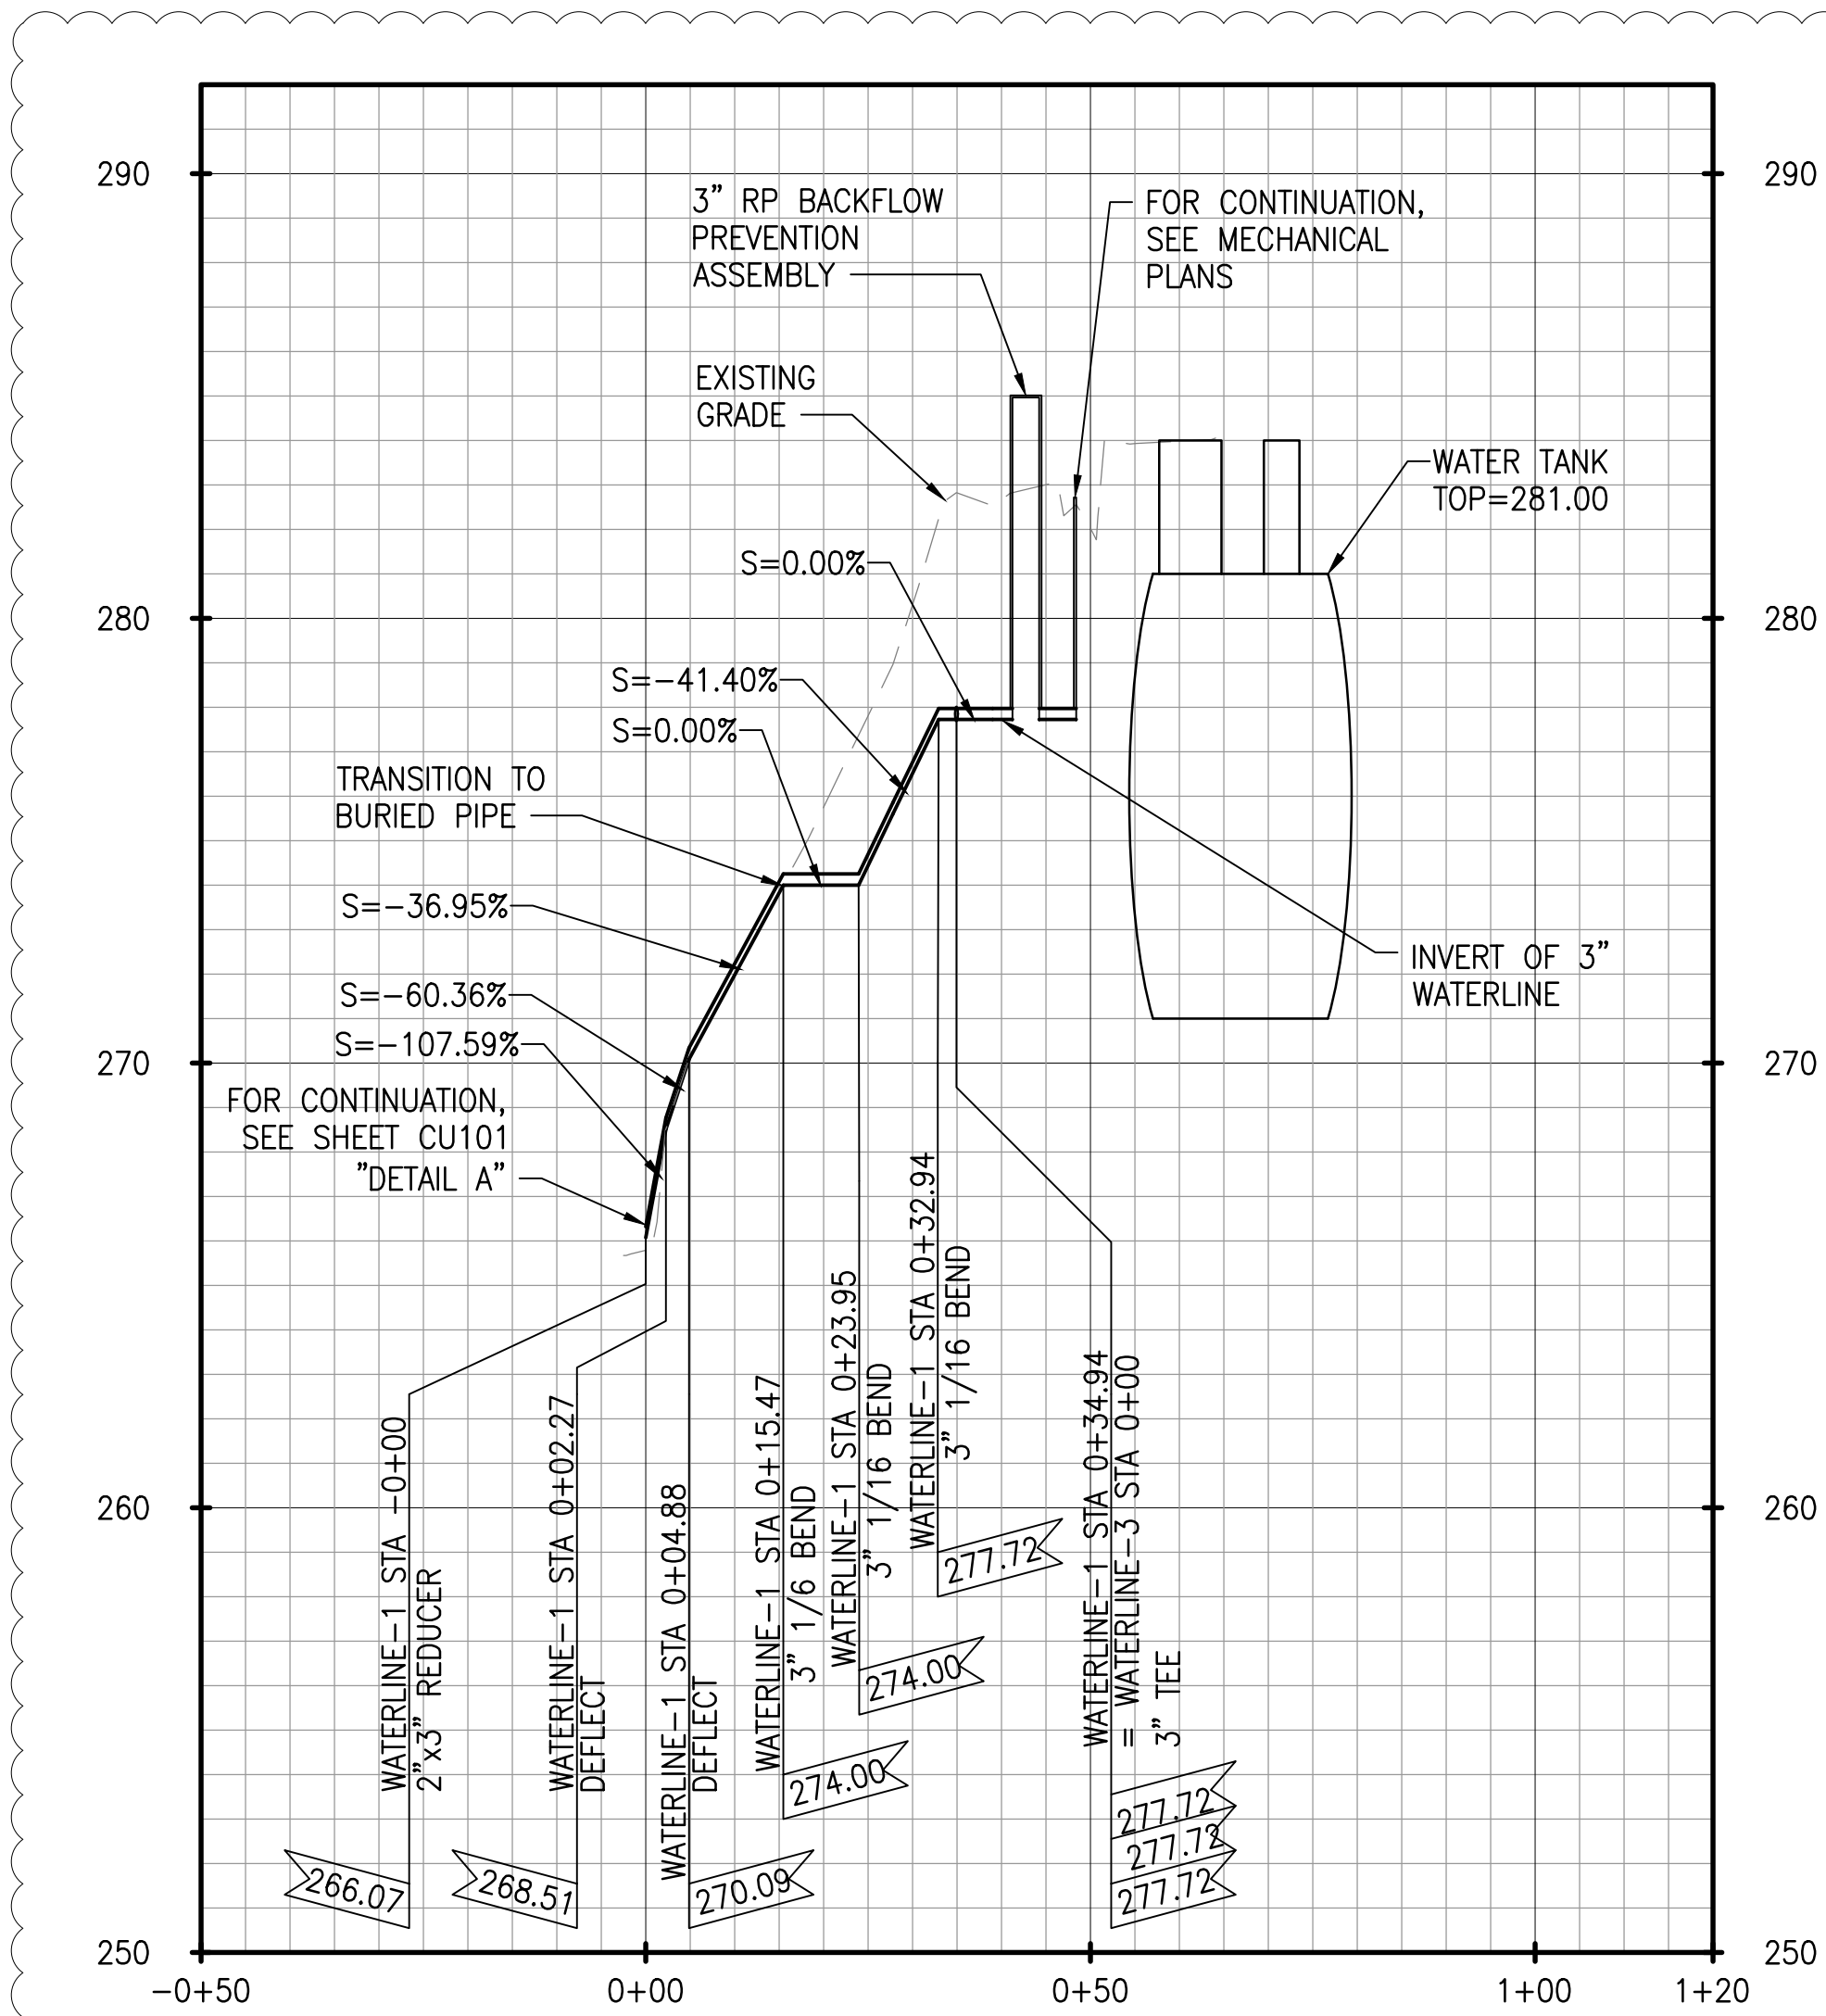


WATERLINE-1 PROFILE

SCALE: HORIZ 1" = 20'
VERT 1" = 4'

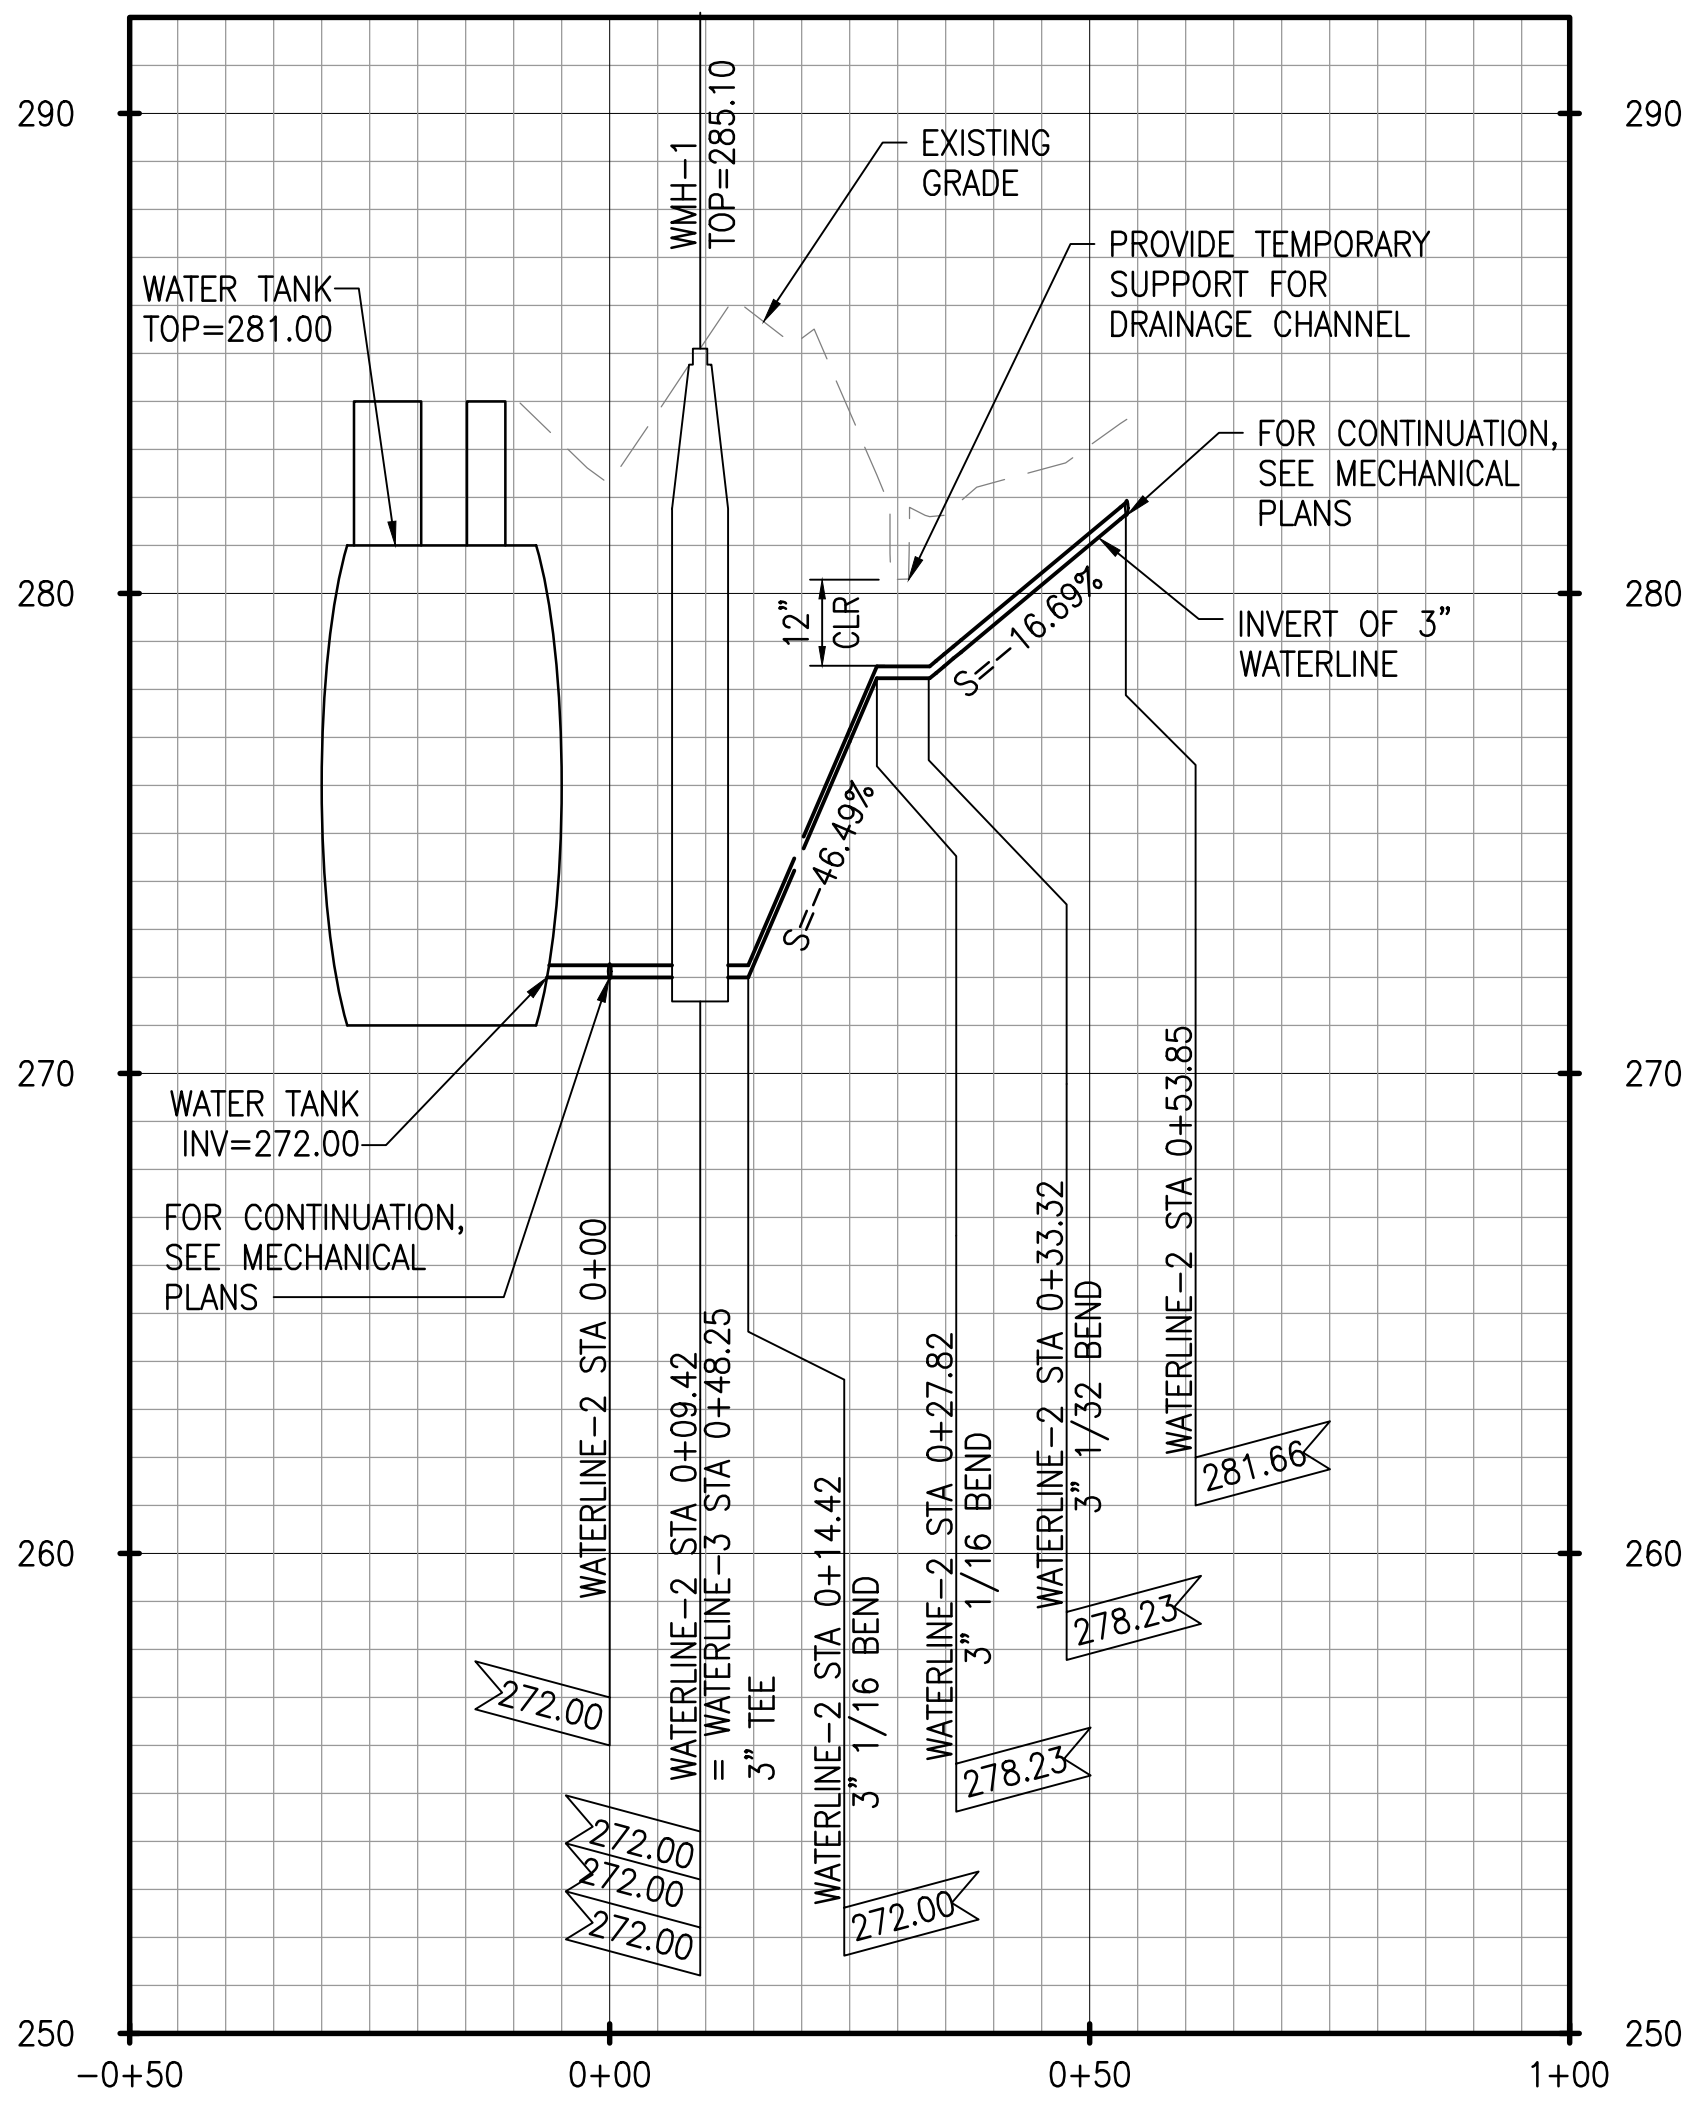

WATERLINE-2 PROFILE

SCALE: HORIZ 1" = 20'
VERT 1" = 4'

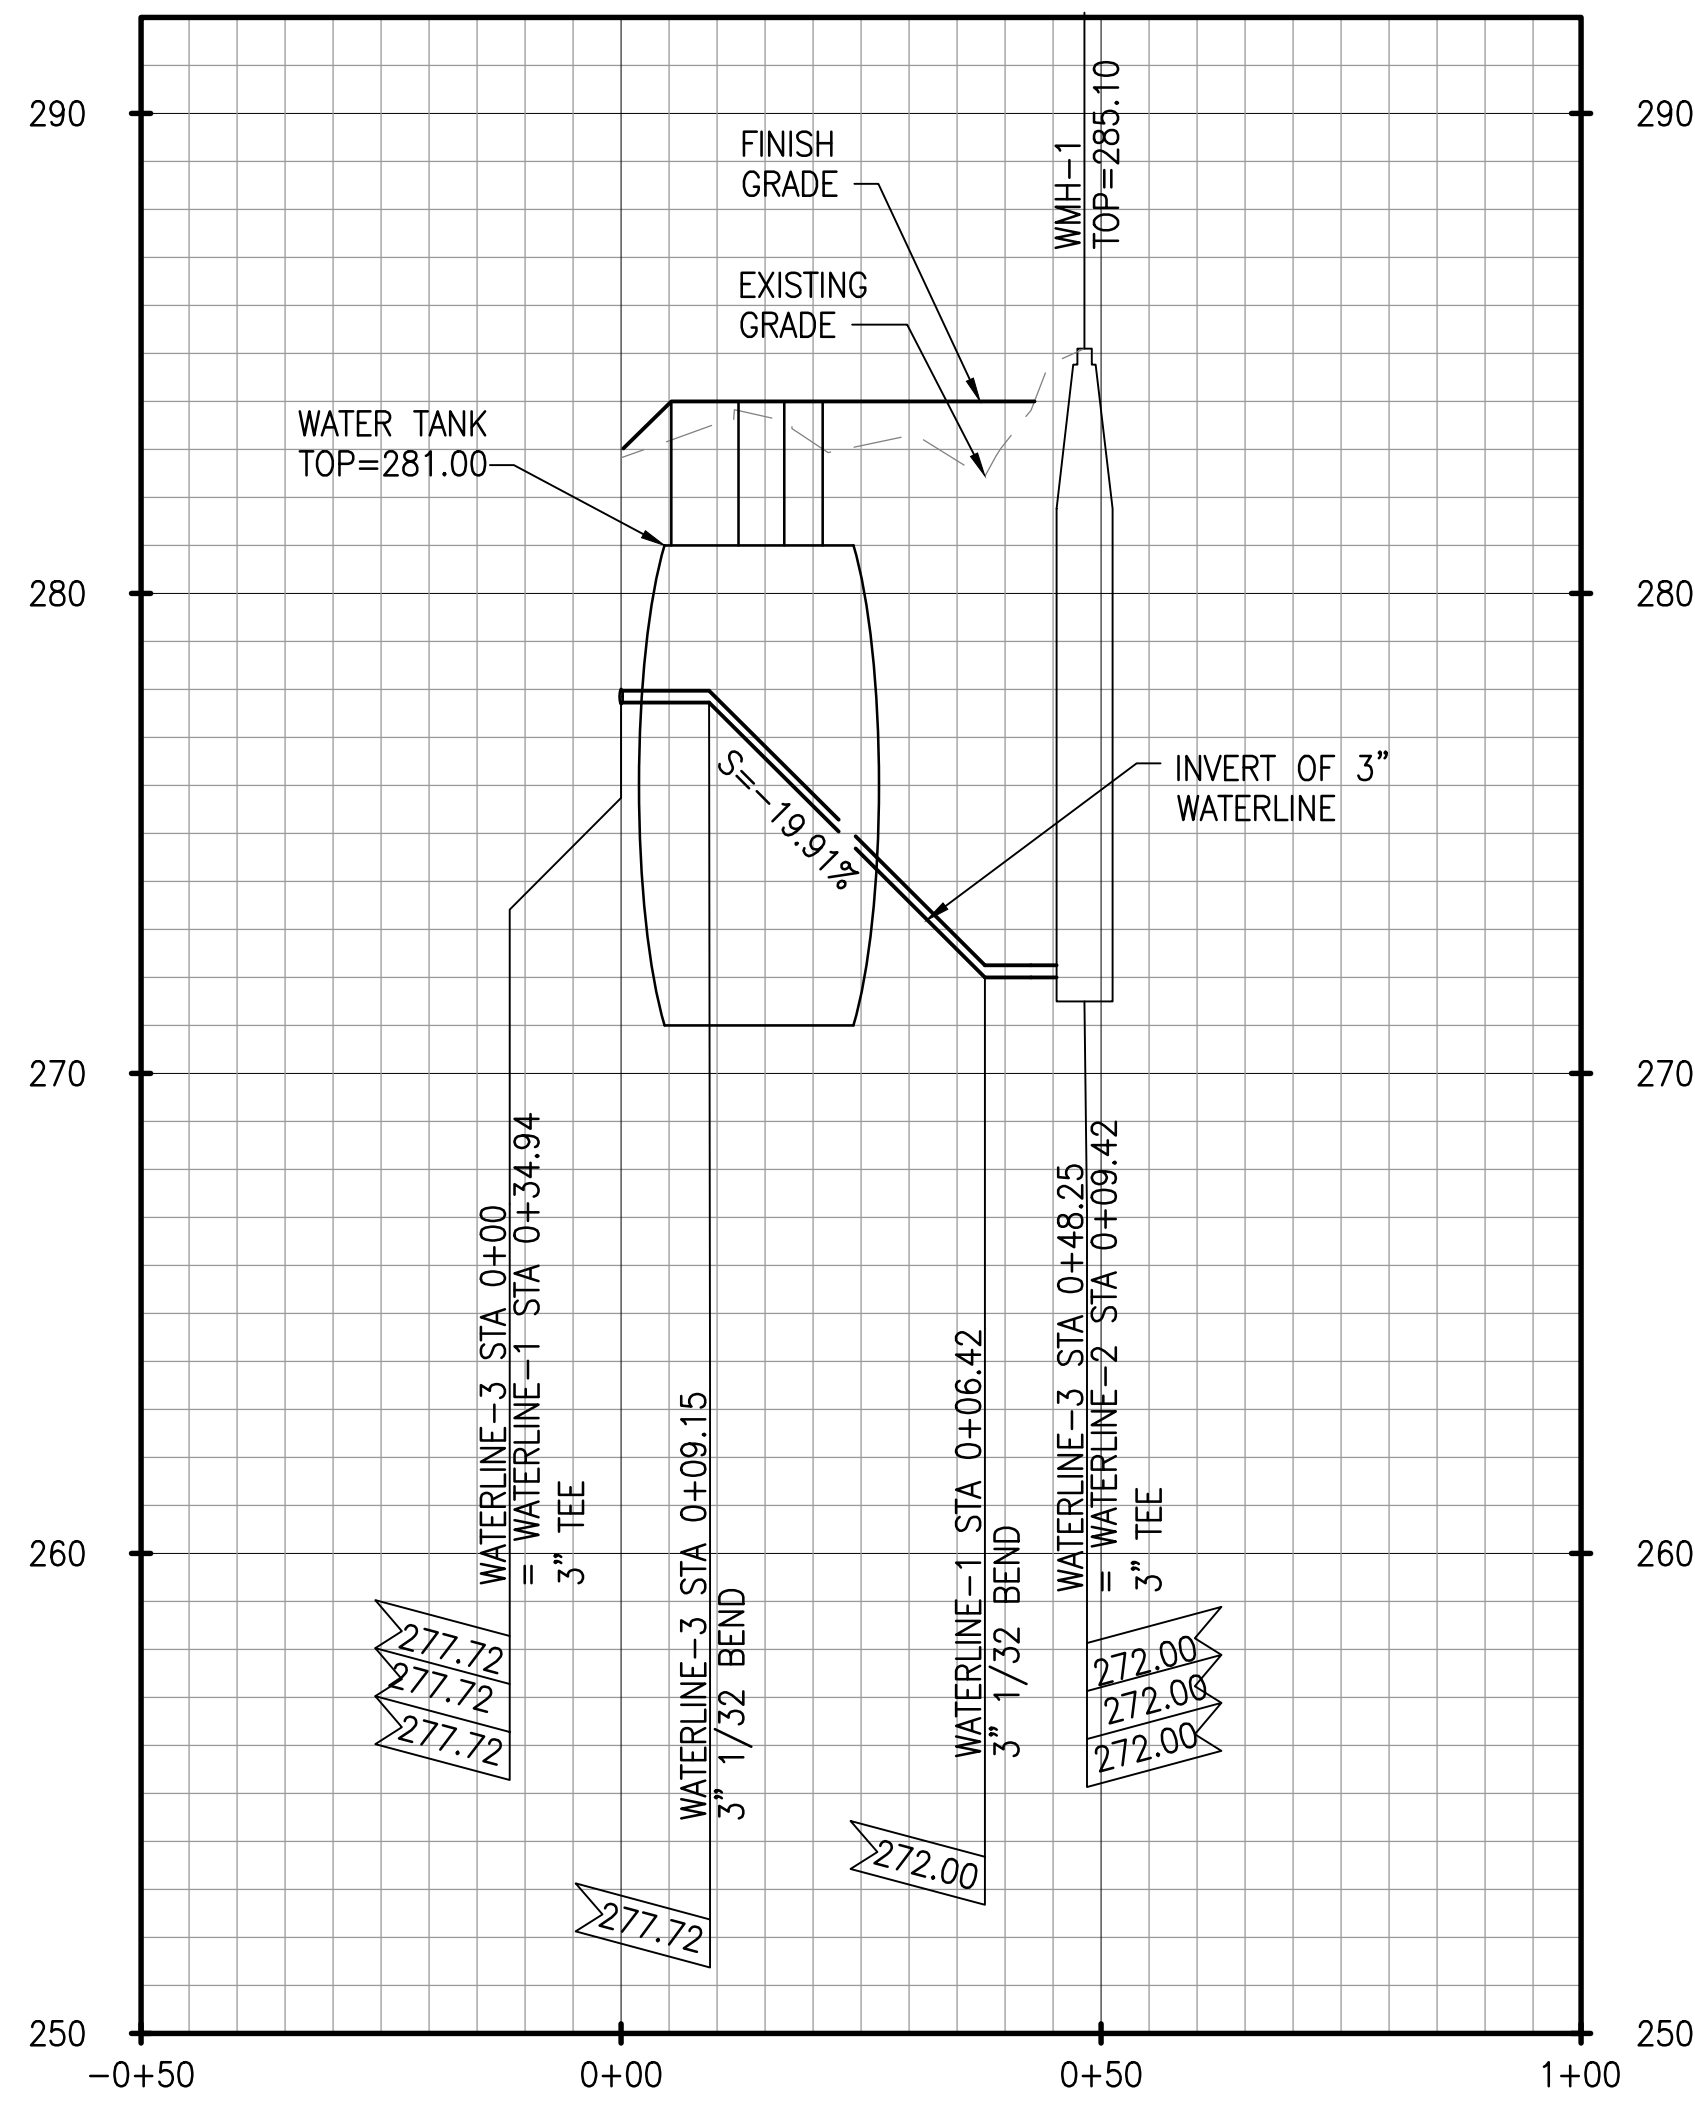


WATERLINE-3 PROFILE

SCALE: HORIZ 1" = 20'
VERT 1" = 4'

NOTES:

- PIPELINE BENDS LABELED FOR CLARITY AND ALIGNMENT CONTROL ONLY.
- PIPE BEND RADII SHALL NOT EXCEED THE MANUFACTURER'S MAXIMUM RECOMMENDATIONS.

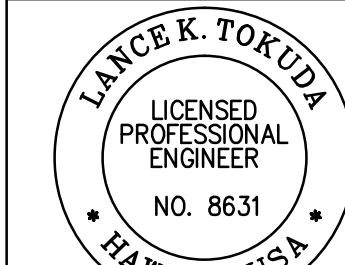

THIS WORK WAS PREPARED BY ME OR UNDER MY SUPERVISION
Signature: Lance K. Tokuda 4/30/2026
SIGNATURE EXPIRATION DATE


APPENDIX NO. 1	DATE	APPROVED	SYMBOL	DESCRIPTION
3/2/24				

SUBMITTAL PHASE
CONSTRUCTION DOCUMENTS
SUBMITTAL DATE 3/01/2024

STATE OF HAWAII	DIAMOND HEAD STATE MONUMENT	TMK: 3-1-042:006	4204 DIAMOND HEAD RD HONOLULU, HI 96816
BIRKHAMER EMERGENCY OPERATIONS CENTER (EOC) UPGRADES AND IMPROVEMENTS			WATERLINE PROFILE

SCALE: AS NOTED
STATE JOB NO. CA-202313-C
FEDERAL PROJECT NO. -
SHEET 20 OF 123
CU203

GRAPHIC SCALE:

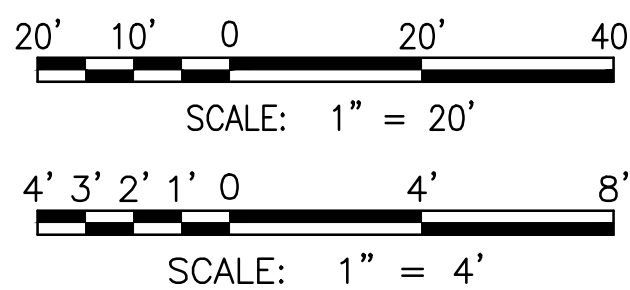

D

C

B

A



NOTES:

1. TYPE "SA" COVER IS USED WITH THIS FRAME.
2. APPROXIMATE WEIGHT = 156 POUNDS.






NOTES:

1. THIS COVER IS USED WITH THE TYPE SA FRAME.
2. APPROXIMATE WEIGHT = 158 POUNDS.
3. COVER SHALL CONFORM TO ASTM A48, CLASS NO. 30.



TYPE SE MANHOLE RUNGS
CAST IRON OR DUCTILE IRON

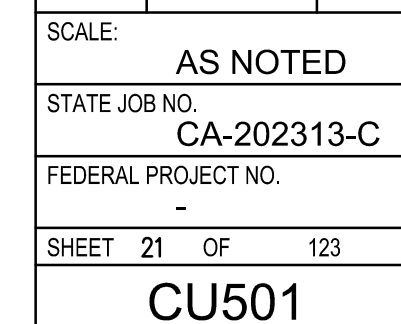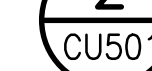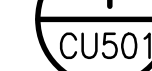


SLOPE %	MINIMUM SPACING (FT)
0-15	NO ANCHOR REQUESTED
15-35	35'
35-50	25'
> 50	BY DESIGN ENGINEER

PIPE DIA	"X" MIN. (FT)	"Y", MIN (FT)
6"-10"	5'	4'
12"-15"	6'	5'
> 15"	BY DESIGN ENGINEER	

1. CONCRETE GRAVITY PIPE ANCHOR BLOCK SHALL BE CONSTRUCTED USING FORMS WHEN SANITARY SEWERS, STORM DRAINS, AND OTHER PIPELINES ARE CONSTRUCTED WITH SLOPES OVER 18%. REMOVE FORMS PRIOR TO BACKFILLING TRENCH.
2. FOR PIPES LARGER THAN 18", ANCHOR BLOCK SHALL BE DESIGNED BY THE DESIGN ENGINEER.
3. ANCHOR BLOCK SHALL ALWAYS BE LOCATED ALONG THE BARREL OF THE PIPE AND NOT AT THE JOINT.
4. INSTALL ONE 3" PVC NON-PERFORATED DRAIN PIPE AT BOTTOM OF TRENCH SECTION DOWN THE SLOPE. ALTERNATE 3" DRAIN ON EACH SIDE OF TRENCH SECTION AND DAYLIGHT TO DRAIN. INSTALL 1/4" STAINLESS STEEL MESH SCREEN USING STAINLESS STEEL HOSE CLAMPS OVER UPSTREAM END.




1 TYPICAL GRAVITY PIPE ANCHOR BLOCK DETAIL
CU502 NOT TO SCALE

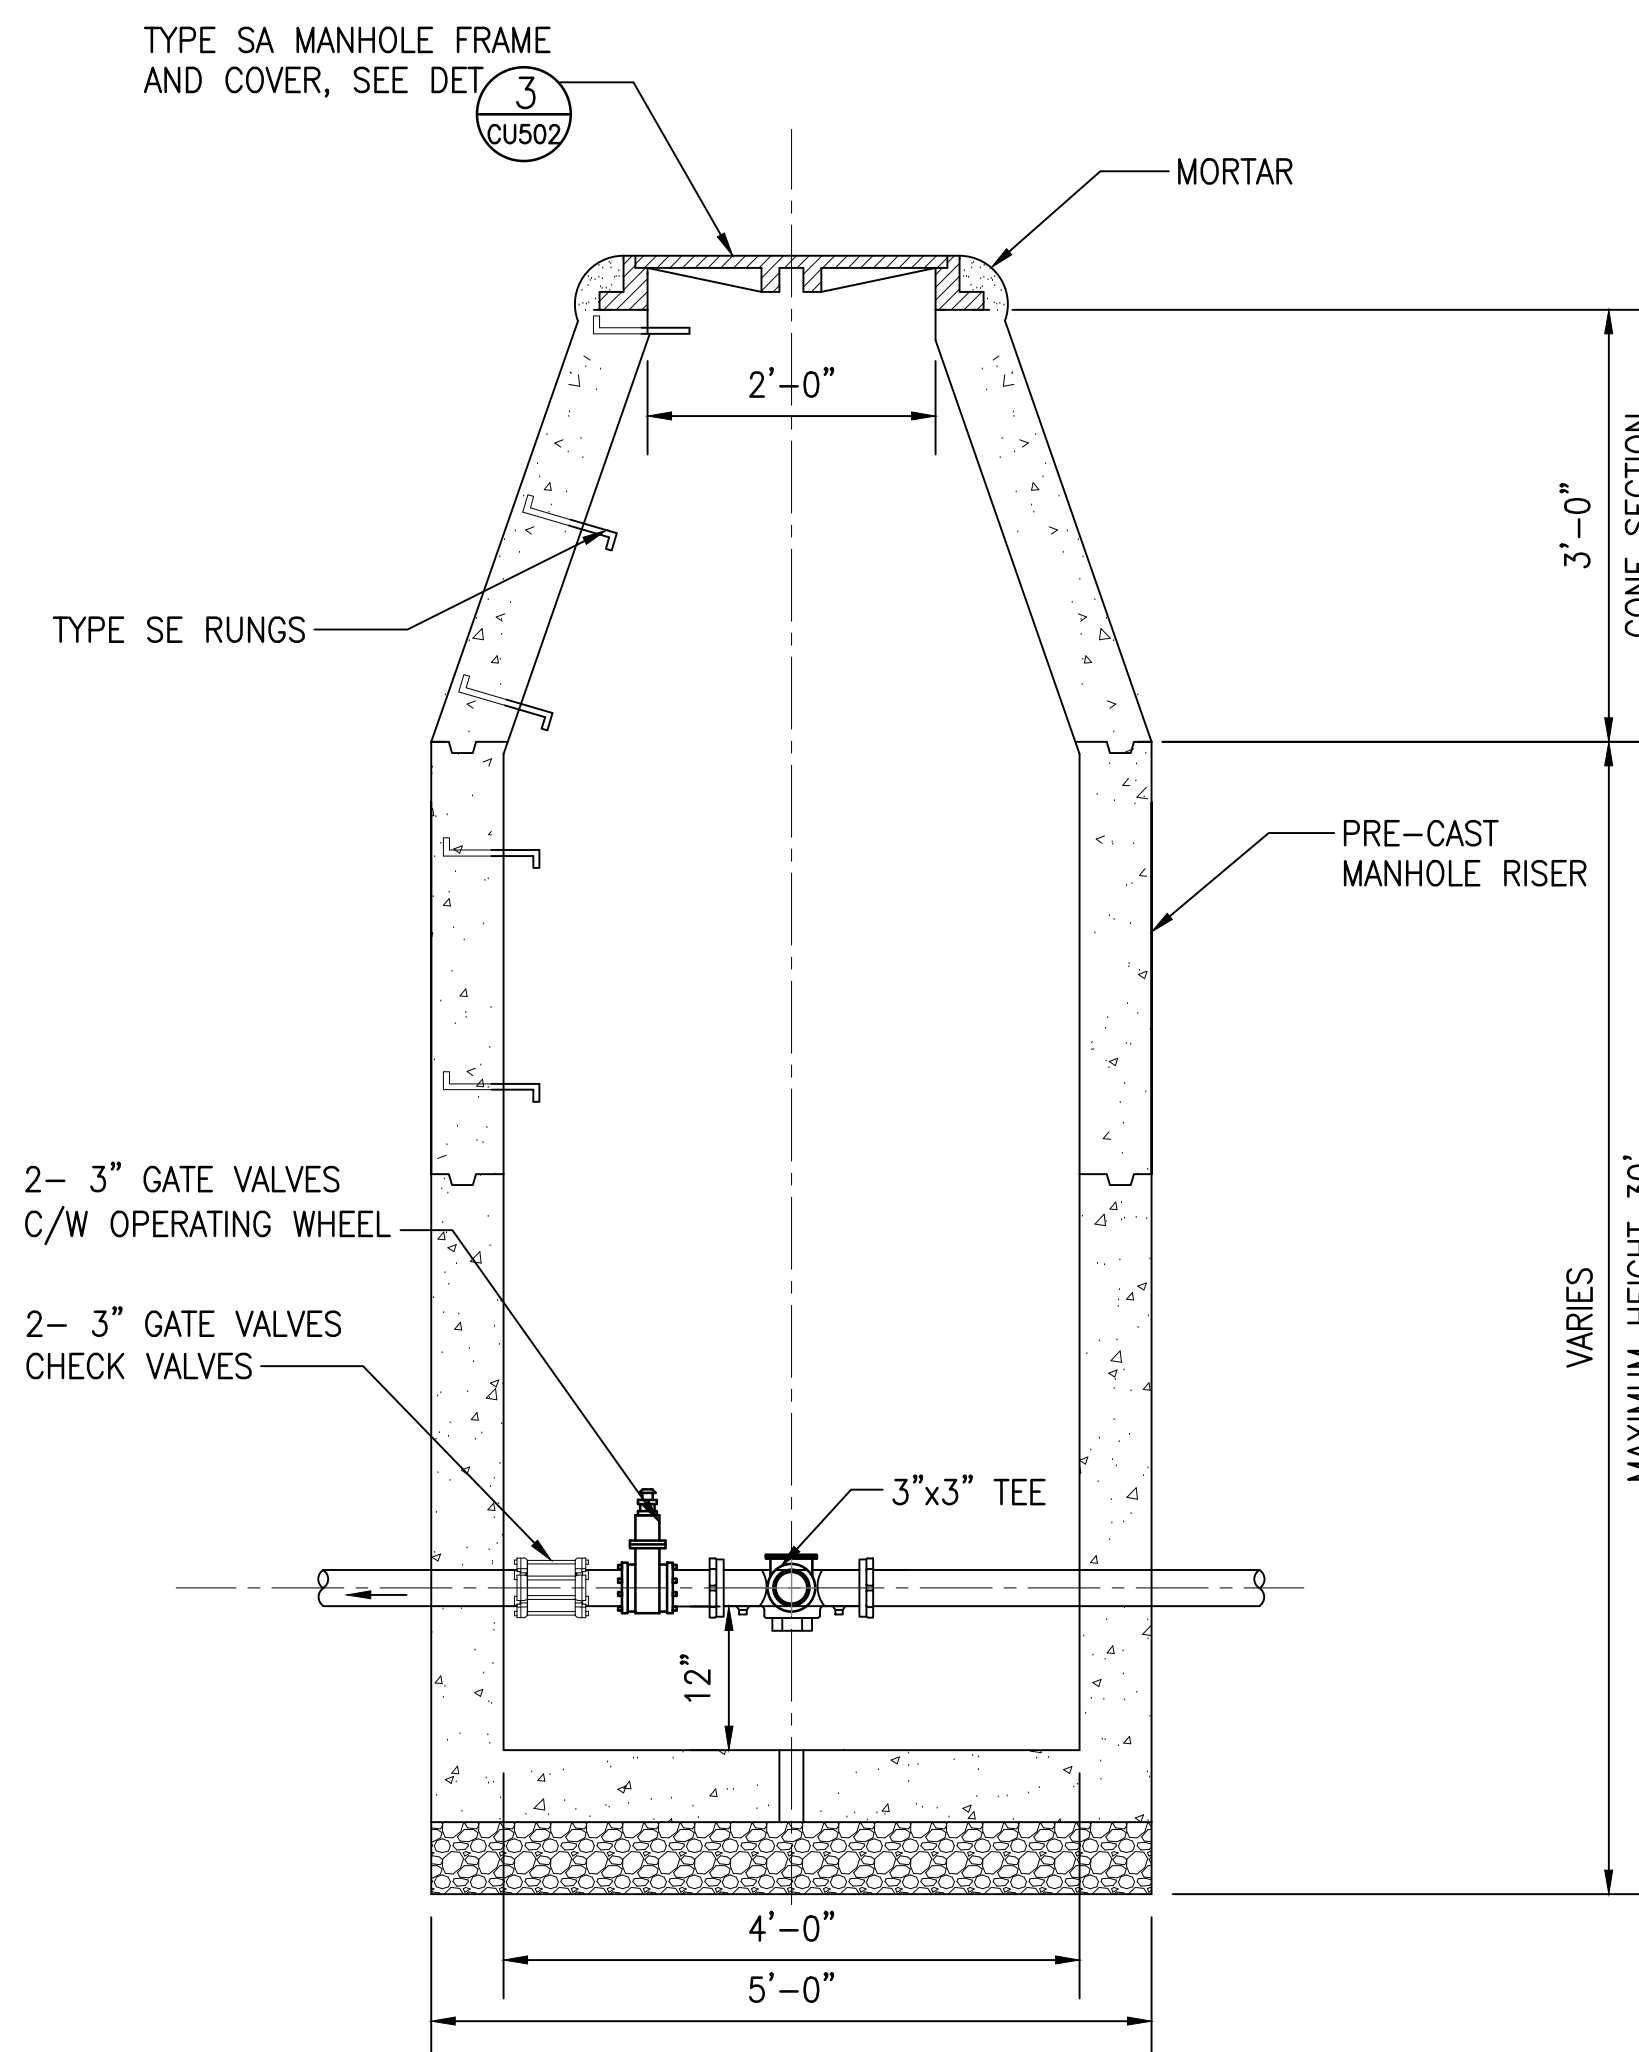

SECTION A-A


2 WATER MANHOLE DETAIL
CU502 NOT TO SCALE

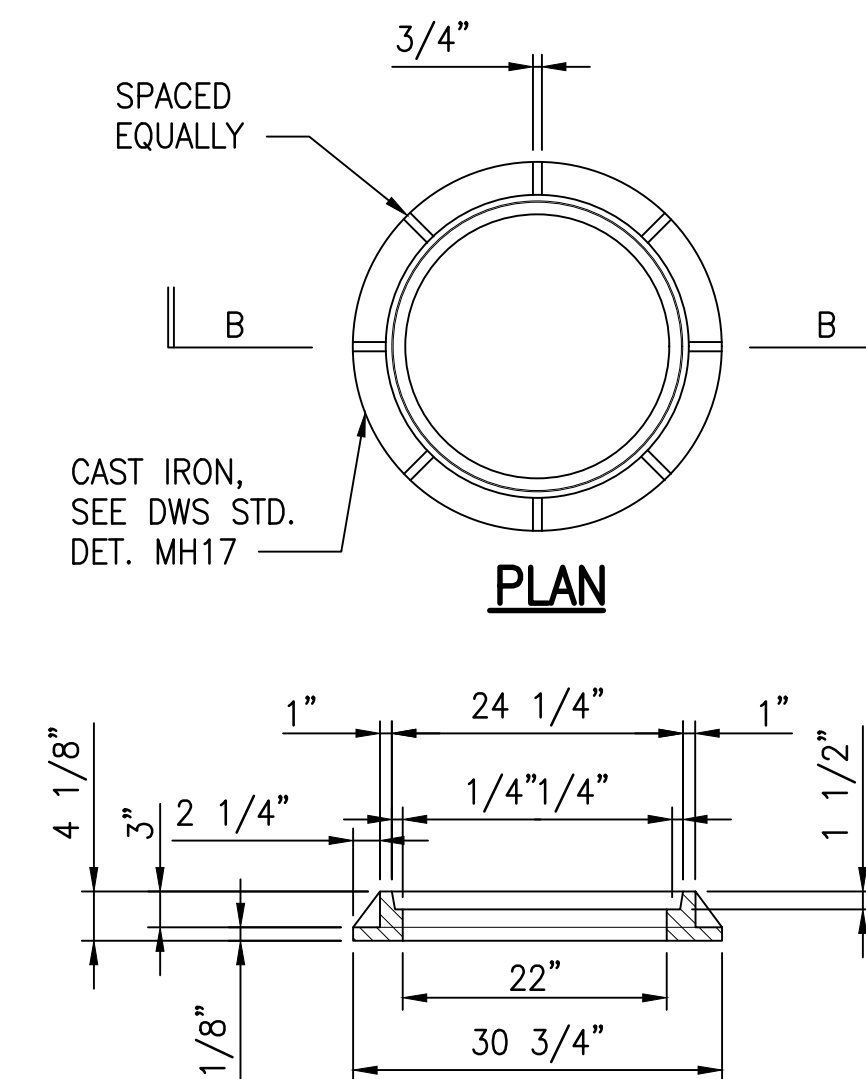

SECTION B-B

2. MANHOLE COVER SHALL BE H-20 RATED.

3 MANHOLE FRAME AND COVER
CU502 NOT TO SCALE

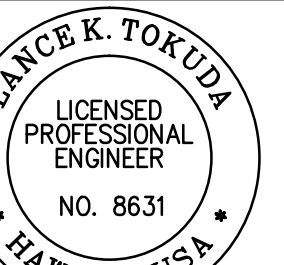



THIS WORK WAS PREPARED BY ME
UNDER MY SUPERVISION
(Signature) 4/30/2026
SIGNATURE EXPIRATION DATE

[illegible]

SUBMITTAL PHASE
CONSTRUCTION
DOCUMENTS
SUBMITTAL DATE 3/01/2024

DIAMOND HEAD STATE MONUMENT	4204 DIAMOND HEAD RD HONOLULU, HI 96816	TMK: 3-1-042-006
BIRKHIEMER EMERGENCY OPERATIONS CENTER (EOC) UPGRADES AND IMPROVEMENTS		
WATER DETAILS		

SCALE:			
AS NOTED			
STATE JOB NO.			
CA-202313-C			
FEDERAL PROJECT NO.			
-			
SHEET	22	OF	123
CU502			

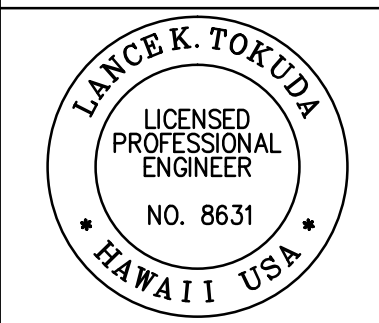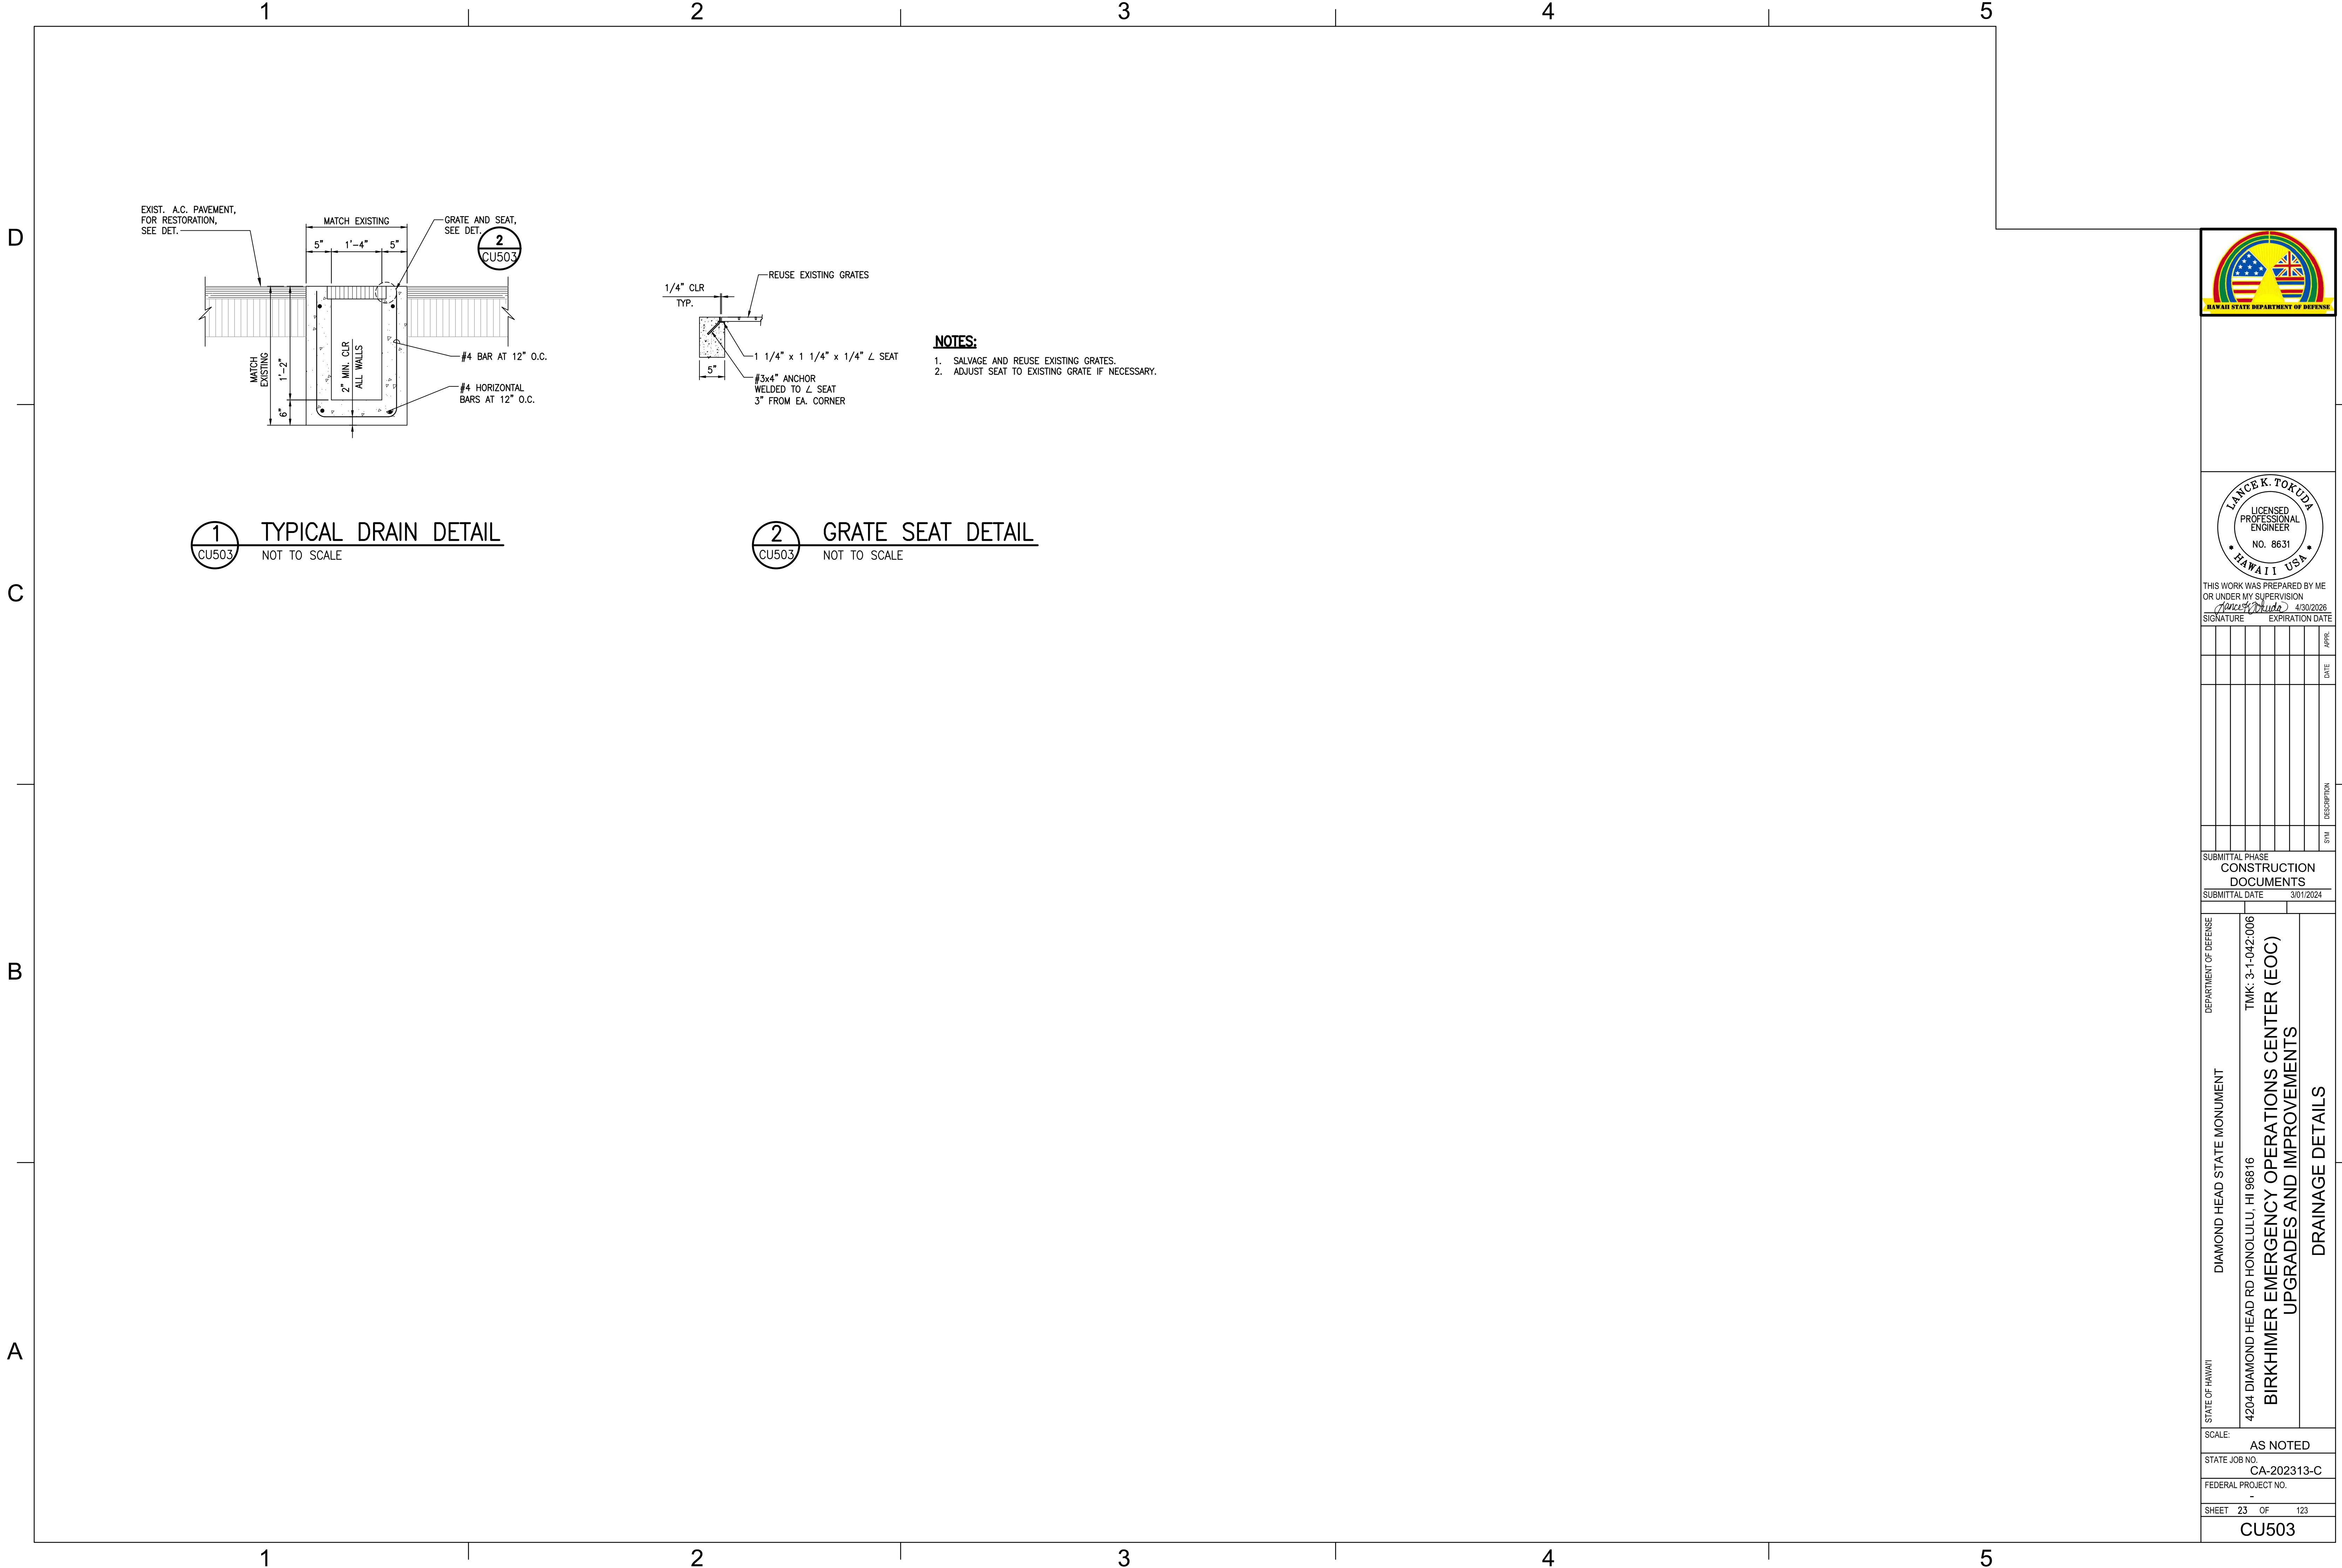

THIS WORK WAS PREPARED BY ME
OR UNDER MY SUPERVISION
Lance K. Tokuda 4/30/2026
SIGNATURE EXPIRATION DATE

										APPR.
										DATE
										DESCRIPTION
										SYM

SUBMITTAL PHASE
CONSTRUCTION DOCUMENTS
SUBMITTAL DATE 3/01/2024

STATE OF HAWAII	DEPARTMENT OF DEFENSE	DIAMOND HEAD STATE MONUMENT	4204 DIAMOND HEAD RD HONOLULU, HI 96816	TMK: 3-1-042:006	BIRKHIMER EMERGENCY OPERATIONS CENTER (EOC) UPGRADES AND IMPROVEMENTS DRAINAGE DETAILS

SCALE:	AS NOTED
STATE JOB NO.	CA-202313-C
FEDERAL PROJECT NO.	-
SHEET 23 OF 123	
CU503	





BUILDING 303 EXISTING FLOOR PLAN
SCALE: 1/8" = 1'-0"

SPALL DESIGNATIONS NOTES:

1. WALL CORNER SPALL (CS): L x W x H
2. WALL VERTICAL SPALL (VS): L x W
3. DIMENSIONS SHOWN IN INCHES

GRAPHIC SCALE:

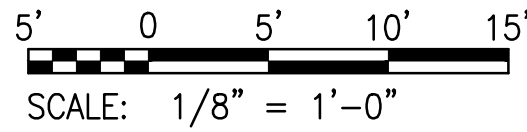



HAWAII STATE DEPARTMENT OF DEFENSE

JOHN UNO
LICENSED PROFESSIONAL ENGINEER
No. 13255-S
HAWAII, U.S.A.

THIS WORK WAS PREPARED BY ME OR UNDER MY SUPERVISION
4/30/2026
SIGNATURE: [Signature] EXPIRATION DATE: [Date]

APPROVAL NO.	DATE	SYN	DESCRIPTION
1	3/2/24		

DEPARTMENT OF DEFENSE

DIAMOND HEAD STATE MONUMENT

4204 DIAMOND HEAD RD HONOLULU, HI 96816

TWK: 3-1-042:006

BIRKHIMER EMERGENCY OPERATIONS CENTER (EOC) UPGRADES AND IMPROVEMENTS

BUILDING 303 EXISTING FLOOR PLAN


SCALE: AS NOTED


STATE JOB NO. CA-202313-C

FEDERAL PROJECT NO. -

SHEET OF 123


S-101

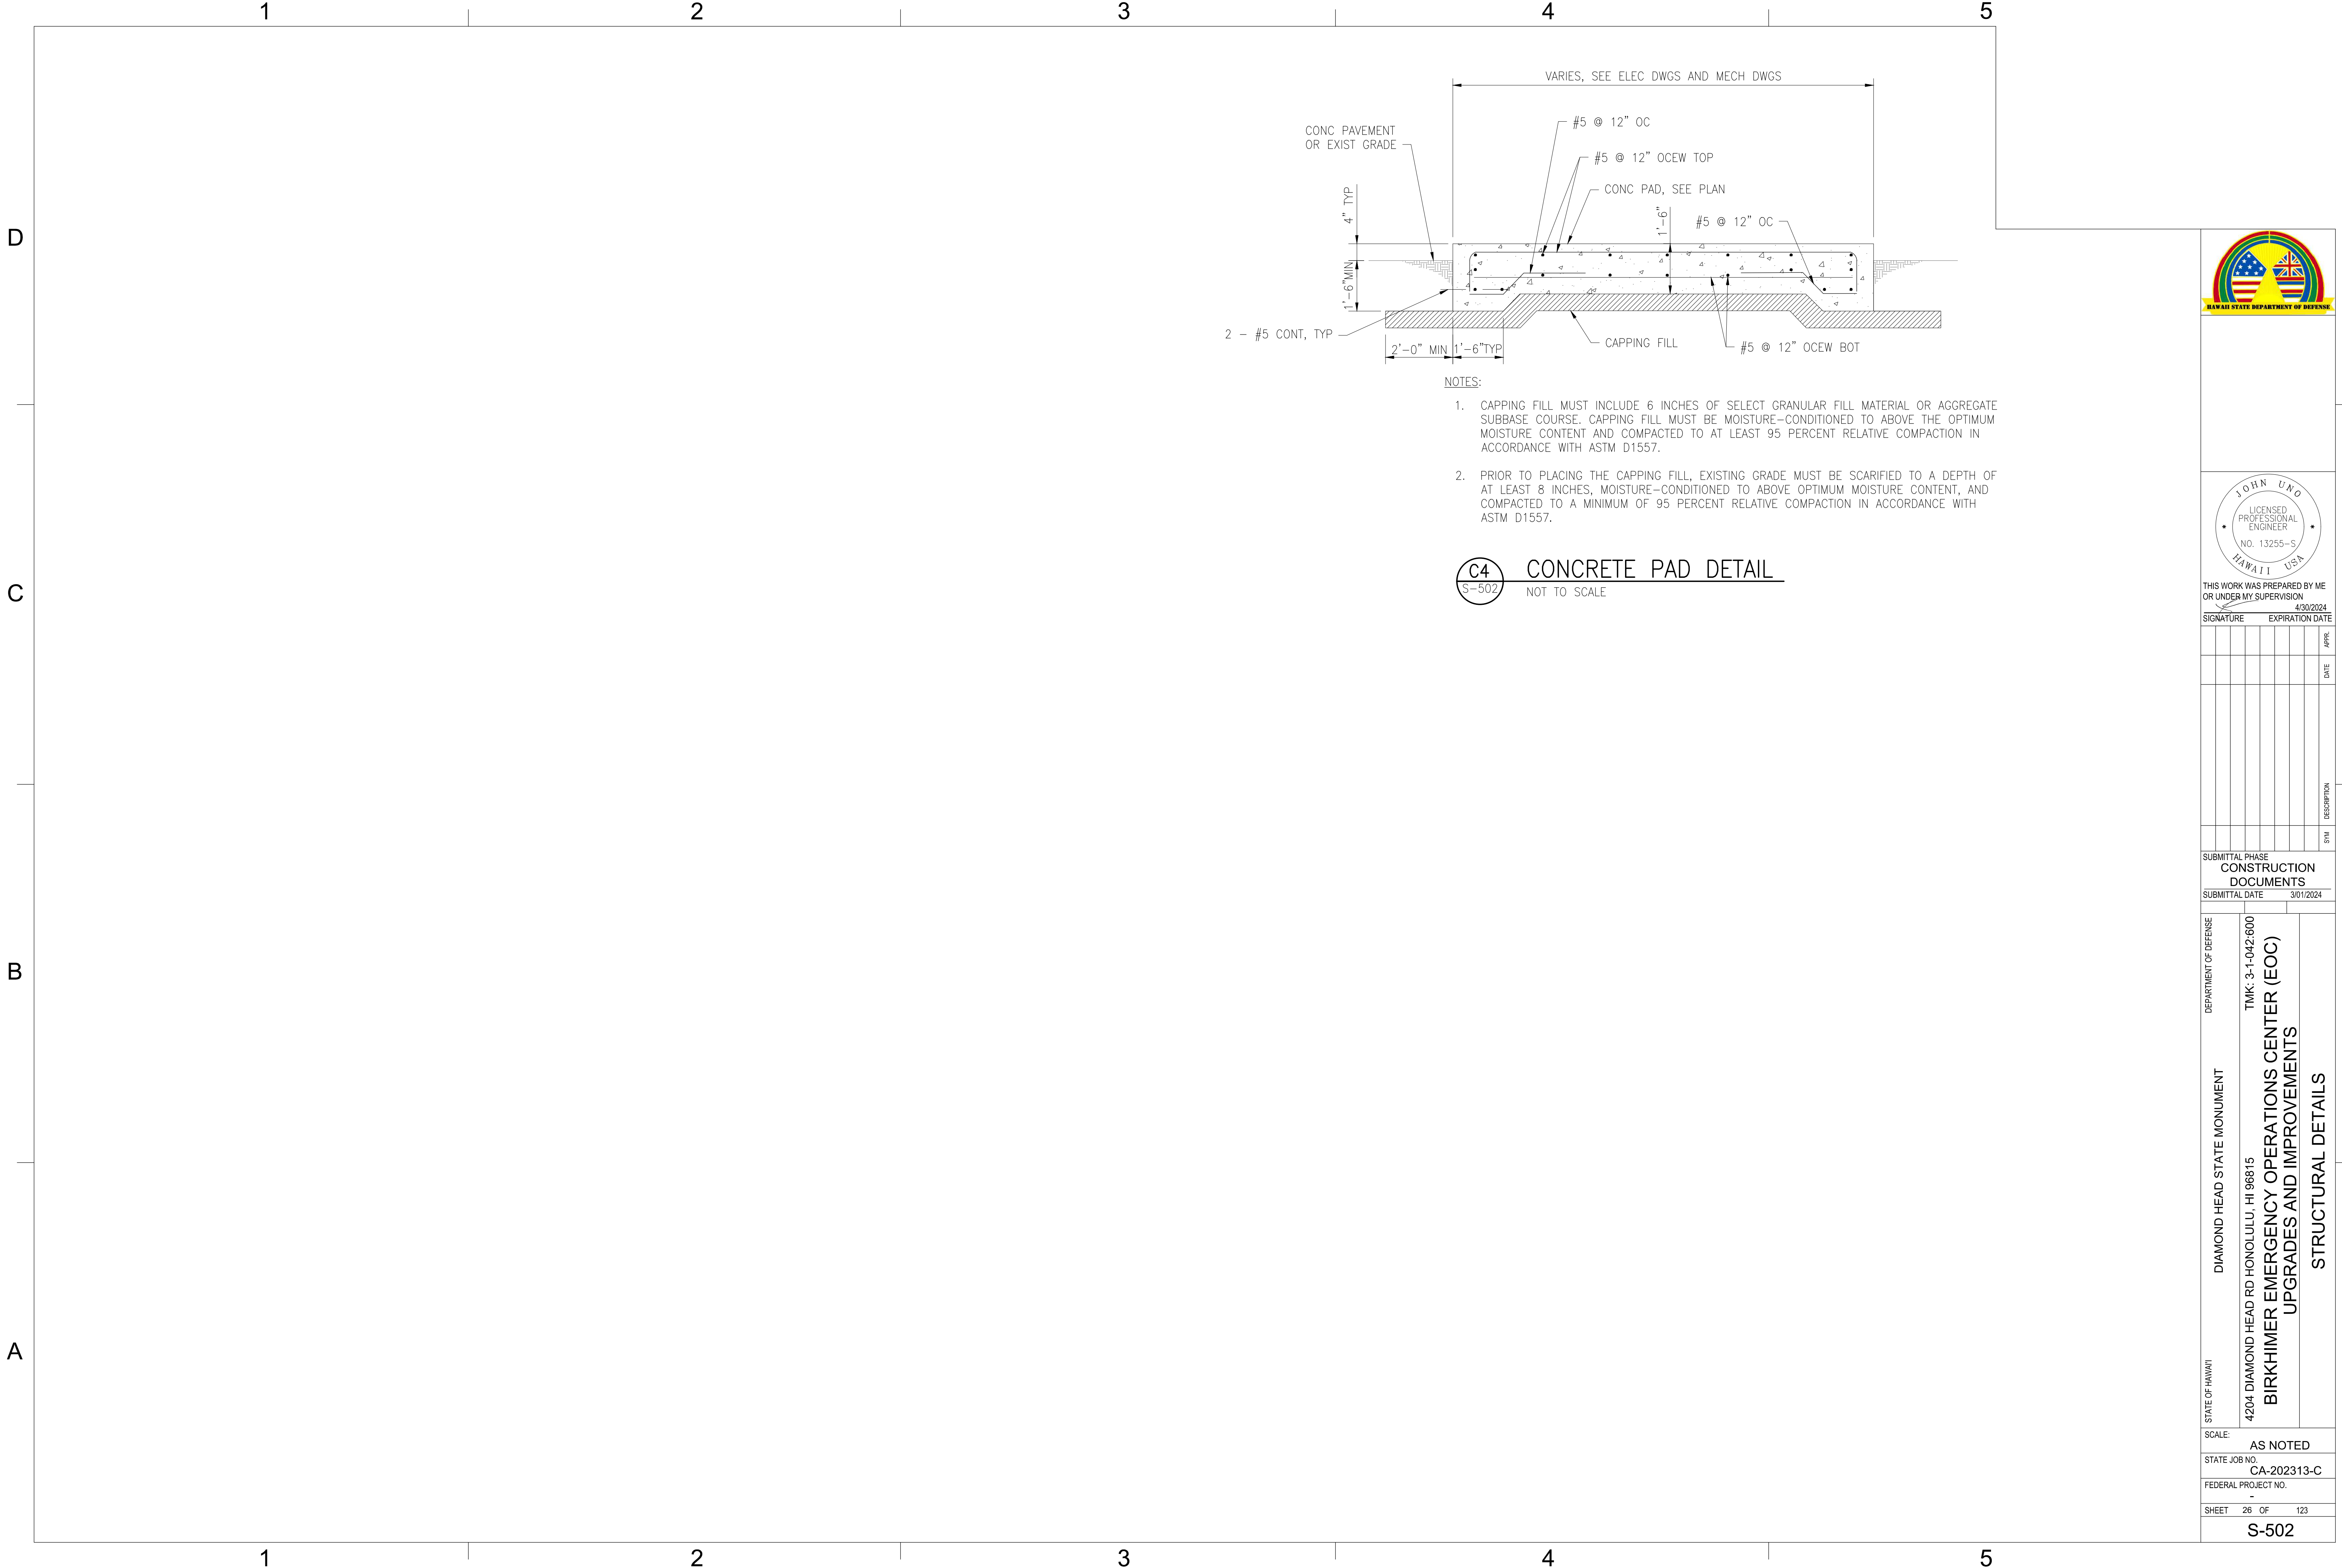

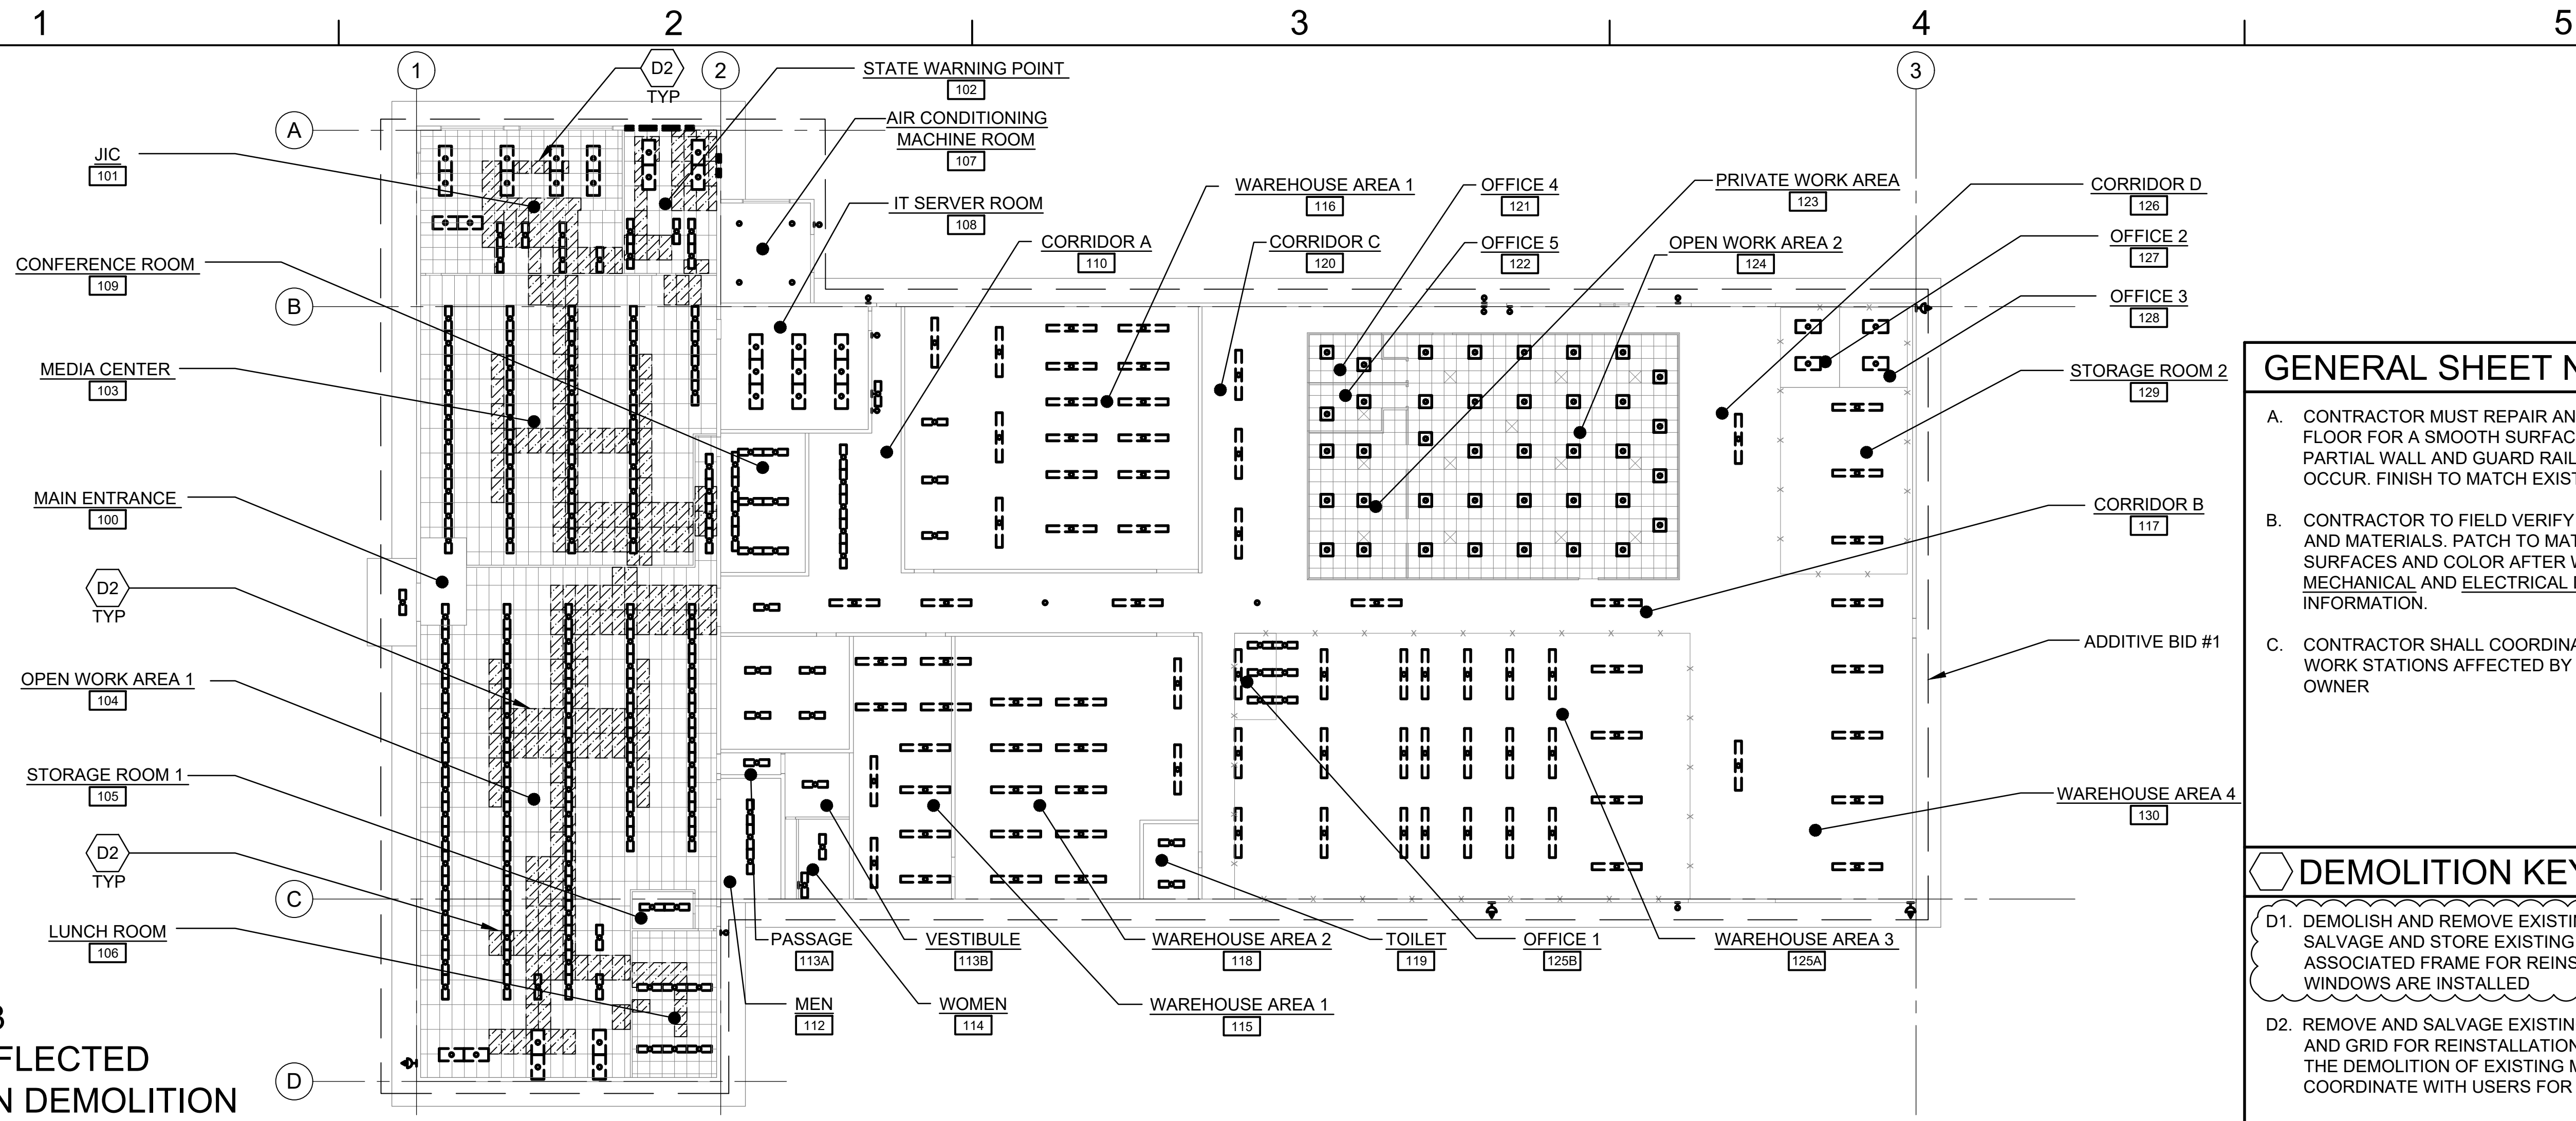

**BUILDING 303
OVERALL REFLECTED
CEILING PLAN DEMOLITION**

2
AA101 SCALE: 1/16" = 1'-0"

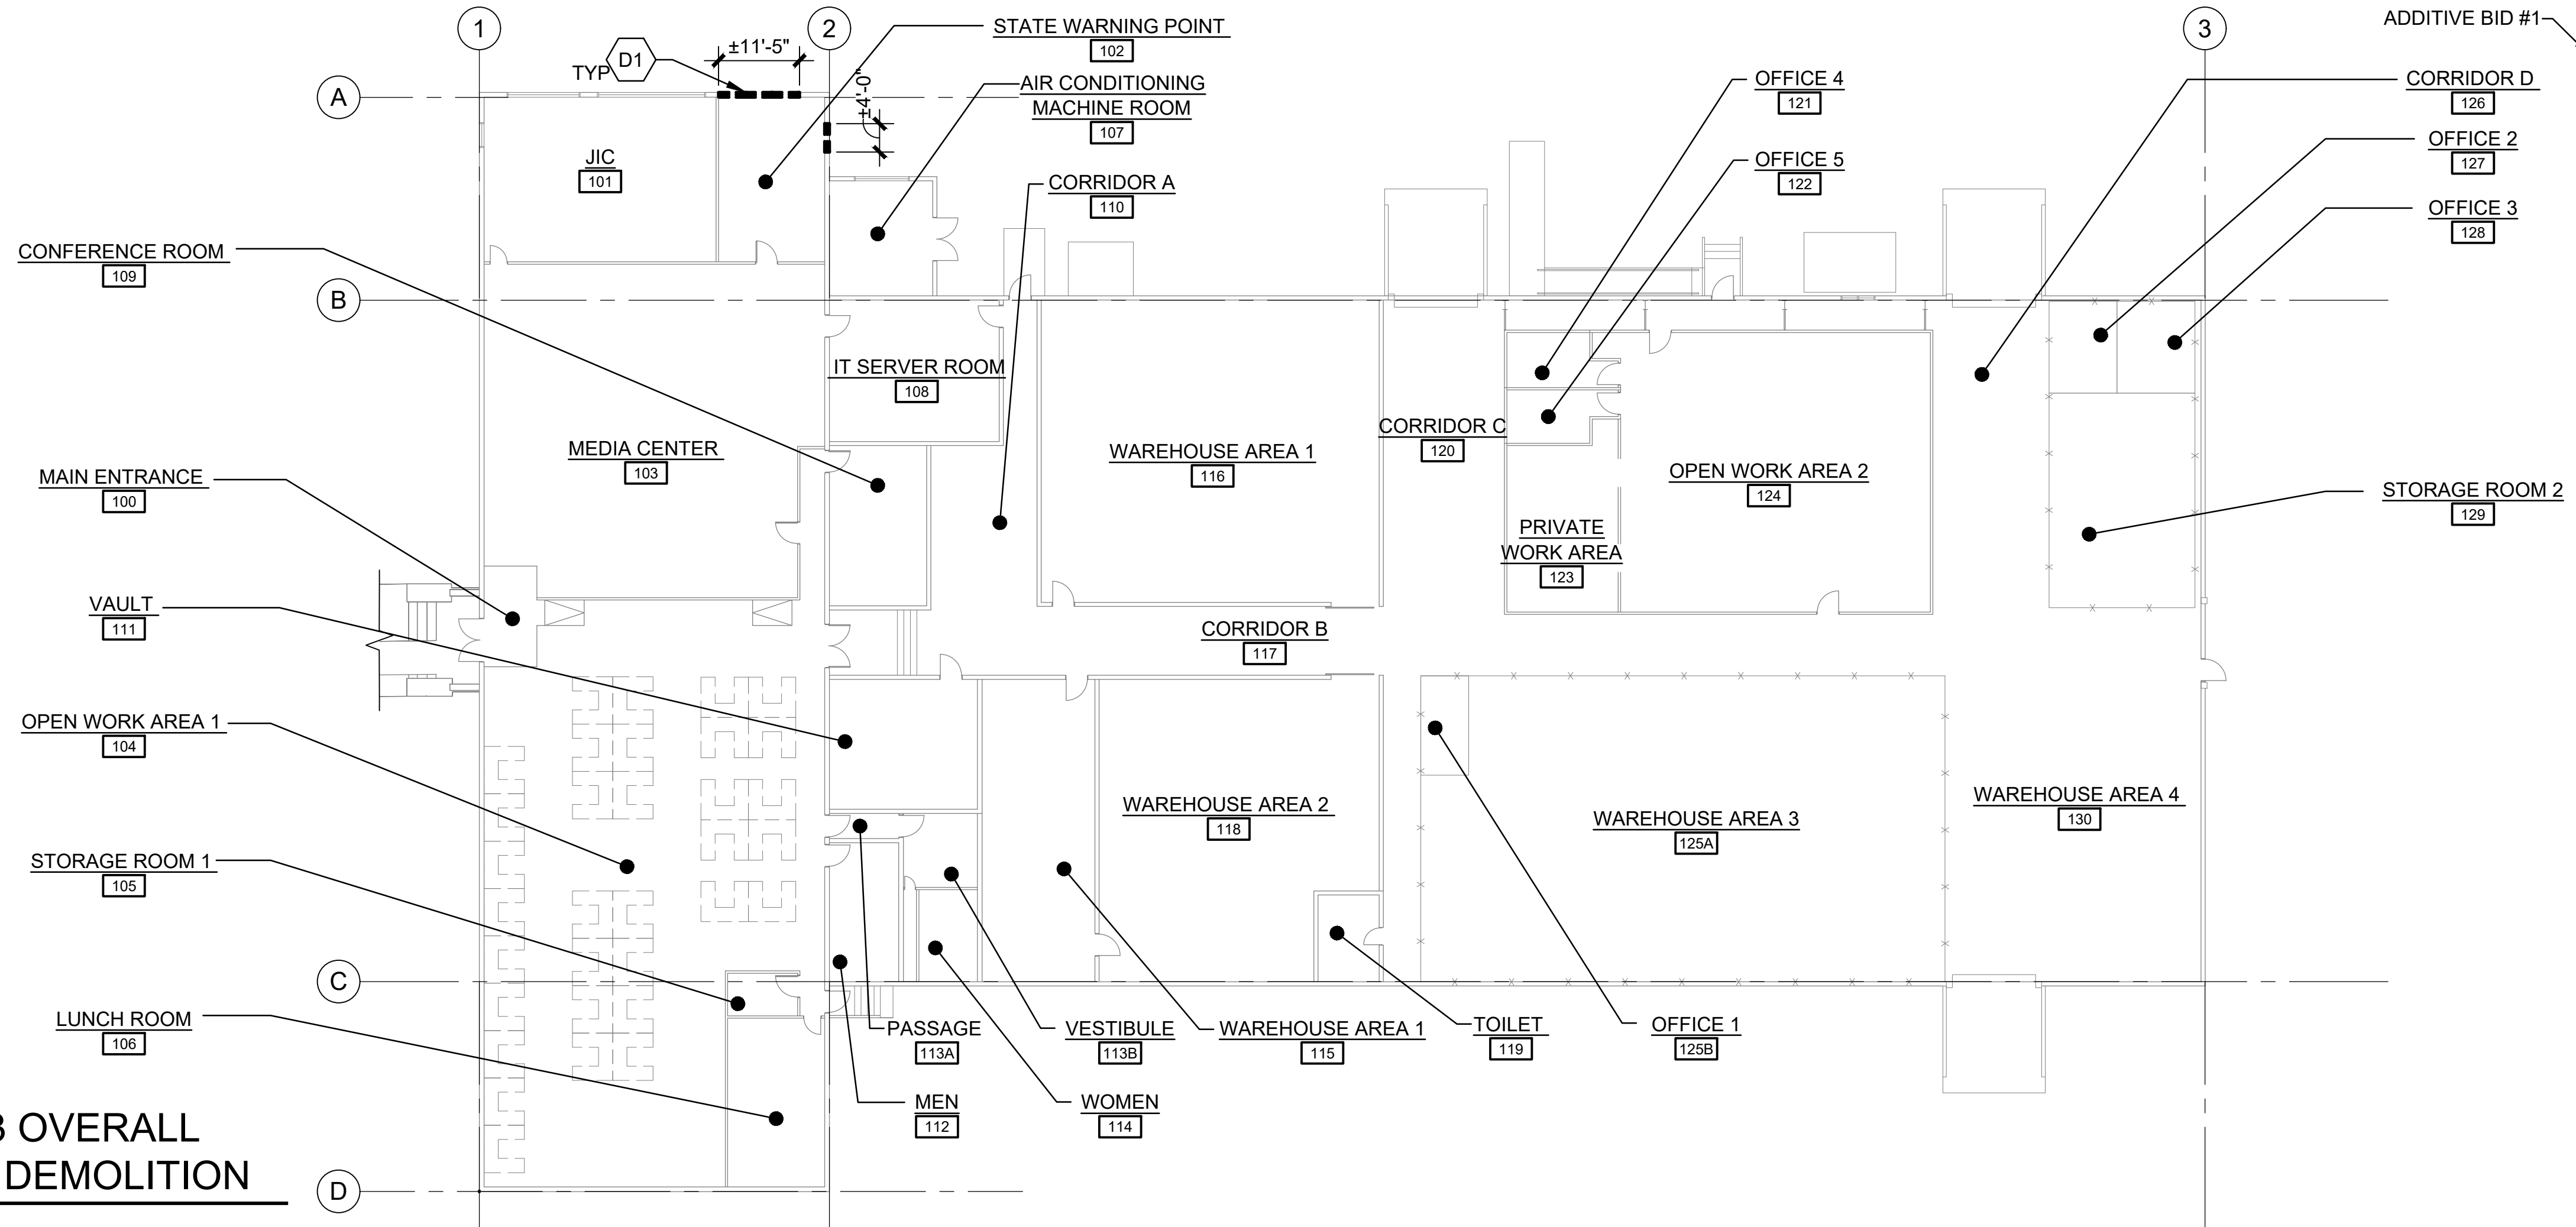

**BUILDING 303 OVERALL
FLOOR PLAN DEMOLITION**

1
AA101 SCALE: 1/16" = 1'-0"

- ### GENERAL SHEET NOTES
- A. CONTRACTOR MUST REPAIR AND PATCH EXISTING WALL AND FLOOR FOR A SMOOTH SURFACE WHERE DOOR ASSEMBLY, PARTIAL WALL AND GUARD RAIL DEMOLITION / REMOVALS OCCUR. FINISH TO MATCH EXISTING ADJACENT SURFACES.
 - B. CONTRACTOR TO FIELD VERIFY EXISTING CEILING CONDITIONS AND MATERIALS. PATCH TO MATCH EXISTING ADJACENT SURFACES AND COLOR AFTER WORK IS COMPLETED. SEE MECHANICAL AND ELECTRICAL DRAWINGS FOR ADDITIONAL INFORMATION.
 - C. CONTRACTOR SHALL COORDINATE RELOCATION OF EXISTING WORK STATIONS AFFECTED BY THE IMPROVEMENTS WITH OWNER

- ### DEMOLITION KEYNOTES (FOR THIS SHT ONLY)
- D1. DEMOLISH AND REMOVE EXISTING WINDOW, COMPLETE. SALVAGE AND STORE EXISTING WINDOW SCREEN AND ASSOCIATED FRAME FOR REINSTALLATION AFTER NEW WINDOWS ARE INSTALLED
 - D2. REMOVE AND SALVAGE EXISTING ACOUSTICAL CEILING TILE AND GRID FOR REINSTALLATION, AS NEEDED, TO FACILITATE THE DEMOLITION OF EXISTING MECHANICAL EQUIPMENT. COORDINATE WITH USERS FOR STORAGE LOCATION

- ### LEGEND
- DEMO AND REMOVE LIGHT FIXTURES, SEE ELEC DWGS
 - EXISTING CHAIN LINK FENCE
 - EXISTING DOOR
 - EXISTING WINDOW TO REMAIN
 - DEMO AND REMOVE WINDOW
 - EXISTING WORK STATION, SEE GENERAL NOTE C
 - EXISTING ACOUSTICAL CEILING TILE TO REMAIN
 - REMOVE AND SALVAGE ACOUSTICAL CEILING TILE AND GRID SYSTEM FOR REINSTALLATION


IECC STAMP

CITY AND COUNTY OF HONOLULU
REVISED ORDINANCES OF HONOLULU 1990
CHAPTER 32,

TO THE BEST OF MY KNOWLEDGE, THIS PROJECT'S DESIGN SUBSTANTIALLY CONFORMS TO THE BUILDING ENERGY CONSERVATION CODE FOR:

☒ BUILDING COMPONENT SYSTEMS
☐ ELECTRICAL COMPONENT SYSTEMS
☐ MECHANICAL COMPONENT SYSTEMS

SIGNATURE: DATE: MAR 2024
NAME: SCOTT RJ HARADA, AIA
TITLE: PRINCIPAL
LICENSE NO.: AR-14637

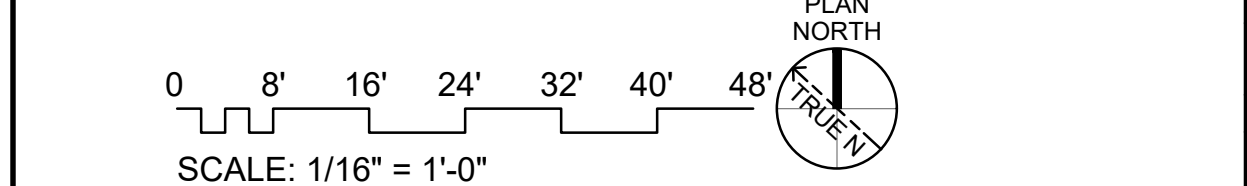


THIS WORK WAS PREPARED BY ME OR UNDER MY SUPERVISION
4/30/2026
SIGNATURE: _____ EXPIRATION DATE: _____
DATE: _____
SYN: _____
DESCRIPTION: _____

ADDENDUM	1
1	


DEPARTMENT OF DEFENSE
DIAMOND HEAD STATE MONUMENT
STATE OF HAWAII
4204 DIAMOND HEAD RD HONOLULU, HI 96816
BIRKHAMER EMERGENCY OPERATIONS CENTER (EOC) UPGRADES AND IMPROVEMENTS
OVERALL FLOOR AND CEILING DEMOLITION

AS NOTED
CA-202313-C
FEDERAL PROJECT NO. -
SHEET 27 OF 123
AA101

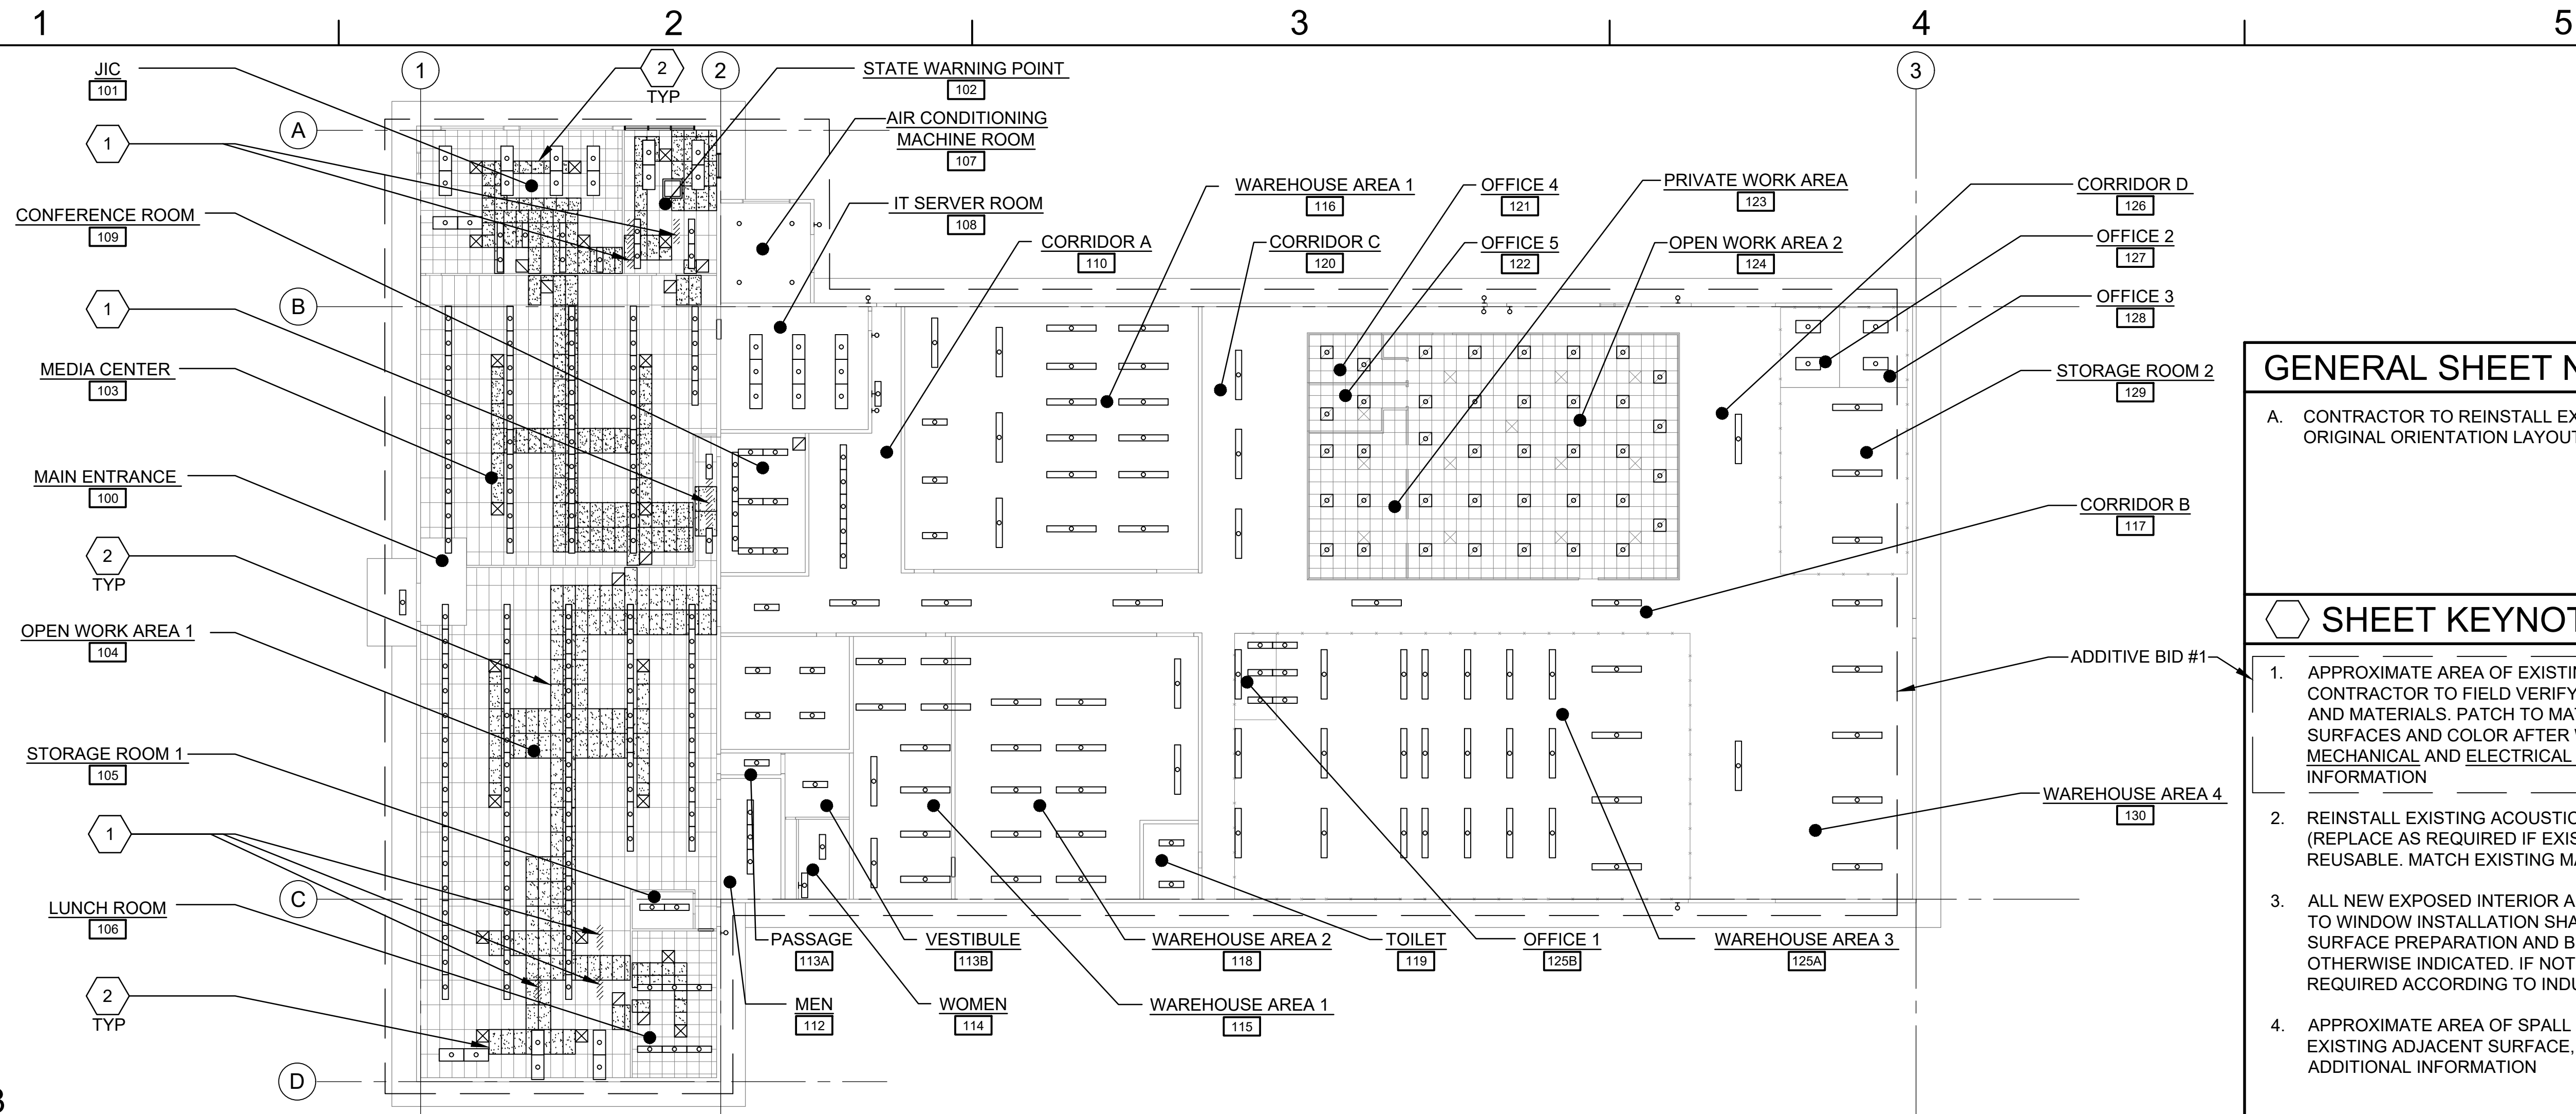

BUILDING 303
OVERALL REFLECTED CEILING PLAN

2
AA102 SCALE: 1/16" = 1'-0"

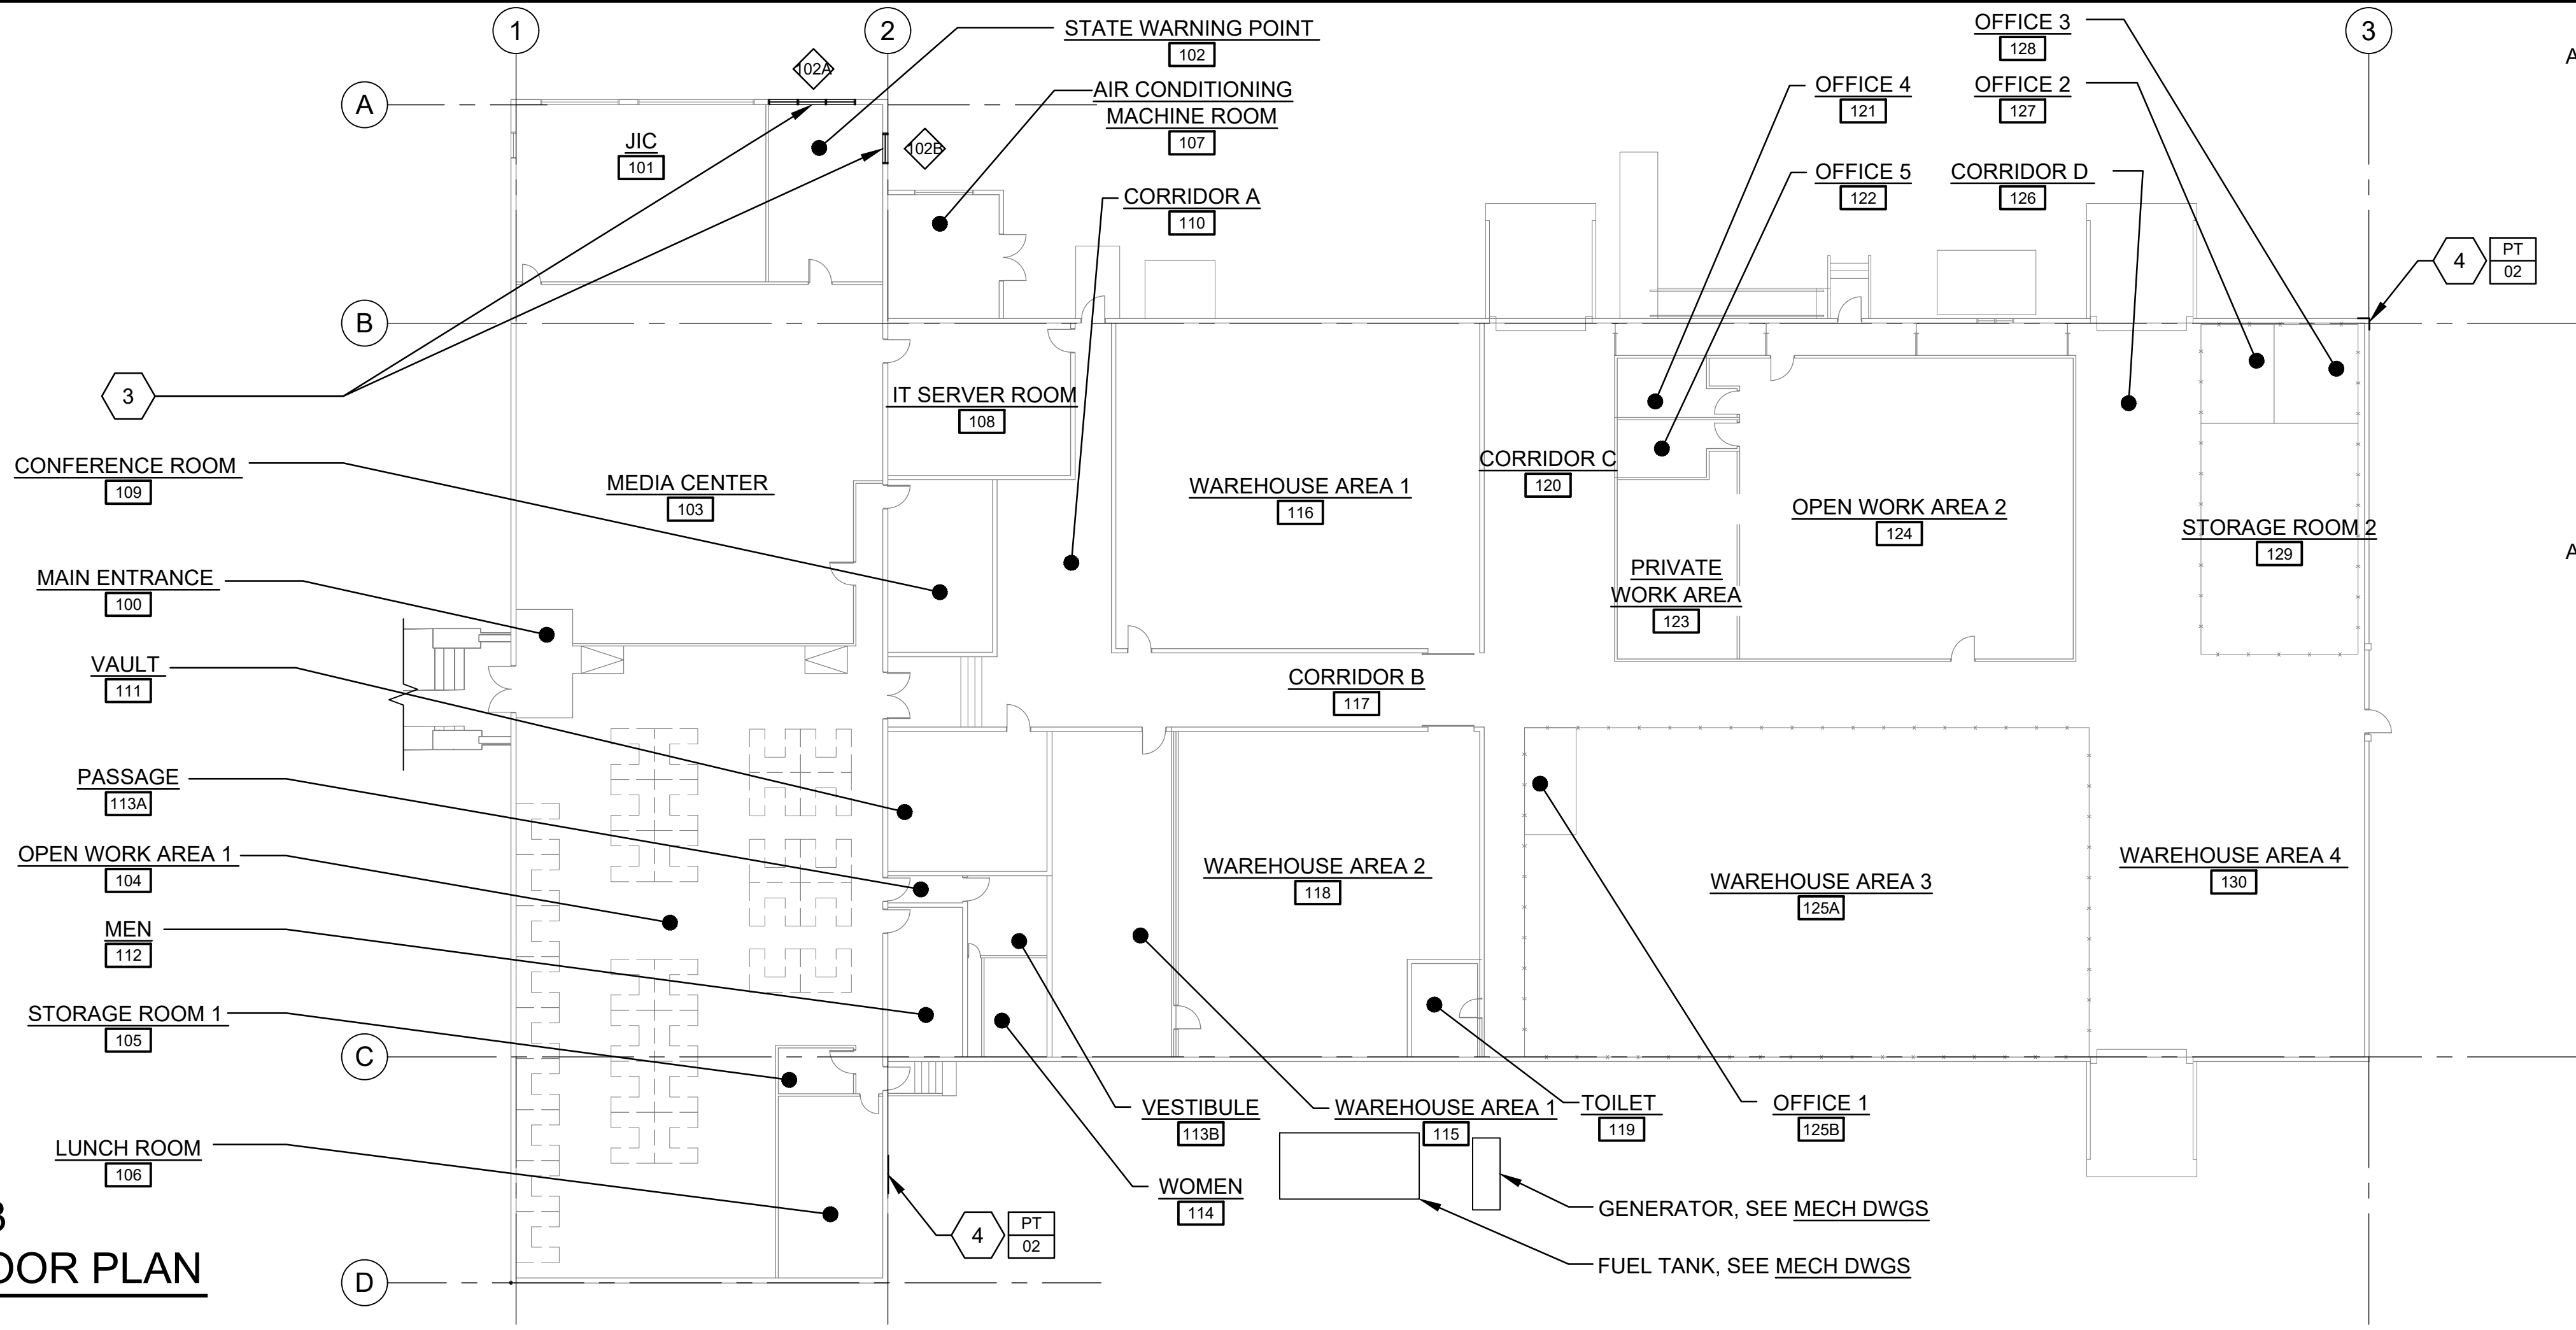

BUILDING 303
OVERALL FLOOR PLAN

1
AA102 SCALE: 1/16" = 1'-0"

GENERAL SHEET NOTES

- A. CONTRACTOR TO REINSTALL EXISTING WORK STATIONS TO ORIGINAL ORIENTATION LAYOUTS AND LOCATIONS

SHEET KEYNOTES (FOR THIS SHT ONLY)

1. APPROXIMATE AREA OF EXISTING CEILING TO BE PATCHED. CONTRACTOR TO FIELD VERIFY EXISTING CEILING CONDITION AND MATERIALS. PATCH TO MATCH EXISTING ADJACENT SURFACES AND COLOR AFTER WORK IS COMPLETED. SEE MECHANICAL AND ELECTRICAL DRAWINGS FOR ADDITIONAL INFORMATION
2. REINSTALL EXISTING ACOUSTICAL CEILING TILE AND GRID (REPLACE AS REQUIRED IF EXISTING CONDITION IS NOT REUSABLE. MATCH EXISTING MATERIAL, PROFILE, AND COLOR)
3. ALL NEW EXPOSED INTERIOR AND EXTERIOR SURFACES DUE TO WINDOW INSTALLATION SHALL RECEIVE THE SPECIFIED SURFACE PREPARATION AND BE PAINTED UNLESS OTHERWISE INDICATED. IF NOT SPECIFIED, PROVIDE AS REQUIRED ACCORDING TO INDUSTRY STANDARDS
4. APPROXIMATE AREA OF SPALL REPAIR, PAINT TO MATCH EXISTING ADJACENT SURFACE, SEE STR DWGS FOR ADDITIONAL INFORMATION

LEGEND

- 9' x 12' LIGHT FIXTURES, SEE ELEC DWGS
- EXISTING CHAIN LINK FENCE
- EXISTING DOOR
- EXISTING WINDOW
- WINDOW AS SCHEDULED
- EXISTING WORK STATION, SEE GENERAL NOTE C
- EXISTING ACOUSTIC CEILING TILE
- EXISTING ACOUSTIC CEILING TILE AND GRID TO BE REINSTALLED
- PATCH EXISTING CEILING TO MATCH EXISTING ADJACENT SURFACE MATERIAL AND COLOR

0 8' 16' 24' 32' 40' 48'
SCALE: 1/16" = 1'-0"



THIS WORK WAS PREPARED BY ME OR UNDER MY SUPERVISION

SIGNATURE EXPIRATION DATE

SH	DATE	APPR	DATE
1	3/21/24		
ADDENDUM 1			

SUBMITTAL PHASE
CONSTRUCTION DOCUMENTS

SUBMITTAL DATE 3/1/2024

INR INR SH

DEPARTMENT OF DEFENSE
DIAMOND HEAD STATE MONUMENT
4204 DIAMOND HEAD RD HONOLULU, HI 96816
BIRKIMER EMERGENCY OPERATIONS CENTER (EOC)
UPGRADES AND IMPROVEMENTS
FLOOR PLAN - CEILING

STATE OF HAWAII
TMK: 3-1-042:006

SCALE:
AS NOTED

STATE JOB NO.
CA-202313-C

FEDERAL PROJECT NO.
-


SHEET 28 OF 123

AA102

ROOM FINISH SCHEDULE													
BUILDING NAME	ROOM NUMBER	ROOM NAME	FLOOR	BASE	WAINSCOT	WALLS				TRIM & MISC	CEILING	CEILING FINISH	REMARKS
						A	B	C	D				
B303	101	JIC	NO CHANGE	NO CHANGE	NO CHANGE	NO CHANGE	NO CHANGE	NO CHANGE	NO CHANGE	NO CHANGE	ACT-01/ ACT-02	-	-
B303	102	STATE WARNING POINT	NO CHANGE	NO CHANGE	NO CHANGE	PT-01	PT-01	PT-01	PT-01	NO CHANGE	ACT-01	-	-
B303	103	MEDIA CENTER	NO CHANGE	NO CHANGE	NO CHANGE	NO CHANGE	NO CHANGE	NO CHANGE	NO CHANGE	NO CHANGE	ACT-01	-	-
B303	104	OPEN WORK AREA 1	NO CHANGE	NO CHANGE	NO CHANGE	NO CHANGE	NO CHANGE	NO CHANGE	NO CHANGE	NO CHANGE	ACT-01	-	-
B303	106	LUNCH ROOM	NO CHANGE	NO CHANGE	NO CHANGE	NO CHANGE	NO CHANGE	NO CHANGE	NO CHANGE	NO CHANGE	ACT-02	-	-





MATERIAL SCHEDULE											
CODE	MATERIAL	MANUFACTURER	MODEL/SIZE	COLOR	OPTIONS	LOCATIONS		REMARKS			
ACT-01	ACOUSTICAL CEILING TILE	ARMSTRONG	2X4	MATCH EXISTING	MATCH EXISTING	JIC, STATE WARNING POINT, MEDIA CENTER, OPEN WORK AREA 1		-			
ACT-02	ACOUSTICAL CEILING TILE	ARMSTRONG	2X2	MATCH EXISTING	MATCH EXISTING	JIC, LUNCH ROOM		-			
PT-01	INTERIOR PAINT	SHERWIN WILLIAMS	-	MATCH EXISTING	SEMI GLOSS	STATE WARNING POINT WALLS		-			
PT-02	EXTERIOR PAINT	SHERWIN WILLIAMS	-	MATCH EXISTING	SEMI GLOSS	EXTERIOR WALL, WINDOW REPLACEMENT		-			

ROOM NUMBER	WINDOW NUMBER	TYPE	SIZE (ROUGH OPENING)		MATERIAL		DETAIL NUMBER				WINDOW COVERINGS	REMARKS
			WIDTH	HEIGHT	FRAME	GLAZING	HEAD	JAMB	MULLION	SILL		
102	102A	A	11'-1"	5'-5"	ALUM	SEE SPECS	1/AA701	2/AA701	3/AA701	4/AA701	SHADE	ASTM E 1996/1886 LARGE MISSILE IMPACT (WINDBORNE DEBRIS)
102	102B	B	3'-6"	5'-5"	ALUM	SEE SPECS	1/AA701	2/AA701	-	4/AA701	SHADE	ASTM E 1996/1886 LARGE MISSILE IMPACT (WINDBORNE DEBRIS)

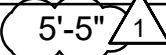WINDOW SCHEDULE												
ROOM NUMBER	WINDOW NUMBER	TYPE	SIZE (ROUGH OPENING)		MATERIAL		DETAIL NUMBER				WINDOW COVERINGS	REMARKS
			WIDTH	HEIGHT	FRAME	GLAZING	HEAD	JAMB	MULLION	SILL		
102	102A	A	11'-1"	5'-5"	ALUM	SEE SPECS	1/AA701	2/AA701	3/AA701	4/AA701	SHADE	ASTM E 1996/1886 LARGE MISSILE IMPACT (WINDBORNE DEBRIS)
102	102B	B	3'-6"	5'-5" 	ALUM	SEE SPECS	1/AA701	2/AA701	-	4/AA701	SHADE	ASTM E 1996/1886 LARGE MISSILE IMPACT (WINDBORNE DEBRIS)

WINDOW TYPES											

<div><div><div><div><div></div><div></div><div></div></div><div><div></div><div></div><div></div></div><div><div></div><div></div><div></div></div></div><div><div></div><div></div><div></div></div><div><div></div><div></div><div></div></div><div><div></div><div></div><div></div></div></div><div>W</div><div>EQ</div><div>EQ</div><div>EQ</div><div>H</div><div>±3'-10"</div><div>FIN FLR</div><div>A</div><div>FIXED ANOD ALUM FRAME WINDOW W/ 1/4" LOW E GLASS COLOR: MATCH EXISTING</div></div>											
<div><div><div><div><div></div><div></div><div></div></div><div><div></div><div></div><div></div></div></div><div><div></div><div></div><div></div></div><div><div></div><div></div><div></div></div><div><div></div><div></div><div></div></div></div><div>W</div><div>H</div><div>±3'-10"</div><div>FIN FLR</div><div>B</div><div>FIXED ANOD ALUM FRAME WINDOW W/ 1/4" LOW E GLASS COLOR: MATCH EXISTING</div></div>											

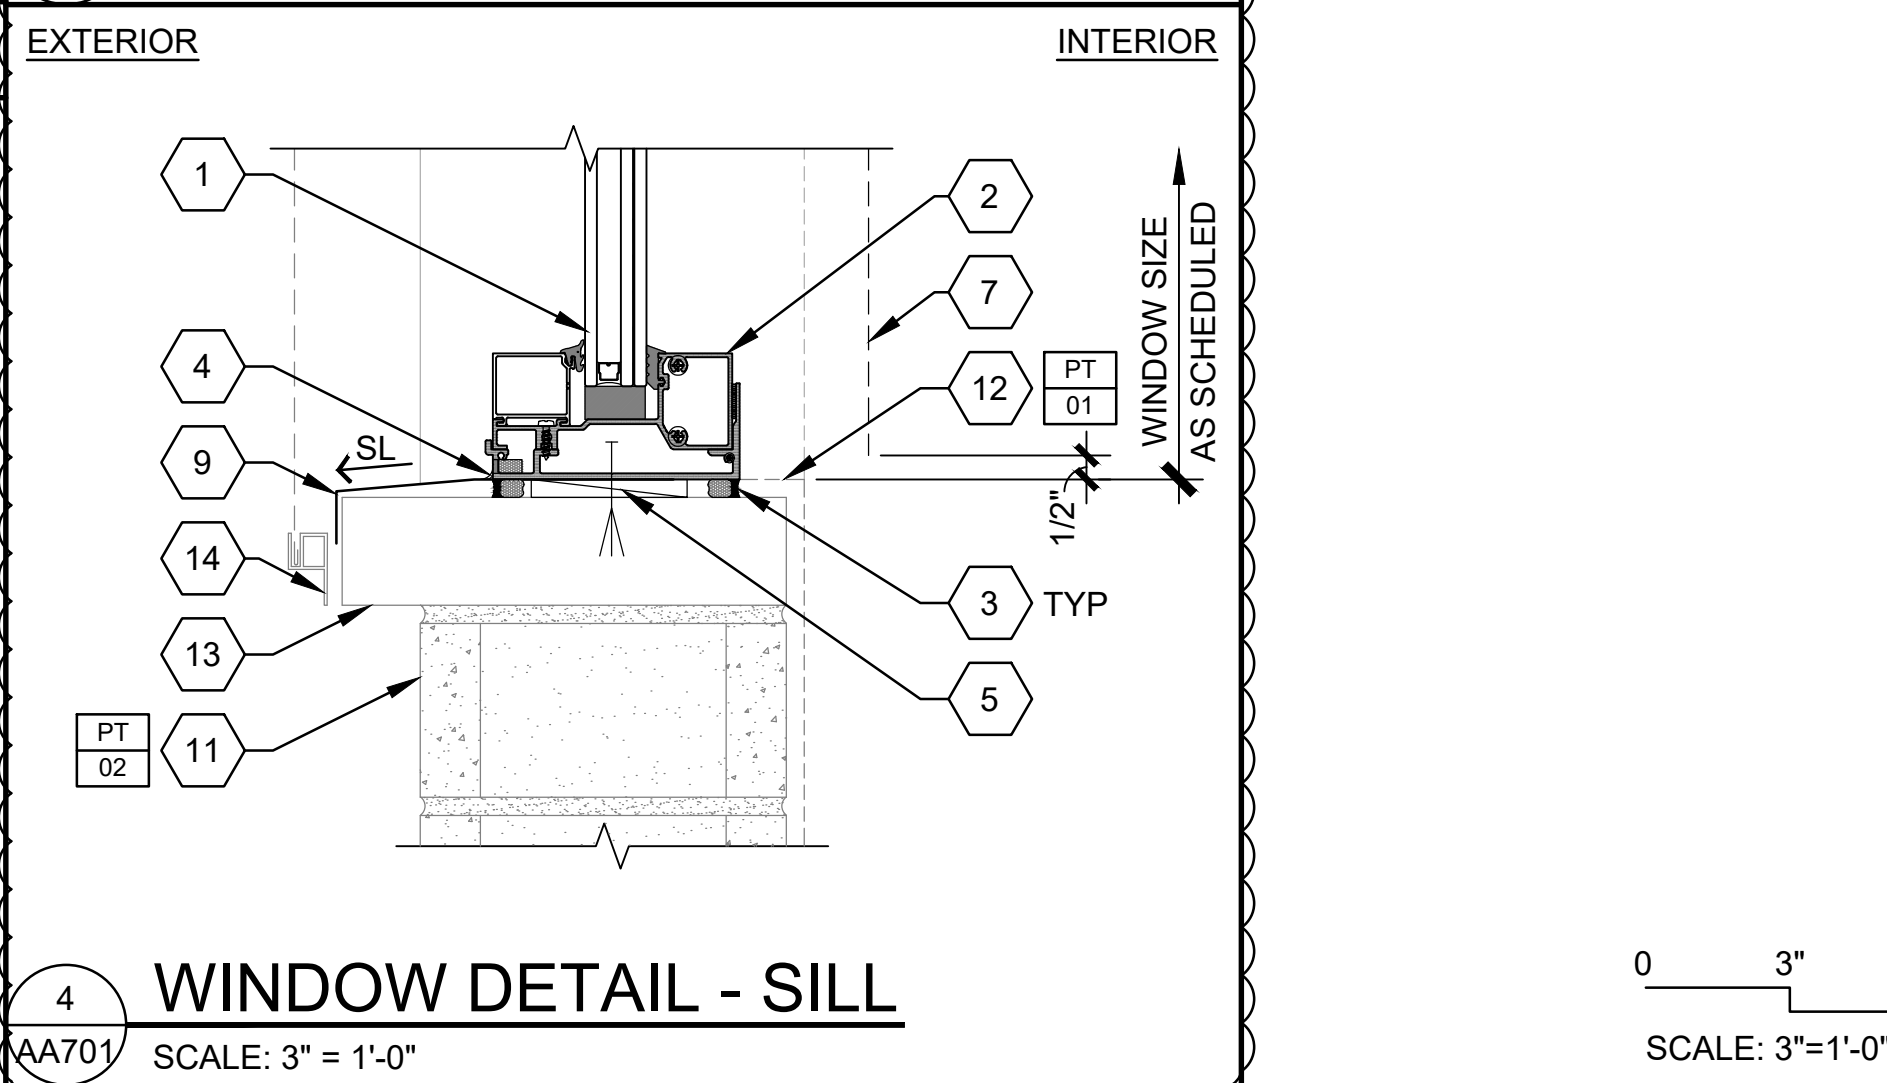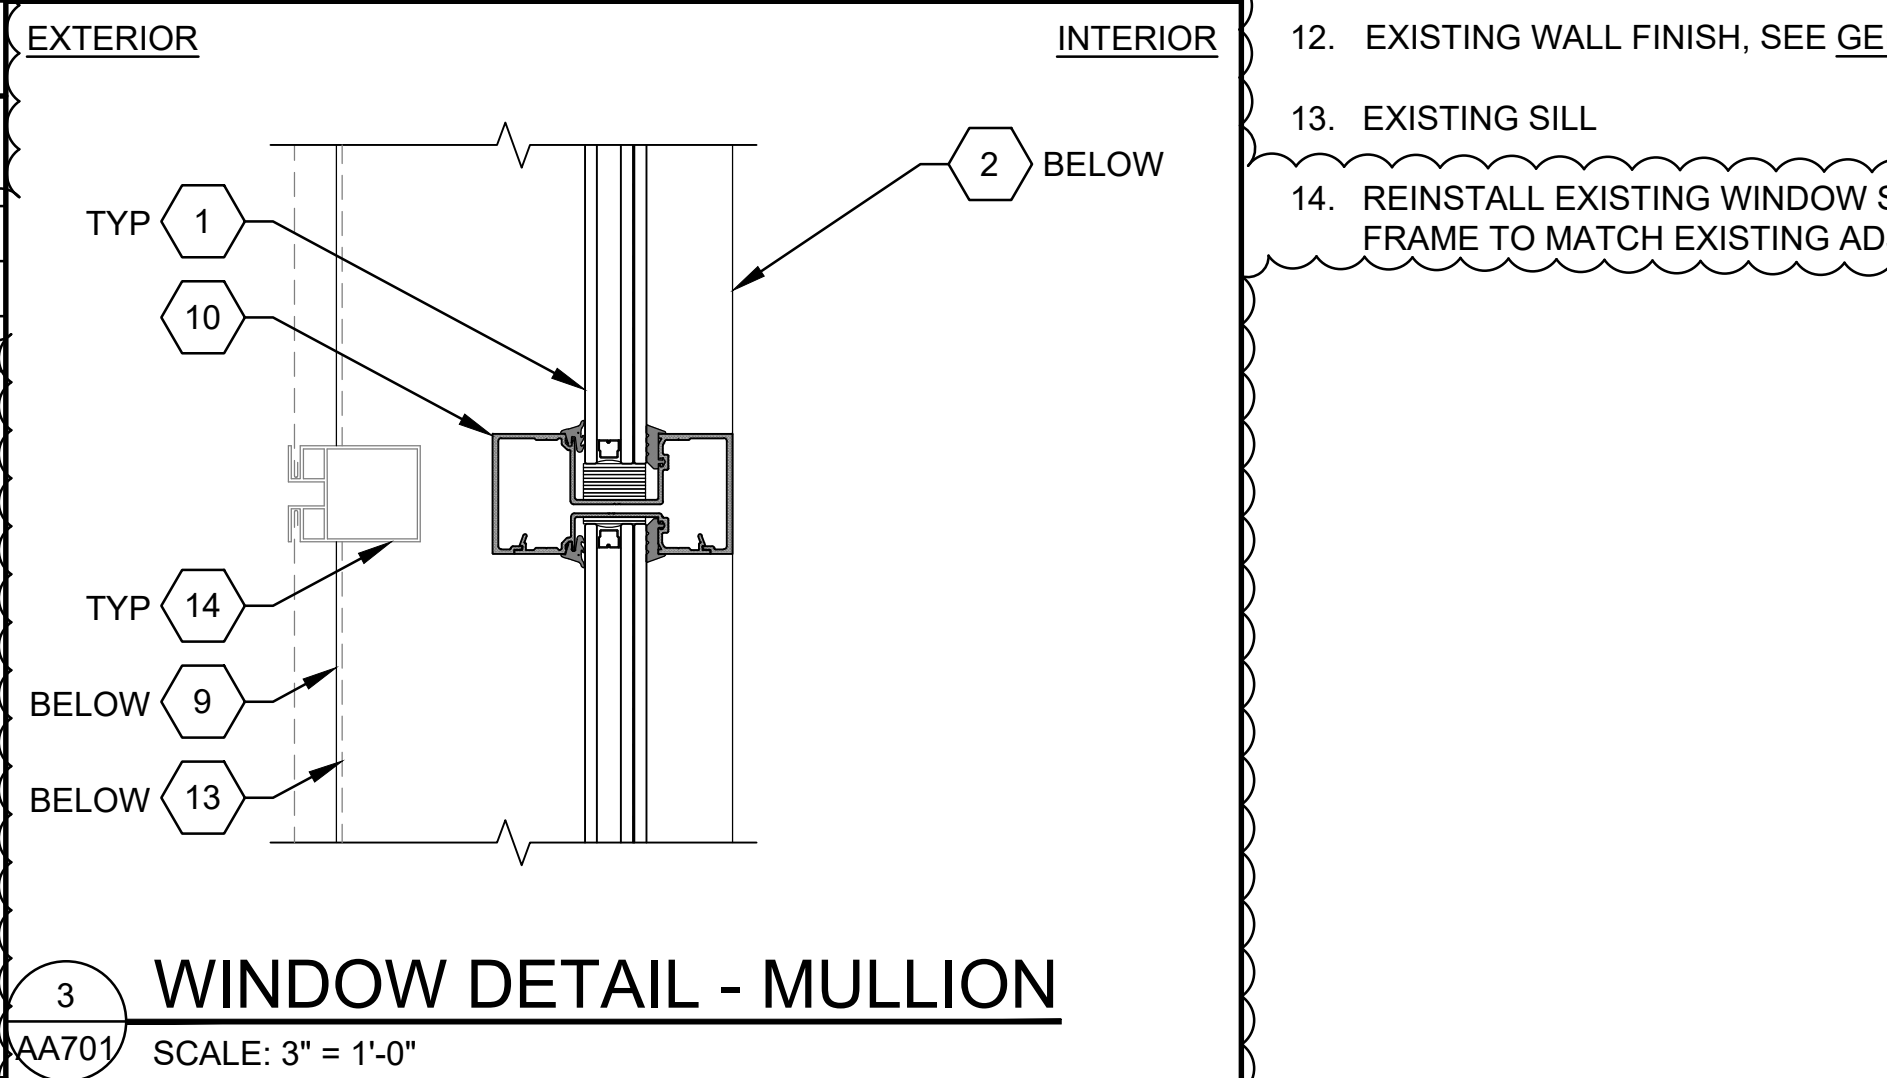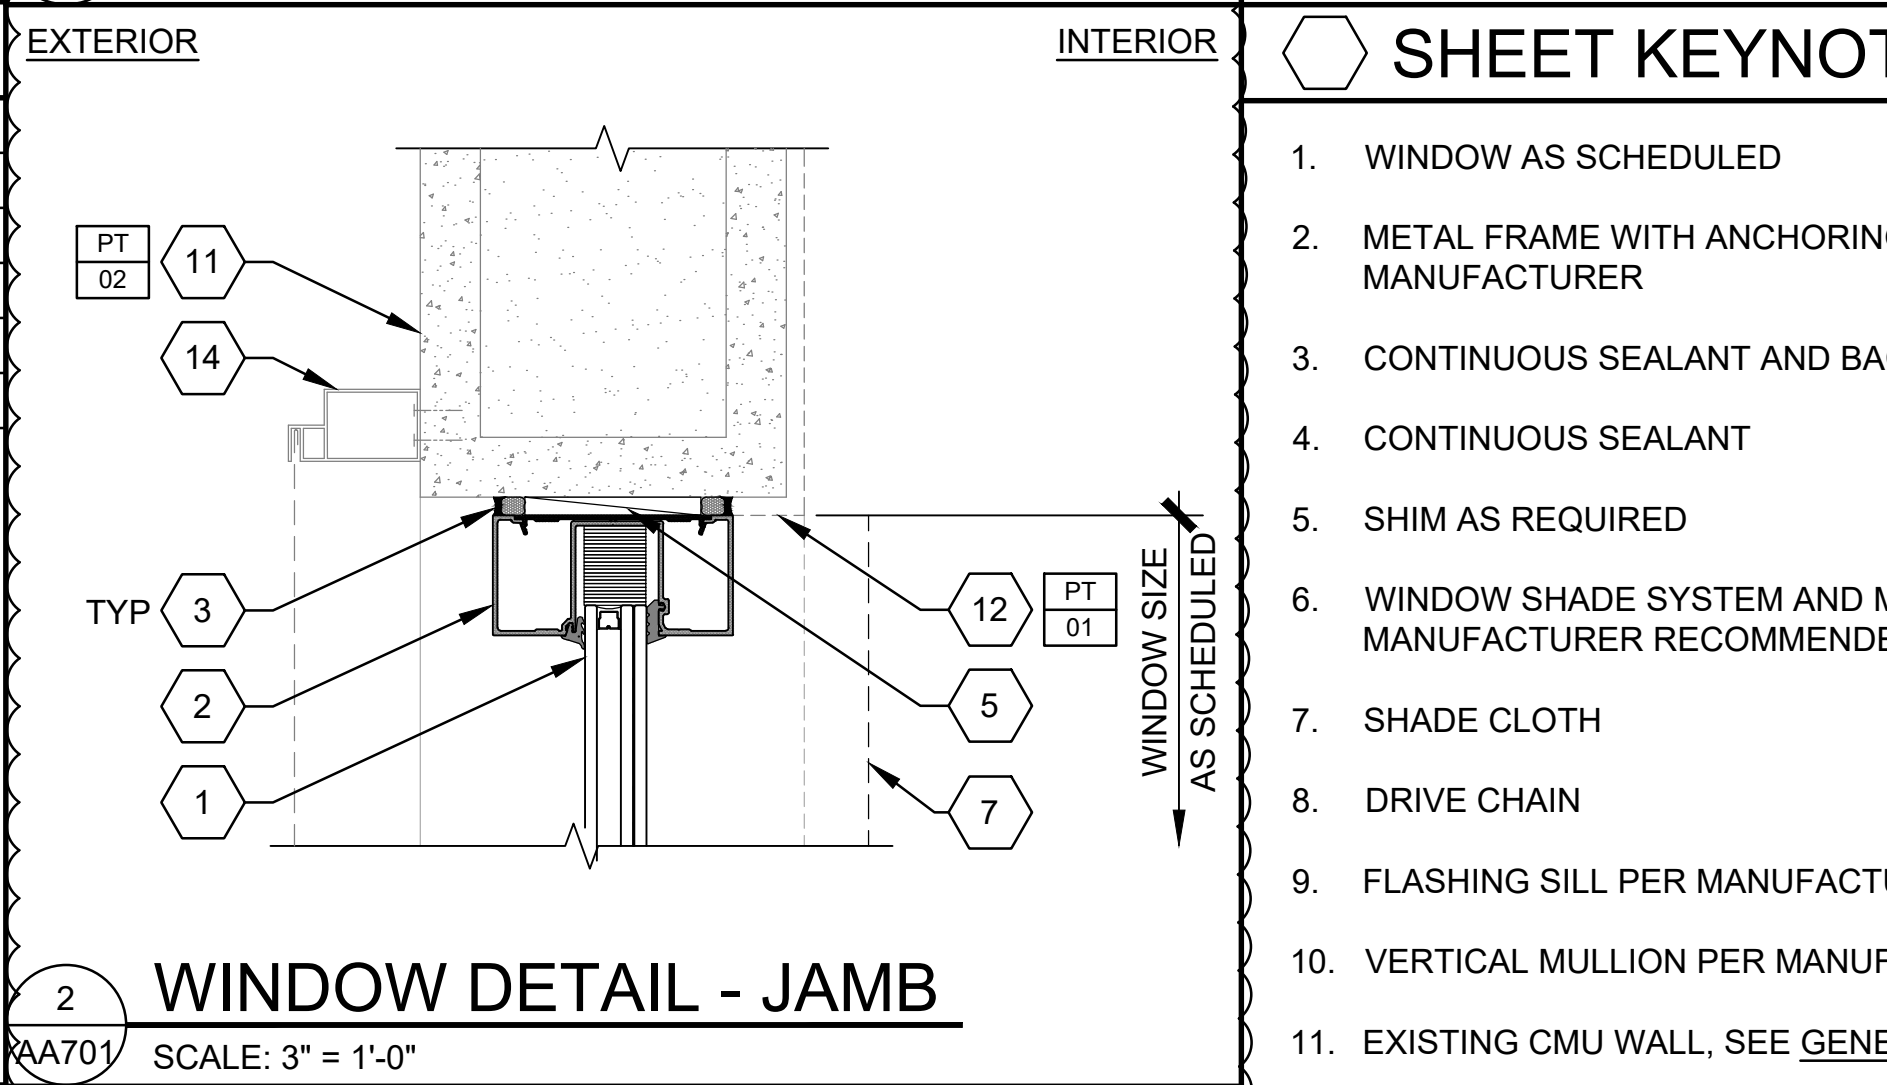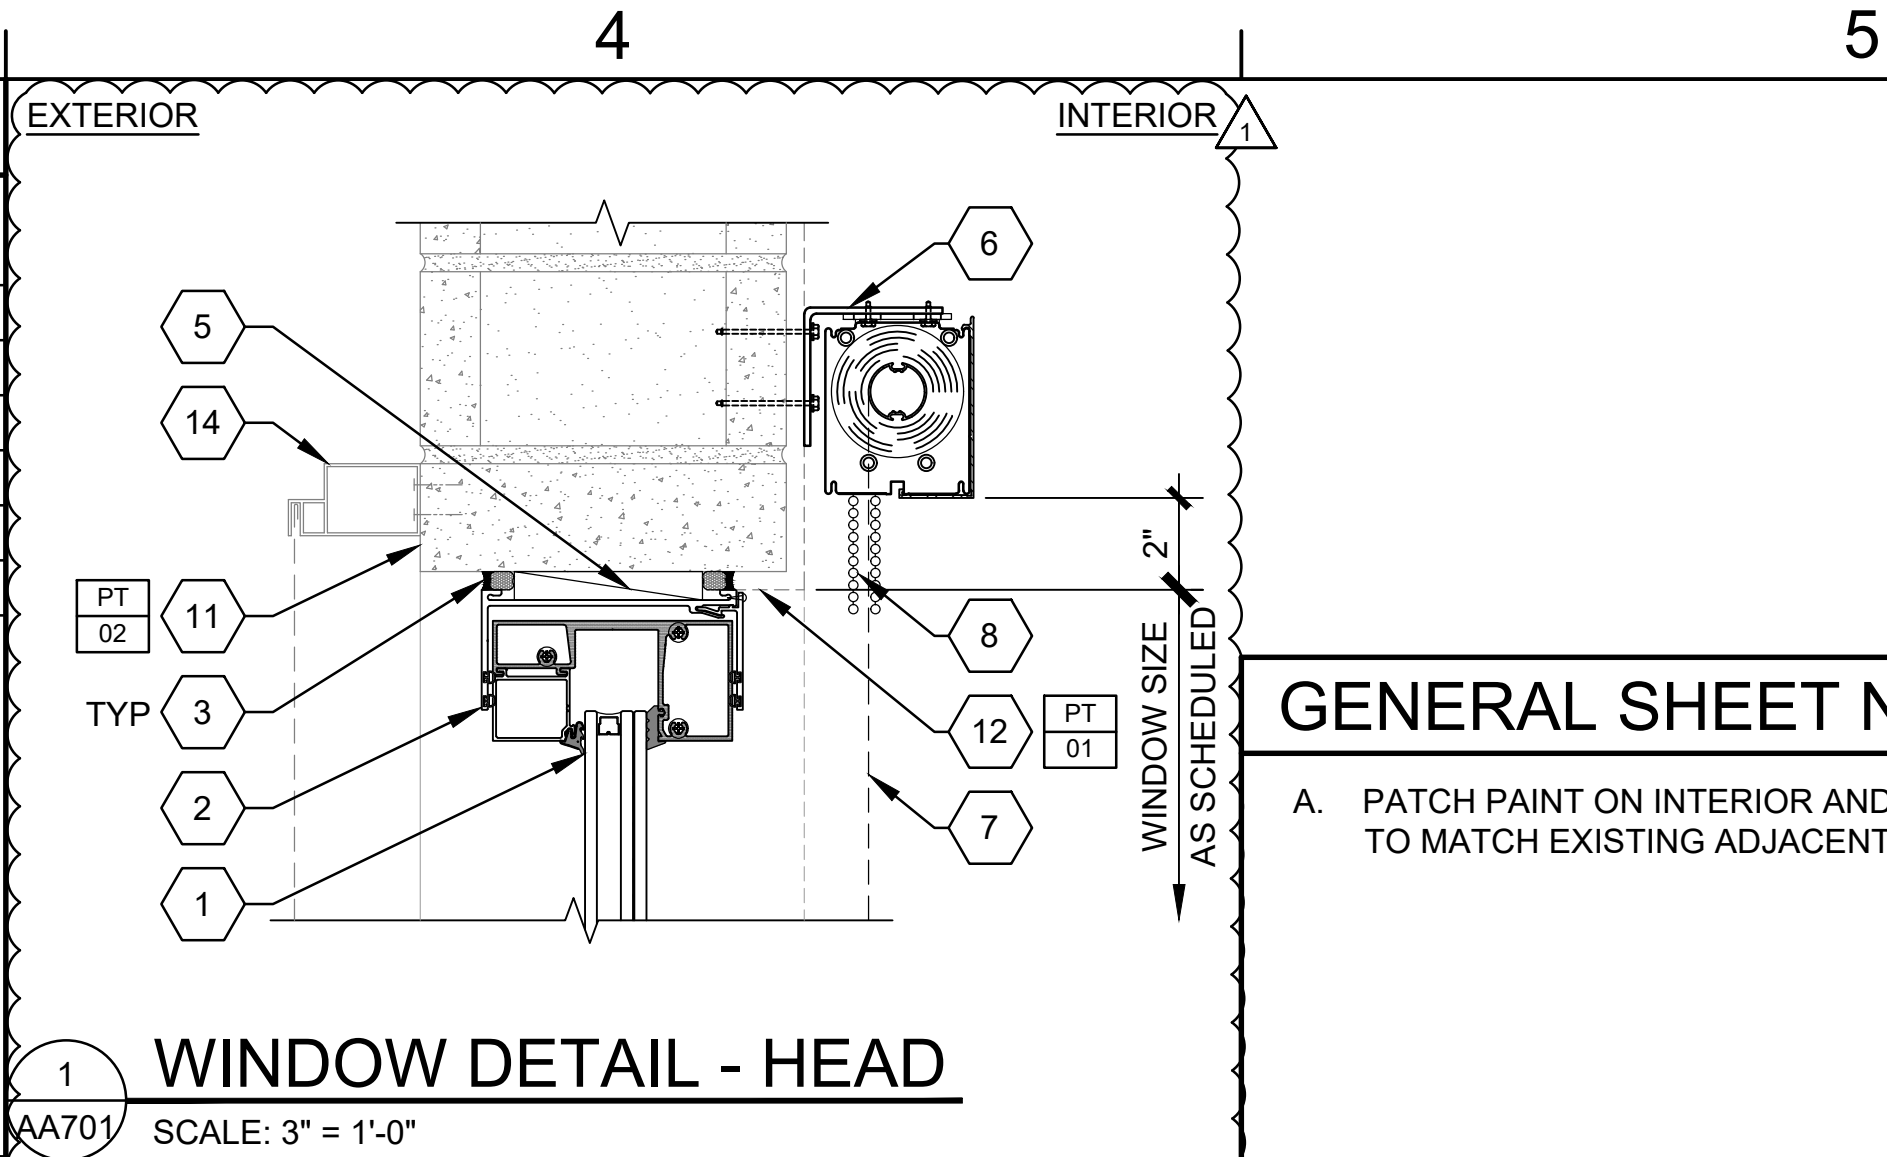

GENERAL SHEET NOTES

- A. PATCH PAINT ON INTERIOR AND EXTERIOR WALL AS NEEDED TO MATCH EXISTING ADJACENT SURFACE

SHEET KEYNOTES (FOR THIS SHT ONLY)

- WINDOW AS SCHEDULED
- METAL FRAME WITH ANCHORING AS RECOMMENDED PER MANUFACTURER
- CONTINUOUS SEALANT AND BACKER ROD
- CONTINUOUS SEALANT
- SHIM AS REQUIRED
- WINDOW SHADE SYSTEM AND MOUNTING HARDWARE W/ MANUFACTURER RECOMMENDED FASTENERS
- SHADE CLOTH
- DRIVE CHAIN
- FLASHING SILL PER MANUFACTURER
- VERTICAL MULLION PER MANUFACTURER
- EXISTING CMU WALL, SEE GENERAL NOTE A
- EXISTING WALL FINISH, SEE GENERAL NOTE A
- EXISTING SILL
- REINSTALL EXISTING WINDOW SCREEN, CLIPS AND FRAME TO MATCH EXISTING ADJACENT



THIS WORK WAS PREPARED BY ME OR UNDER MY SUPERVISION

4/30/2026

SIGNATURE EXPIRATION DATE

SH

3/21/24

DATE

APPR

DATE

SYN

DESCRIPTION

ADDENDUM 1

1

SUBMITTAL PHASE

CONSTRUCTION

DOCUMENTS

SUBMITTAL DATE

3/12/2024

INR INR INR SH

DEPARTMENT OF DEFENSE

DIAMOND HEAD STATE MONUMENT

4204 DIAMOND HEAD RD HONOLULU, HI 96816

BIRKHIRMER EMERGENCY OPERATIONS CENTER (EOC)

UPGRADES AND IMPROVEMENTS

(SCHEDULE TYPES AND DETAIL)

SCALE:

AS NOTED

STATE JOB NO.



CA-202313-C

FEDERAL PROJECT NO.

-

SHEET 29 OF 123

AA701

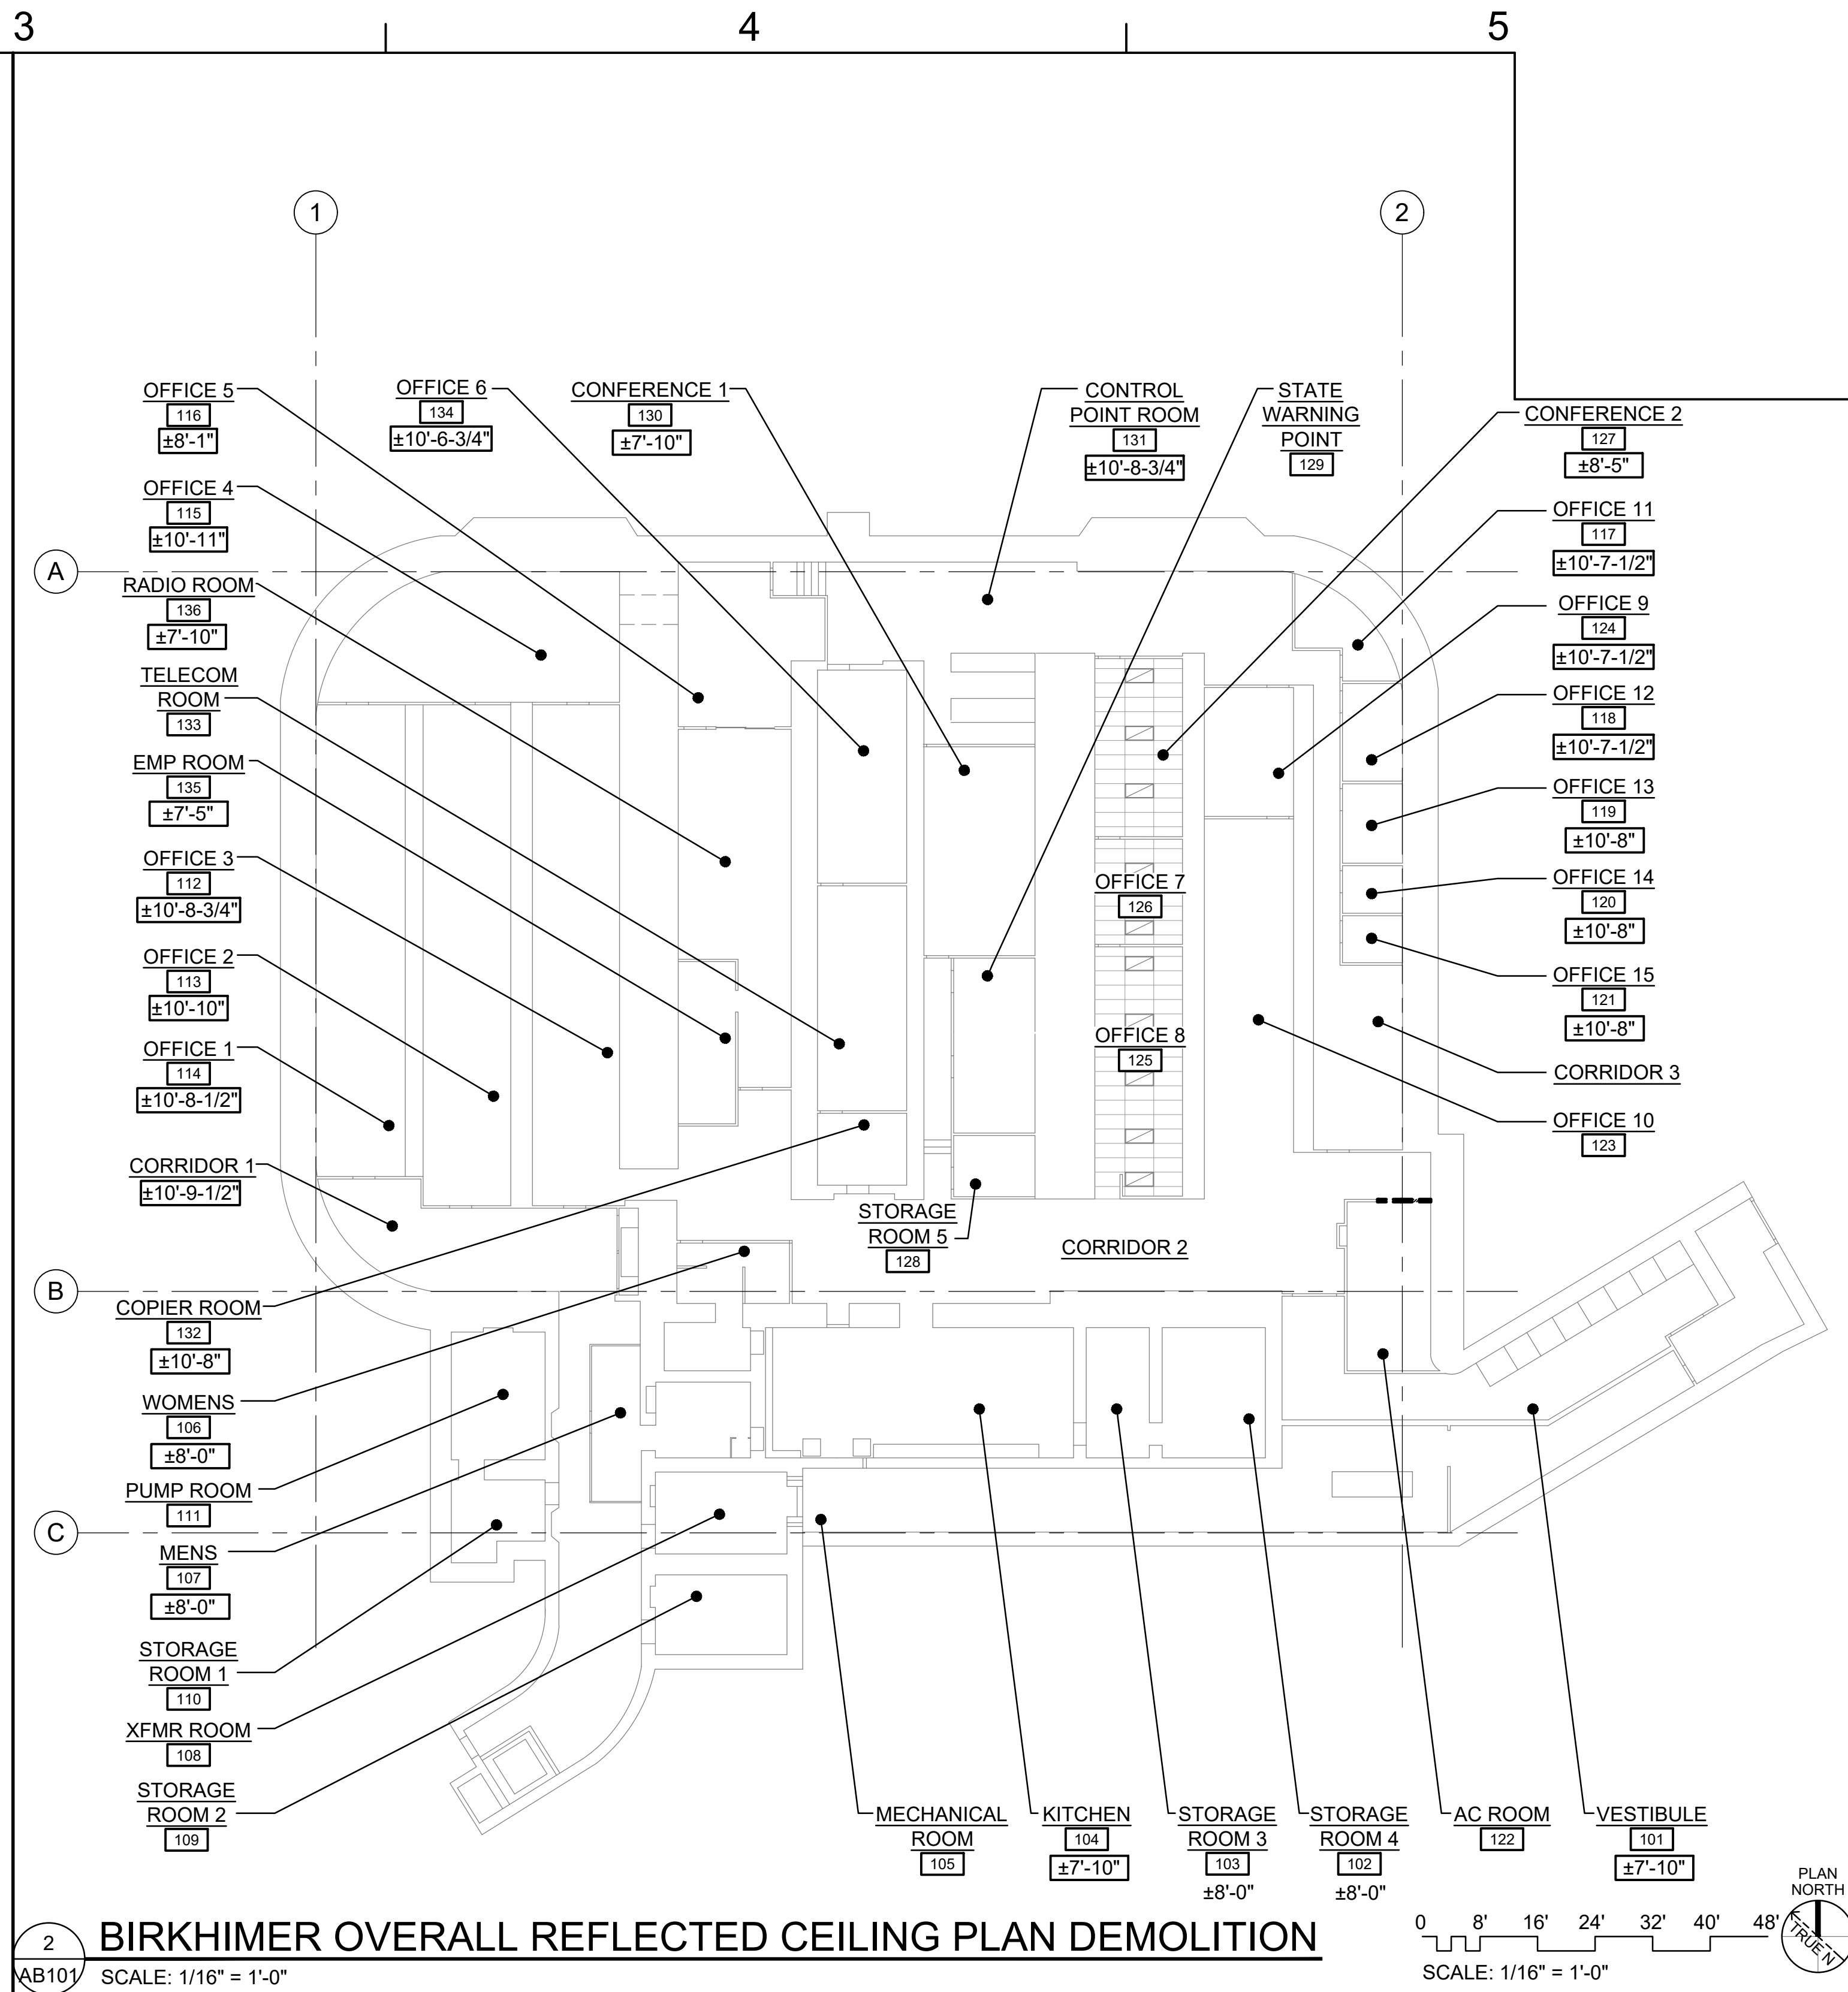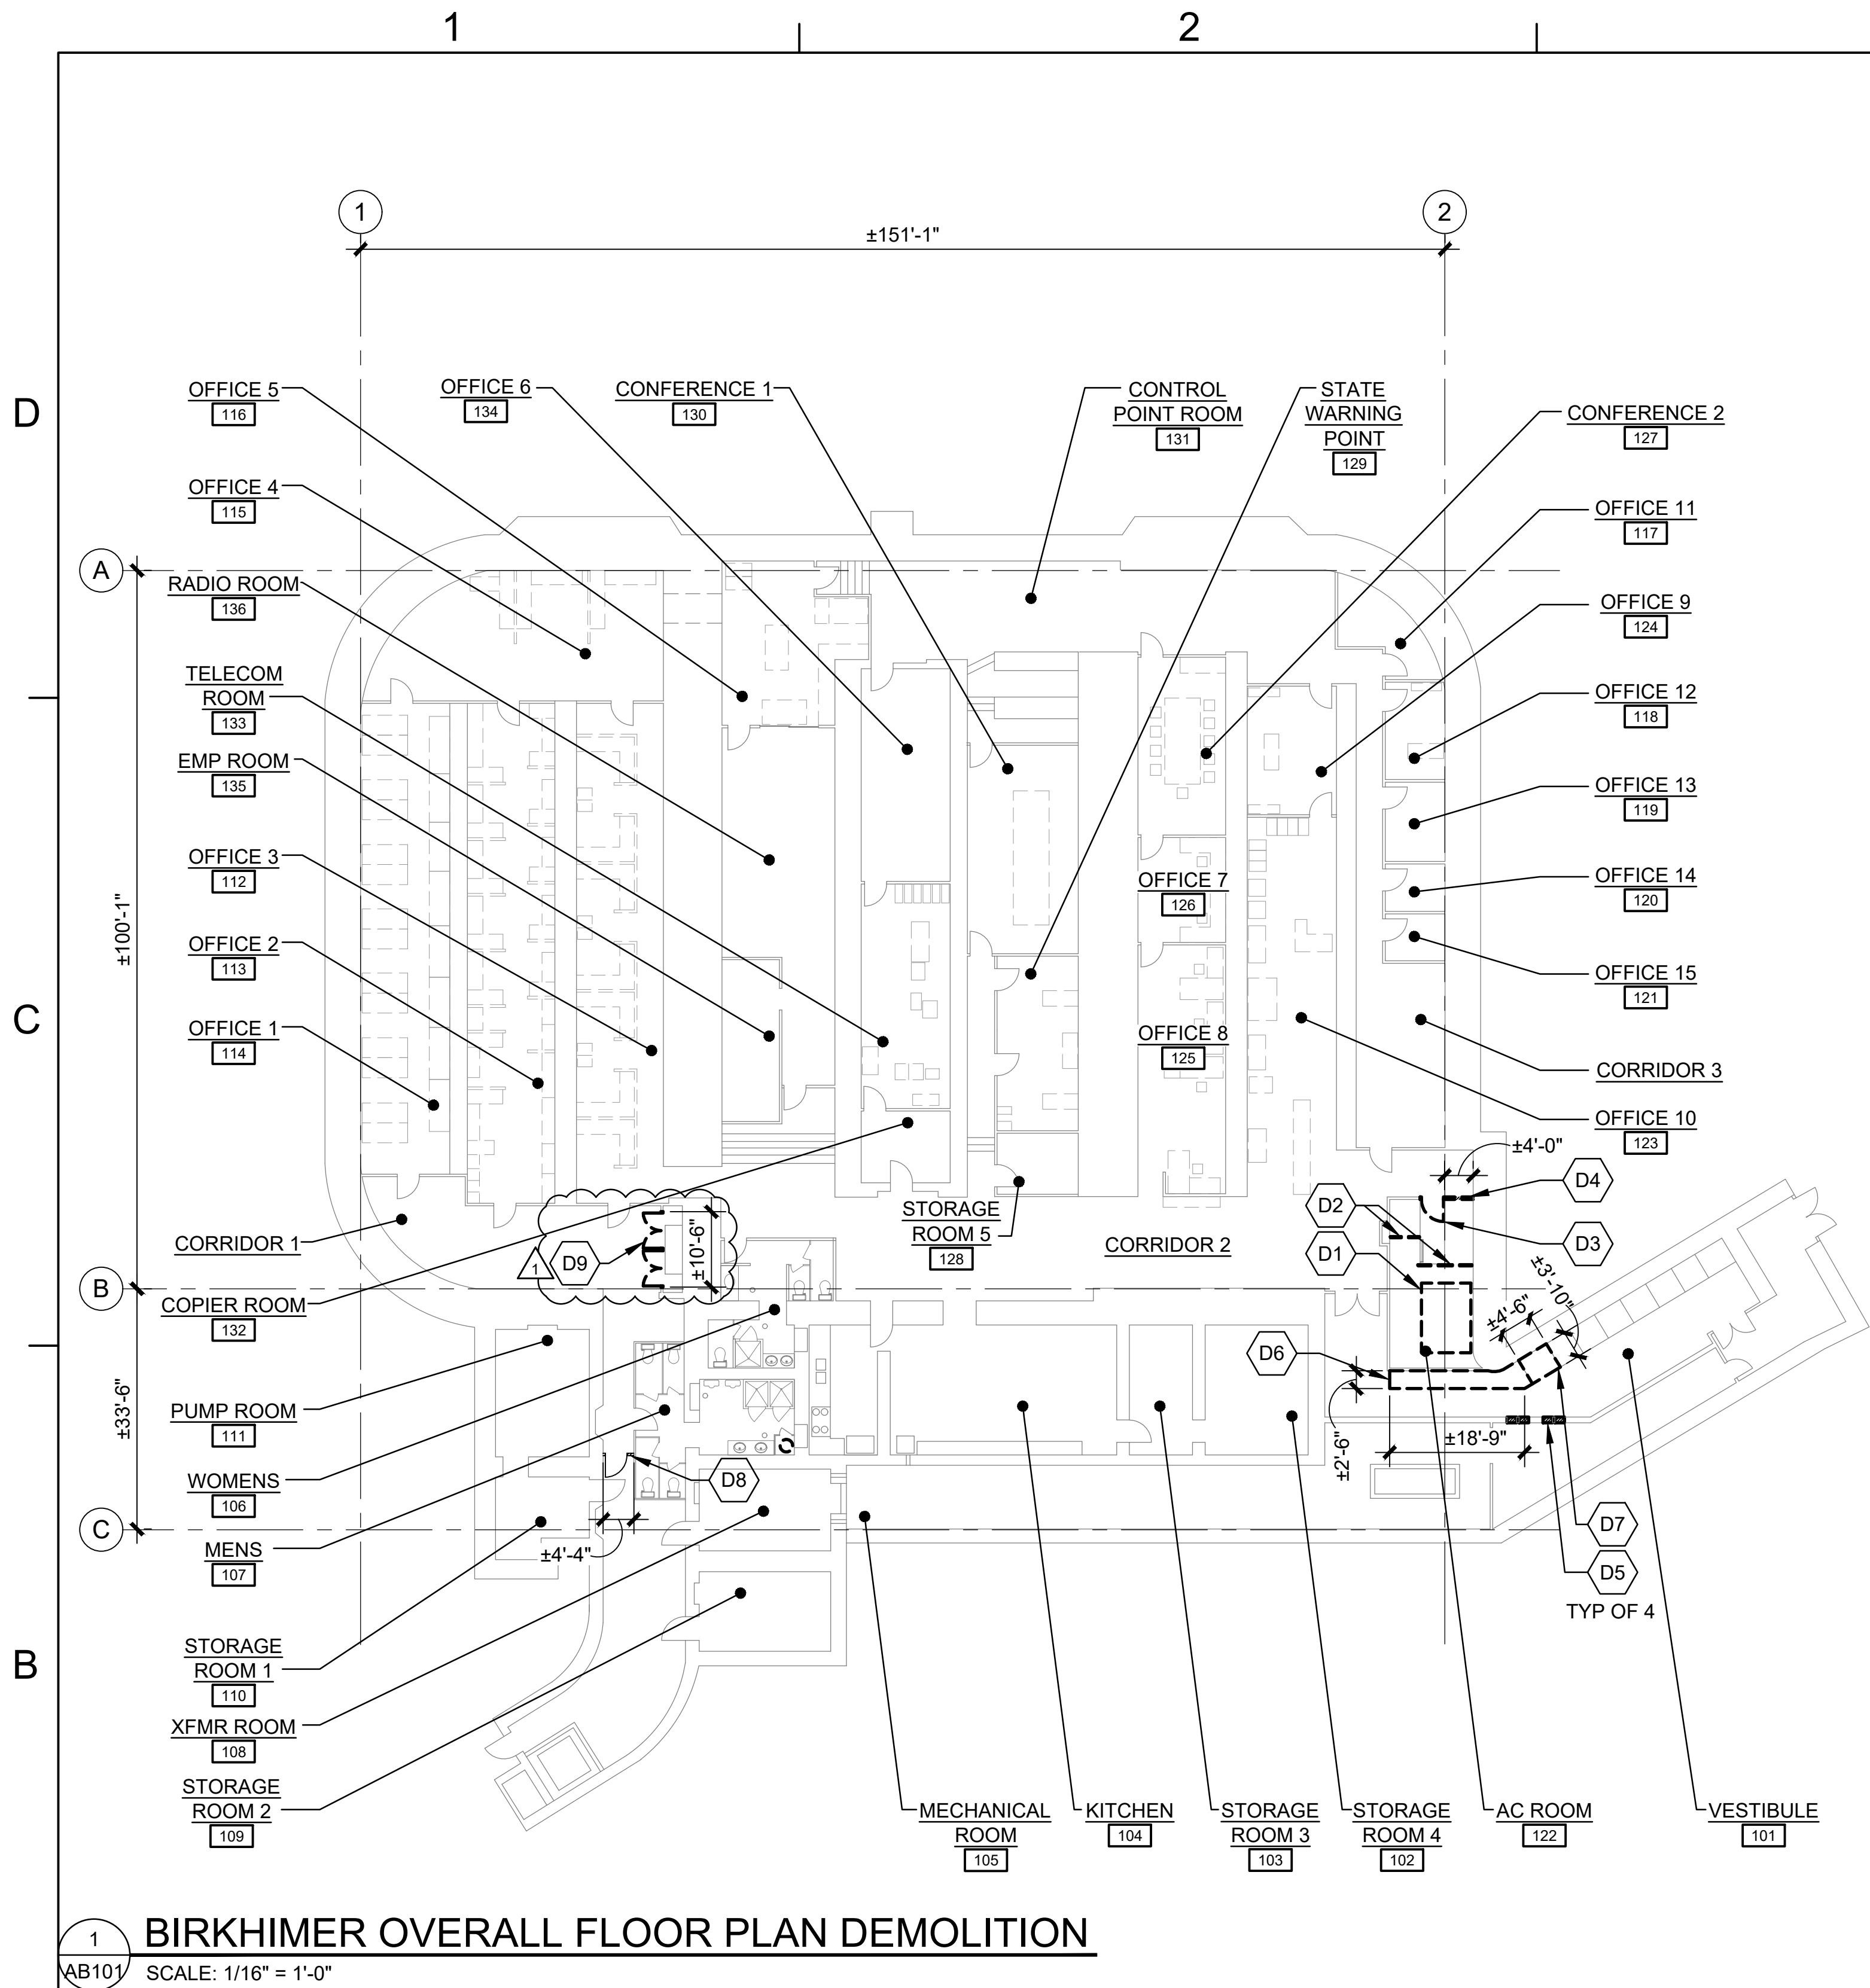

GENERAL SHEET NOTES

A. CONTRACTOR MUST REPAIR AND PATCH EXISTING WALL AND FLOOR FOR A SMOOTH SURFACE WHERE DOOR ASSEMBLY, PARTIAL WALL AND GUARD RAIL DEMOLITION/ REMOVALS OCCUR. FINISH TO MATCH EXISTING ADJACENT SURFACES

B. CONTRACTOR TO FIELD VERIFY EXISTING CEILING CONDITIONS AND MATERIALS. REMOVE AND SALVAGE EXISTING CEILING AS NEEDED TO FACILITATE MECHANICAL AND ELECTRICAL WORK. SEE MECHANICAL AND ELECTRICAL DRAWINGS FOR ADDITIONAL INFORMATION.

C. ALL EXISTING PLUMBING FIXTURES AND ACCESSORIES IN WOMENS 106 AND MENS 107 ARE TO REMAIN

D. SEE SITE PLAN ON SHEET 001 FOR PORTA POTTY LOCATIONS

DEMOLITION KEYNOTES (FOR THIS SHT ONLY)

D1. DEMOLISH AND REMOVE EXISTING AIR HANDLING UNIT, SEE MECH DWGS

D2. REMOVE AND SALVAGE EXISTING SURFACE MOUNTED GUARDRAILS FOR REINSTALLATION, AS NEEDED TO FACILITATE THE DEMOLITION AND REMOVAL OF AIR HANDLING UNIT. COORDINATE WITH USERS FOR STORAGE LOCATION

D3. REMOVE AND SALVAGE EXISTING DOOR AND FRAME FOR REINSTALLATION, AS NEEDED TO FACILITATE THE DEMOLITION AND REMOVAL OF AIR HANDLING UNIT. COORDINATE WITH USERS FOR STORAGE LOCATION

D4. DEMOLISH AND REMOVE PORTION OF EXISTING METAL STUD WALL, AS NEEDED TO FACILITATE THE DEMOLITION AND REMOVAL OF AIR HANDLING UNIT, EXISTING LOUVER ABOVE TO REMAIN. SEE GENERAL NOTE NO. 27 ON SHEET G-001 FOR SHORING INFORMATION

D5. DEMOLISH AND REMOVE (36" H X 16" W) PORTION OF EXISTING WALL, AS NEEDED TO FACILITATE INSTALLATION OF TEMPORARY MECHANICAL DUCTS, SEE MECH DWGS

D6. DEMOLISH AND REMOVE EXISTING PLYWOOD ENCLOSURE COMPLETE TO FACILITATE INSTALLATION OF TEMPORARY MECHANICAL DUCTS, SEE MECH DWGS

D7. REMOVE AND SALVAGE PORTION OF EXISTING WOOD CABINET TO FACILITATE INSTALLATION OF TEMPORARY MECHANICAL DUCTS, SEE MECH DWGS. SAVE FOR REINSTALLATION. COORDINATE WITH USERS FOR STORAGE LOCATION

D8. PROVIDE FULL HEIGHT TEMPORARY CONSTRUCTION BARRICADE WALL WITH DOOR DURING PHASE-2 OF CONSTRUCTION, SEE MECH DWGS. DEMOLISH THE TEMPORARY WALL ENTIRELY WHEN PHASE-2 OF THE PROJECT IS COMPLETED.

D9. REMOVE AND SALVAGE EXISTING WOOD CLOSET DOOR, FRAME AND RELATED ACCESSORIES TO FACILITATE REPLACEMENT OF MECHANICAL AIR HANDLING UNIT, SEE MECH DWGS. SAVE FOR REINSTALLATION. COORDINATE WITH USERS FOR STORAGE LOCATION

LEGEND

EXISTING DOOR

EXISTING WALL

EXISTING LIGHT FIXTURE


EXISTING ACT W/ GRID

EXISTING DOOR TO BE REMOVED

EXISTING WALL TO BE REMOVED

ITEMS TO BE DEMOLISHED

TEMPORARY CONSTRUCTION BARRICADE WALL AND DOOR



HAWAII STATE DEPARTMENT OF DEFENSE

SCOTT R.J. HARADA
REGISTERED ARCHITECT
No. 14637
HAWAII, U.S.A.

THIS WORK WAS PREPARED BY ME OR UNDER MY SUPERVISION
4/30/2026
SIGNATURE EXPIRATION DATE

SH	DATE	APPR	SYN	DESCRIPTION
9/21/24				

ADDENDUM 1

1

SUBMITTAL PHASE
CONSTRUCTION DOCUMENTS
SUBMITTAL DATE 3/1/2024

INK	INK	SH

DEPARTMENT OF DEFENSE

DIAMOND HEAD STATE MONUMENT

4204 DIAMOND HEAD RD HONOLULU, HI 96816

TWK: 3-1-042:006

BIRKHIMER EMERGENCY OPERATIONS CENTER (EOC) UPGRADES AND IMPROVEMENTS

OVERALL FLOOR AND CEILING DEMOLITION



SCALE: AS NOTED

STATE JOB NO. CA-202313-C

FEDERAL PROJECT NO. -

SHEET 30 OF 123

AB101

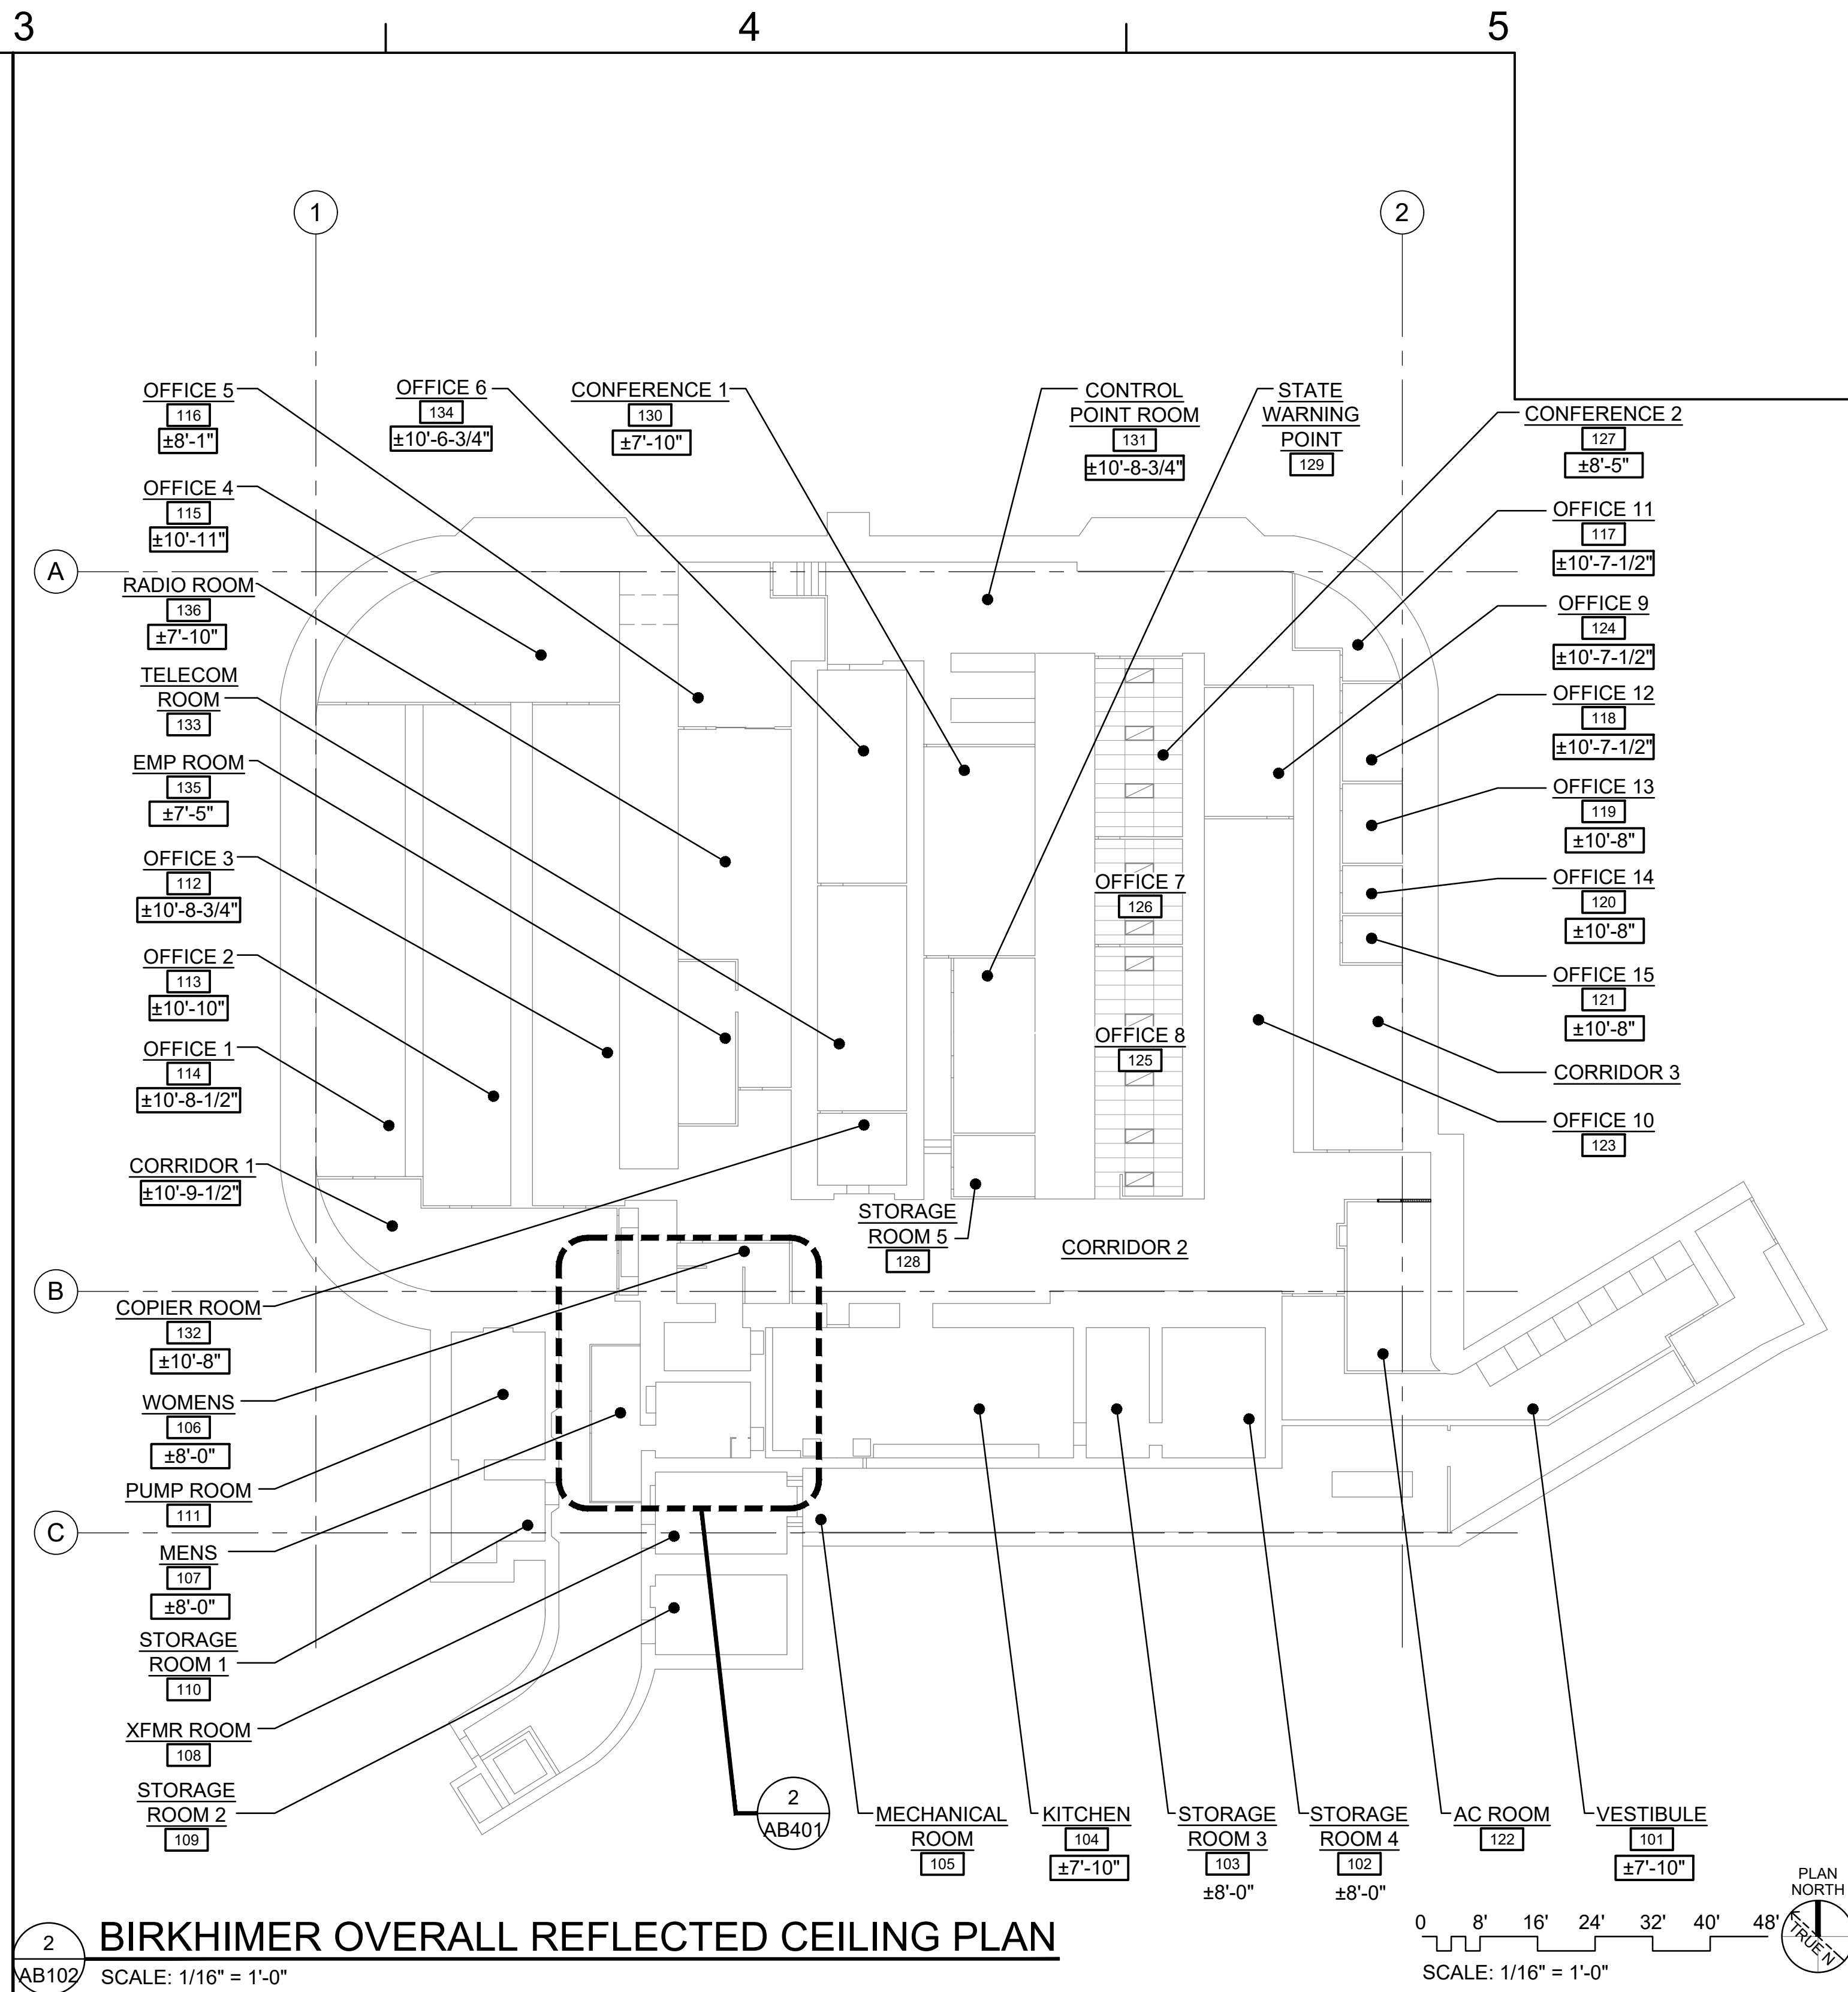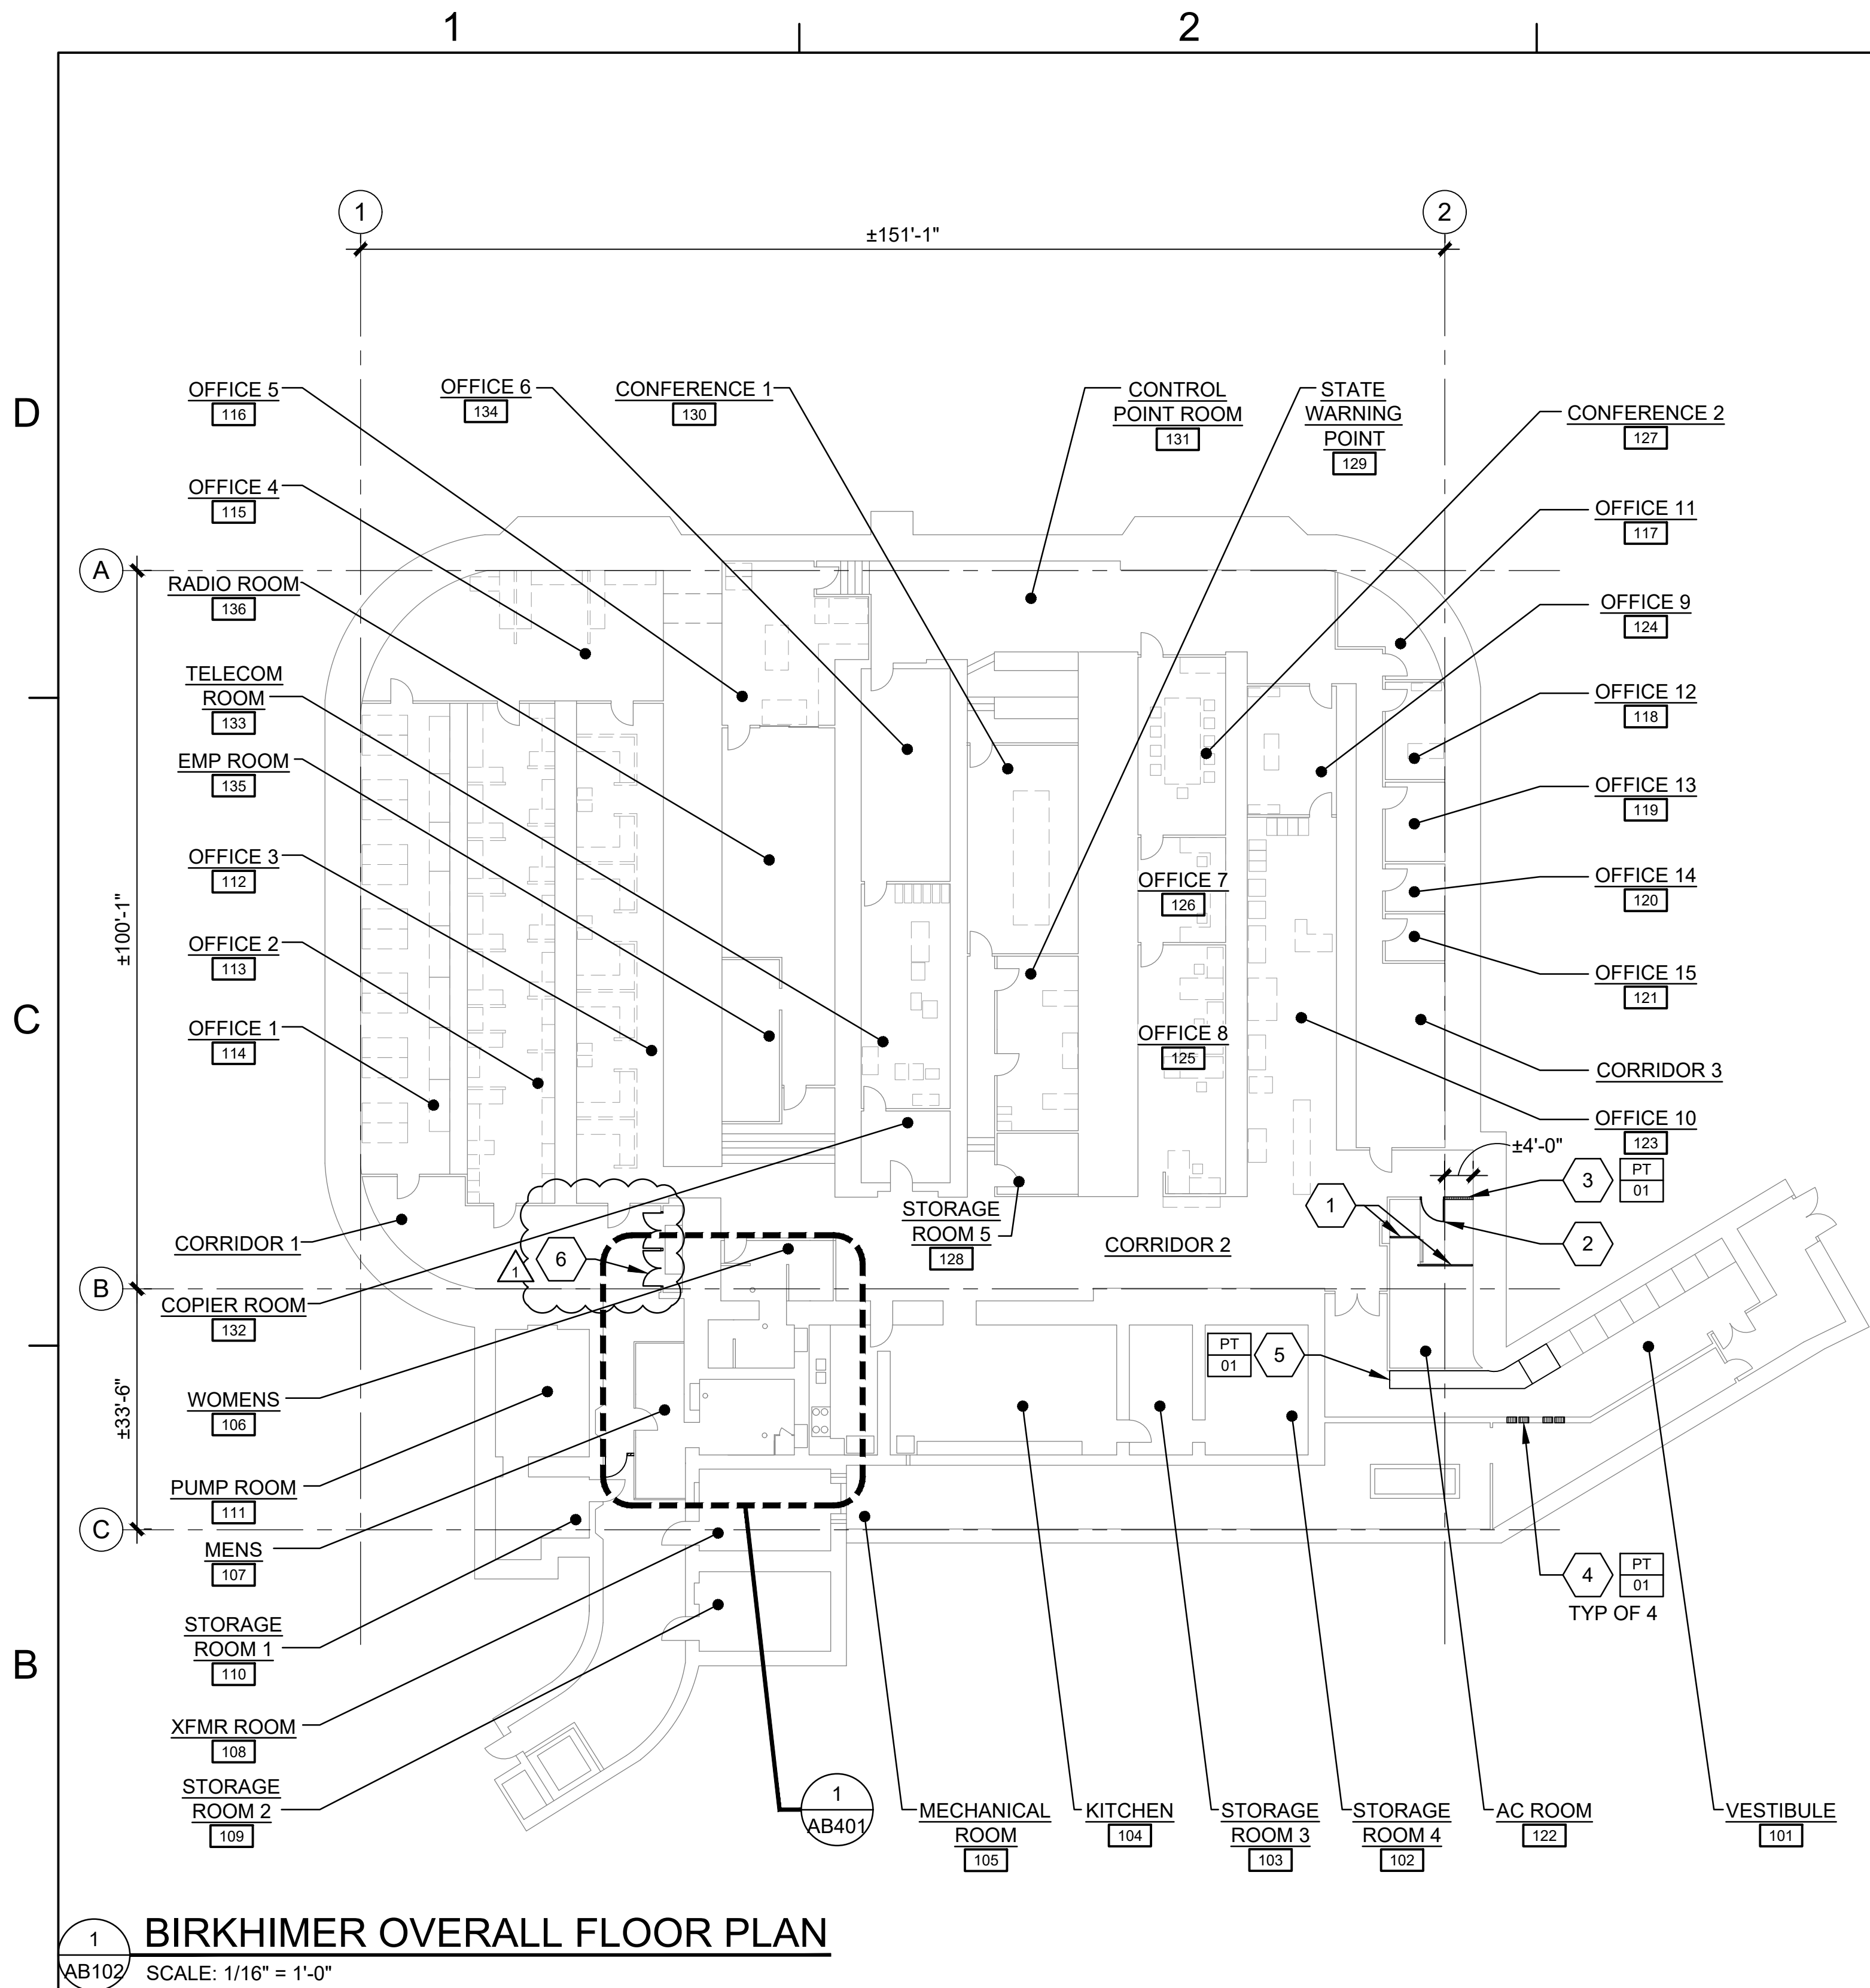

GENERAL SHEET NOTES

A. CONTRACTOR MUST REPAIR AND PATCH EXISTING WALL AND FLOOR FOR A SMOOTH SURFACE WHERE DOOR ASSEMBLY, PARTIAL WALL AND GUARD RAIL DEMOLITION/ REMOVALS OCCUR. FINISH TO MATCH EXISTING ADJACENT SURFACES


B. CONTRACTOR TO FIELD VERIFY EXISTING CEILING CONDITIONS AND MATERIALS. REINSTALL AND PATCH AS NEEDED TO MATCH EXISTING ADJACENT SURFACES AND COLOR AFTER WORK IS COMPLETED. SEE MECHANICAL AND ELECTRICAL DRAWINGS FOR ADDITIONAL INFORMATION.

C. ALL EXISTING PLUMBING FIXTURES AND ACCESSORIES IN WOMENS 106 AND MENS 107 ARE TO REMAIN


D. SEE SITE PLAN ON SHEET 001 FOR PORTA POTT Y LOCATIONS

- SHEET KEYNOTES (FOR THIS SHT ONLY)**
- REINSTALL EXISTING SURFACE MOUNTED GUARDRAILS REMOVED IN THE DEMOLITION OF EXISTING AIR HANDLING UNIT
 - REINSTALL DOOR AND FRAME REMOVED IN THE DEMOLITION OF EXISTING AIR HANDLING UNIT
 - PATCH PORTION OF EXISTING WALL REMOVED IN THE DEMOLITION OF EXISTING AIR HANDLING UNIT
 - INFILL (36" H X 16" W) PORTION OF EXISTING WALL REMOVED IN THE DEMOLITION OF TEMPORARY MECHANICAL DUCTS
 - REINSTALL EXISTING PLYWOOD ENCLOSURE AND PORTION OF CABINET. PAINT TO MATCH EXISTING ADJACENT SURFACES
 - REINSTALL EXISTING WOOD CLOSET DOOR, FRAME AND RELATED ACCESSORIES. PAINT AS NEEDED TO MATCH EXISTING ADJACENT SURFACES

- LEGEND**
- EXISTING DOOR
 - EXISTING WALL
 - EXISTING LIGHT FIXTURES
 - EXISTING 2X4 ACT W/ GRID
 - EXISTING DOOR TO BE REINSTALLED
 - WALL PATCH



HAWAII STATE DEPARTMENT OF DEFENSE

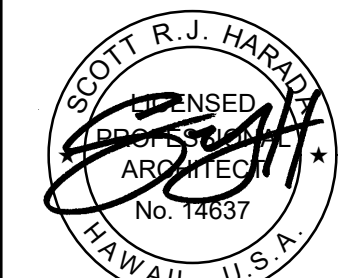

SCOTT R.J. HARADA
No. 14637
HAWAII, U.S.A.

THIS WORK WAS PREPARED BY ME OR UNDER MY SUPERVISION
4/30/2026
SIGNATURE EXPIRATION DATE

ADDENDUM 1	SYN	DESCRIPTION	DATE	APPR
1				

DEPARTMENT OF DEFENSE

TWK: 3-1-042:006

4204 DIAMOND HEAD RD HONOLULU, HI 96816

BIRKHIMER EMERGENCY OPERATIONS CENTER (EOC) UPGRADES AND IMPROVEMENTS

OVERALL FLOOR PLAN AND CEILING


SCALE: AS NOTED

STATE JOB NO. CA-202313-C

FEDERAL PROJECT NO. -

SHEET 31 OF 123

AB102

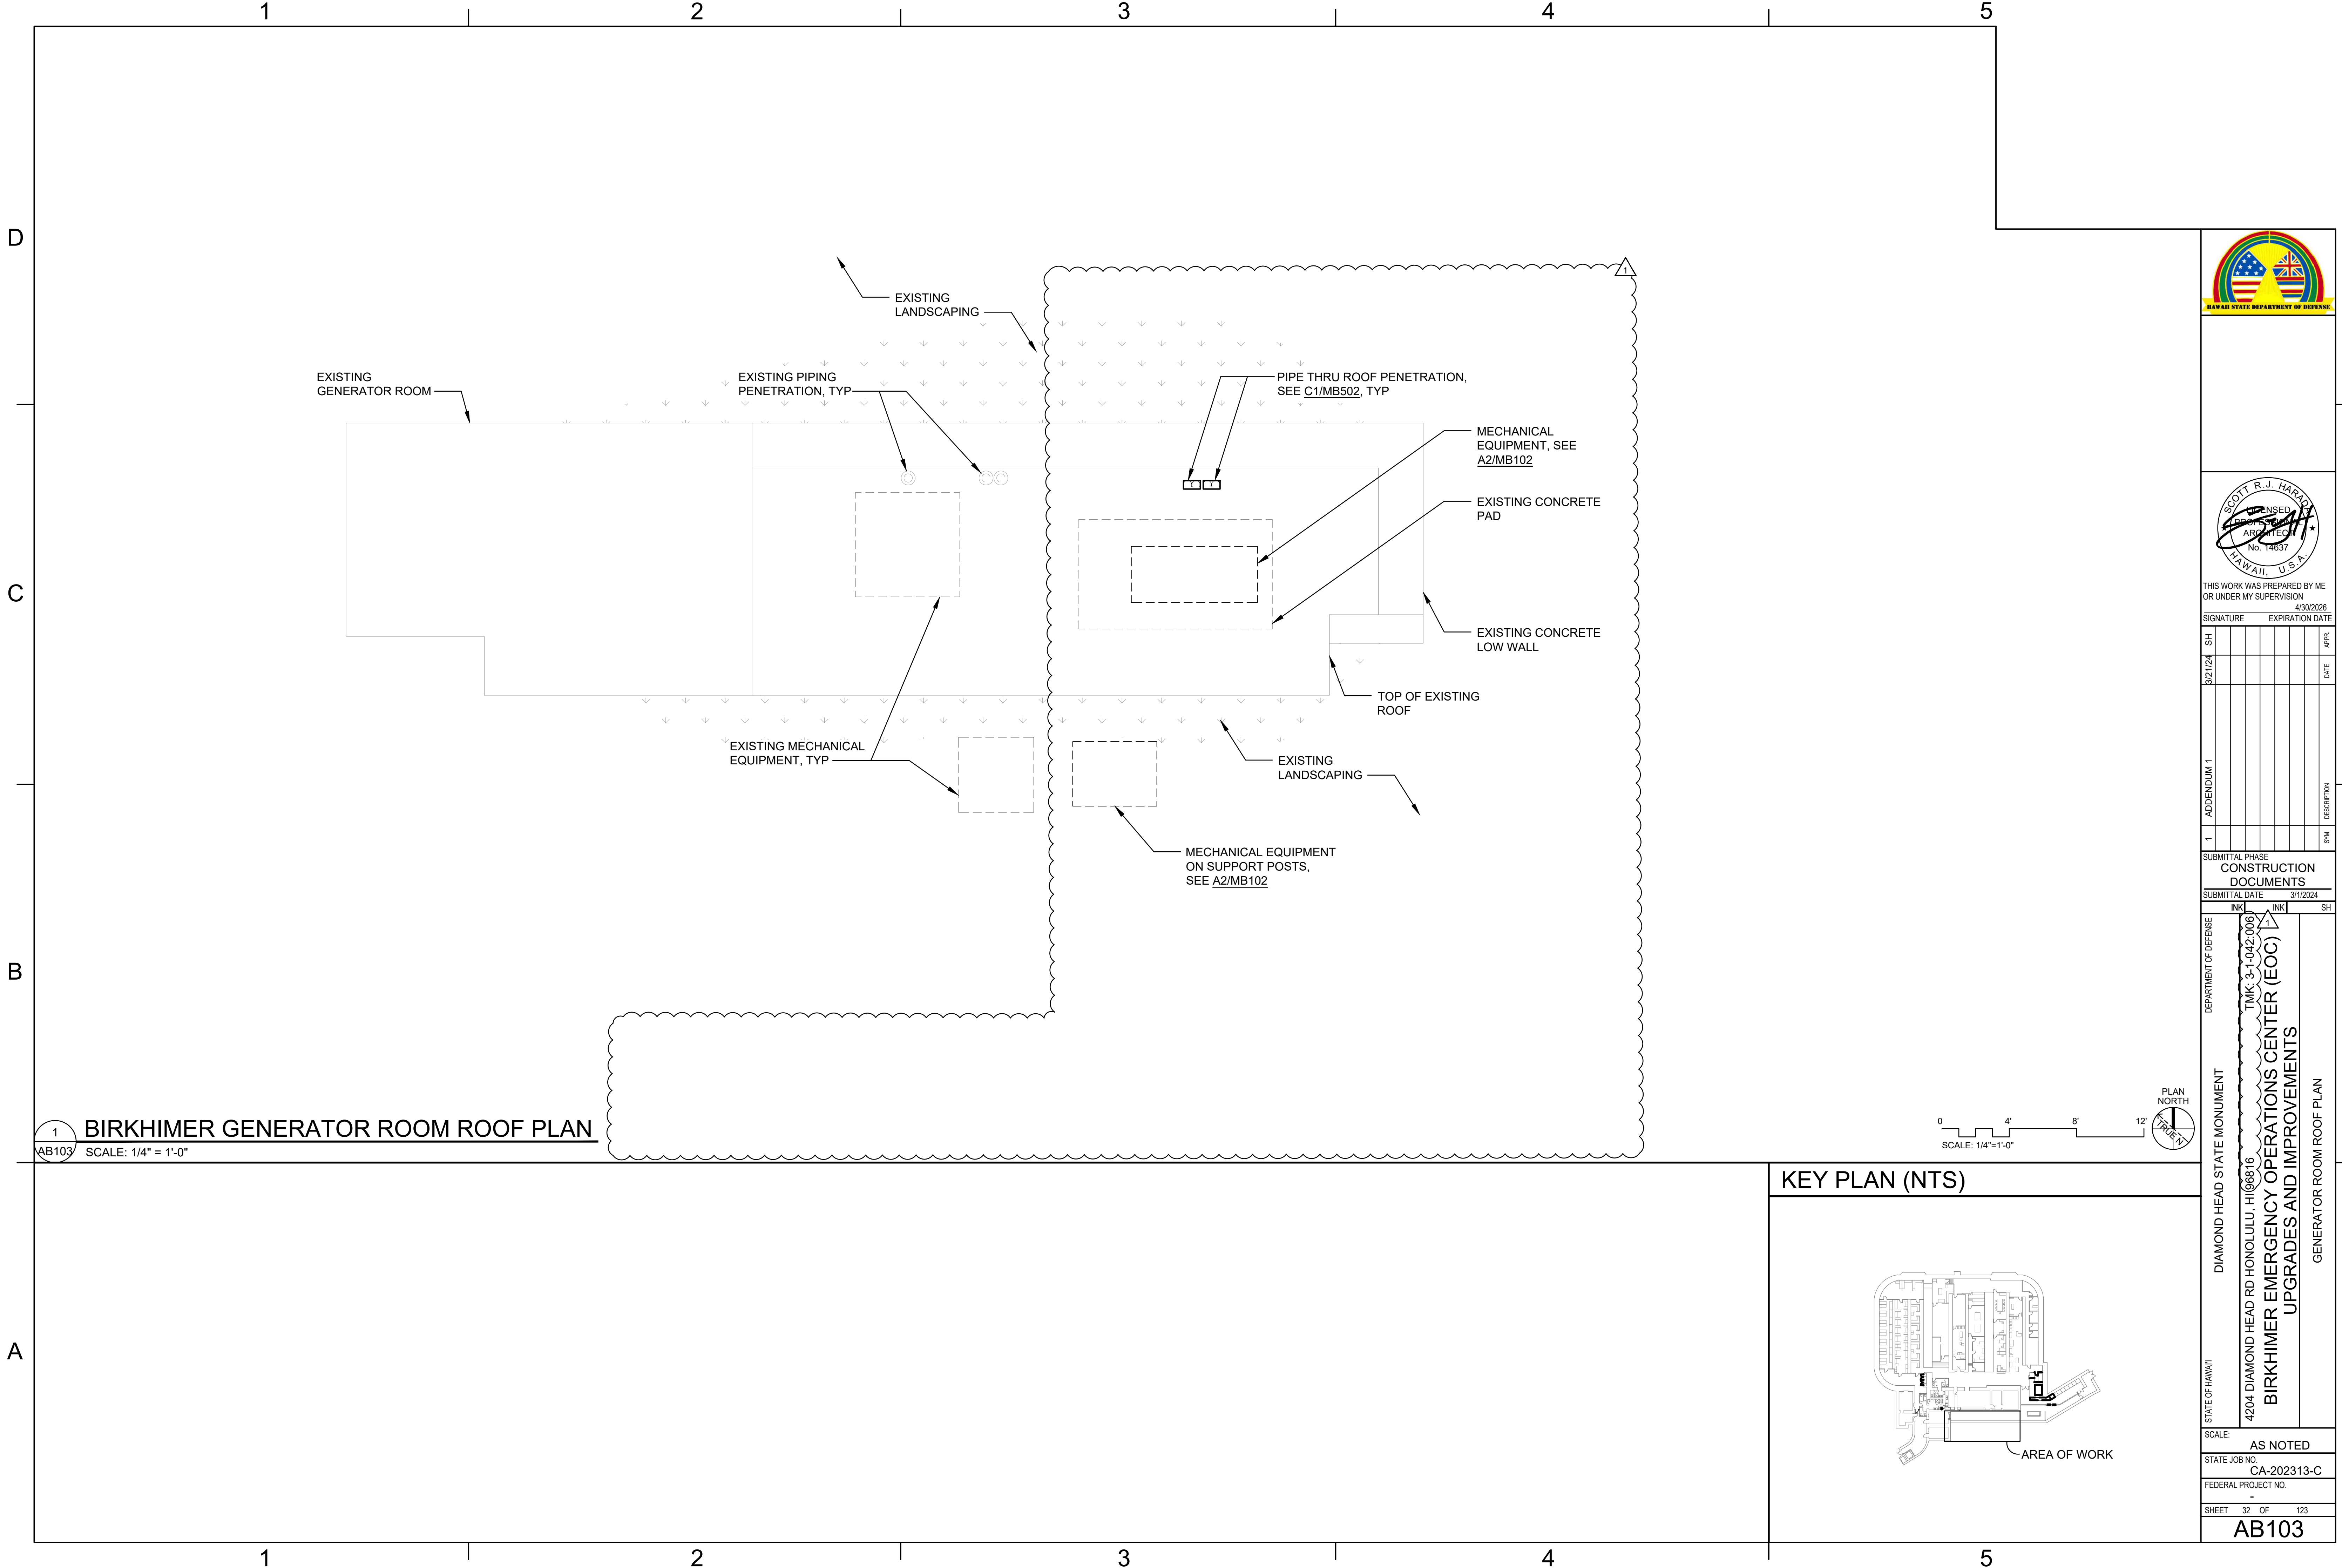

THIS WORK WAS PREPARED BY ME OR UNDER MY SUPERVISION

SIGNATURE EXPIRATION DATE

3/21/24 DATE

APPRO

DATE

DESCRIPTION

SYN

1

ADDENDUM 1

CONSTRUCTION DOCUMENTS

SUBMITTAL DATE 3/1/2024

INK INK INK SH

DEPARTMENT OF DEFENSE

DIAMOND HEAD STATE MONUMENT

4204 DIAMOND HEAD RD HONOLULU, HI 96816

TWK: 3-1-042:006

BIRKHIMER EMERGENCY OPERATIONS CENTER (EOC)

UPGRADES AND IMPROVEMENTS

GENERATOR ROOM ROOF PLAN

SCALE: AS NOTED

STATE JOB NO. CA-202313-C

FEDERAL PROJECT NO.

SHEET 32 OF 123

AB103

MECHANICAL GENERAL NOTES:

1. THE ENTIRE INSTALLATION SHALL COMPLY WITH ALL APPLICABLE REQUIREMENTS OF THE BUILDING CODE OF THE CITY & COUNTY OF HONOLULU, STATE DEPARTMENT OF HEALTH REGULATIONS, 2018 UNIFORM PLUMBING CODE, NFPA 99, NFPA 13, AND ALL OTHER AGENCIES HAVING JURISDICTION.
2. THE DRAWINGS AND SPECIFICATIONS ARE INTENDED TO COVER THE COMPLETE INSTALLATION OF SYSTEMS TO FUNCTION AS DESCRIBED AND SPECIFIED. THE OMISSION OF REFERENCE TO ANY NECESSARY ITEM OF LABOR OR MATERIAL SHALL NOT RELIEVE THE CONTRACTOR FROM PROVIDING SUCH LABOR AND MATERIAL.
3. THE CONTRACTOR SHALL PROVIDE ALL MATERIAL AND EQUIPMENT INCLUDING CUTTING, REPAIRING AND REFINISHING AS REQUIRED FOR COMPLETE AND OPERATING SYSTEMS UNLESS OTHERWISE INDICATED IN THE PLANS AND SPECIFICATIONS. "PROVIDE" SHALL MEAN TO PROCURE ALL NECESSARY MATERIALS AND INSTALL A COMPLETE WORKING INSTALLATION AS REFERENCED ON THE CONSTRUCTION DRAWINGS.
4. INSTALL ALL EQUIPMENT AND MATERIALS IN A FIRST CLASS OR "WORKMANLIKE" MANNER WHERE EQUIPMENT AND MATERIALS MUST BE INSTALLED WITH ACCEPTABLE CARE AND QUALITY CONFORMING TO RECOGNIZED COMMERCIAL STANDARDS.
5. ALL EQUIPMENT SHALL BE CAPABLE OF FITTING INTO THE SPACES ALLOCATED WHILE MEETING THE MANUFACTURER'S RECOMMENDED ACCESS REQUIREMENTS. REVIEW ALL SPACES WHERE EQUIPMENT IS TO BE INSTALLED PRIOR TO ORDERING OF EQUIPMENT AND NOTIFY THE ENGINEER OF ANY INADEQUATE CLEARANCES OR CONDITIONS THAT WILL PREVENT THE PROPER INSTALLATION, MAINTENANCE, AND OPERATION OF THE EQUIPMENT.
6. DRAWINGS DO NOT ATTEMPT TO SHOW EXACT DETAILS OF DUCTWORK. PROVIDE OFFSETS AS NECESSARY TO AVOID LOCAL OBSTRUCTIONS OR INTERFERENCE WITH OTHER TRADES. REVIEW ALL DUCT RUNS PRIOR TO FABRICATION AND IMMEDIATELY NOTIFY THE ENGINEER OF ANY INTERFERENCE AND/OR LACK OF ADEQUATE CLEARANCES.
7. SHOULD PROJECT CONDITIONS REQUIRE REARRANGEMENT OF WORK, MARK SUCH CHANGES ON THE AS-BUILT DRAWINGS. IF THESE CHANGES REQUIRE ALTERNATE METHODS TO THOSE APPROVED BY THE CONTRACT DOCUMENTS, SUBMIT SHOP DRAWINGS SHOWING THE PROPOSED ALTERNATE METHODS TO THE ENGINEER FOR REVIEW. DO NOT PROCEED UNTIL REVIEWED.
8. REPAIR AND REFINISH ALL EXPOSED MATERIAL TO MATCH ADJACENT SURFACES OR AS INDICATED.

ADDITIVE BID ALTERNATES		
ALTERNATE	LOCATION	DESCRIPTION
#1	B303	ALL WORK ASSOCIATED WITH LIGHT FIXTURE REPLACEMENT IN THE ADMIN SECTION OF BUILDING B303.
#2	B303	ALL WORK ASSOCIATED WITH THE INSTALLATION OF THE NEW SMART ELECTRIC METER.
#3	B303	ALL WORK ASSOCIATED WITH THE INSTALLATION OF THE NEW SMART WATER METER.
#4	BIRKHIMER	ALL WORK ASSOCIATED WITH THE INSTALLATION OF THE NEW SMART ELECTRIC METER.
#5	BIRKHIMER	ALL WORK ASSOCIATED WITH THE INSTALLATION OF THE NEW SMART WATER METER.
#6	BIRKHIMER	ALL WORK ASSOCIATED WITH BATHROOM PLUMBING UPGRADES.
#7	PSB	ALL WORK ASSOCIATED WITH THE INSTALLATION OF THE NEW SMART ELECTRIC METER.

CITY AND COUNTY OF HONOLULU
REVISED ORDINANCE CHAPTER 32,
HONOLULU COUNTY CODE 1990, AS
AMENDED
TO THE BEST OF MY KNOWLEDGE, THIS PROJECT'S DESIGN SUBSTANTIALLY
CONFORMS TO THE BUILDING ENERGY CONSERVATION CODE FOR:

JASON Y. HWANG
LICENSED
PROFESSIONAL
ENGINEER
No. 14297-M
HAWAII, U.S.A.

X

MECHANICAL SYSTEMS

SIGNATURE:

DATE: 04-30-2024

NAME: JASON Y. HWANG

TITLE: PROJECT MANAGER

LICENSE NO.: 14297-M

MECHANICAL LEGEND		
SYMBOL	ABBRV.	DESCRIPTION
	ACCU	AIR COOLED CONDENSING UNIT
	AHU	AIR HANDLING UNIT
	BDD	BACKDRAFT DAMPER
		CAPPED/STUBOUT PIPE
	CD	CONDENSATE PIPING
	CP	CONDENSATE PUMP
	CFM	CUBIC FEET PER MINUTE
	CONC	CONCRETE
	DEMO	DEMOLITION
		DENOTES DEMOLITION/REMOVAL
		ITEM TO BE REMOVED / DEMOLISHED
	DIA	DIAMETER
	DWG	DRAWING
	SD	DUCT SMOKE DETECTOR
	(E)	EXISTING
	EA	EXHAUST AIR
	EAR	EXHAUST AIR REGISTER
	EF	EXHAUST FAN
	EXH	EXHAUST
	FCU	FAN COIL UNIT
	GALV.	GALVANIZED
	HZ	HERTZ
	IN.	INCHES
	MAX.	MAXIMUM
	MIN.	MINIMUM
	NO.	NUMBER
	NTS	NOT TO SCALE
	POR/POC	POINT OF REMOVAL/POINT OF CONNECTION
	RA	RETURN AIR
	RAR	RETURN AIR REGISTER
	RMS	ROOMS
	RL	REFRIGERANT LIQUID
	RS	REFRIGERANT SUCTION
	SA	SUPPLY AIR
	SAD	SUPPLY AIR DIFFUSER
	SHT	SHEET
	SYM.	SYMBOL
	T-STAT	THERMOSTAT
	TA	TRANSFER AIR
	TAG	TRANSFER AIR GRILLE
	TYP.	TYPICAL
	VAV	VARIABLE AIR VOLUME
	VFD	VARIABLE FREQUENCY DRIVE
	V	VOLTS
	VD	VOLUME DAMPER

JASON Y. HWANG
LICENSED
PROFESSIONAL
ENGINEER
No. 14297-M
HAWAII, U.S.A.

THIS WORK WAS PREPARED BY ME
OR UNDER MY SUPERVISION
SIGNATURE:

4/30/2026

 EXPIRATION DATE

APPROVED
DATE

DESCRIPTION

DEPARTMENT OF DEFENSE
DIAMOND HEAD STATE MONUMENT
4204 DIAMOND HEAD RD HONOLULU, HI 96816
BIRKHIMER EMERGENCY OPERATIONS CENTER (EOC)
UPGRADES AND IMPROVEMENTS
GENERAL NOTES AND LEGENDS

TMK: 3-1-042:006

SCALE: AS NOTED

STATE JOB NO. CA-202313-C

FEDERAL PROJECT NO. -

SHEET 34 OF 123

M-001

PHASING NOTES:

CONSTRUCTION OF DUCTWORK REPLACEMENT TO TAKE PLACE OVER MULTIPLE PHASES. REFER TO SPECIFICATIONS FOR AVAILABLE NON-BUSINESS HOUR TIMES. PROVIDE TEMPORARY A/C FOR ALL DISABLED AREAS. CONTRACTOR TO DUCT EXHAUST WITHOUT IMPACTING OPERATIONS AS WELL AS REMOVAL OF CONDENSATE. SEE SPEC FOR SPECIFIC CONSTRUCTION DURATION DAYS PER PHASE.

DEMO/NEW PHASE 1:

REMOVE AND REPLACE ALL SUPPLY AIR AND RETURN AIR DUCTWORK UP TO (E)AHU-1.

DEMO/NEW PHASE 2:

REMOVE AND REPLACE ALL SUPPLY AIR DUCTWORK FOR "MEDIA CENTER". INSTALL NEW TRANSFER AIR DUCTWORK.

DEMO/NEW PHASE 3:


REMOVE AND REPLACE ALL SUPPLY AIR DUCTWORK FOR "JIC" ROOM AND "STATE WARNING POINT ROOM". INSTALL NEW TRANSFER AIR DUCTWORK. *OFFICE STAFF WILL CONTINUE TO WORK DURING THIS CONSTRUCTION.

DEMO/NEW PHASE 4:

REMOVE AND REPLACE ALL SUPPLY AIR DUCTWORK FOR "OPEN OFFICE AREA" AND "LUNCHROOM". INSTALL NEW TRANSFER AIR DUCTWORK.


KEYNOTES:

- 1 DEMO ALL EXISTING SA/RA DUCTS.
- 2 DUCTWORK POR FOR FUTURE PHASE AT OVERLAP OF DASHED PHASE BOUNDARY, TYPICAL FOR ALL PHASE BOUNDARIES.

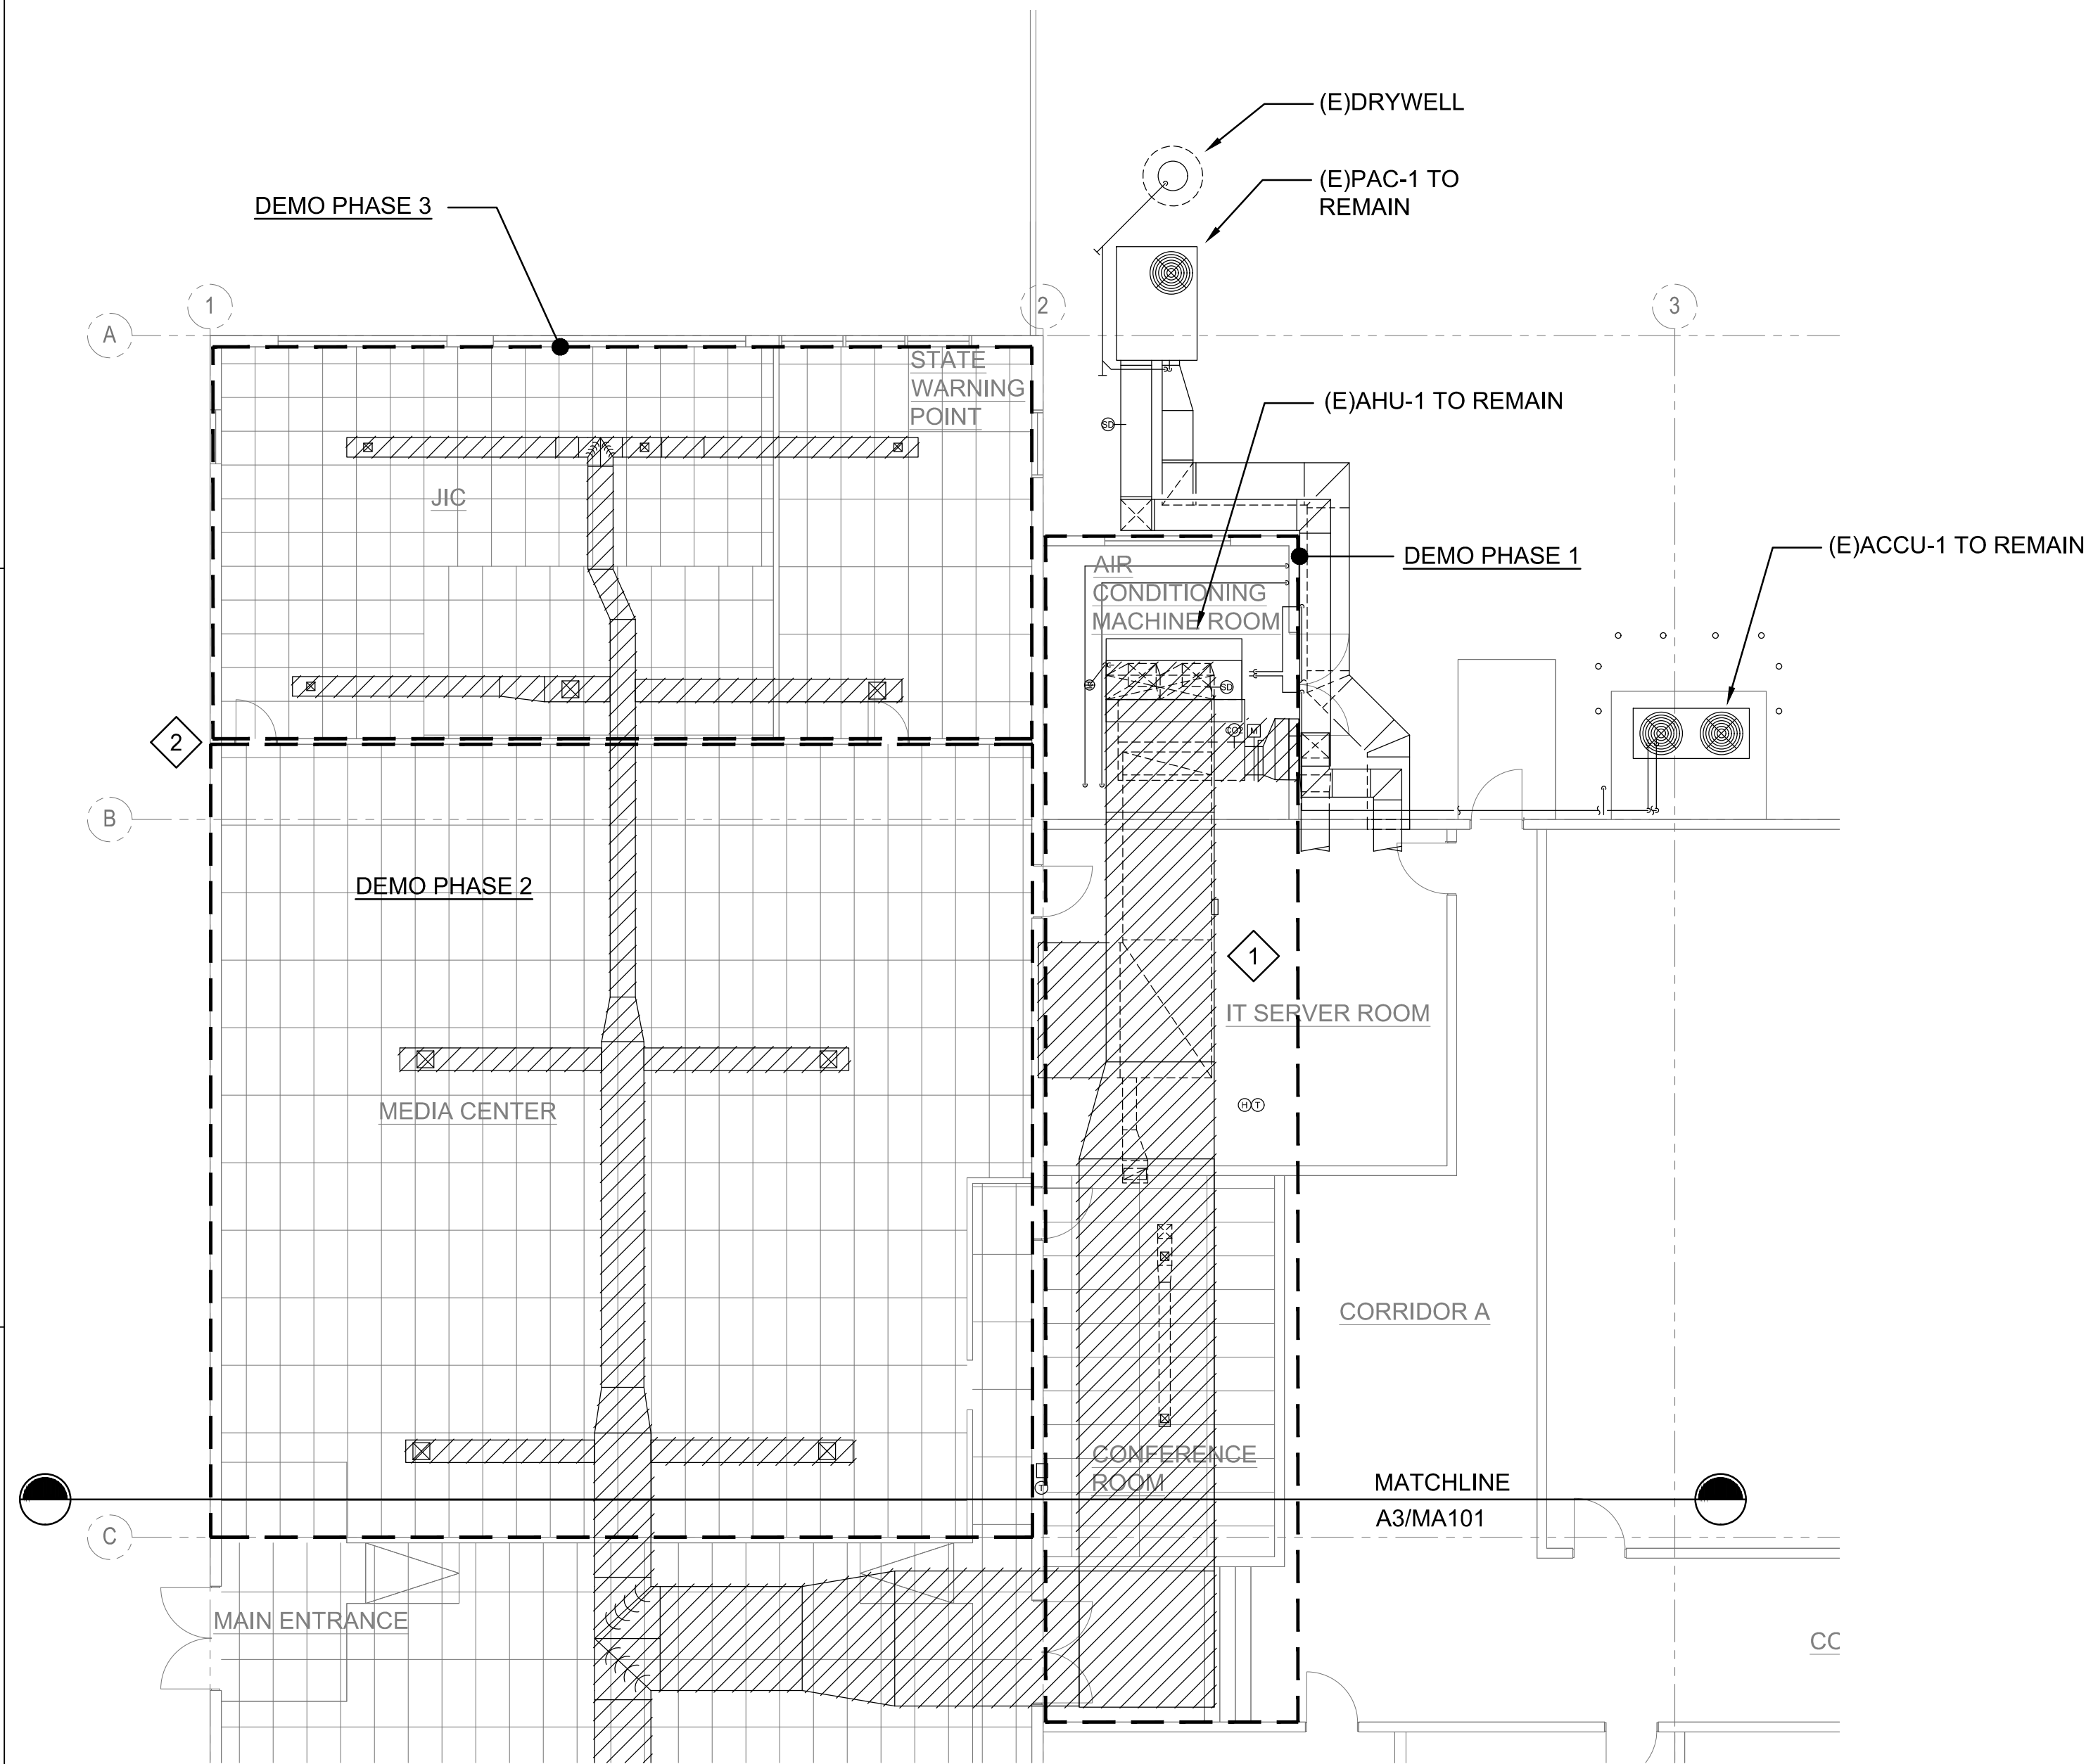

ENLARGED FLOOR PLAN - DEMO

SCALE: 1/8" = 1'-0"

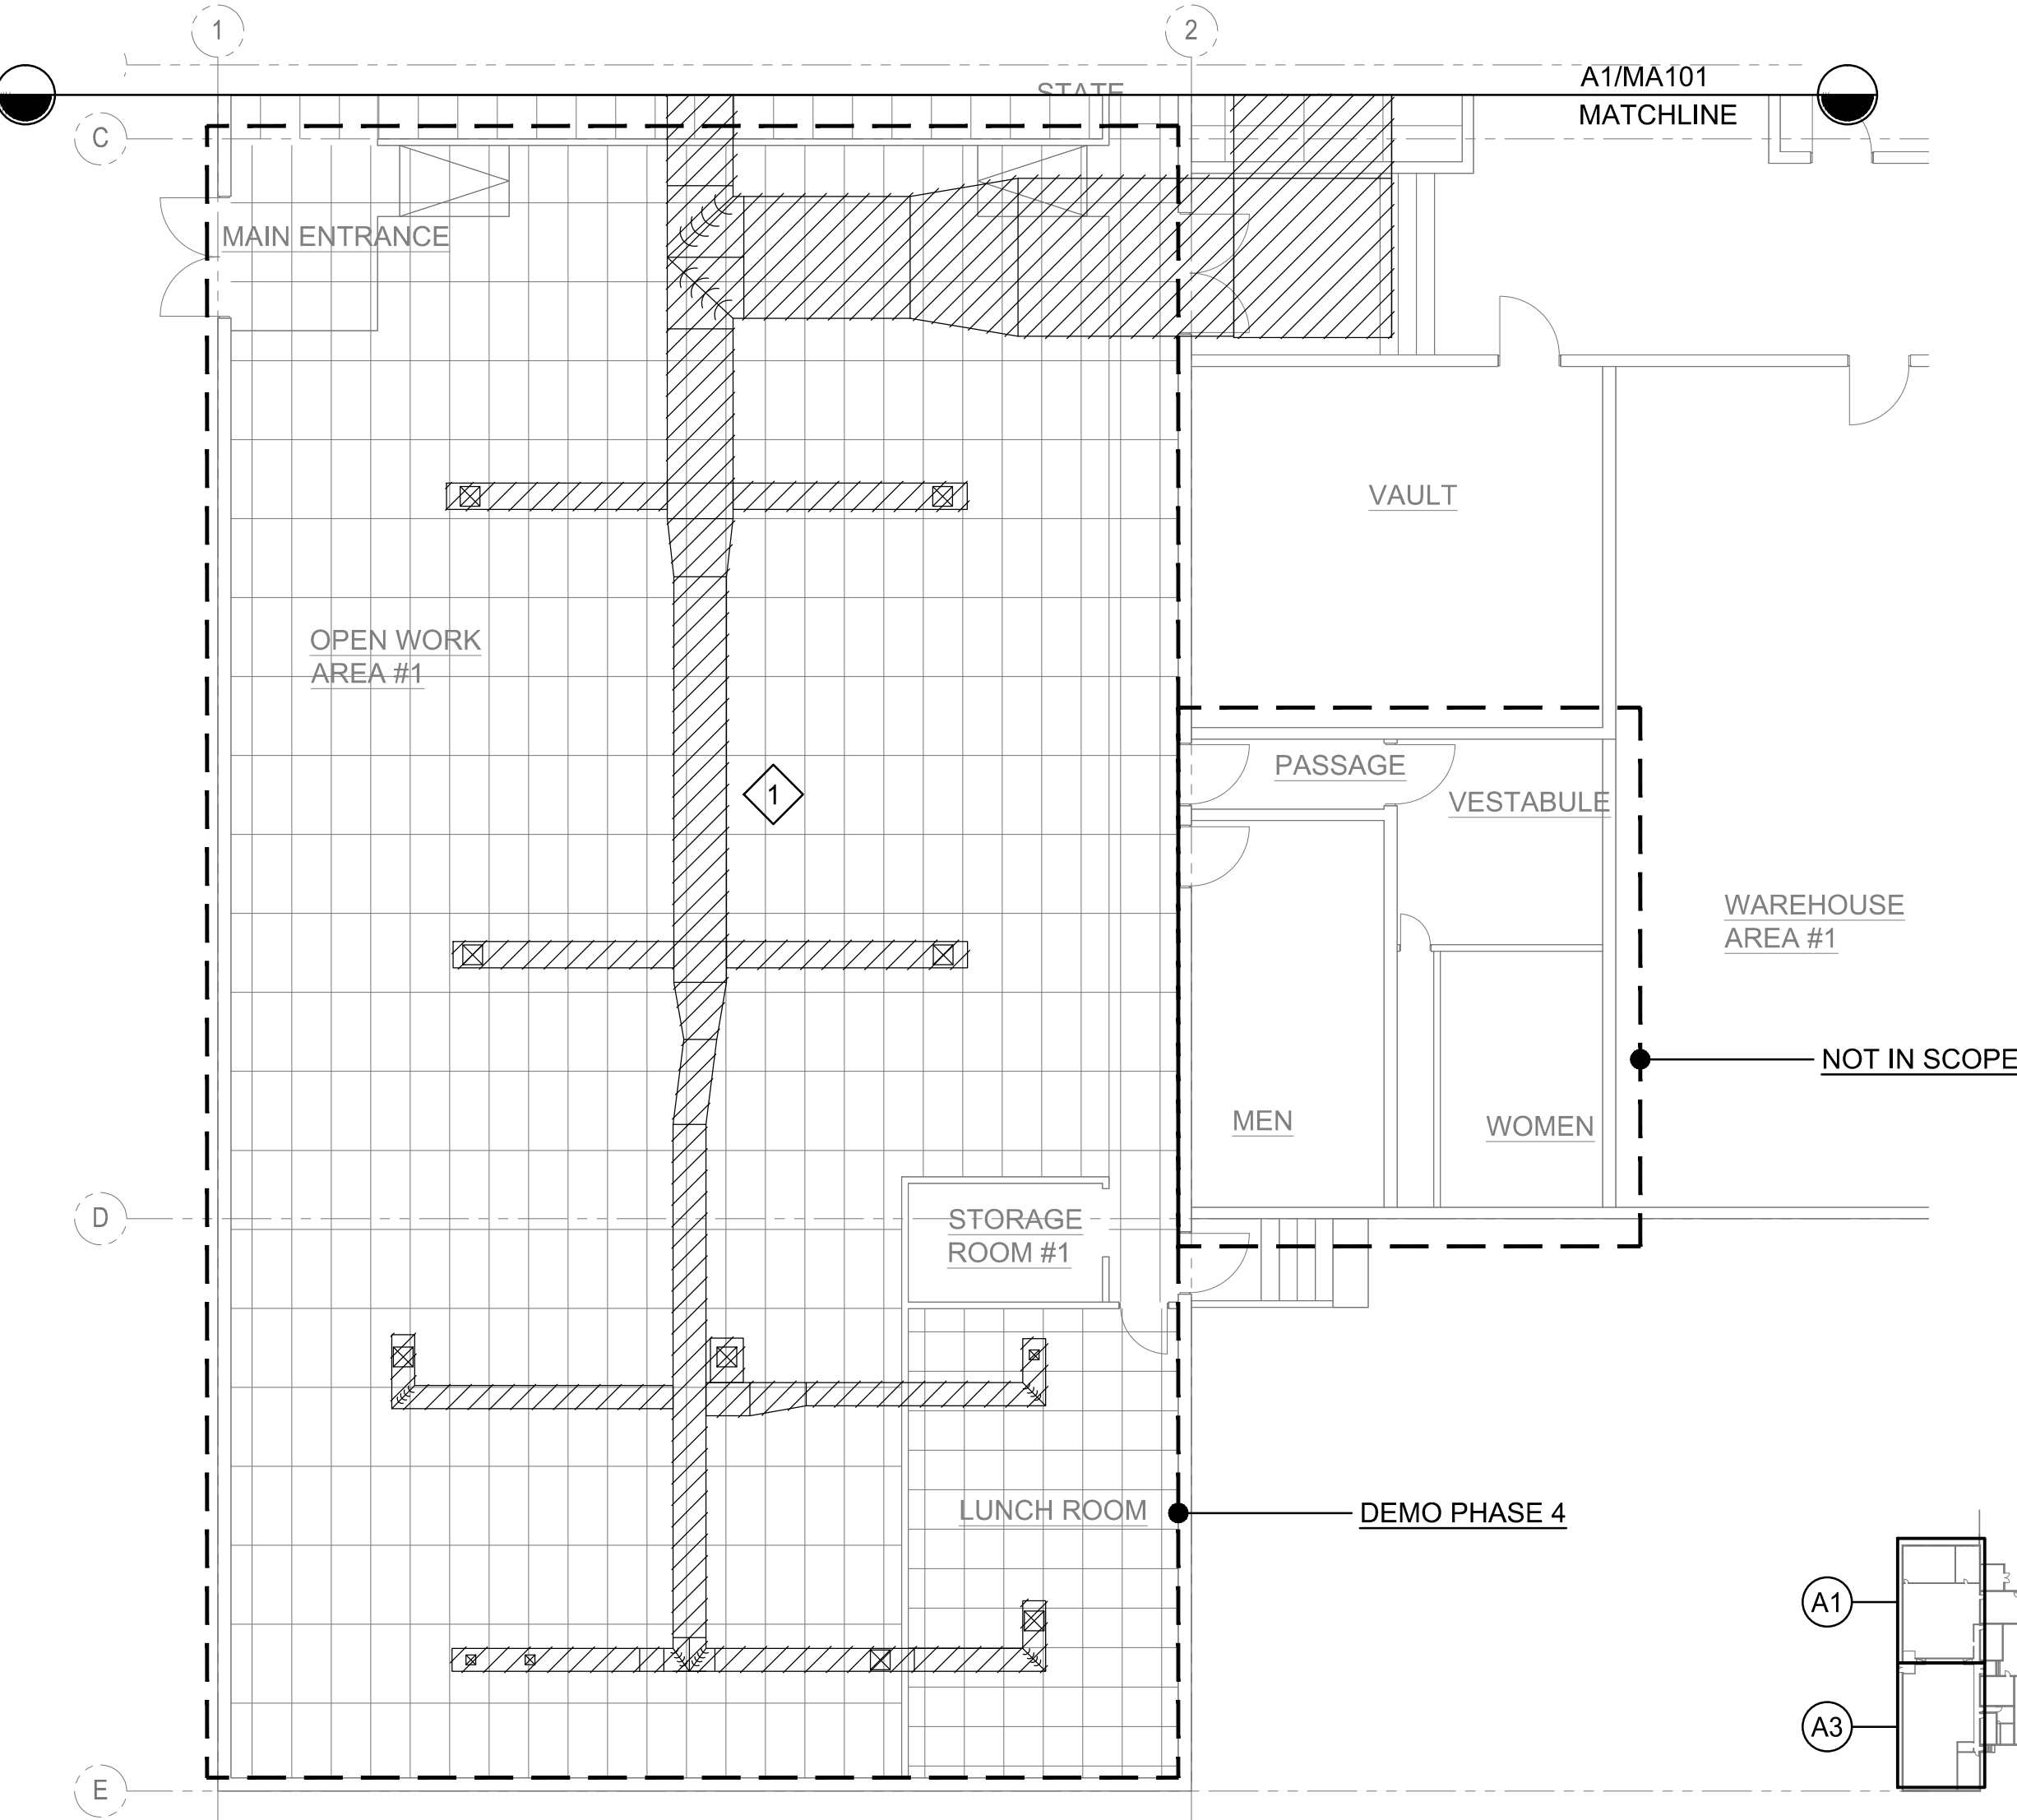

ENLARGED FLOOR PLAN - DEMO

SCALE: 1/8" = 1'-0"

KEY PLAN

NTS



THIS WORK WAS PREPARED BY ME OR UNDER MY SUPERVISION

SIGNATURE: *Yoon Hwang* EXPIRATION DATE: 4/30/2026

DATE: APR. 2024

SYN. DESCRIPTION

DEPARTMENT OF DEFENSE

DIAMOND HEAD STATE MONUMENT

STATE OF HAWAII

4204 DIAMOND HEAD RD HONOLULU, HI 96816

TMK: 3-1-042:006

BIRKHMER EMERGENCY OPERATIONS CENTER (EOC)

UPGRADES AND IMPROVEMENTS

ENLARGED FLOOR PLANS - DEMO


SCALE: AS NOTED

STATE JOB NO. CA-202313-C

FEDERAL PROJECT NO. -

SHEET 36 OF 123

MA101

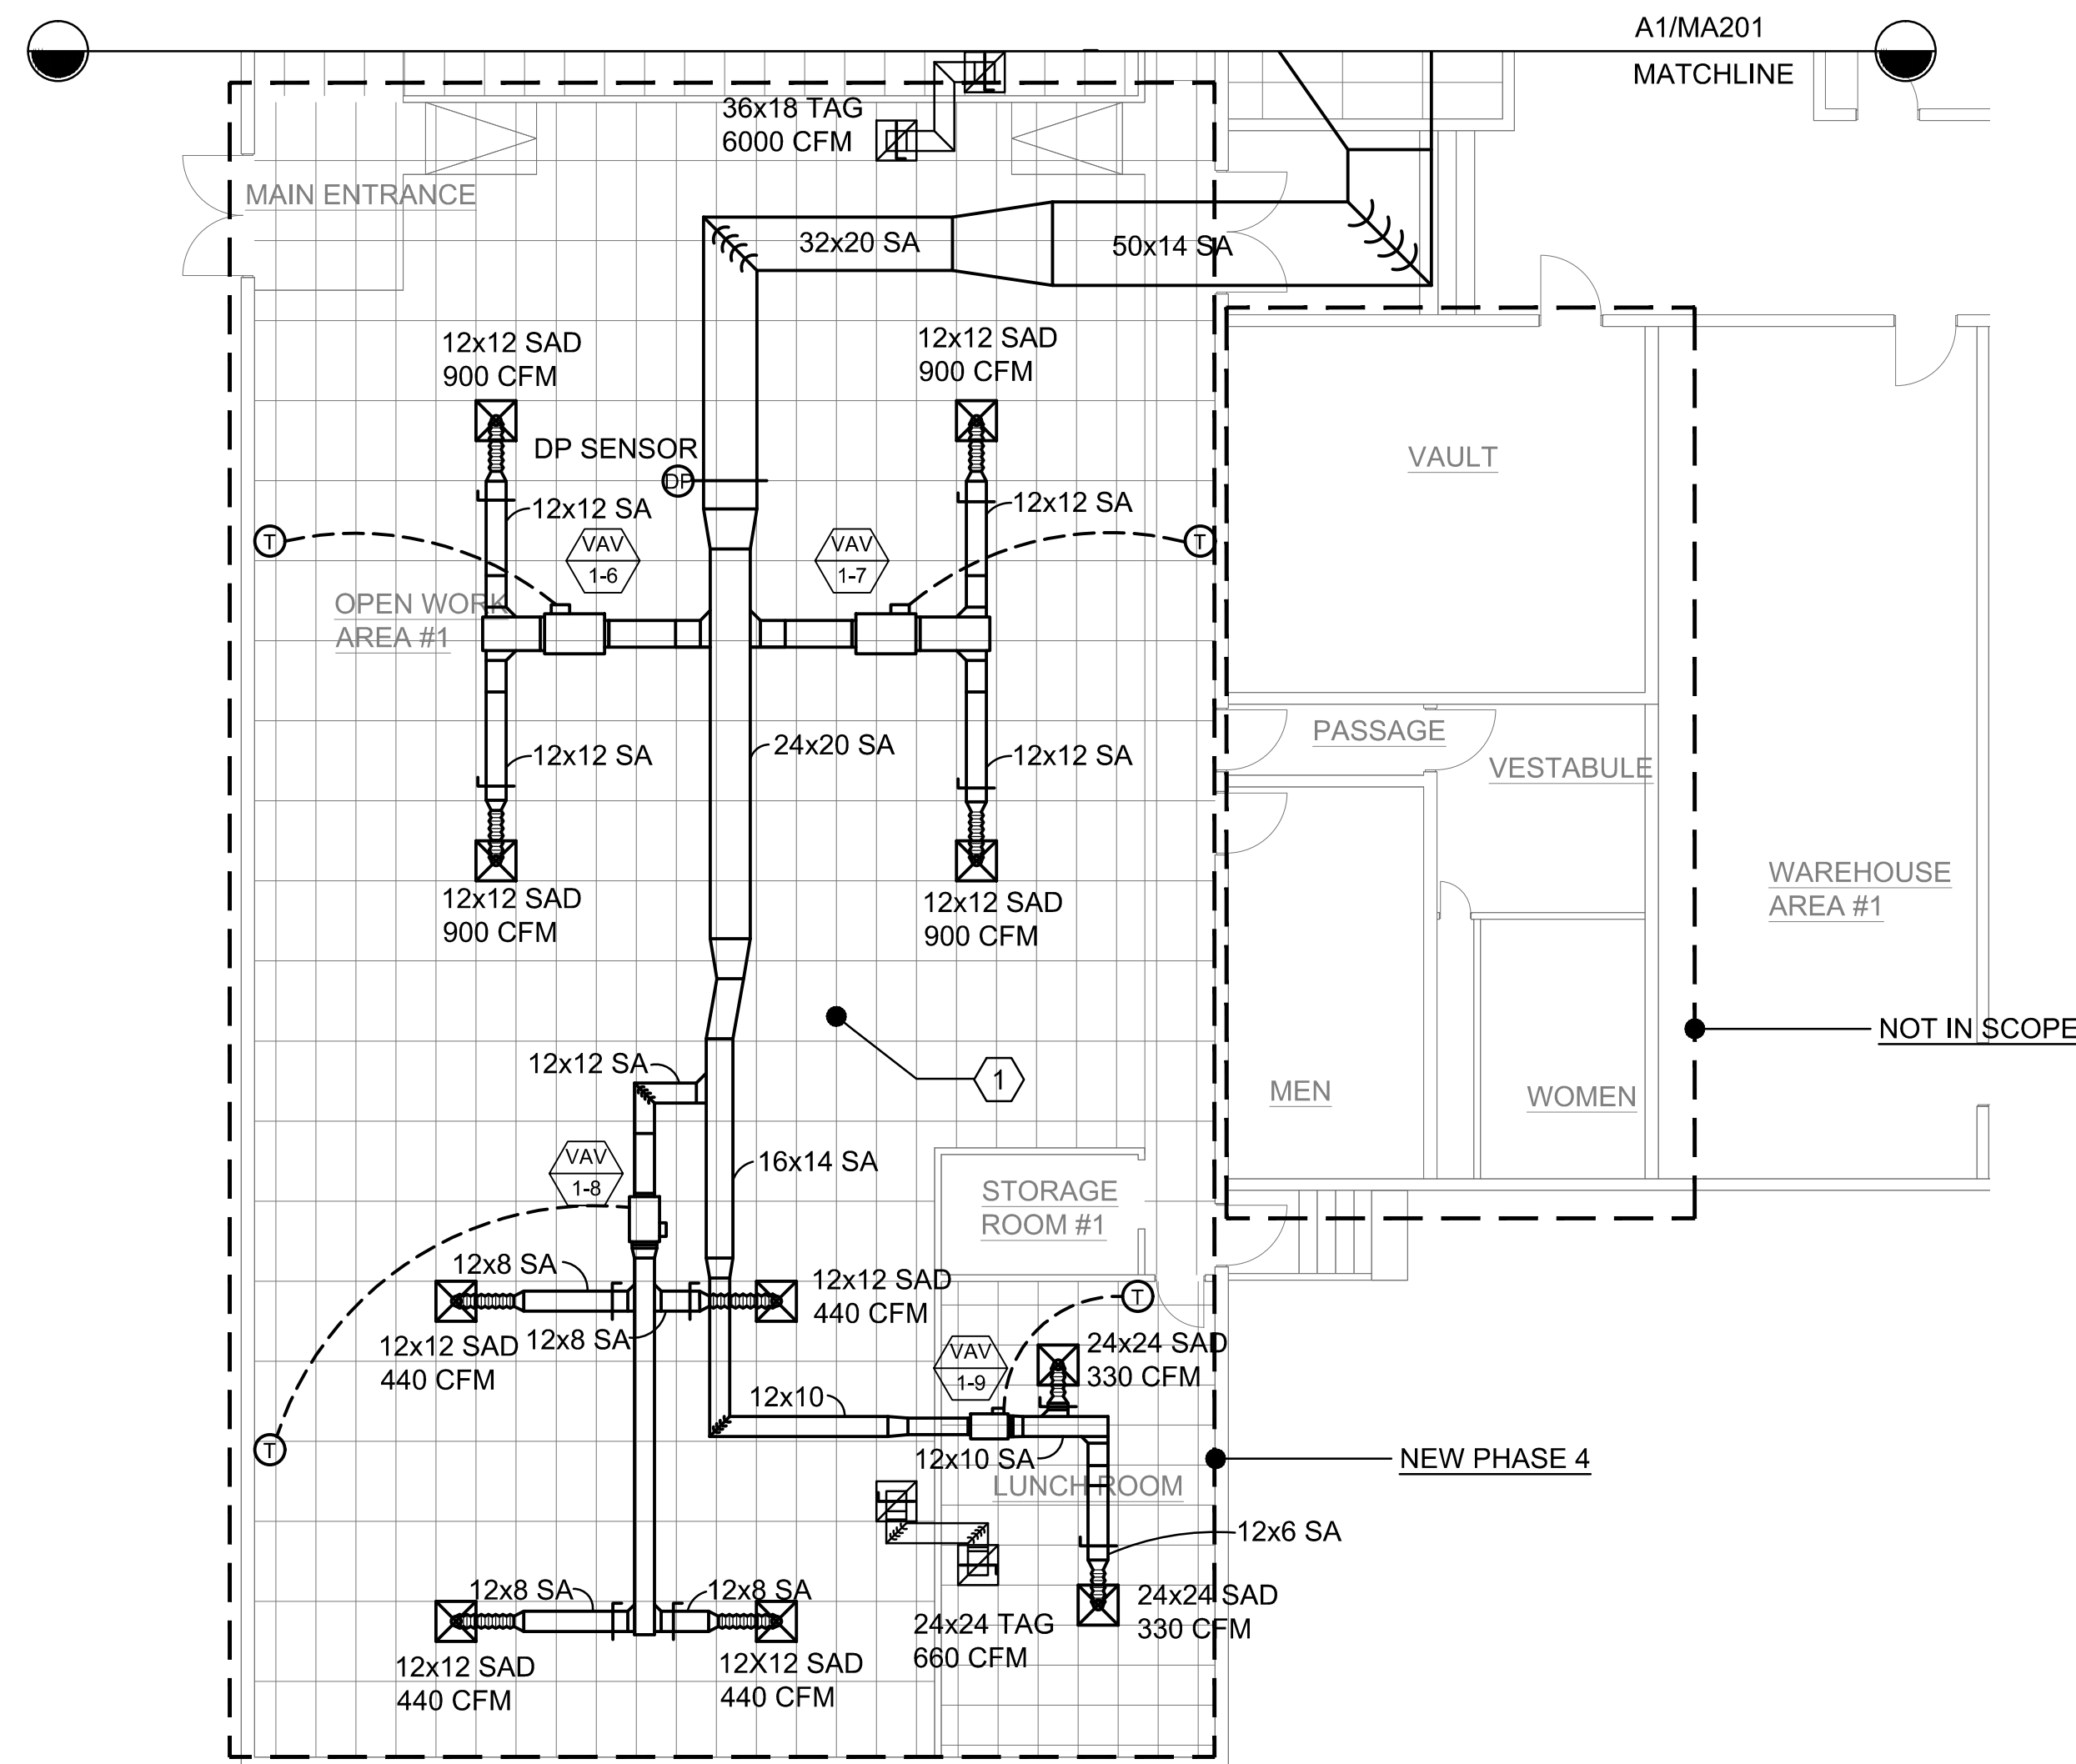

TRUE NORTH
PLAN NORTH

A1
MA201

ENLARGED FLOOR PLAN - NEW

SCALE: 1/8" = 1'-0"

0 2' 4' 8' 12' 16' 20' 24'


SCALE: 1/8" = 1'-0"



ENLARGED FLOOR PLAN - NEW
 SCALE: 1/8" = 1'-0"

0 2' 4' 8' 12' 16' 20' 24'
 SCALE: 1/8" = 1'-0"

-

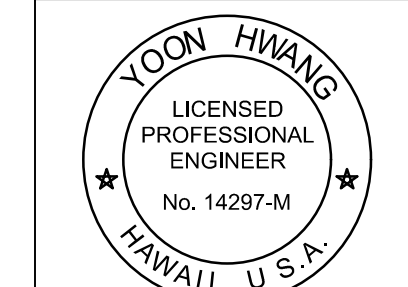

THIS WORK WAS PREPARED BY ME
OR UNDER MY SUPERVISION

James 4/30/2026
SIGNATURE EXPIRATION DATE

[illegible]

								DA

--	--	--	--	--	--	--	--	--

[illegible]

								SYS
SUBMITTAL PHASE								
CONSTRUCTION								

CONSTRUCTION DOCUMENTS		
SUBMITTAL DATE		03/01/2024
YH	FM	YH

OF DEFENSE	
-042:006	DC)

DEPARTMENT
TMK: 3-1
ER (EC

CENTRE
ENTS

MENT
ONS
/EME
NEW

TE MONU	ERATI	MPROV	PLANS -
---------	-------	-------	---------

HEAD STAIRS
HI 96816
COPY
AND IN
D FLOOR

MOND H
OLULU,
GENC
DES A
N LARGED

DIA	RD HON	EMER	PGRA	EN
-----	--------	------	------	----

AND HEAD
IMMER
U

OF HAWAII
DIAMOND
BIRKBE

STATE	4204	E
SCALE:		
AS NOTED		

STATE JOB NO.	CA-202313-C
FEDERAL PROJECT NO.	

SHEET 37 OF 123
MA201



U-BOLT PIPE CLAMP, TYP.

DOUBLE WALL FUEL PIPE

3" x 2" x 1/4"

1/4"

HOT DIP GALVANIZE ENTIRE ASSEMBLY

1-1/2" PIPE

WEDGE ANCHOR (TYP)

4" x 4" x 1/4" BASEPLATE W/ 4 WEDGE ANCHORS

1" GROUT

DOUBLE WALL FUEL PIPE (FOS/R)

CONTROL WIRE

Diagram illustrating the VAV terminal box and duct assembly. The diagram shows a cross-section of the terminal box and the duct connection. Key components and labels include:


- INSULATED MAIN SUPPLY DUCT
- CONICAL TEE BRANCH
- REDUCER WHERE SHOWN IN PLAN
- TRANSITION REQUIRED FROM VAV OUTLET SIZE TO DUCT
- COIL ACCESS (12" dimension)
- CONTROLLER
- INLET REDUCER IF REQUIRED
- FLEXIBLE DUCT CONNECTIONS. REFER TO PLANS FOR SIZE
- NOTE 3
- WANGER RODS SECURED TO STRUCTURE ABOVE (PRECAST CONCRETE DOUBLE TEE PLANKS W/CONCRETE TOPPING). REFER TO STRUCTURAL NOTES FOR ADDITIONAL ANCHORAGE REQUIREMENTS.
- AIRFLOW (indicated by an arrow)
- LENGTH OF STRAIGHT DUCT AS REQUIRED TO REDUCE LENGTH OF FLEX DUCT AS MINIMAL AS POSSIBLE

NOTES:

1. PROVIDE 8"x8" INTERNALLY INSULATED 1" STAND OFF ACCESS DOOR IN 12" INCH COIL ACCESS SECTION.
2. CONTROLLER ENCLOSURE, COIL ACCESS COIL, CONNECTIONS AND CONTROL VALVE ASSEMBLY SHALL BE ON THE SAME SIDE OF THE TERMINAL BOX.
3. 1-1/2" NOZZLE DIAMETERS STRAIGHT DUCT.

ANCHOR BOLT ULTIMATE LOAD VALUES IN 2000 PSI CONCRETE				
SIZE	MIN. EMBEDMENT	DRILL BIT	PULL-OUT (LBS.)	SHEAR (LBS.)
1/4"	1-1/8"	1/4"	877	1082
5/16"	1-1/8"	5/16"	892	1156
3/8"	1-1/2"	3/8"	1223	3238
1/2"	2-1/4"	1/2"	2999	5564
5/8"	2-3/4"	5/8"	3749	6198
3/4"	3-1/4"	3/4"	4978	9378
7/8"	3-7/8"	7/8"	6294	13687
1"	4-1/2"	1"	7329	17712
1-1/4"	5-1/2"	1-1/4"	13162	24206

VALUES SHOWN ARE AVERAGE ULTIMATE VALUES AND ARE OFFERED ONLY AS A GUIDE AND ARE NOT GUARANTEED. A SAFETY FACTOR OF 4:1 OR 25% IS GENERALLY ACCEPTED AS A SAFE WORKING LOAD. REFERENCE SHOULD BE MADE TO APPLICABLE CODES FOR THE SPECIFIC WORK RATIO.

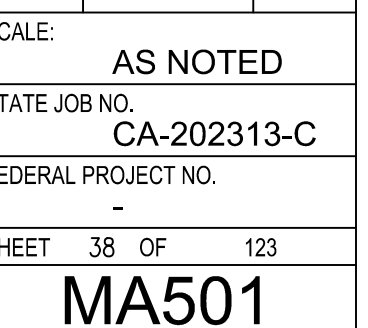

(E)AIR HANDLING UNIT SCHEDULE

UNIT ID	LOCATION	AREA SERVED	TOTAL CFM	OUTSIDE AIR CFM (MIN.)	ESP (IN.W.G)	ENTERING AIR		TOTAL HEAT BTUH	SENSIBLE HEAT BTUH	ELECTRICAL			DRIVE	UNIT WEIGHT (LBS)
						DB	WB			V/HZ/PH	MCA	MOCP		
(E)AHU-1	MECH RM	GENERAL OFFICE AREA	12,500	800 (200)	1.0	75.0	62.6	298,600	288,900	208/60/3	40.0	70	BELT	1,050

NOTES:

1. UNIT IS EXISTING AND SHOWN FOR REFERENCE ONLY.
2. PROVIDE NEW INVERTER DUTY RATED MOTOR.
3. PROVIDE VFD.

(E)AIR COOLED CONDENSING UNIT SCHEDULE

UNIT ID	UNIT SERVE	NOMINAL CAPACITY TONS	AMBIENT	REFRIGERANT	MIN. UNIT CAPACITY W/ DIGITAL COMPRESSOR	CAPACITY STEPS W/ DIGITAL OPTION	ELECTRICAL				UNIT WEIGHT (LBS)
							V/HZ/PH	EER	MCA	MOCp	
(E)ACCU-1	(E)AHU-1	25	95F	R410A	17%	22	208/60/3	11.0	120.2	150	1,115

NOTES:

1. UNIT IS EXISTING AND SHOWN FOR REFERNECE ONLY

FAN COIL UNIT (FCU) SCHEDULE

FCU NO.	AREA SERVED	TYPE	COOLING CAPACITY						AIRFLOW		ELECTRICAL	MAKE AND MODEL	REMARKS
			TOTAL (BTUH)	SENSIBLE (BTUH)	EAT DB°F	EAT WB°F	LAT DB°F	LAT WB°F	SA (CFM)	OA (CFM)	V/PH/Hz		
FCU-2	STATE WARNING POINT ROOM	CASSETTE	9,500	8,300	76.0	61.9	55.0	52.7	355	30	208/1/60	TRANE TPLA0A0121EA80A	1.2

NOTES

2. INDOOR FCU POWERED BY OUTDOOR ACCU.

AIR COOLED CONDENSING UNIT (ACCU) SCHEDULE


ACCU NO.	LOCATION	UNIT(S) SERVED	REFRIG. TYPE	CONDENSER FAN			ELECTRICAL DATA			EER	SIZE HxWxD (IN)	SOUND LEVEL (DBA)	WEIGHT (LBS)	MAKE & MODEL NO.	REMARKS
				AMBIENT AIR TEMP - EXTREME HIGH (F)	TYPE	FAN MOTOR OUTPUT (W)	MCA	MOCP	V/PH/Hz						
ACCU-2	EXTERIOR	FCU-2	R-410A	95	PROP	46	11	28	208/60/1	16.2	25x32x12	44	92	TRANE TRUYA0121KA70NA	1,2

NOTES:

1. REFRIGERANT PIPE QUANTITIES AND SIZE TO BE PER MANUFACTURER'S PIPING SCHEMATIC
2. COAT UNIT CASING AND COILS WITH COATING RATED FOR COASTAL ENVIRONMENT

VAV SCHEDULE - AHU-1

VAV ID	ROOM NAME	ROOM AIRFLOW (CFM)	VAV MAX FLOW (CFM)	VAV MIN FLOW (CFM)	TYPE	UNIT SIZE	INLET SIZE (IN)	MAX. INLET PD (IN W/G)	ELECTRICAL	REMARKS
1-1	JIC	1650	1650	545	DDC, SINGLE INLET	14	14	0.25	120/1/60	---
1-2	STATE WARNING POINT	400	400	132	DDC, SINGLE INLET	8	8	0.25	120/1/60	---
1-3	MEDIA CENTER	1800	1800	594	DDC, SINGLE INLET	16	16	0.25	120/1/60	---
1-4	MEDIA CENTER	1800	1800	594	DDC, SINGLE INLET	16	16	0.25	120/1/60	---
1-5	CONFERENCE ROOM	500	500	165	DDC, SINGLE INLET	8	8	0.25	120/1/60	---
1-6	GENERAL OFFICE AREA	1800	1800	594	DDC, SINGLE INLET	16	16	0.25	120/1/60	---
1-7	GENERAL OFFICE AREA	1800	1800	594	DDC, SINGLE INLET	16	16	0.25	120/1/60	---
1-8	GENERAL OFFICE AREA	1760	1760	581	DDC, SINGLE INLET	16	16	0.25	120/1/60	---
1-9	LUNCH ROOM	660	660	218	DDC, SINGLE INLET	10	10	0.25	120/1/60	---

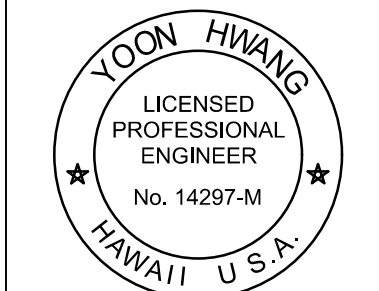

THIS WORK WAS PREPARED BY ME
OR UNDER MY SUPERVISION
2/20/2026 4/30/2026
SIGNATURE EXPIRATION DATE

[illegible]

SUBMITTAL PHASE		
CONSTRUCTION		
DOCUMENTS		
SUBMITTAL DATE		03/01/2024
YH	FM	YH

STATE OF HAWAII	DIAMOND HEAD STATE MONUMENT	DEPARTMENT OF DEFENSE
4204 DIAMOND HEAD RD HONOLULU, HI 96816	TMK: 3-1-042:006	
BIRKHAMER EMERGENCY OPERATIONS CENTER (EOC) UPGRADES AND IMPROVEMENTS		
		MECHANICAL SCHEDULES

SCALE:	AS NOTED		
STATE JOB NO.	CA-202313-C		
FEDERAL PROJECT NO.	-		
SHEET	39	OF	123
MA601			

1


2

3



4

5


D

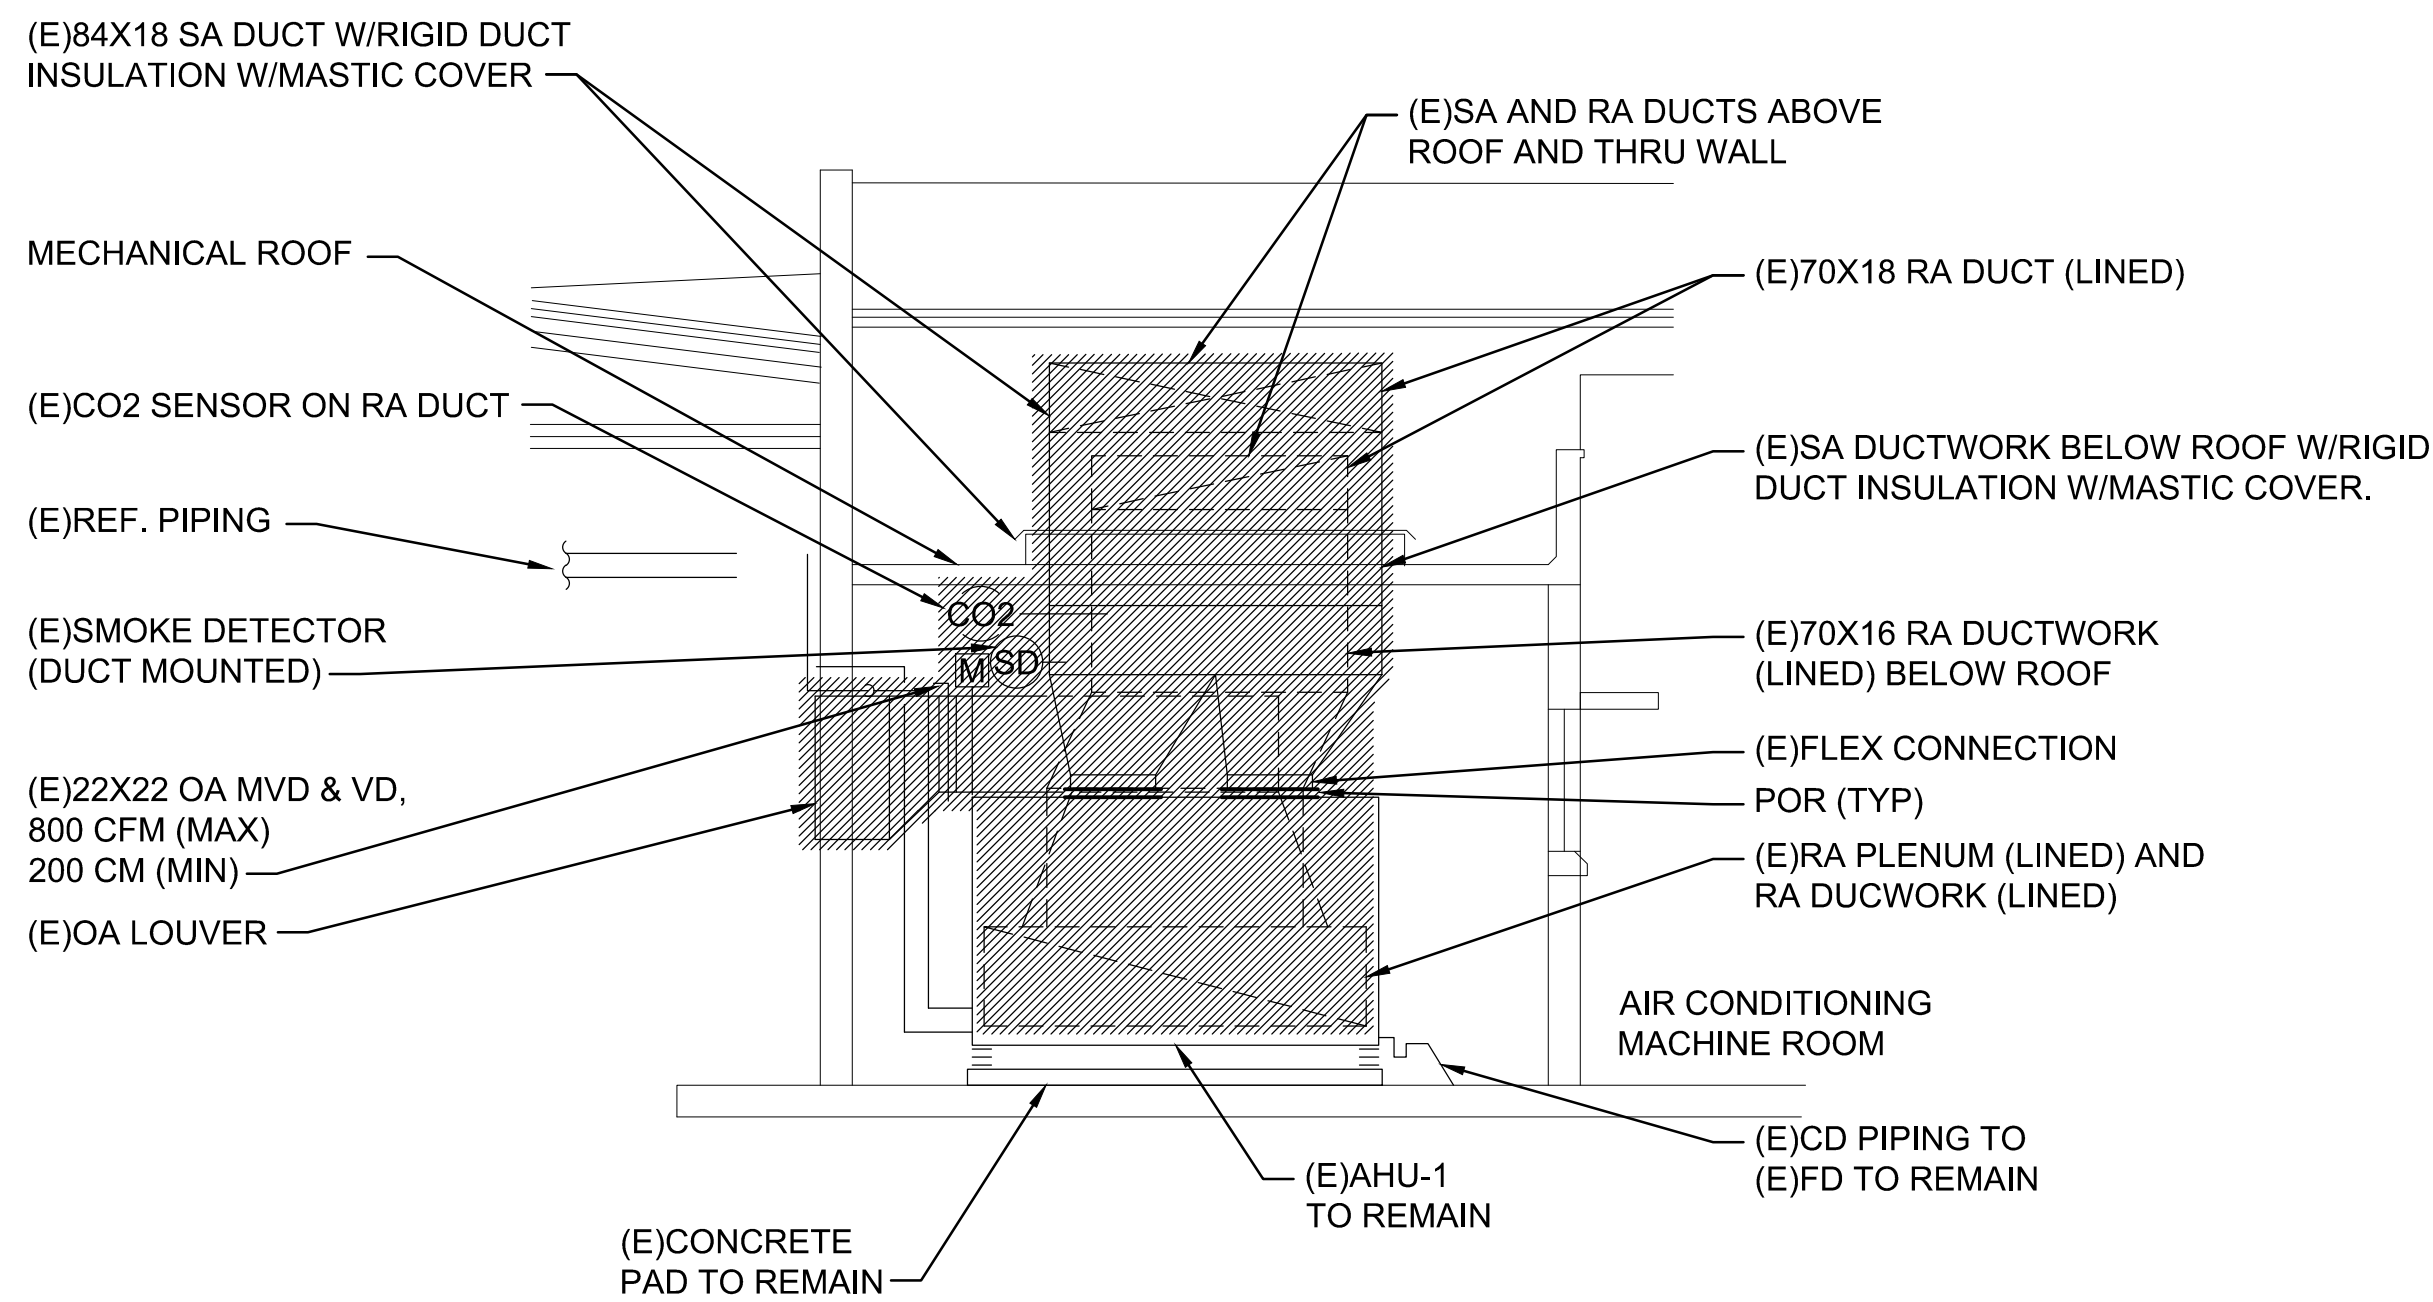

C1
MA702
MECHANICAL SECTION - DEMO
SCALE: 1/4" = 1'-0"

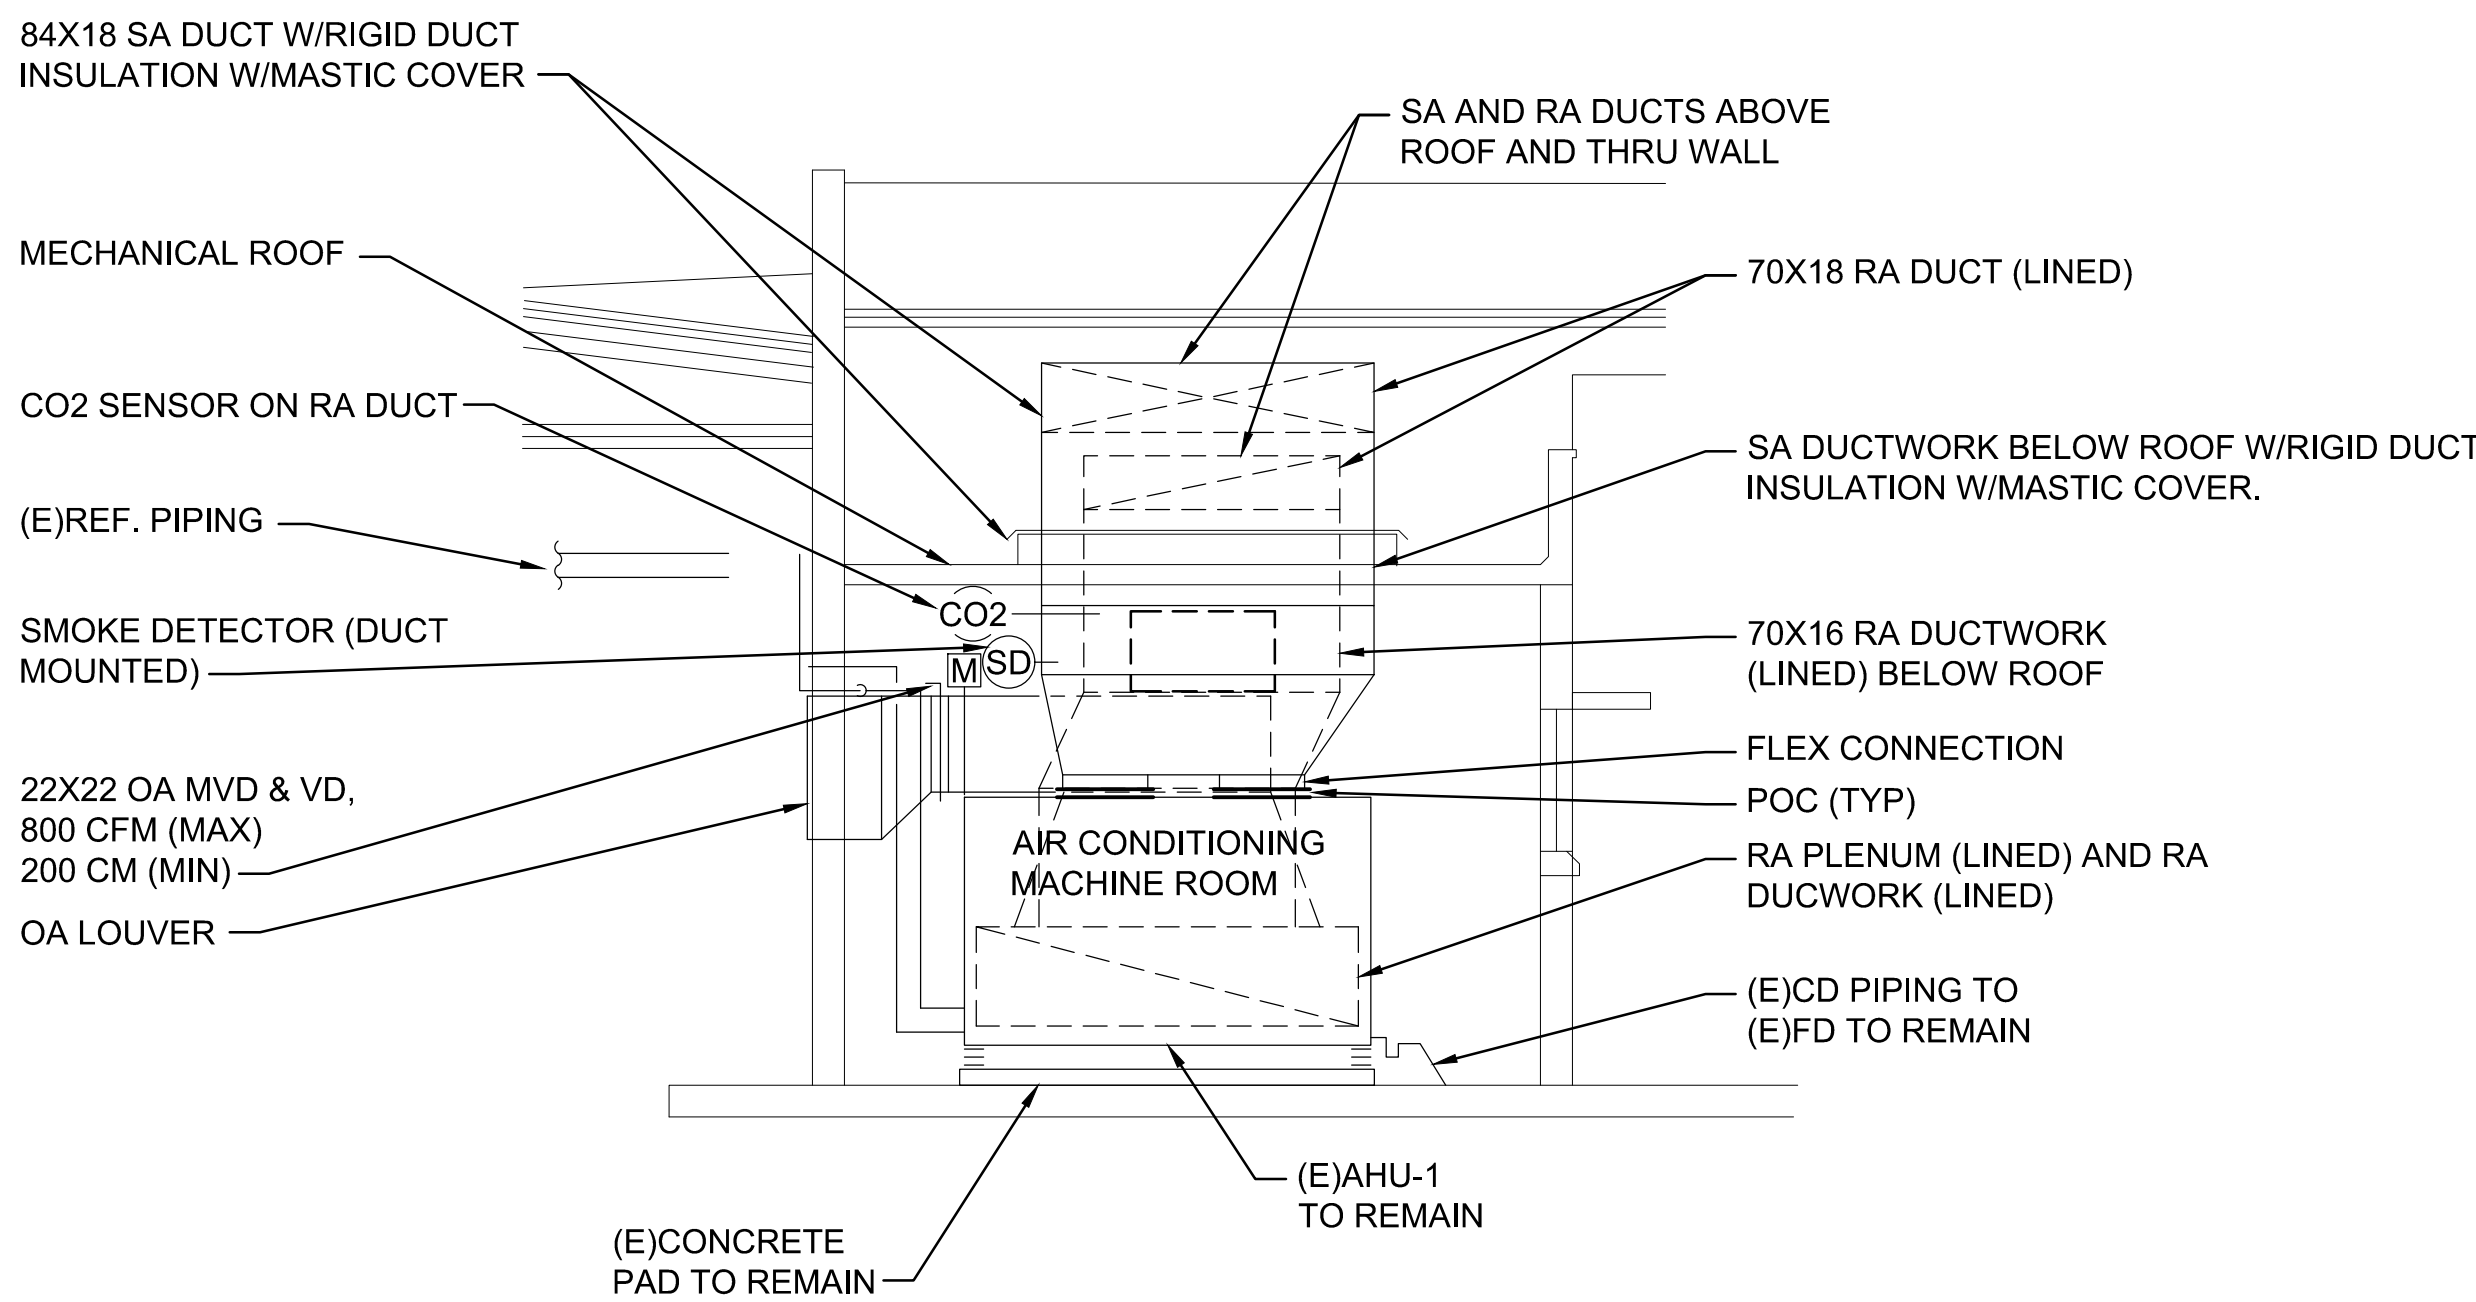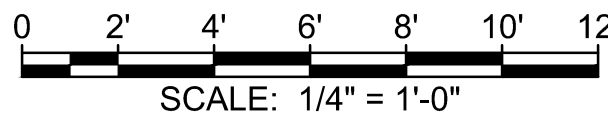


C3
MA702
MECHANICAL SECTION - NEW
SCALE: 1/4" = 1'-0"

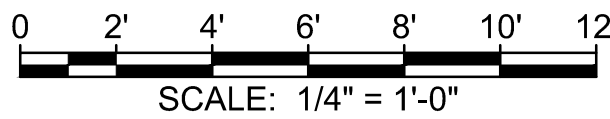



C

B



A

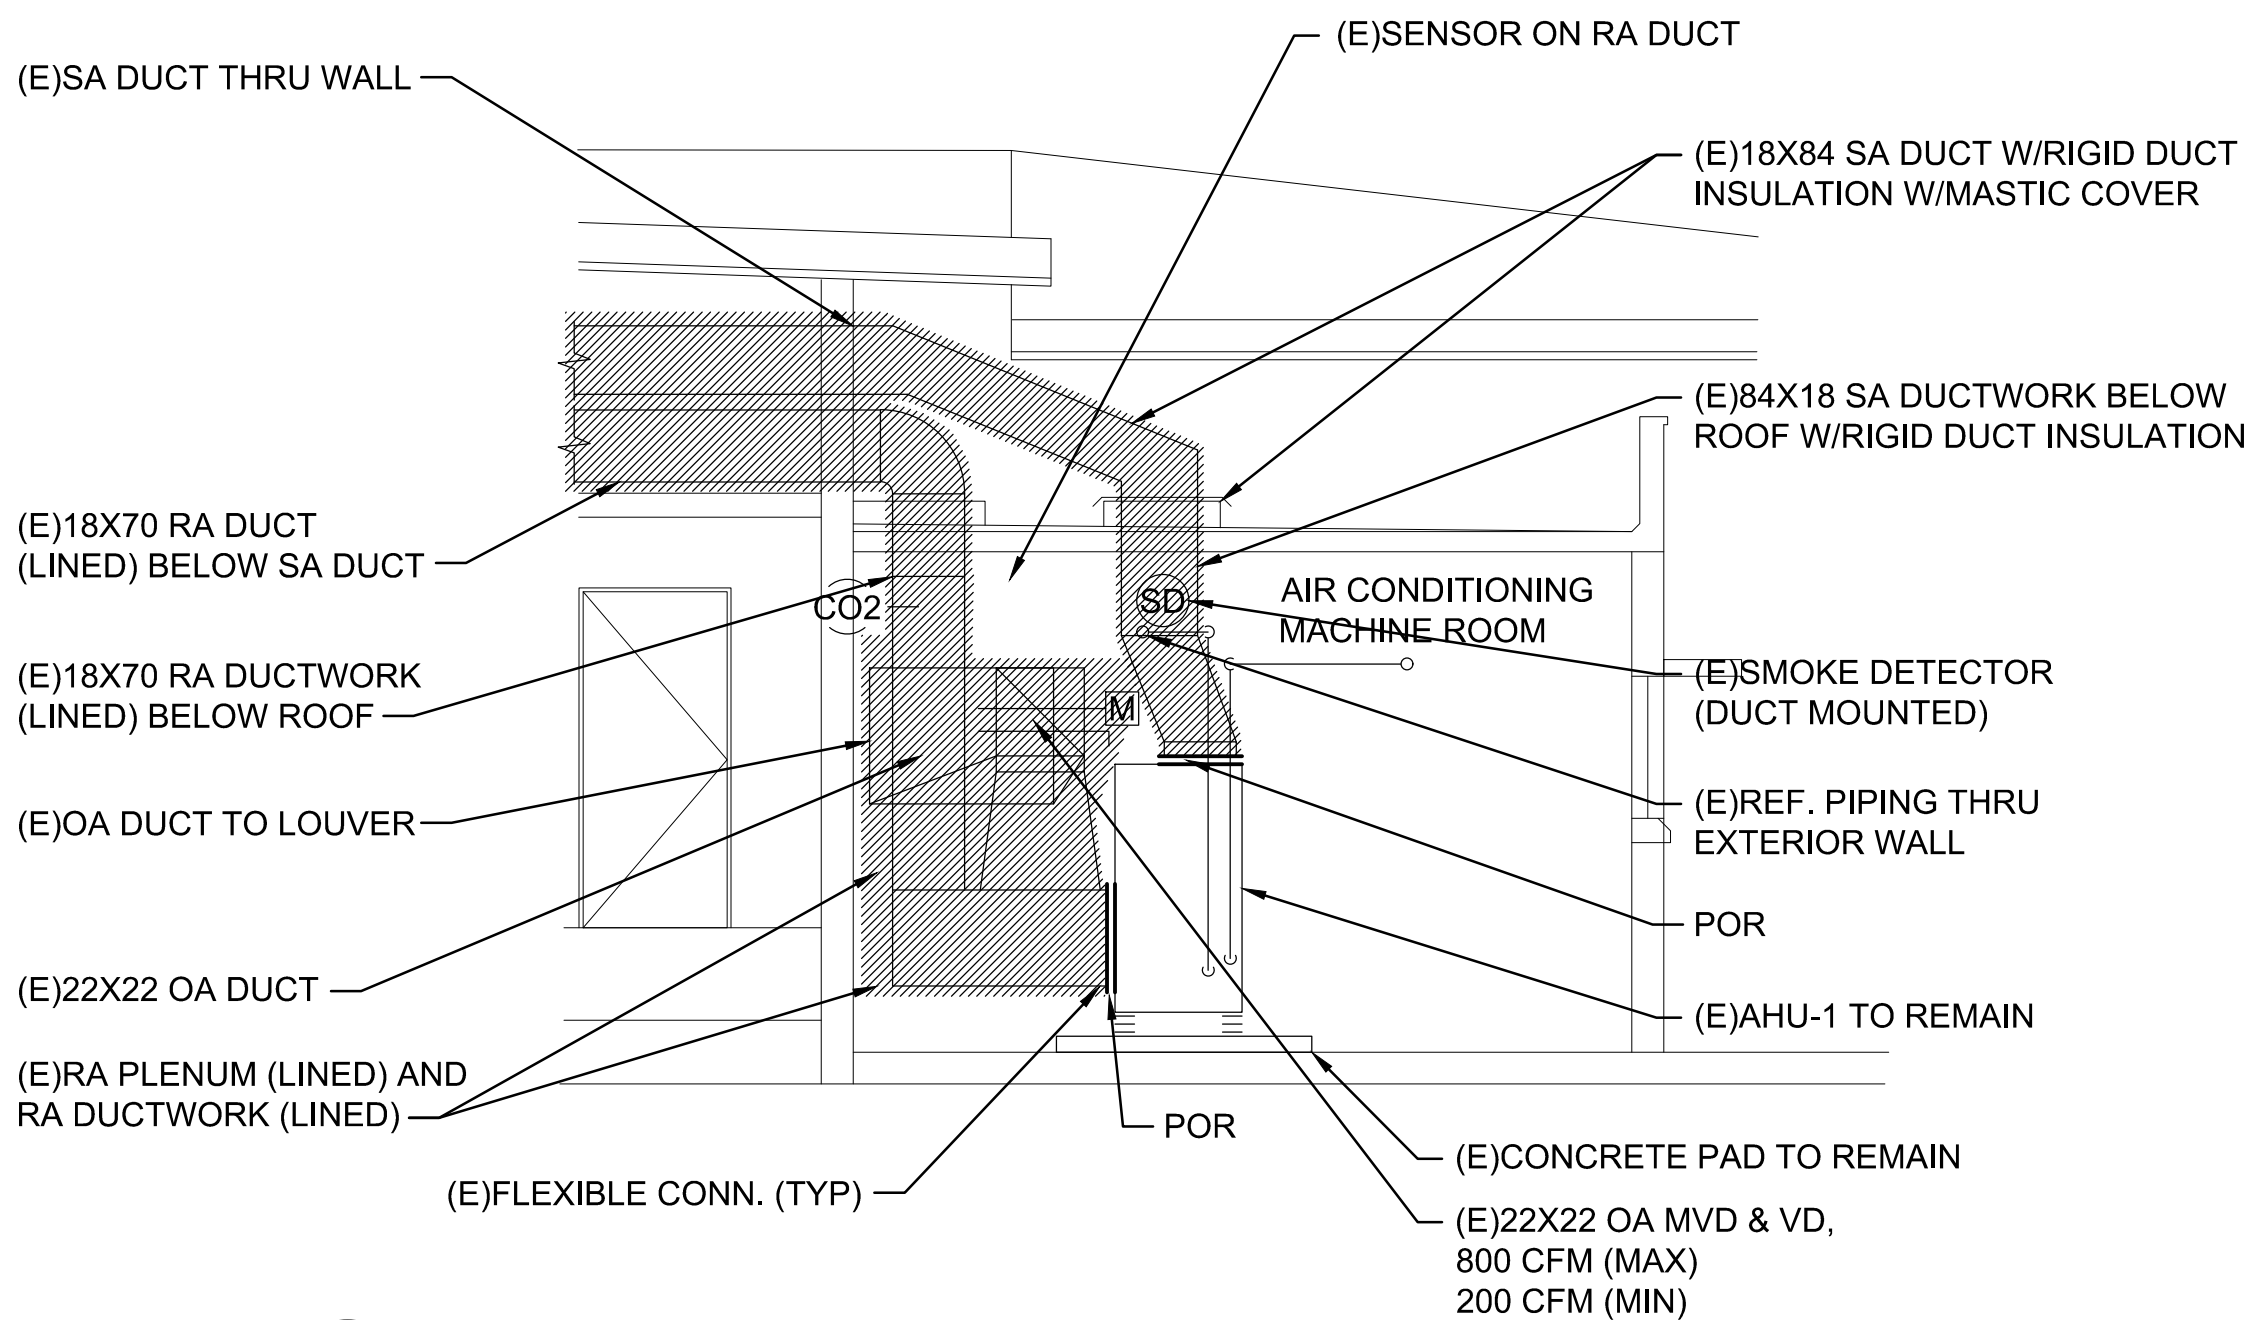

A1
MA702
MECHANICAL SECTION - DEMO
SCALE: 1/4" = 1'-0"

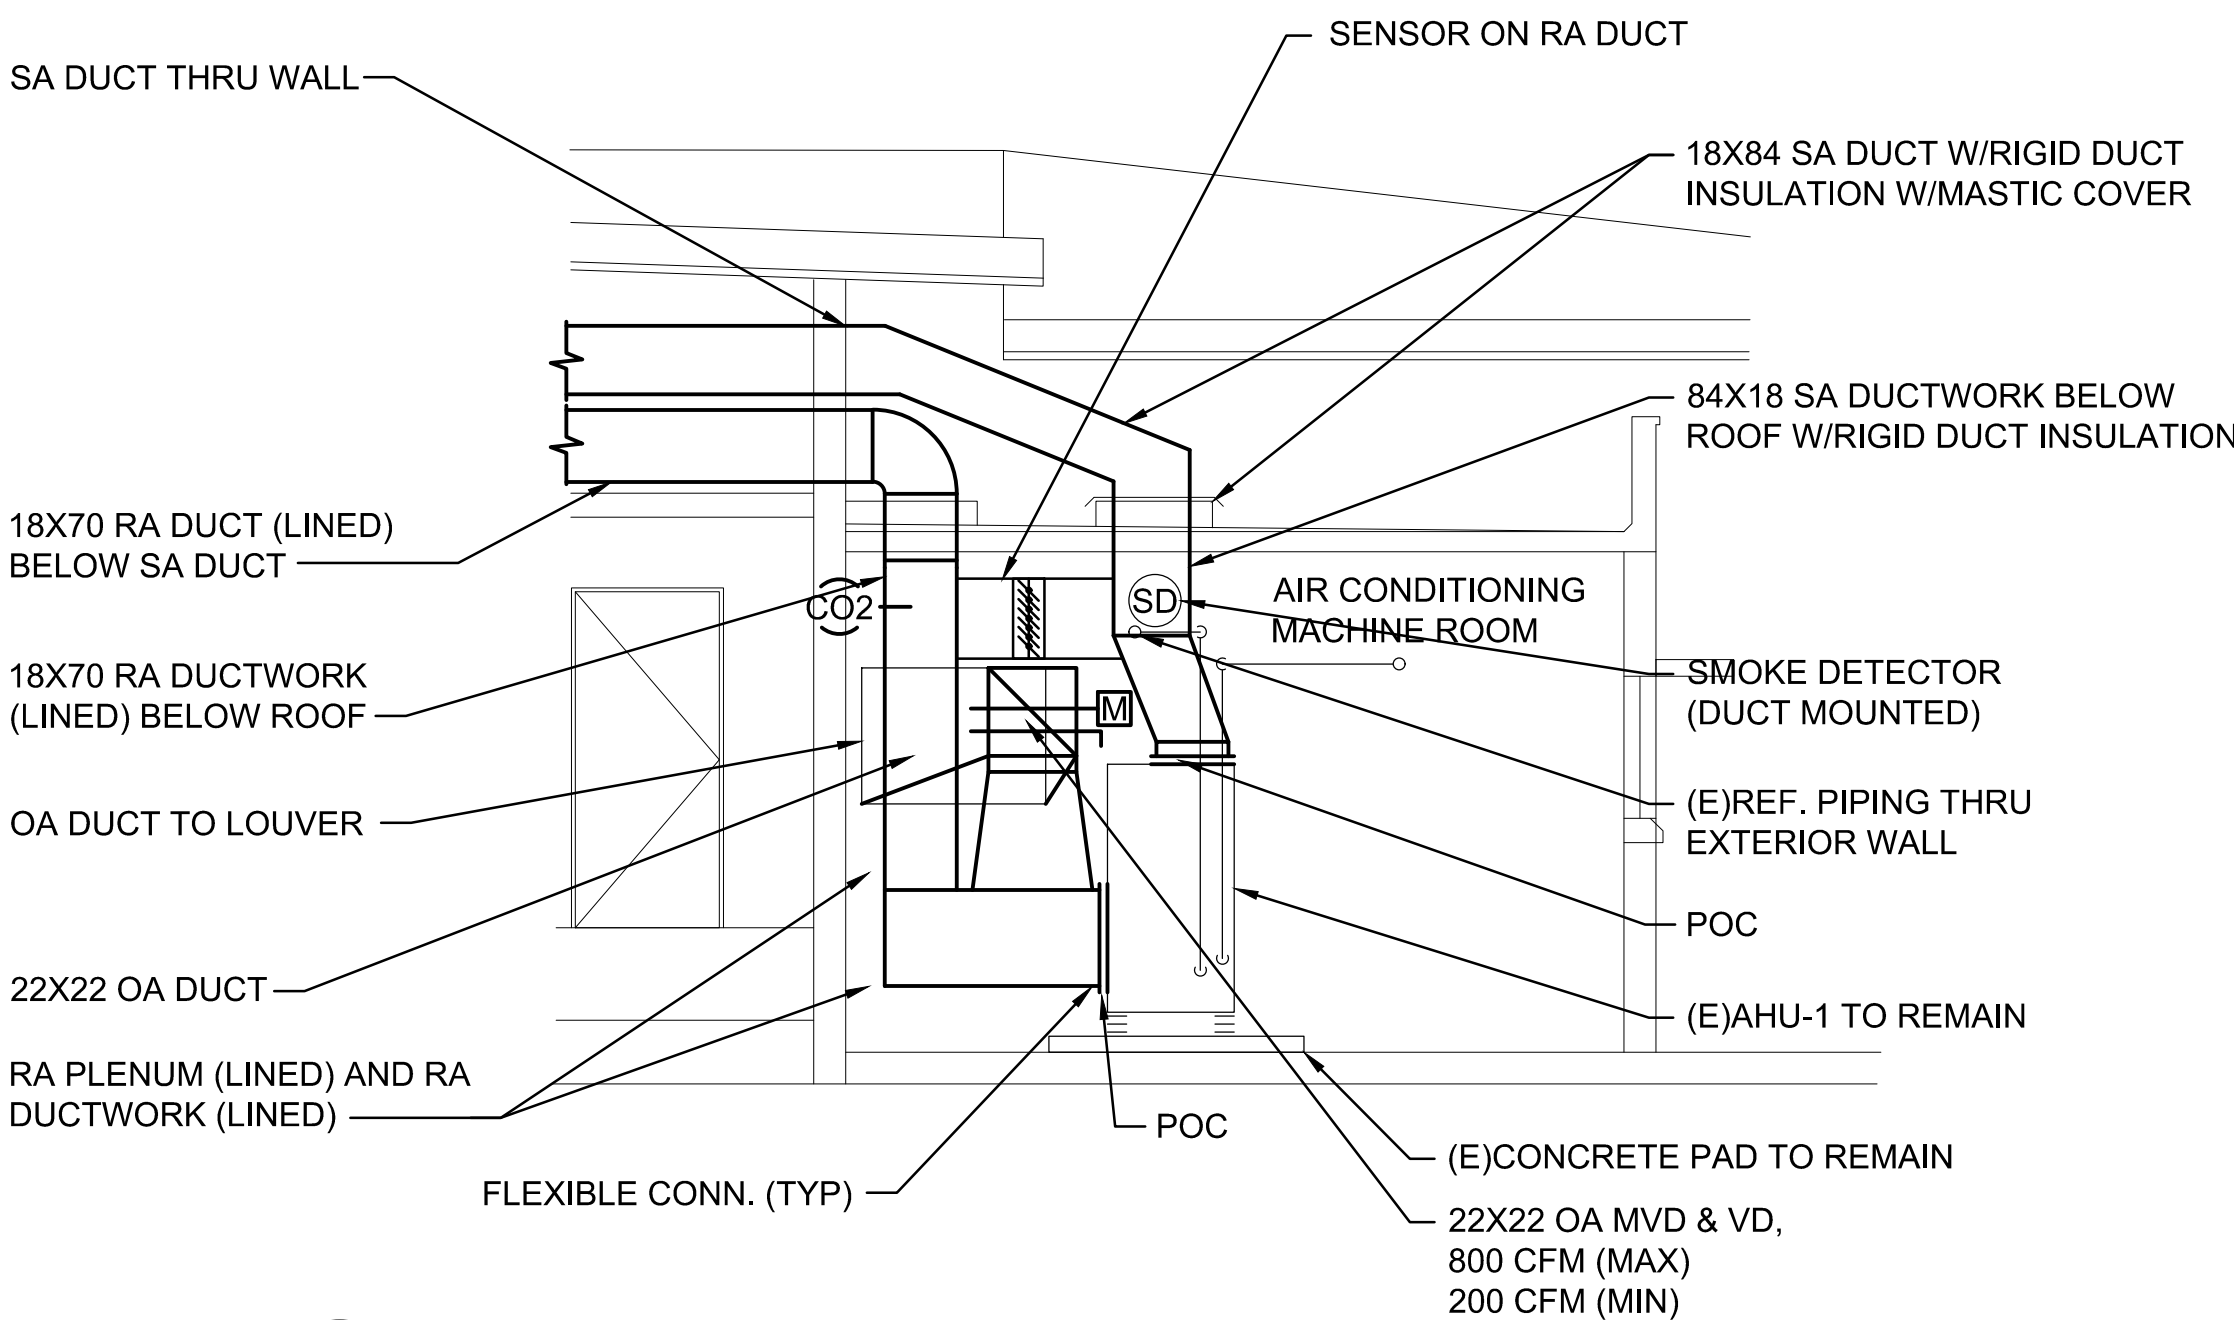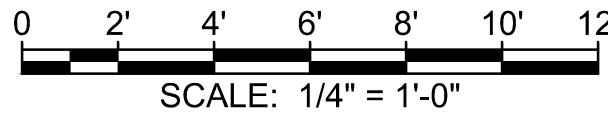

A3
MA702
MECHANICAL SECTION - NEW
SCALE: 1/4" = 1'-0"

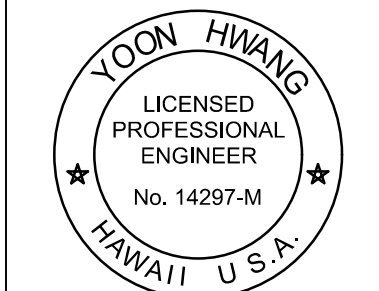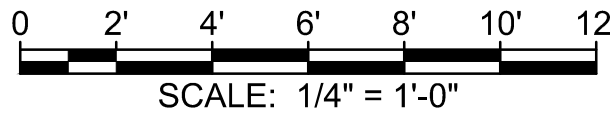


THIS WORK WAS PREPARED BY ME OR UNDER MY SUPERVISION
SIGNATURE: *Yoon Hwang* EXPIRATION DATE: 4/30/2026





SUBMITTAL PHASE
CONSTRUCTION DOCUMENTS
SUBMITTAL DATE 03/01/2024

STATE OF HAWAII
DEPARTMENT OF DEFENSE
DIAMOND HEAD STATE MONUMENT
4204 DIAMOND HEAD RD HONOLULU, HI 96816
TMK: 3-1-042:006
BIRKHAMER EMERGENCY OPERATIONS CENTER (EOC)
UPGRADES AND IMPROVEMENTS
MECHANICAL SECTIONS

SCALE: AS NOTED
STATE JOB NO. CA-202313-C
FEDERAL PROJECT NO. -
SHEET 41 OF 123
MA702

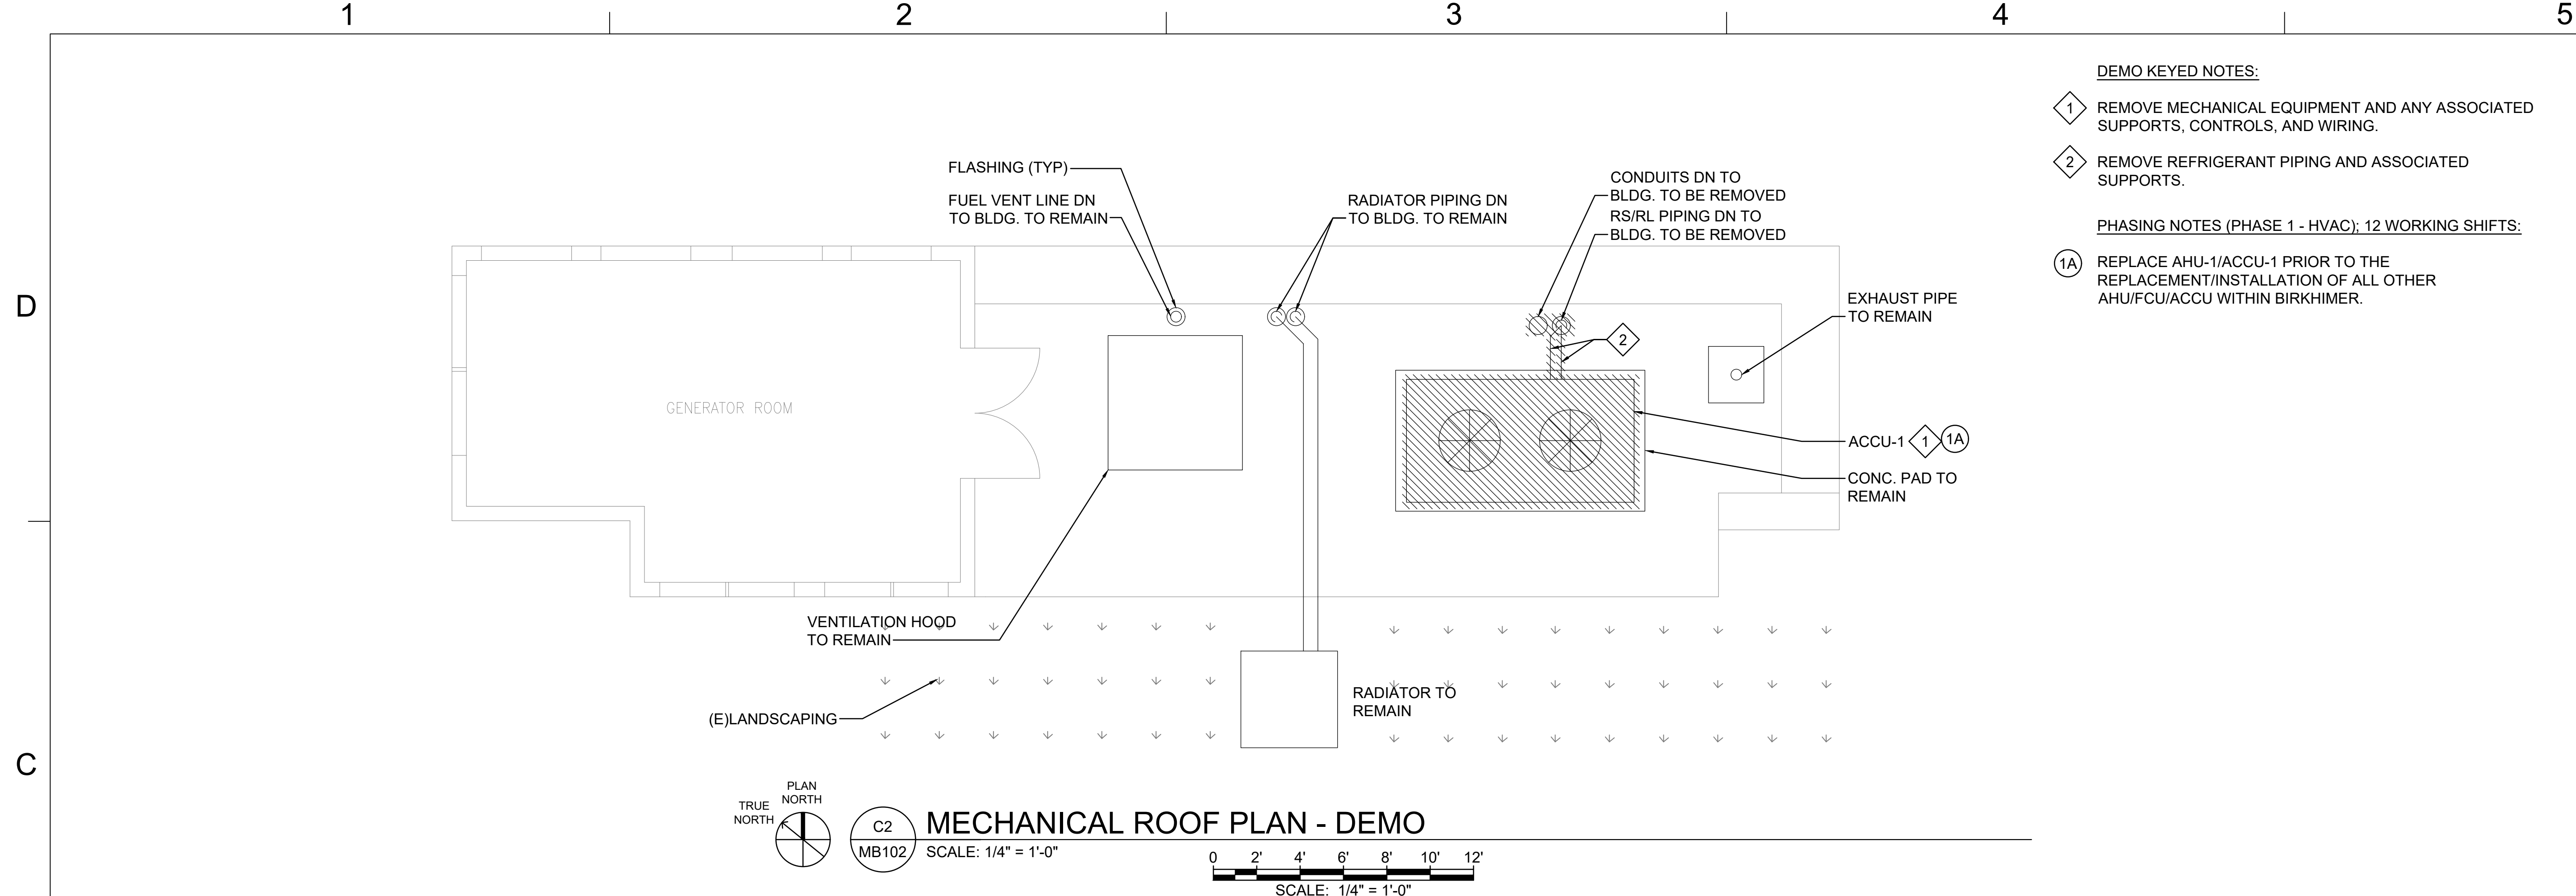

- DEMO KEYED NOTES:**
- 1 REMOVE MECHANICAL EQUIPMENT AND ANY ASSOCIATED SUPPORTS, CONTROLS, AND WIRING.
 - 2 REMOVE REFRIGERANT PIPING AND ASSOCIATED SUPPORTS.
- PHASING NOTES (PHASE 1 - HVAC); 12 WORKING SHIFTS:**
- 1A REPLACE AHU-1/ACCU-1 PRIOR TO THE REPLACEMENT/INSTALLATION OF ALL OTHER AHU/FCU/ACCU WITHIN BIRKHIRMER.

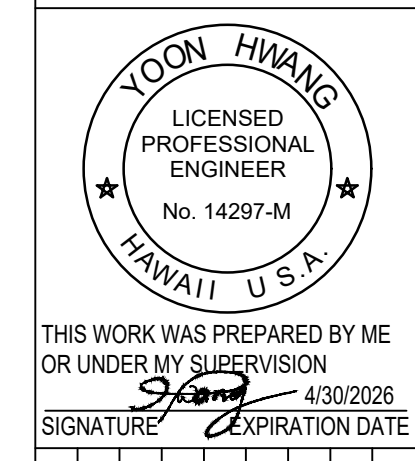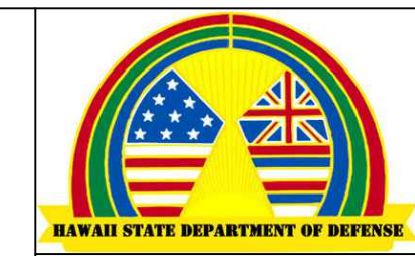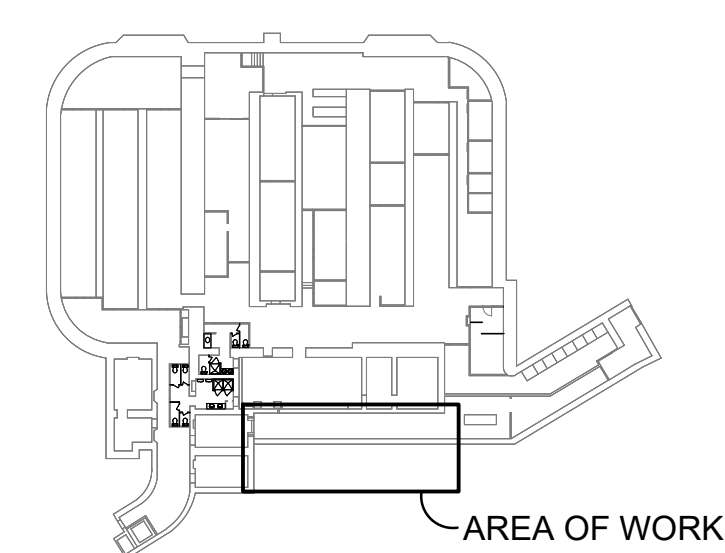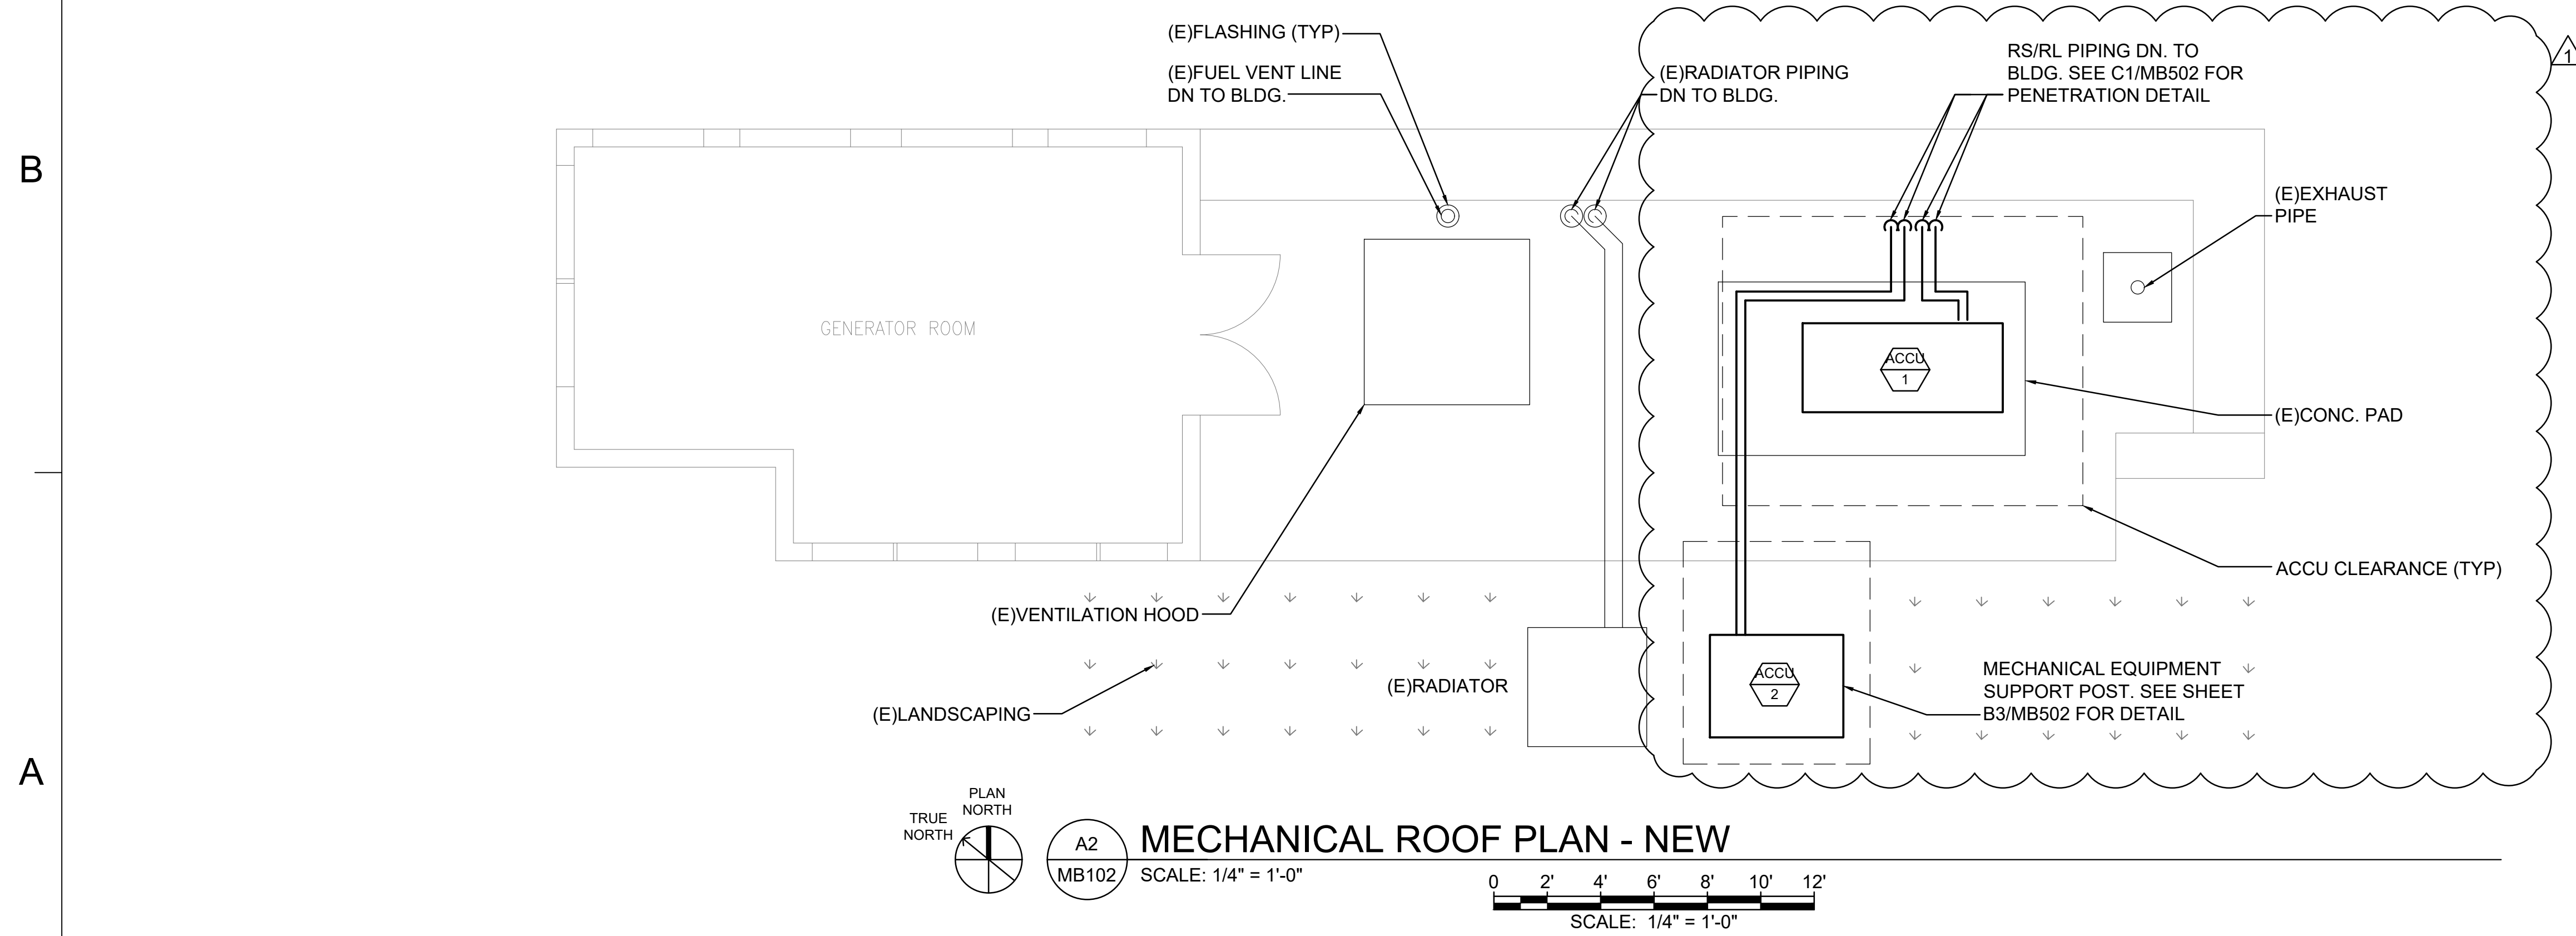

THIS WORK WAS PREPARED BY ME OR UNDER MY SUPERVISION

SIGNATURE: *[Signature]* EXPIRATION DATE: 4/30/2026

YH	FM	YH	APR	DATE
3/2/24				

ADDENDUM 1


SYN	DESCRIPTION

SUBMITTAL PHASE

CONSTRUCTION DOCUMENTS

SUBMITTAL DATE 03/01/2024

STATE OF HAWAII	DIAMOND HEAD STATE MONUMENT	4204 DIAMOND HEAD RD HONOLULU, HI 96816	TMK: 3-1-042:006	DEPARTMENT OF DEFENSE
BIRKHIRMER EMERGENCY OPERATIONS CENTER (EOC) UPGRADES AND IMPROVEMENTS				
MECHANICAL ROOF PLANS				
SCALE: AS NOTED				
STATE JOB NO. CA-202313-C				
FEDERAL PROJECT NO. -				
SHEET 43 OF 123				
MB102				


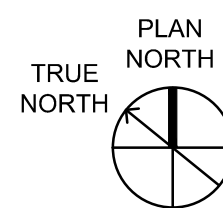


NEW OVERALL FLOOR PLAN


0 8' 16' 32' 48'

SCALE: 1/16" = 1'-0"



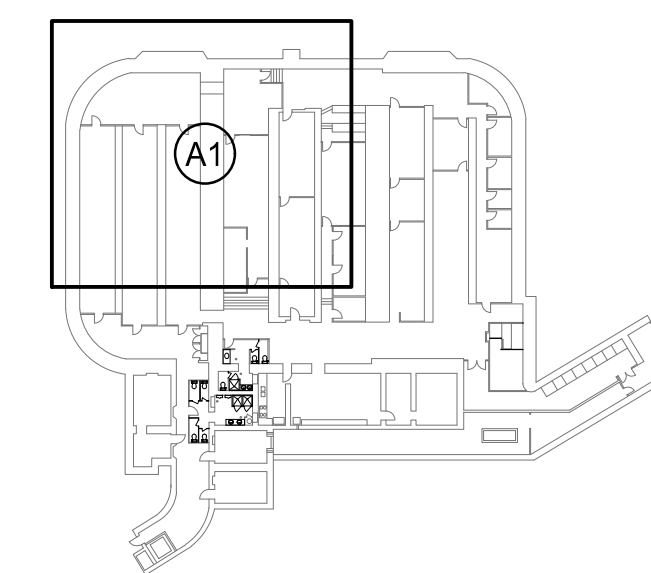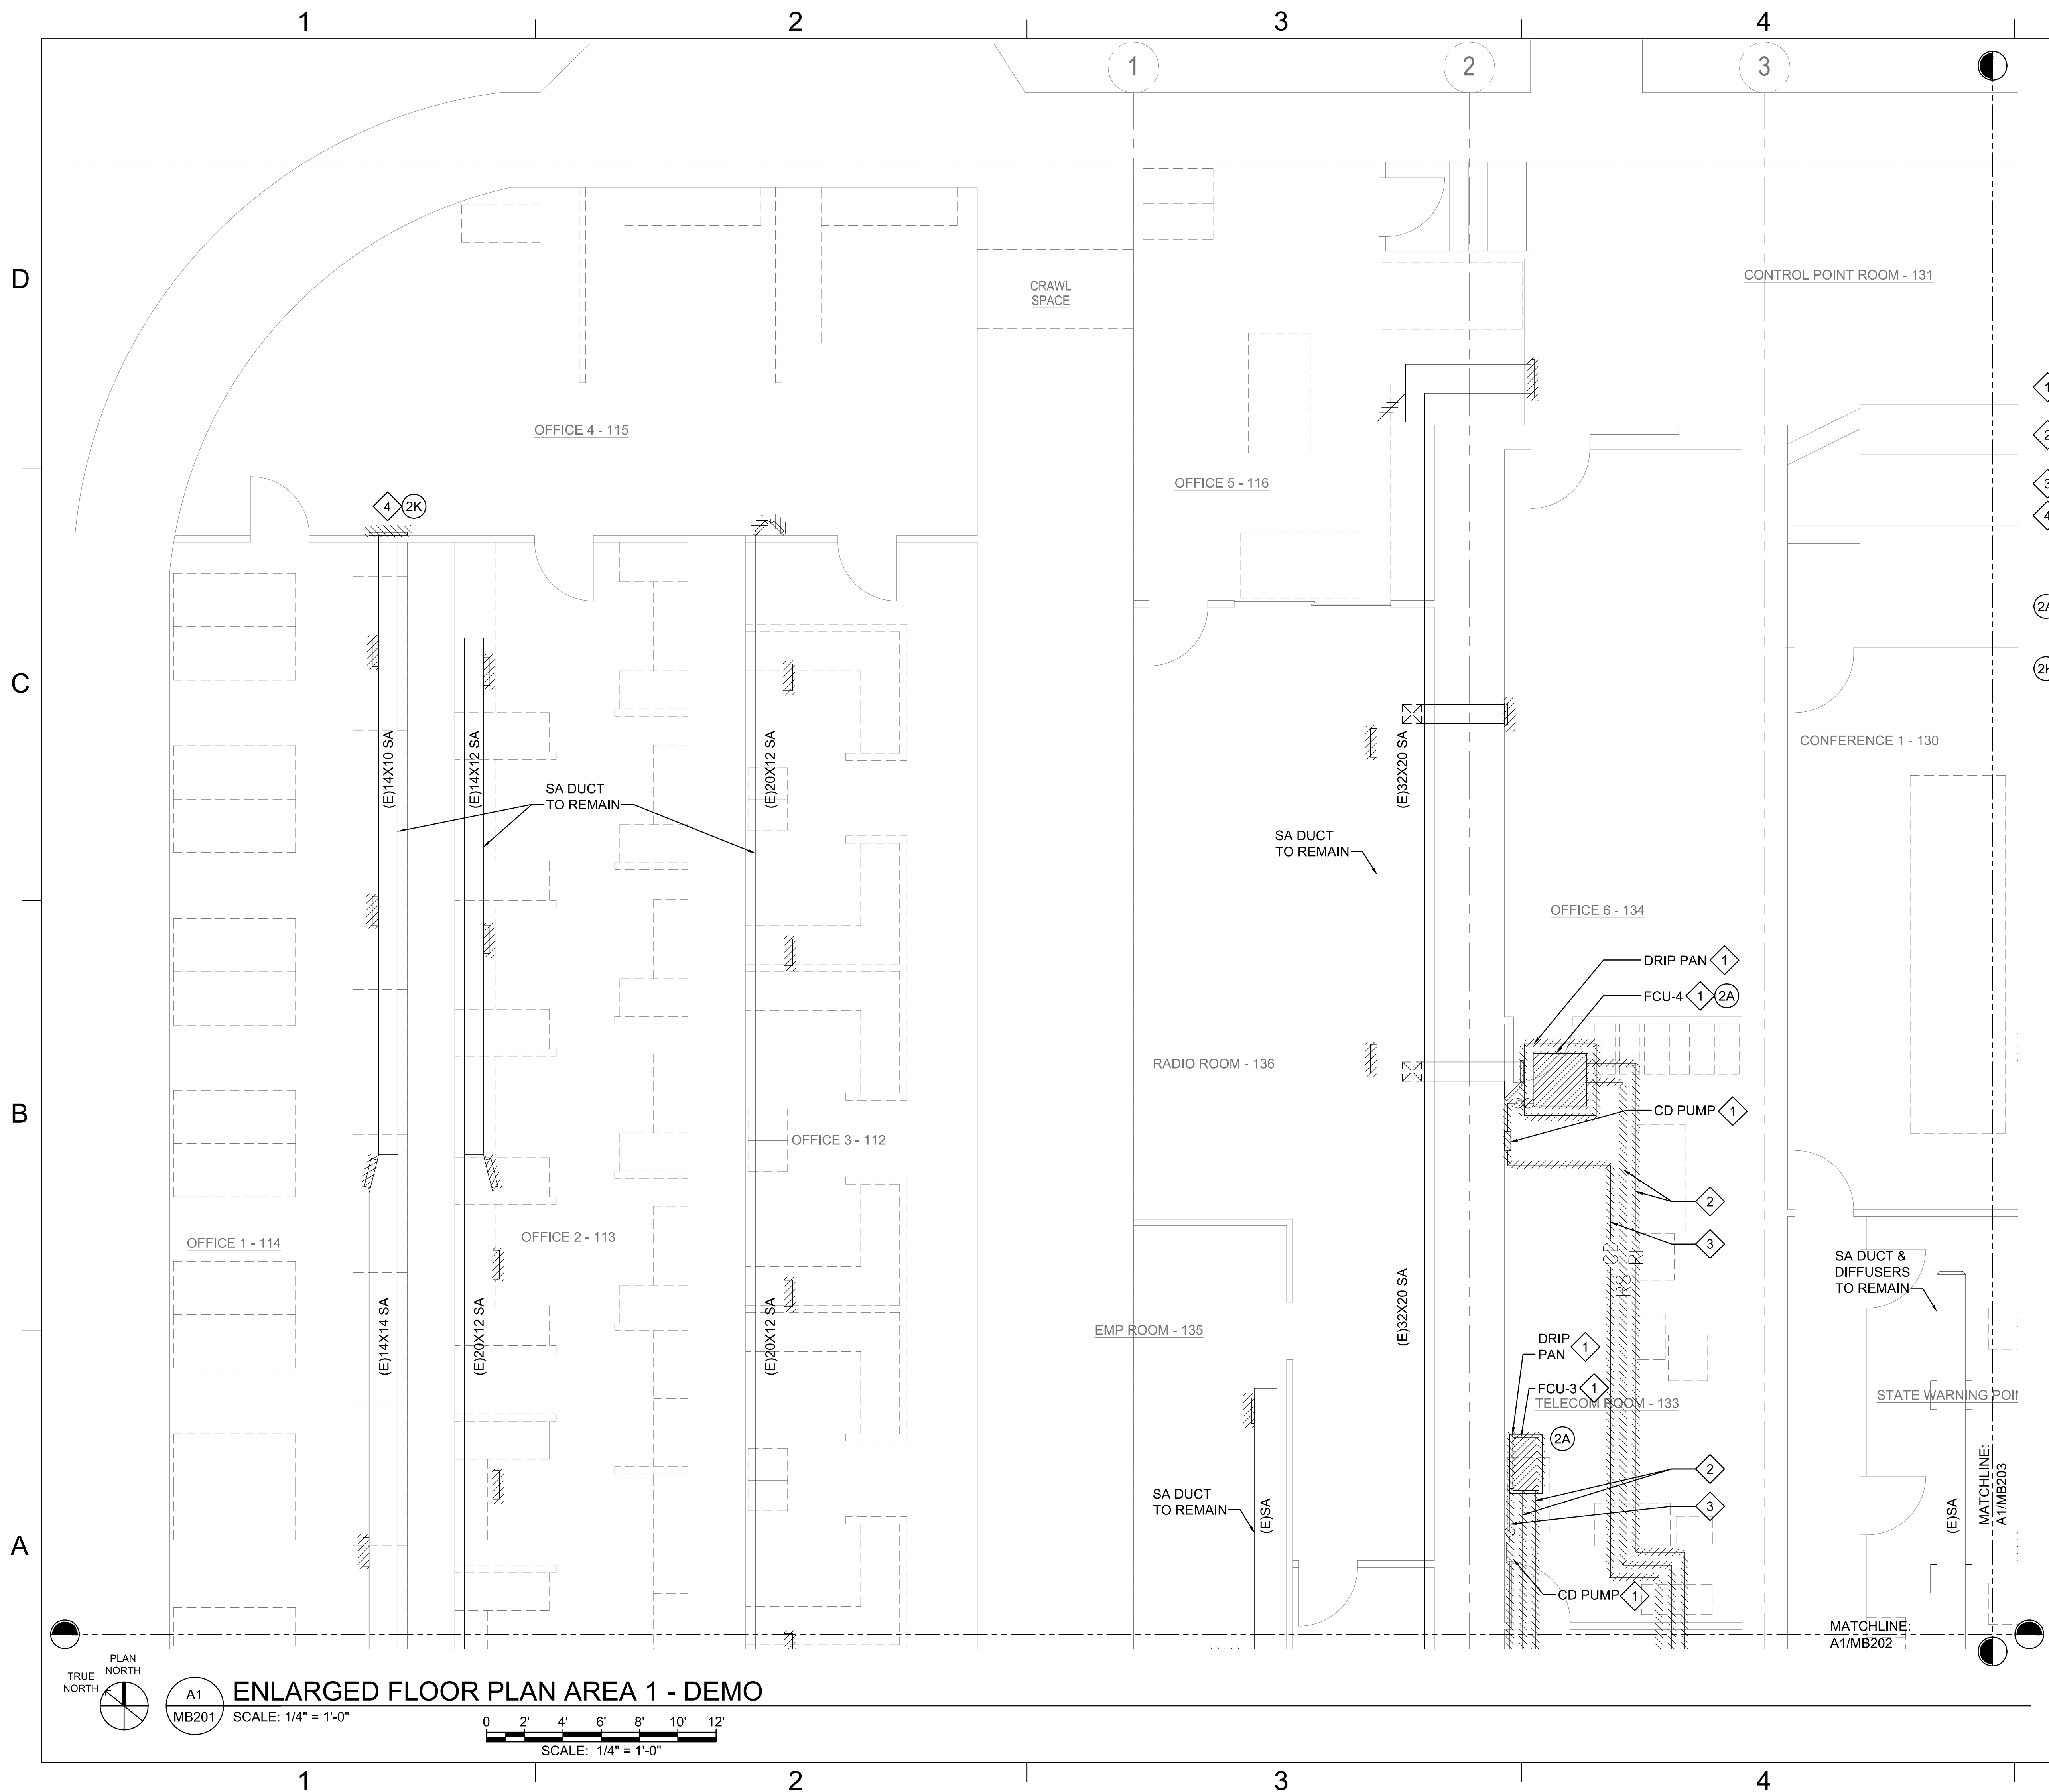

KEY PLAN

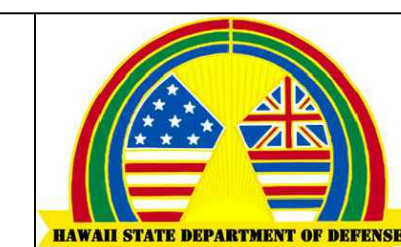

THIS WORK WAS PREPARED BY ME
OR UNDER MY SUPERVISION
4/30/2026
SIGNATURE _____ EXPIRATION DATE _____

[illegible]


SUBMITTAL PHASE
CONSTRUCTION
DOCUMENTS

SUBMITTAL DATE			03/01/2024
YH	FM	YH	


DEPARTMENT OF DEFENSE
TMK: 3-1-042:006
ER (EOC)

STATE OF HAWAII
DIAMOND HEAD STATE MONUMENT
4204 DIAMOND HEAD RD HONOLULU, HI 96816
**BIRKHIMER EMERGENCY OPERATIONS CENTER
UPGRADES AND IMPROVEMENTS**
ENLARGED FLOOR PLAN AREA 1 - DEMO


SCALE:	AS NOTED	
STATE JOB NO.	CA-202313-C	
FEDERAL PROJECT NO.	-	
SHEET	45 OF	123
MB201		

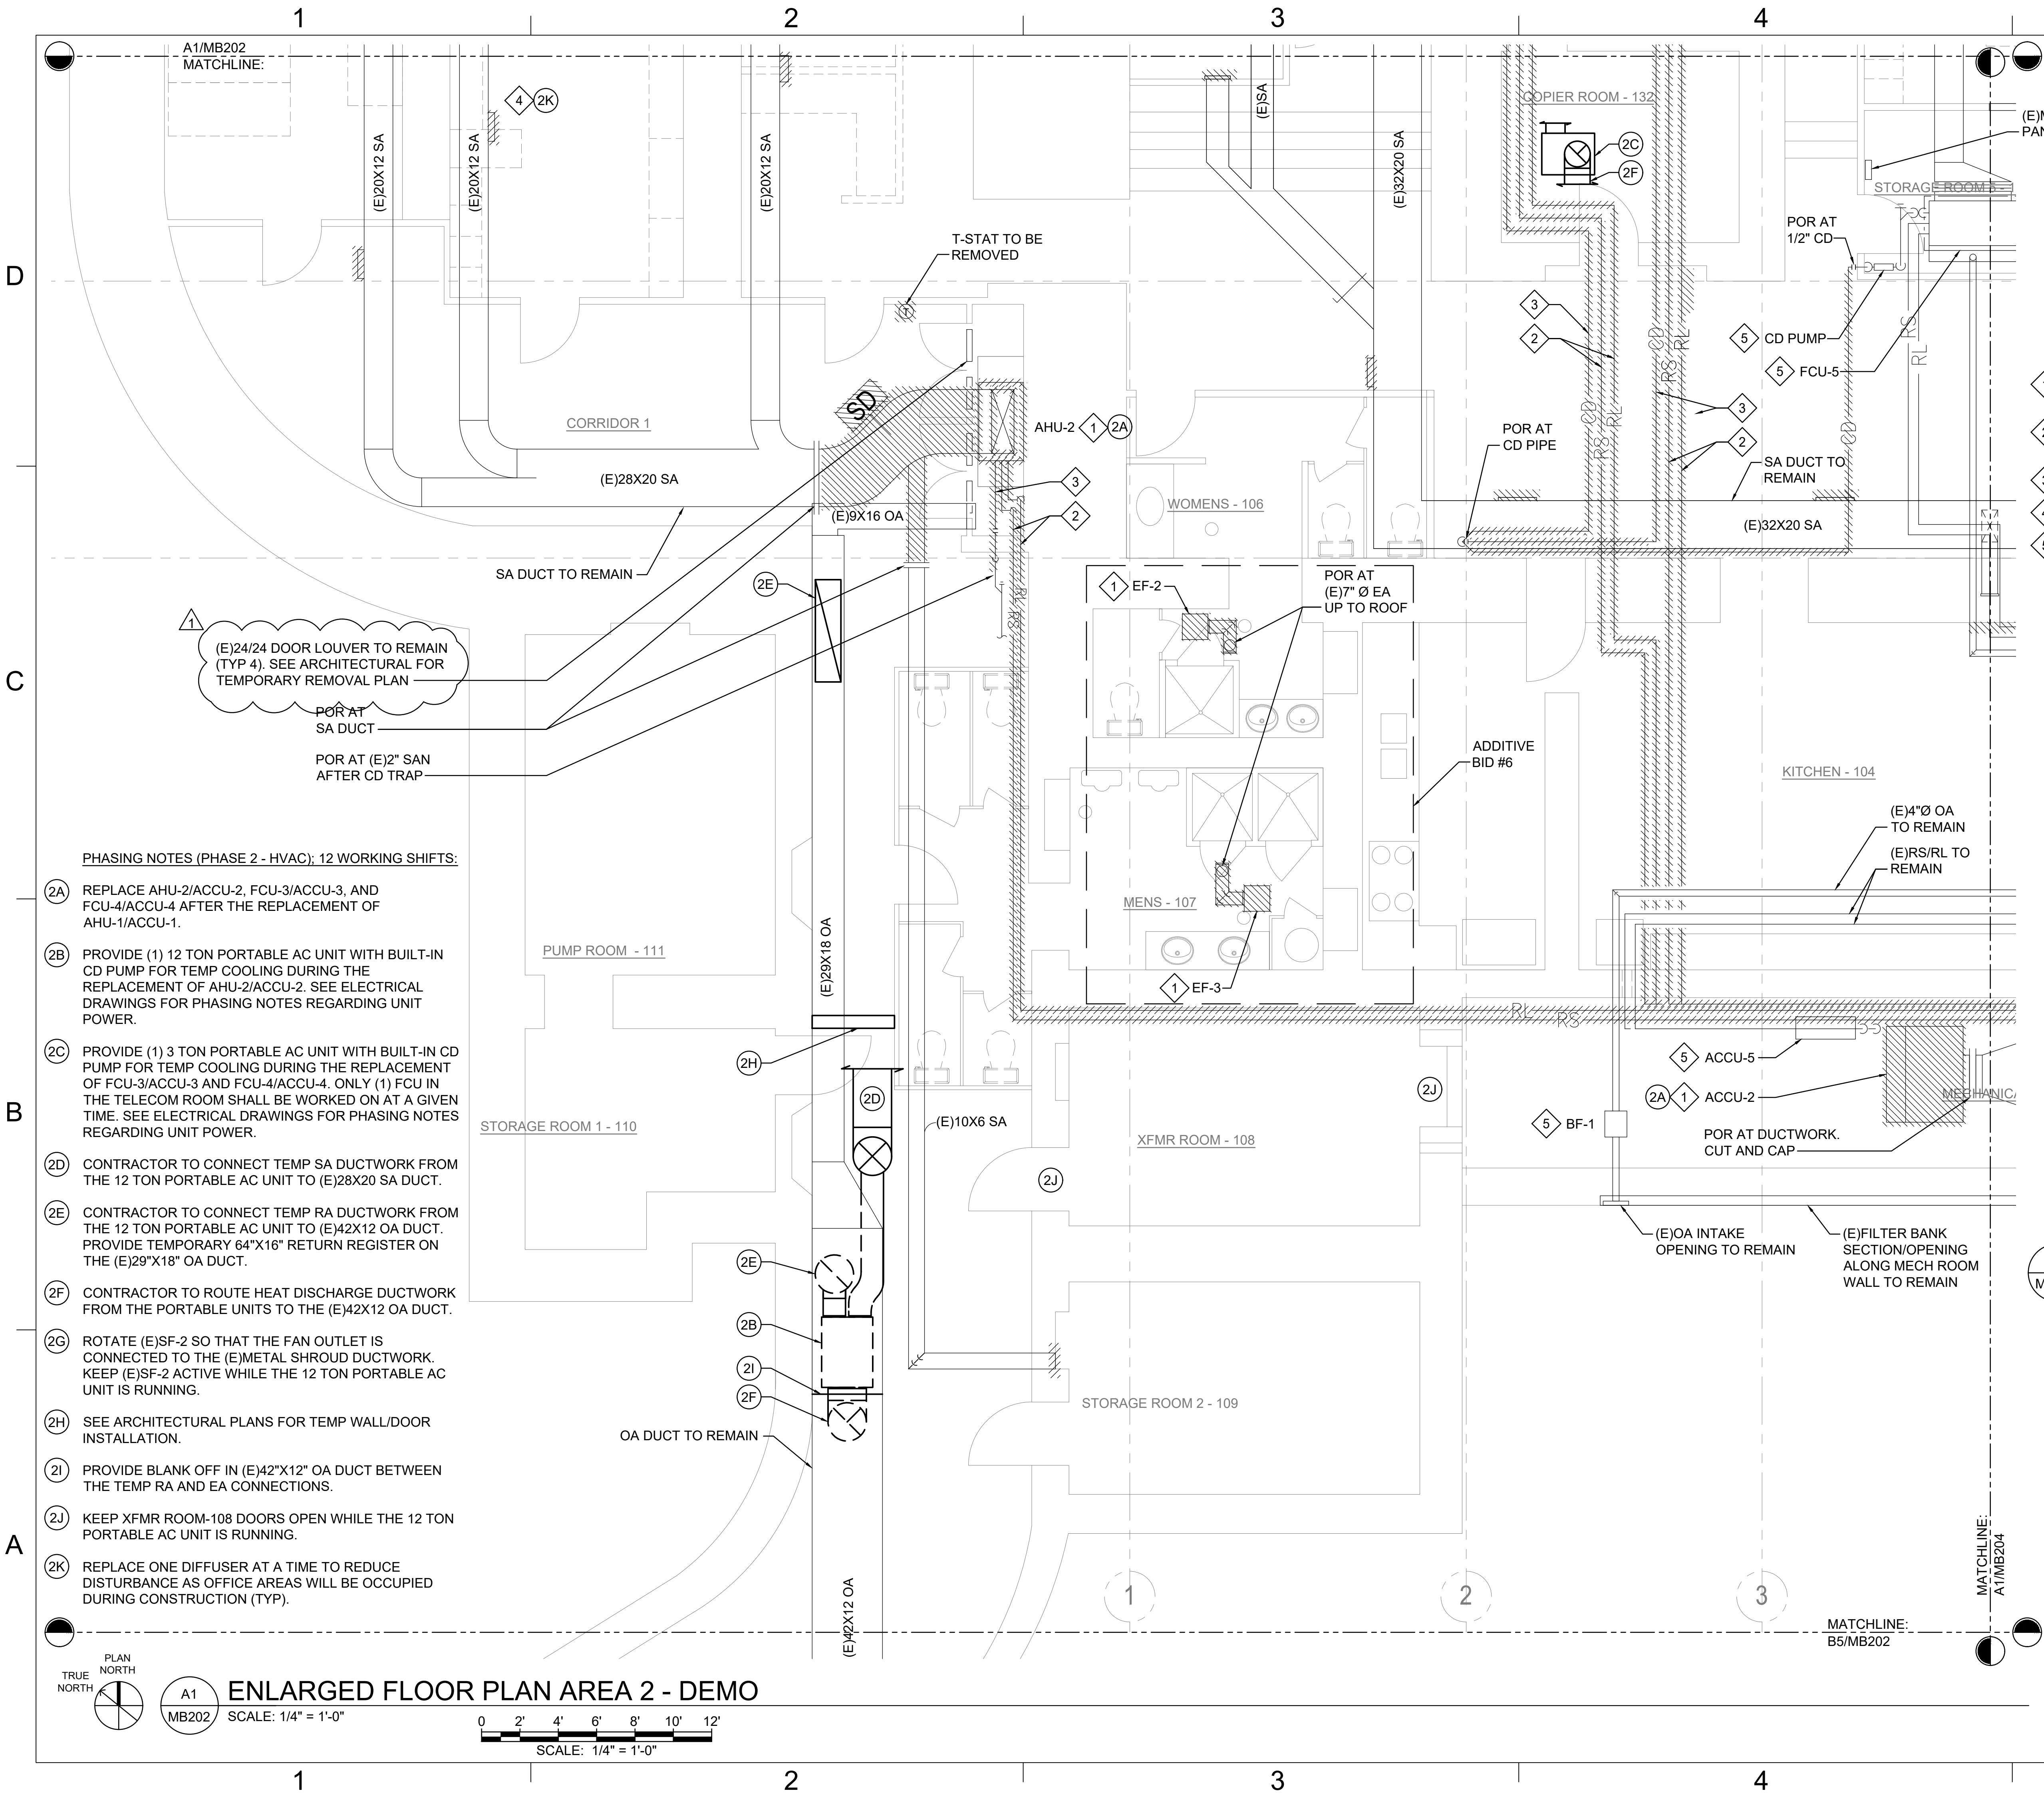

- KEYNOTES:**
- 1 REMOVE MECHANICAL EQUIPMENT AND ANY ASSOCIATED SUPPORTS, CONTROLS, AND WIRING.
 - 2 REMOVE REFRIGERANT PIPING AND ASSOCIATED SUPPORTS.
 - 3 REMOVE CD PIPING AND ASSOCIATED SUPPORTS.
 - 4 REMOVE AIR DEVICE (TYP).
 - 5 MECHANICAL EQUIPMENT TO REMAIN.

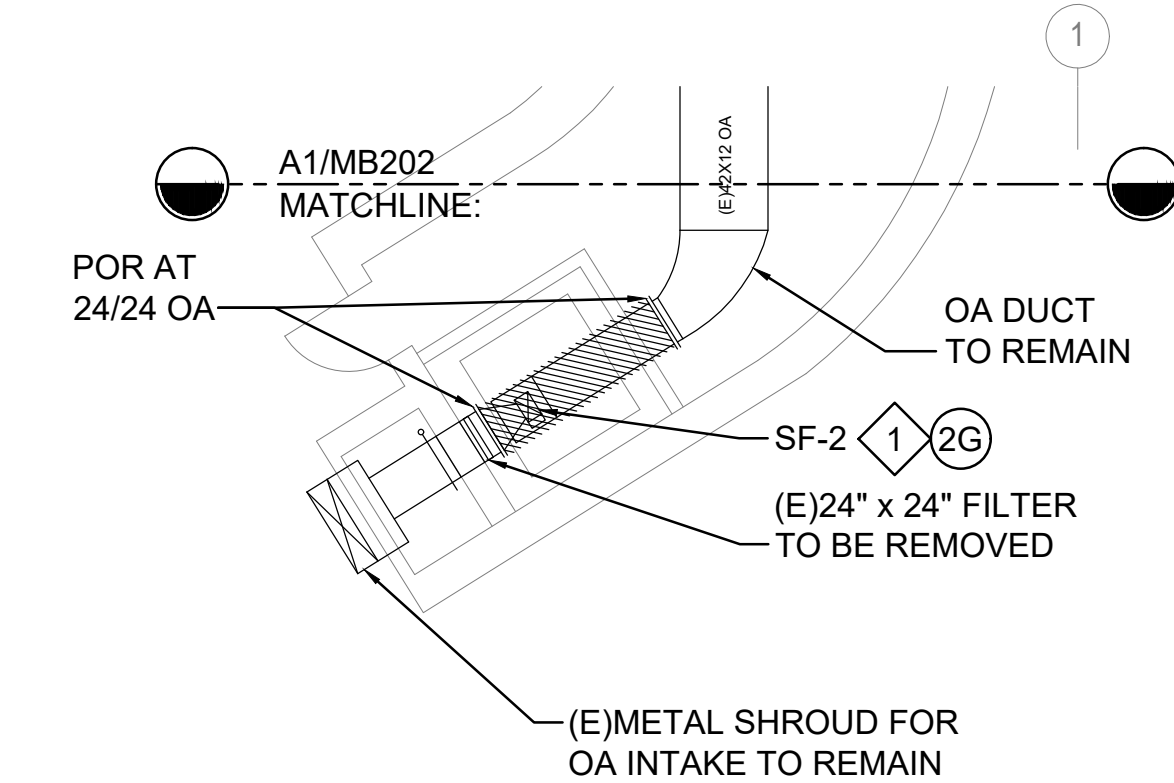


ENLARGED FLOOR PLAN AREA 5 - DEMO
SCALE: 1/8" = 1'-0"

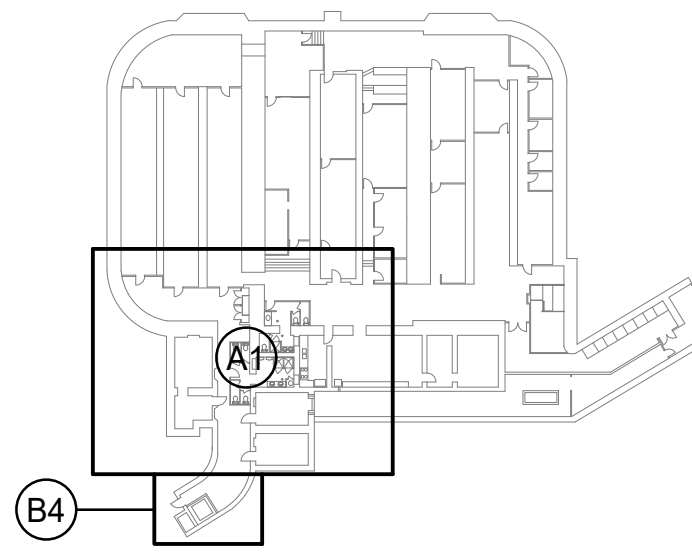


KEY PLAN
NTS

- PHASING NOTES (PHASE 2 - HVAC); 12 WORKING SHIFTS:**
- 2A REPLACE AHU-2/ACCU-2, FCU-3/ACCU-3, AND FCU-4/ACCU-4 AFTER THE REPLACEMENT OF AHU-1/ACCU-1.
 - 2B PROVIDE (1) 12 TON PORTABLE AC UNIT WITH BUILT-IN CD PUMP FOR TEMP COOLING DURING THE REPLACEMENT OF AHU-2/ACCU-2. SEE ELECTRICAL DRAWINGS FOR PHASING NOTES REGARDING UNIT POWER.
 - 2C PROVIDE (1) 3 TON PORTABLE AC UNIT WITH BUILT-IN CD PUMP FOR TEMP COOLING DURING THE REPLACEMENT OF FCU-3/ACCU-3 AND FCU-4/ACCU-4. ONLY (1) FCU IN THE TELECOM ROOM SHALL BE WORKED ON AT A GIVEN TIME. SEE ELECTRICAL DRAWINGS FOR PHASING NOTES REGARDING UNIT POWER.
 - 2D CONTRACTOR TO CONNECT TEMP SA DUCTWORK FROM THE 12 TON PORTABLE AC UNIT TO (E)28X20 SA DUCT.
 - 2E CONTRACTOR TO CONNECT TEMP RA DUCTWORK FROM THE 12 TON PORTABLE AC UNIT TO (E)42X12 OA DUCT. PROVIDE TEMPORARY 64"X16" RETURN REGISTER ON THE (E)29"X18" OA DUCT.
 - 2F CONTRACTOR TO ROUTE HEAT DISCHARGE DUCTWORK FROM THE PORTABLE UNITS TO THE (E)42X12 OA DUCT.
 - 2G ROTATE (E)SF-2 SO THAT THE FAN OUTLET IS CONNECTED TO THE (E)METAL SHROUD DUCTWORK. KEEP (E)SF-2 ACTIVE WHILE THE 12 TON PORTABLE AC UNIT IS RUNNING.
 - 2H SEE ARCHITECTURAL PLANS FOR TEMP WALL/DOOR INSTALLATION.
 - 2I PROVIDE BLANK OFF IN (E)42"X12" OA DUCT BETWEEN THE TEMP RA AND EA CONNECTIONS.
 - 2J KEEP XFMR ROOM-108 DOORS OPEN WHILE THE 12 TON PORTABLE AC UNIT IS RUNNING.
 - 2K REPLACE ONE DIFFUSER AT A TIME TO REDUCE DISTURBANCE AS OFFICE AREAS WILL BE OCCUPIED DURING CONSTRUCTION (TYP).

ENLARGED FLOOR PLAN AREA 2 - DEMO
SCALE: 1/4" = 1'-0"



HAWAII STATE DEPARTMENT OF DEFENSE

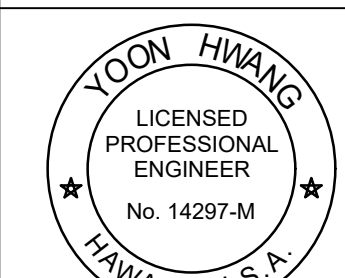

Yoon Hwang
LICENSED PROFESSIONAL ENGINEER
No. 14297-M
HAWAII U.S.A.

THIS WORK WAS PREPARED BY ME OR UNDER MY SUPERVISION

SIGNATURE: *[Signature]* EXPIRATION DATE: 4/30/2026

YH	FM	YH	APR	DATE	DESCRIPTION
3/27/24					

DEPARTMENT OF DEFENSE

DIAMOND HEAD STATE MONUMENT

STATE OF HAWAII

4204 DIAMOND HEAD RD HONOLULU, HI 96816

TMK: 3-1-042:006

BIRKHIRMER EMERGENCY OPERATIONS CENTER (EOC) UPGRADES AND IMPROVEMENTS

ENLARGED FLOOR PLAN AREA 2_5 - DEMO


SCALE: AS NOTED

STATE JOB NO. CA-202313-C

FEDERAL PROJECT NO. -

SHEET 46 OF 123

MB202

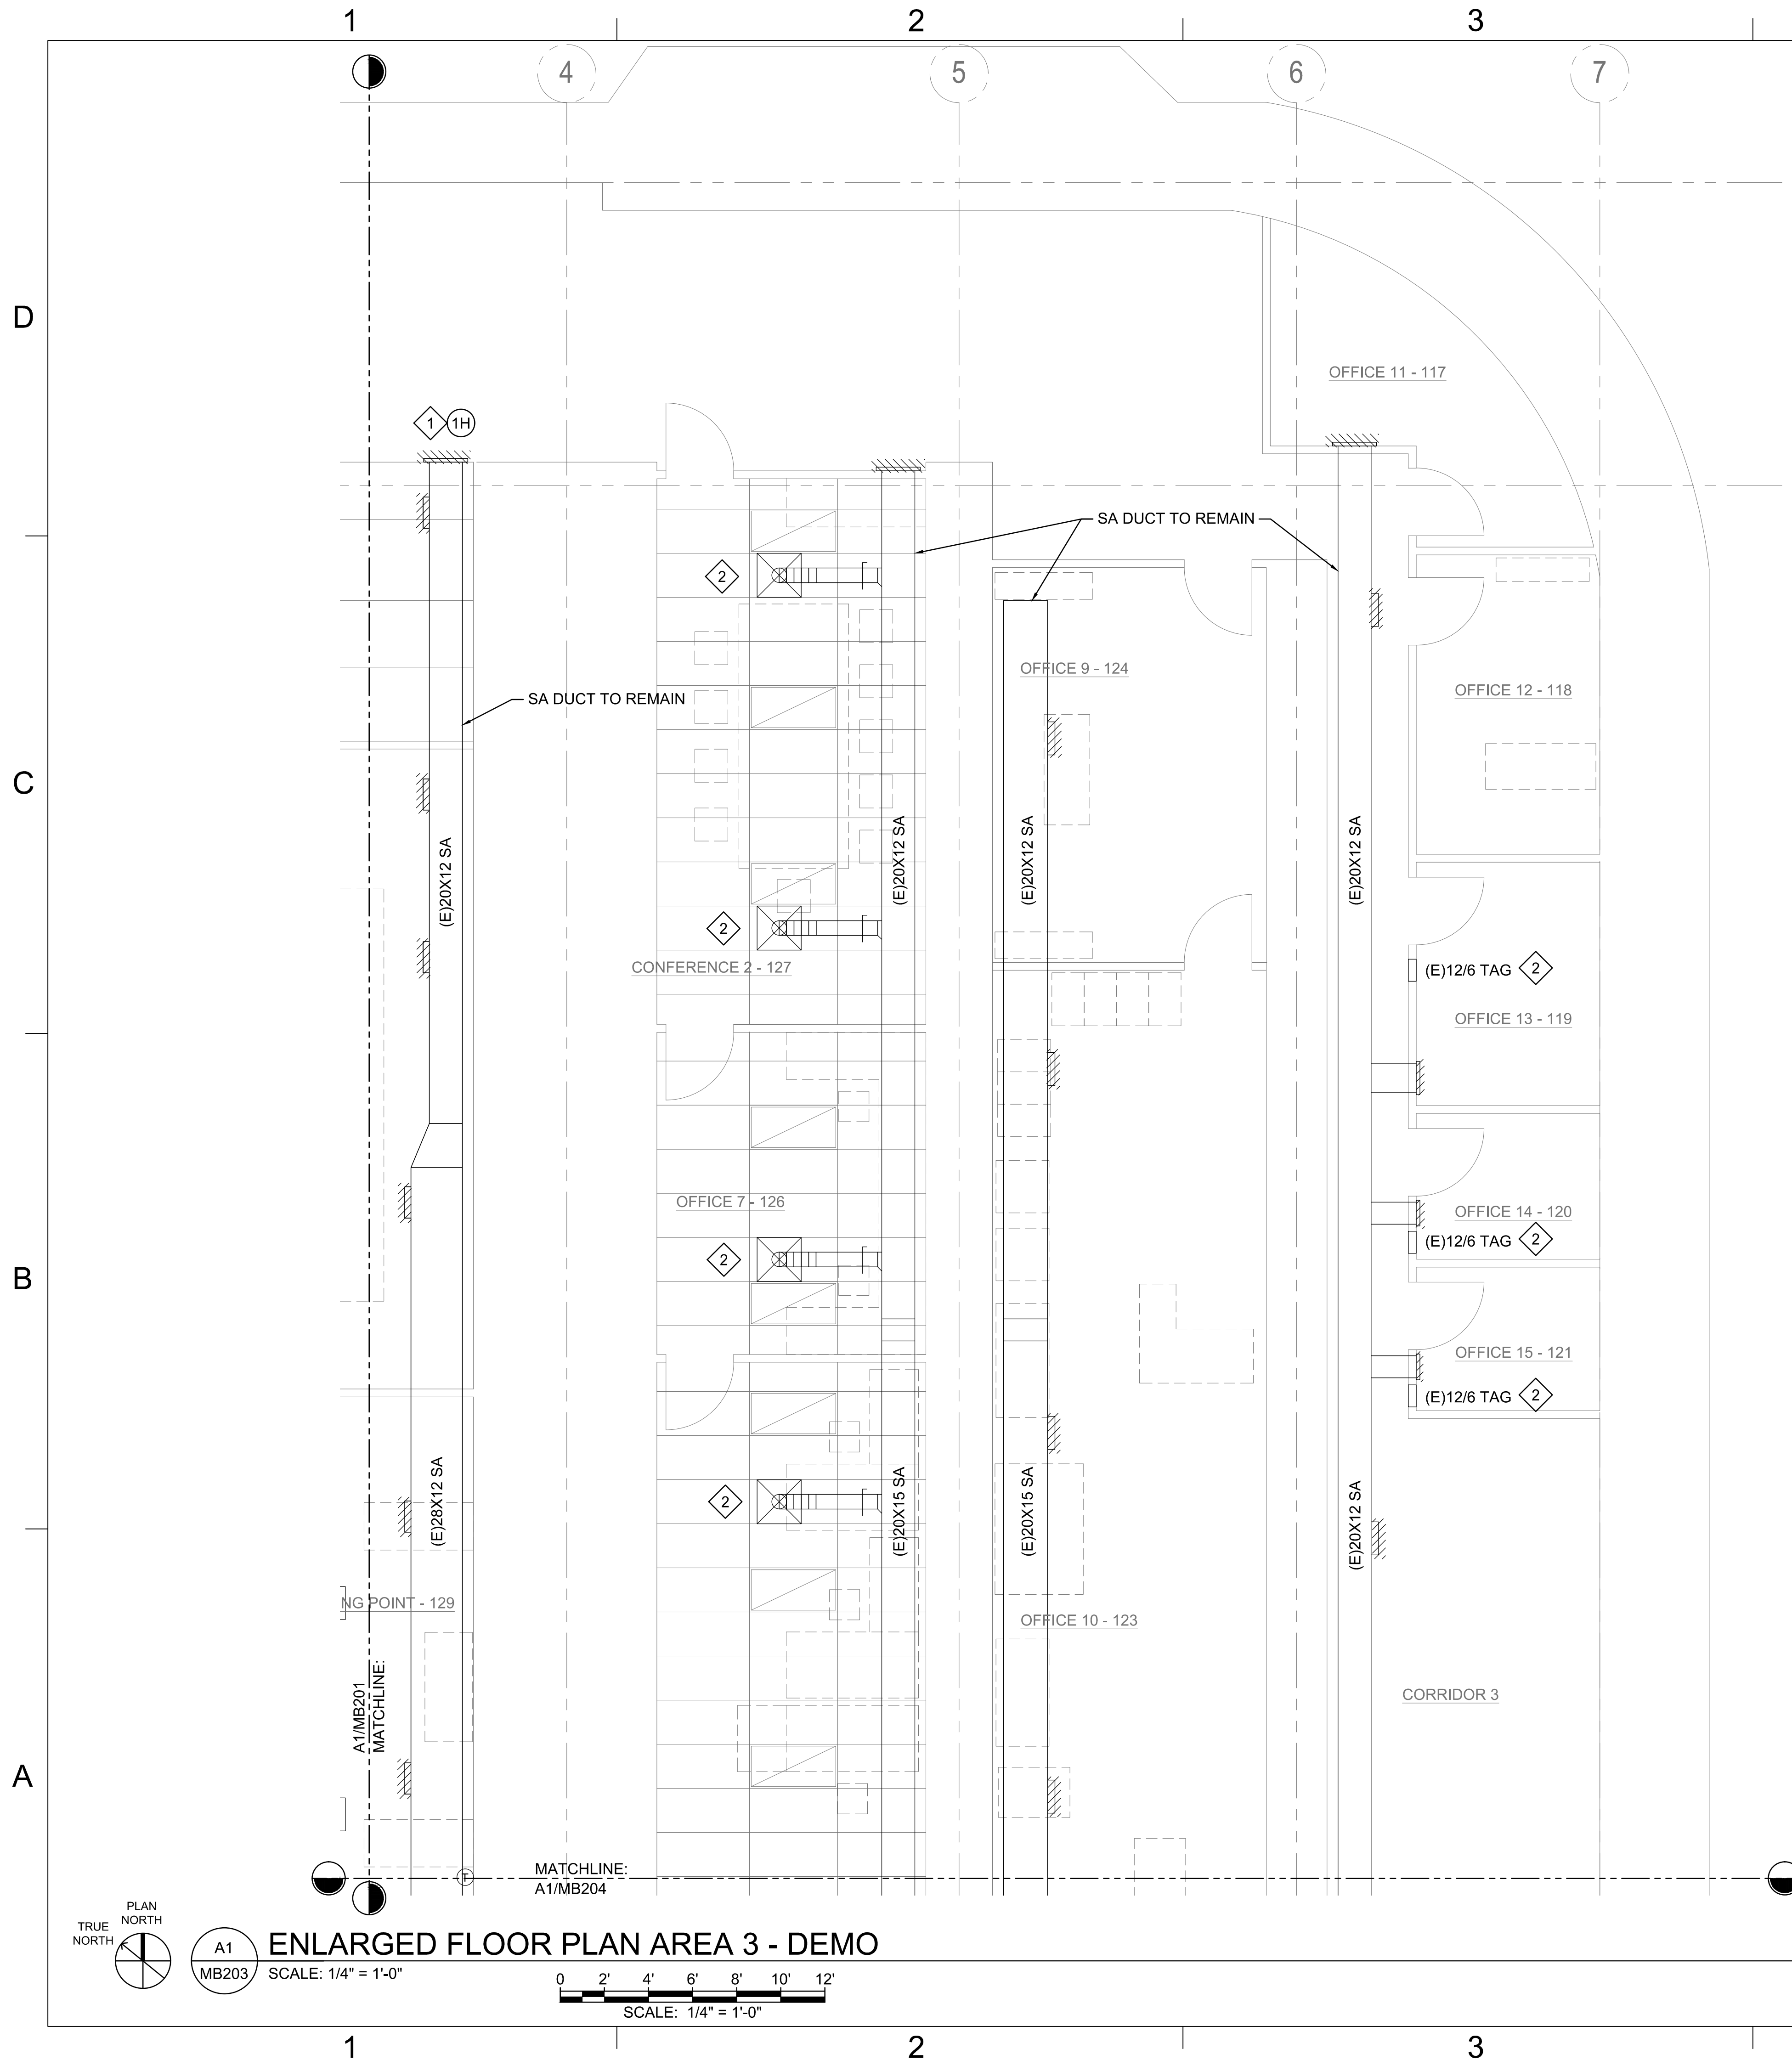


KEYNOTES:

- 1 REMOVE AIR DEVICE (TYP).
- 2 AIR DEVICE TO REMAIN.

PHASING NOTES (PHASE 1 - HVAC); 12 WORKING SHIFTS:

- ①H REPLACE ONE DIFFUSER AT A TIME TO REDUCE DISTURBANCE AS OFFICE AREAS WILL BE OCCUPIED DURING CONSTRUCTION (TYP).

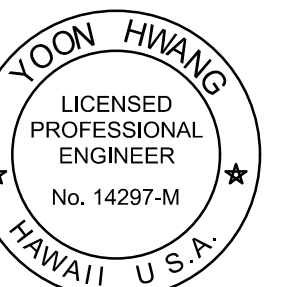

THIS WORK WAS PREPARED BY ME
UNDER MY SUPERVISION
4/30/2026
SIGNATURE EXPIRATION DATE

[illegible][illegible]

SUBMITTAL DATE		03/01/2024	
YH	FM	YH	

90		
----	--	--


TMK: 3-1-042:0
ER (EOC)

DIAMOND HEAD STATE MONUMENT

10 HONOLULU, HI 96816

EMERGENCY OPERATIONS CENTER
GRADES AND IMPROVEMENTS

ENLARGED FLOOR PLAN AREA 3 - DEMO

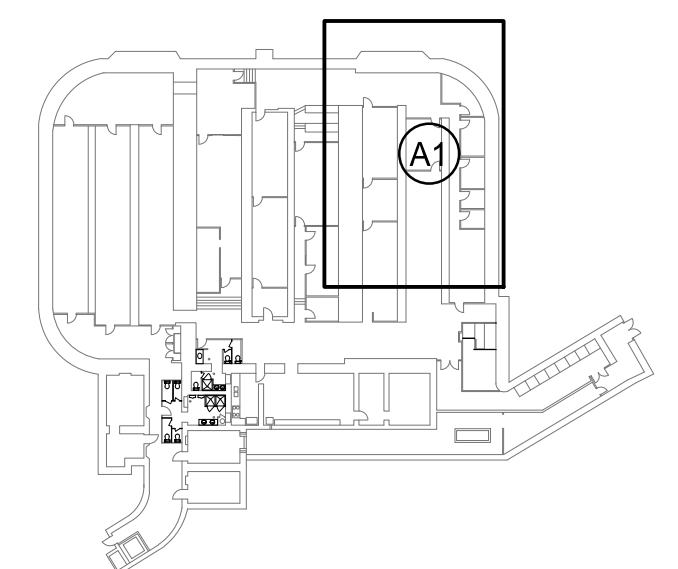

KEY PLAN

SCALE:

AS NOTED
DATE LOG NO.

CA-202313-C

FEDERAL PROJECT NO.

-

SHEET 17 OF 123

MB203



C



A






C

B

A

1. PRIOR TO DEMOLISHING EXISTING FCU'S, THE CONTRACTOR SHALL INSTALL NEW FCU C3/C4/C5.
2. ONCE THE NEW FCU'S ARE IN OPERATION, REMOVE THE EXISTING FCU'S.
3. PROGRAM THE NEW UNITS VIA THE NEW MATER CONTROLLER TO MATCH THE NEW SEQUENCE OF OPERATION.

- 1 REMOVE (E)ACCU (2 UNITS), CONCRETE PAD, REF/CD PIPING.
- 2 REMOVE (E)FCU (2 UNITS), DUCT CONNECTION, ASSOCIATED CONTROLS, T-STATS, AND WIRING.
- 3 REFER TO ELEC TO COORDINATE REMOVAL/RELOCATION OF LIGHT FIXTURES
- 4 REMOVE (E)30X30 EXH. FAN, ASSOCIATED CONTROLS, AND WIRING.

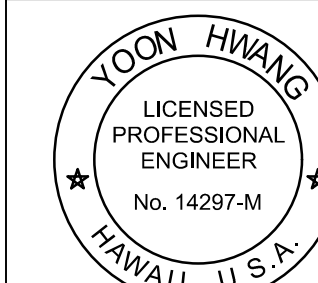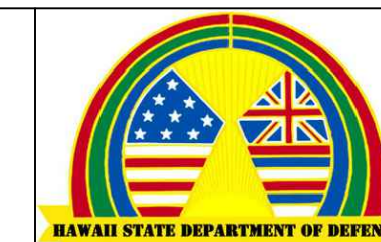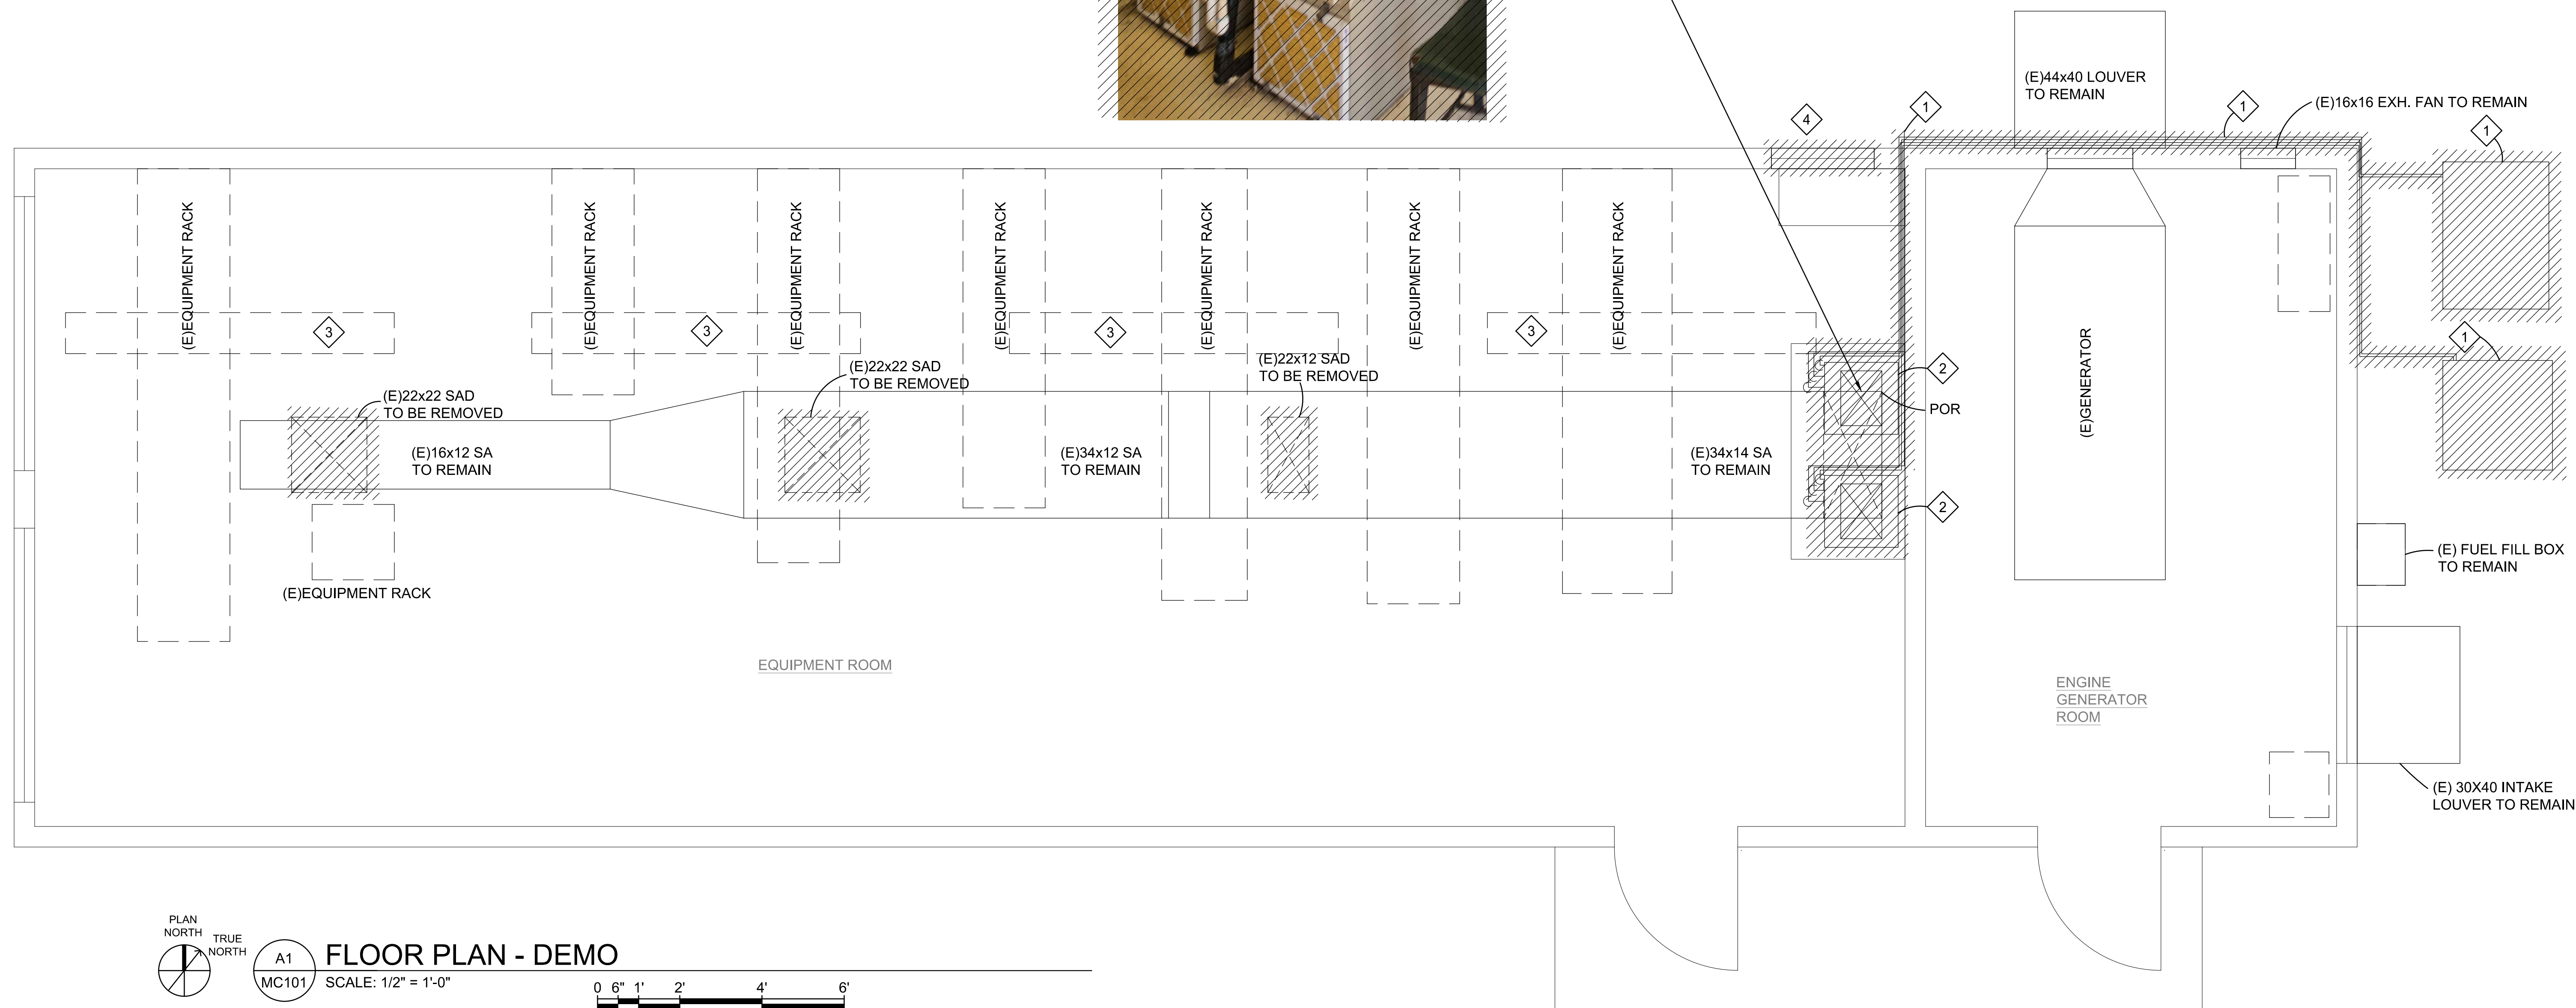

THIS WORK WAS PREPARED BY ME
OR UNDER MY SUPERVISION
4/30/2022
SIGNATURE _____ EXPIRATION DATE _____

SUBMITTAL PHASE							
CONSTRUCTION							
DOCUMENTS							

SUBMITTAL DATE			03/01/202		
YH		FM		Y	

DEPARTMENT OF DEFENSE	TMK: 3-1-042:006	ER (EOC)
-----------------------	------------------	----------

DIAMOND HEAD STATE MONUMENT
HONOLULU, HI 96816
EMERGENCY OPERATIONS
GRADES AND IMPROVEMENTS
FLOOR PLAN - DEMO

STATE OF HAWAII
44 DIAMOND HEAD RD
UPGRADE

SCALE: AS NOTED

STATE JOB NO.	CA-202313-C
---------------	-------------



FEDERAL PROJECT NO.

SHEET 59 OF 123

MC101

1. PRIOR TO DEMOLISHING EXISTING FCU'S, THE CONTRACTOR SHALL INSTALL NEW FCU C3/C4/C5.
2. ONCE THE NEW FCU'S ARE IN OPERATION, REMOVE THE EXISTING FCU'S.
3. PROGRAM THE NEW UNITS VIA THE NEW MATER CONTROLLER TO MATCH THE NEW SEQUENCE OF OPERATION.

- 1 MOUNT FCU-C3, C4, C5 TO THE ROOF SLAB, SEE A1/MC901.
- 2 MOUNT ACCU-C1-5 TO THE WALL, SEE B1/MC901.
- 3 DRYWELL, SEE C2/MC901.
- 4 PENETRATE THROUGH EXTERIOR WALL. PATCH AROUND PENETRATIONS UPON INSTALLATION OF REF. AND CD PIPING.
- 5 MOUNT EF-C1 IN THE WALL USING EXISTING PENETRATION. PATCH AROUND PENETRATION UPON INSTALLATION. SEE B3/MC901.

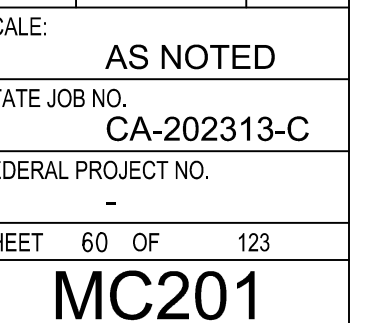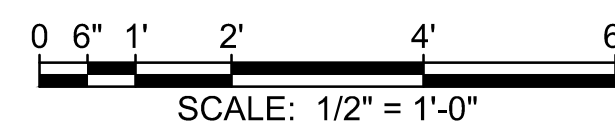


D


C

B



A1
MC601

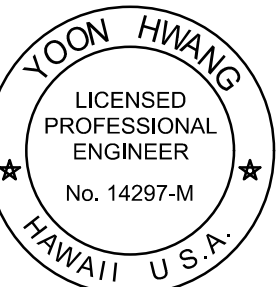

THIS WORK WAS PREPARED BY ME
UNDER MY SUPERVISION
 4/30/2026
SIGNATURE EXPIRATION DATE

[illegible]

CONSTRUCTION
DOCUMENTS

SUBMITTAL DATE		03/01/2024	
YH		FM	YH

TMK: 3-1-042:006
ER (EOC)

DIAMOND HEAD STATE MONUMENT
HONOLULU, HI 96816
**EMERGENCY OPERATIONS
GRADES AND IMPROVEMENTS**
OVERALL FLOOR PLAN

4204 DIAMOND HEAD RD
BIRKHIMER EM
UPG



SCALE: AS NOTED

STATE JOB NO.
CA-202313-C

FEDERAL PROJECT NO.

SHEET 64 OF 123

PA100

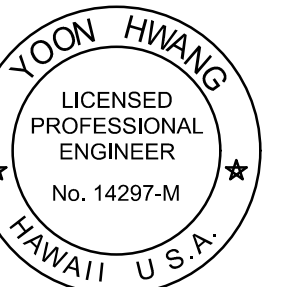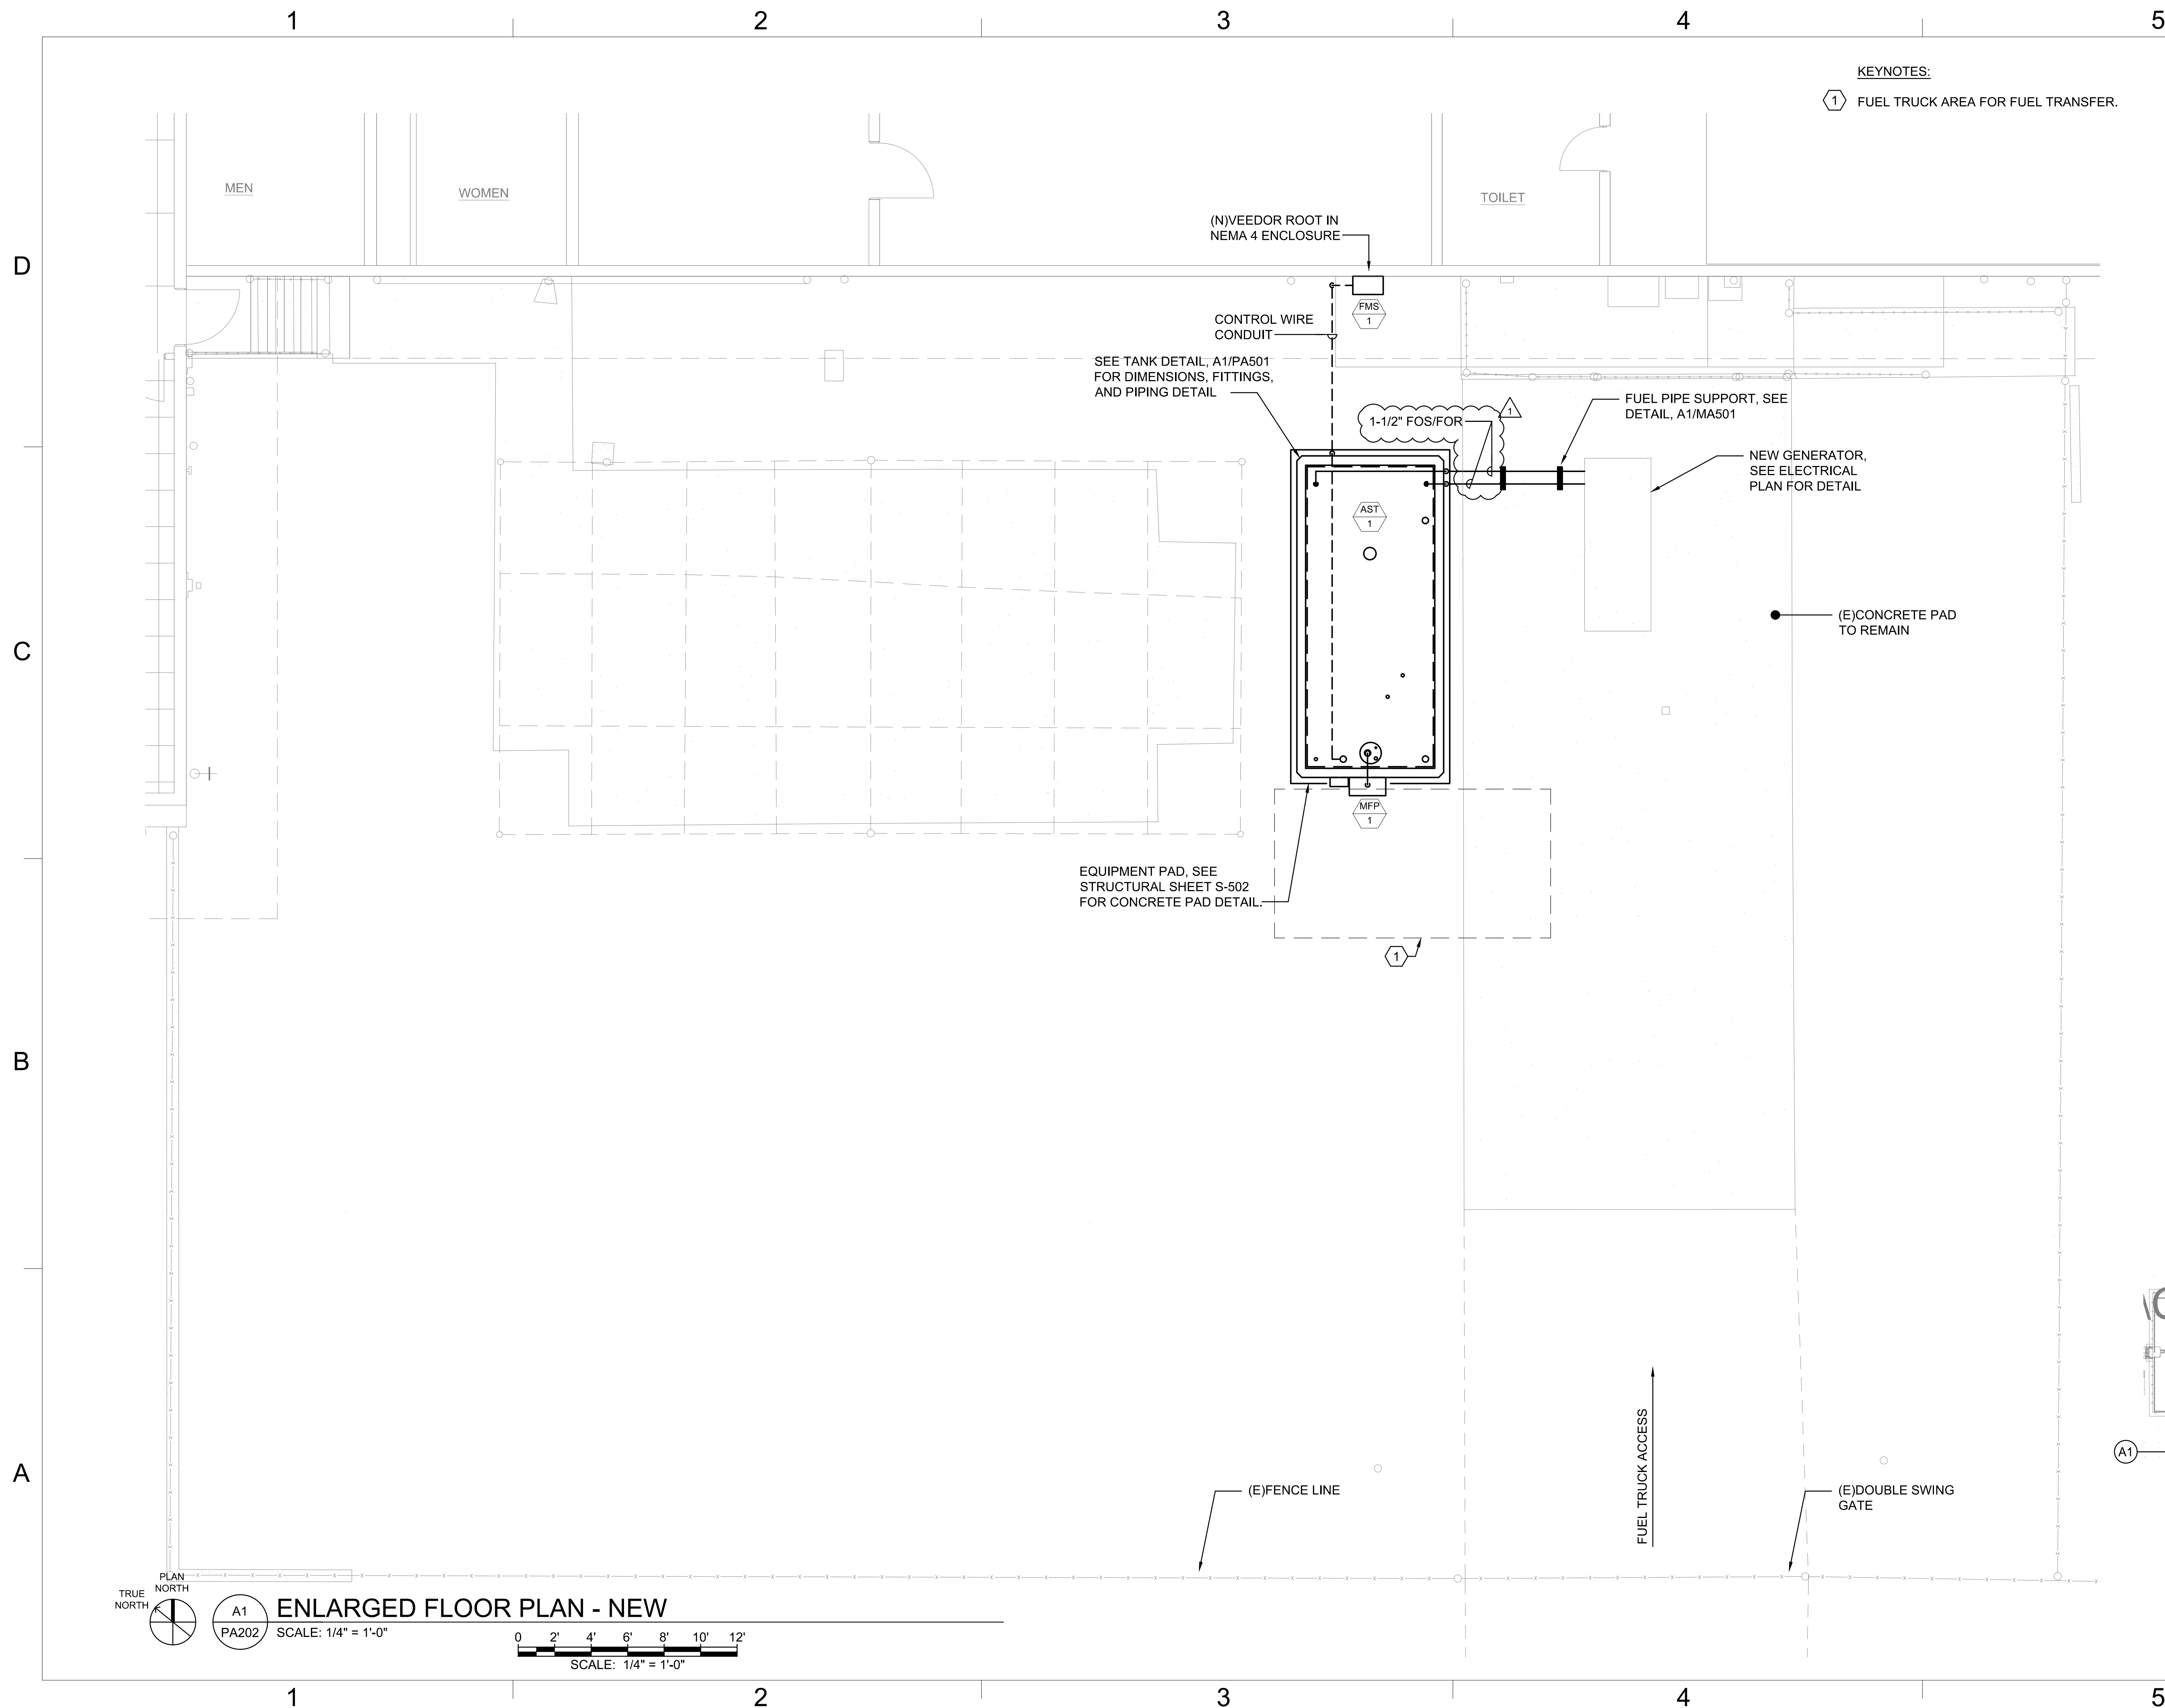

THIS WORK WAS PREPARED BY ME
UNDER MY SUPERVISION
4/30/2026
SIGNATURE EXPIRATION DATE

[illegible][illegible]

SUBMITTAL DATE		03/01/2024
YH	FM	YH

TMK: 3-1-042:006	ER (EOC)
------------------	----------

DIAMOND HEAD STATE MONUMENT
HONOLULU, HI 96816
EMERGENCY OPERATIONS CENTER
RADES AND IMPROVEMENTS
ENLARGED FLOOR PLAN - NEW


4204 DIAMOND HEAD RD
BIRKHIMER EM
UPG

SCALE:	AS NOTED		
STATE JOB NO.	CA-202313-C		
FEDERAL PROJECT NO.	-		
SHEET	66	OF	123

PA202



1. GENERATOR CONTROL PANEL SHALL CONTROL BUILT-IN FUEL SUPPLY PUMP TO CIRCULATE FUEL IN/OUT OF TANK.
2. COORDINATE WITH GENERATOR SUPPLIER TO CONNECT FOS/FOR TO GENERATOR.

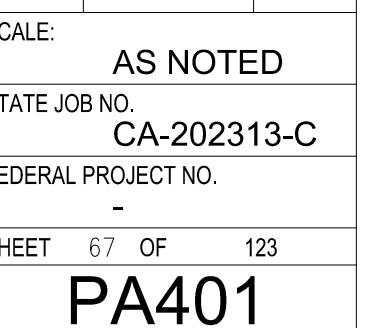

ABOVE GROUND FUEL STORAGE TANK SCHEDULE

UNIT ID	SERVING	TANK CAPACITY [GALLONS]	FUEL TYPE	AST DIMENSION			WT	OPER. WT	REMARKS
				LENGTH [IN]	WIDTH [IN]	HT [IN]	[LBS]	[LBS]	
AST-1	GENERATOR 1	4,000	FUEL NO. 2 DIESEL	17'-7 1/2"	8'-0 1/2"	6'-5 3/4"	45,000	95,040	1,2,3,4,5,6,7

1. PROVIDE TANK WITH STEEL INNER WALL AND CONCRETE OUTER WALL.
2. PROVIDE GROUNDING PER NFPA AND NEC CODE.
3. FILL TANK TO 90% OF ITS RATED CAPACITY.
4. TANK SHALL BE TESTED PER MANUFACTURER'S RECOMMENDATION PRIOR TO OPERATION.
5. PROVIDE STAINLESS STEEL FITTINGS.
6. TANK SHALL BE PAINTED A "PRAIRIE DUSK" COLOR.
7. SEE SPECS FOR ADDITIONAL INFORMATION.


MANUAL FUEL PORT SCHEDULE

UNIT ID	SERVING	ELECTRICAL FOR TANK ALARM PANEL			TRANSMITTER	MAKE AND MODEL	REMARKS
		[V]	[PH]	[HZ]	FITTING PER TANK		
MFP-1	AST-1	120	1	60	3"	SIMPLEX	1,2,3


NOTES:

1. PROVIDE WITH MANUAL ALARM PANEL.
2. PROVIDE WITH FUEL TANK MONITORING PANEL.
3. PROVIDE FUEL LEVEL GAUGE PROBE.

UNIT ID	AREA SERVED	DESCRIPTION	FUEL TYPE
FMS-1	AST-1	TCP/IP COMM. MODULE, 1INTERSTITIAL SENSOR FOR STEEL TANK, 3XLOW POINT PIPE LEAK DETECTION SENSORS. 1X FUEL LEVEL PROBE. AND 1X HYDROCARBON SENSOR	DIESEL FUEL NO. 2

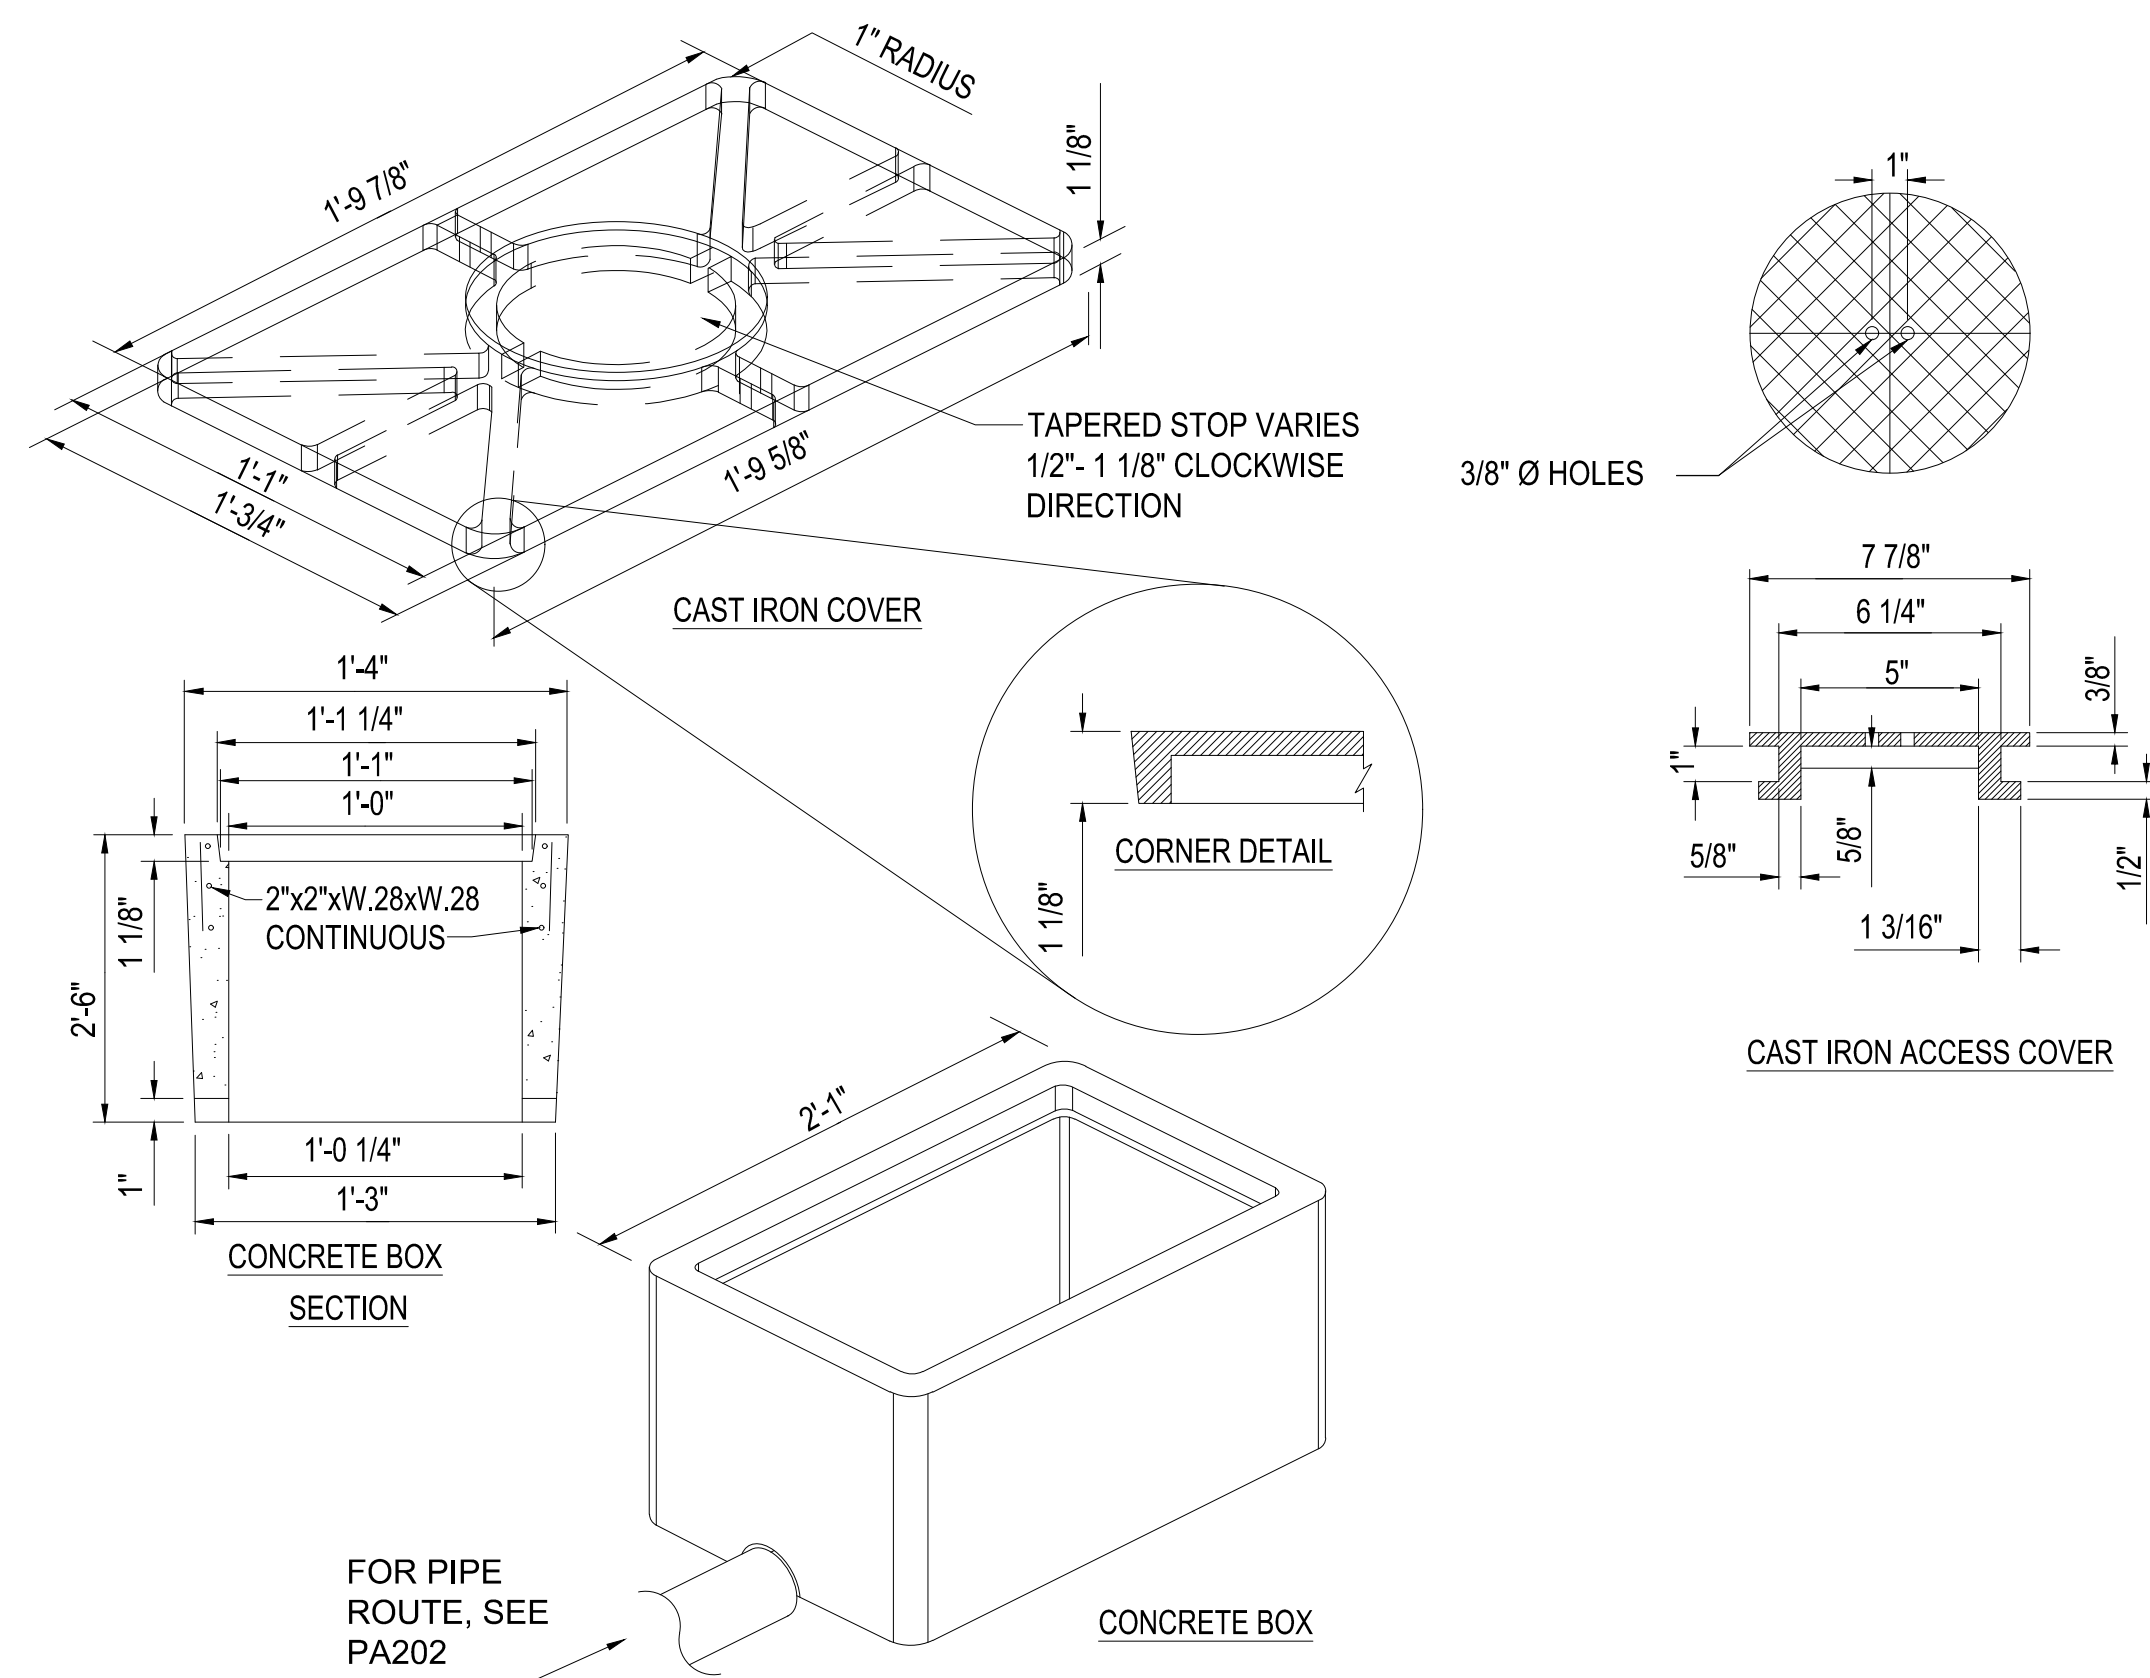

A1) WATER METER PIT DETAIL
PA601 SCALE: NTS

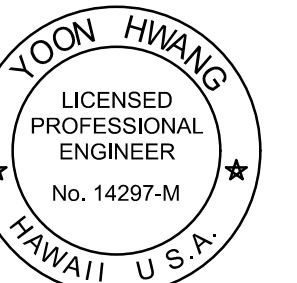

THIS WORK WAS PREPARED BY ME
OR UNDER MY SUPERVISION

SIGNATURE _____ EXPIRATION DATE 4/30/2026

[illegible][illegible][illegible]

CONSTRUCTION DOCUMENTS

SUBMITTAL DATE			03/01/2024
YH	FM	YH	

TMK: 3-1-042:006	ER (EOC)
------------------	----------

DIAMOND HEAD STATE MONUMENT

4204 DIAMOND HEAD RD HONOLULU, HI 96816

**BIRKHMIR EMERGENCY OPERATIONS CENTER
UPGRADES AND IMPROVEMENTS**

PLUMBING SCHEDULES

SCALE: AS NOTED

STATE JOB NO.
CA-202313-C

FEDERAL PROJECT NO.

SHEET 69 OF 123

PA601



HATCHED PLUMBING ITEMS TO BE REMOVED UP TO POR.
REFER TO ARCHITECTURAL DRAWINGS FOR GENERAL
PATCHWORK NOTES.

DEMOLISH (E)EWH

DEMOLISH ALL (E)WC (TYP.7)

- 1 SEE PLUMBING DETAIL P7.
- 2 MANUAL CIRCUIT SETTER. BALANCE TO 0.33 GPM. INCLUDE FINAL SETTING AS PART OF TAB REPORT.

FIVE WORKING SHIFTS.

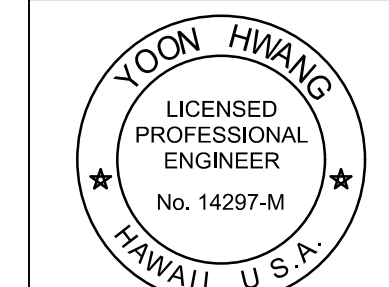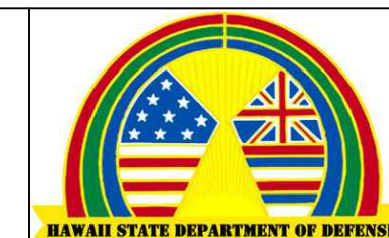

THIS WORK WAS PREPARED BY ME
OR UNDER MY SUPERVISION
J. [Signature] 4/30/2026
SIGNATURE EXPIRATION DATE



[illegible][illegible]

SUBMITTAL DATE			03/01/2024
YH	FM	YH	

SE	16	
----	----	--

STATE OF HAWAII	DIAMOND HEAD STATE MONUMENT	DEPARTMENT OF DEFENSE
4204 DIAMOND HEAD RD HONOLULU, HI 96816	<p align="center"> BIRKHIMER EMERGENCY OPERATIONS CENTER (EOC) UPGRADES AND IMPROVEMENTS </p> <p align="center">ENLARGED DOMESTIC WATER FLOOR PLANS</p>	
		TWK: 3-1-042.00




SCALE:			AS NOTED		
STATE JOB NO.			CA-202313-C		
FEDERAL PROJECT NO.			-		
SHEET	72	OF		123	
PB102					

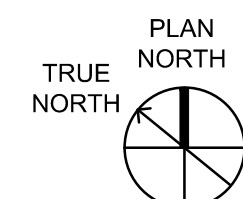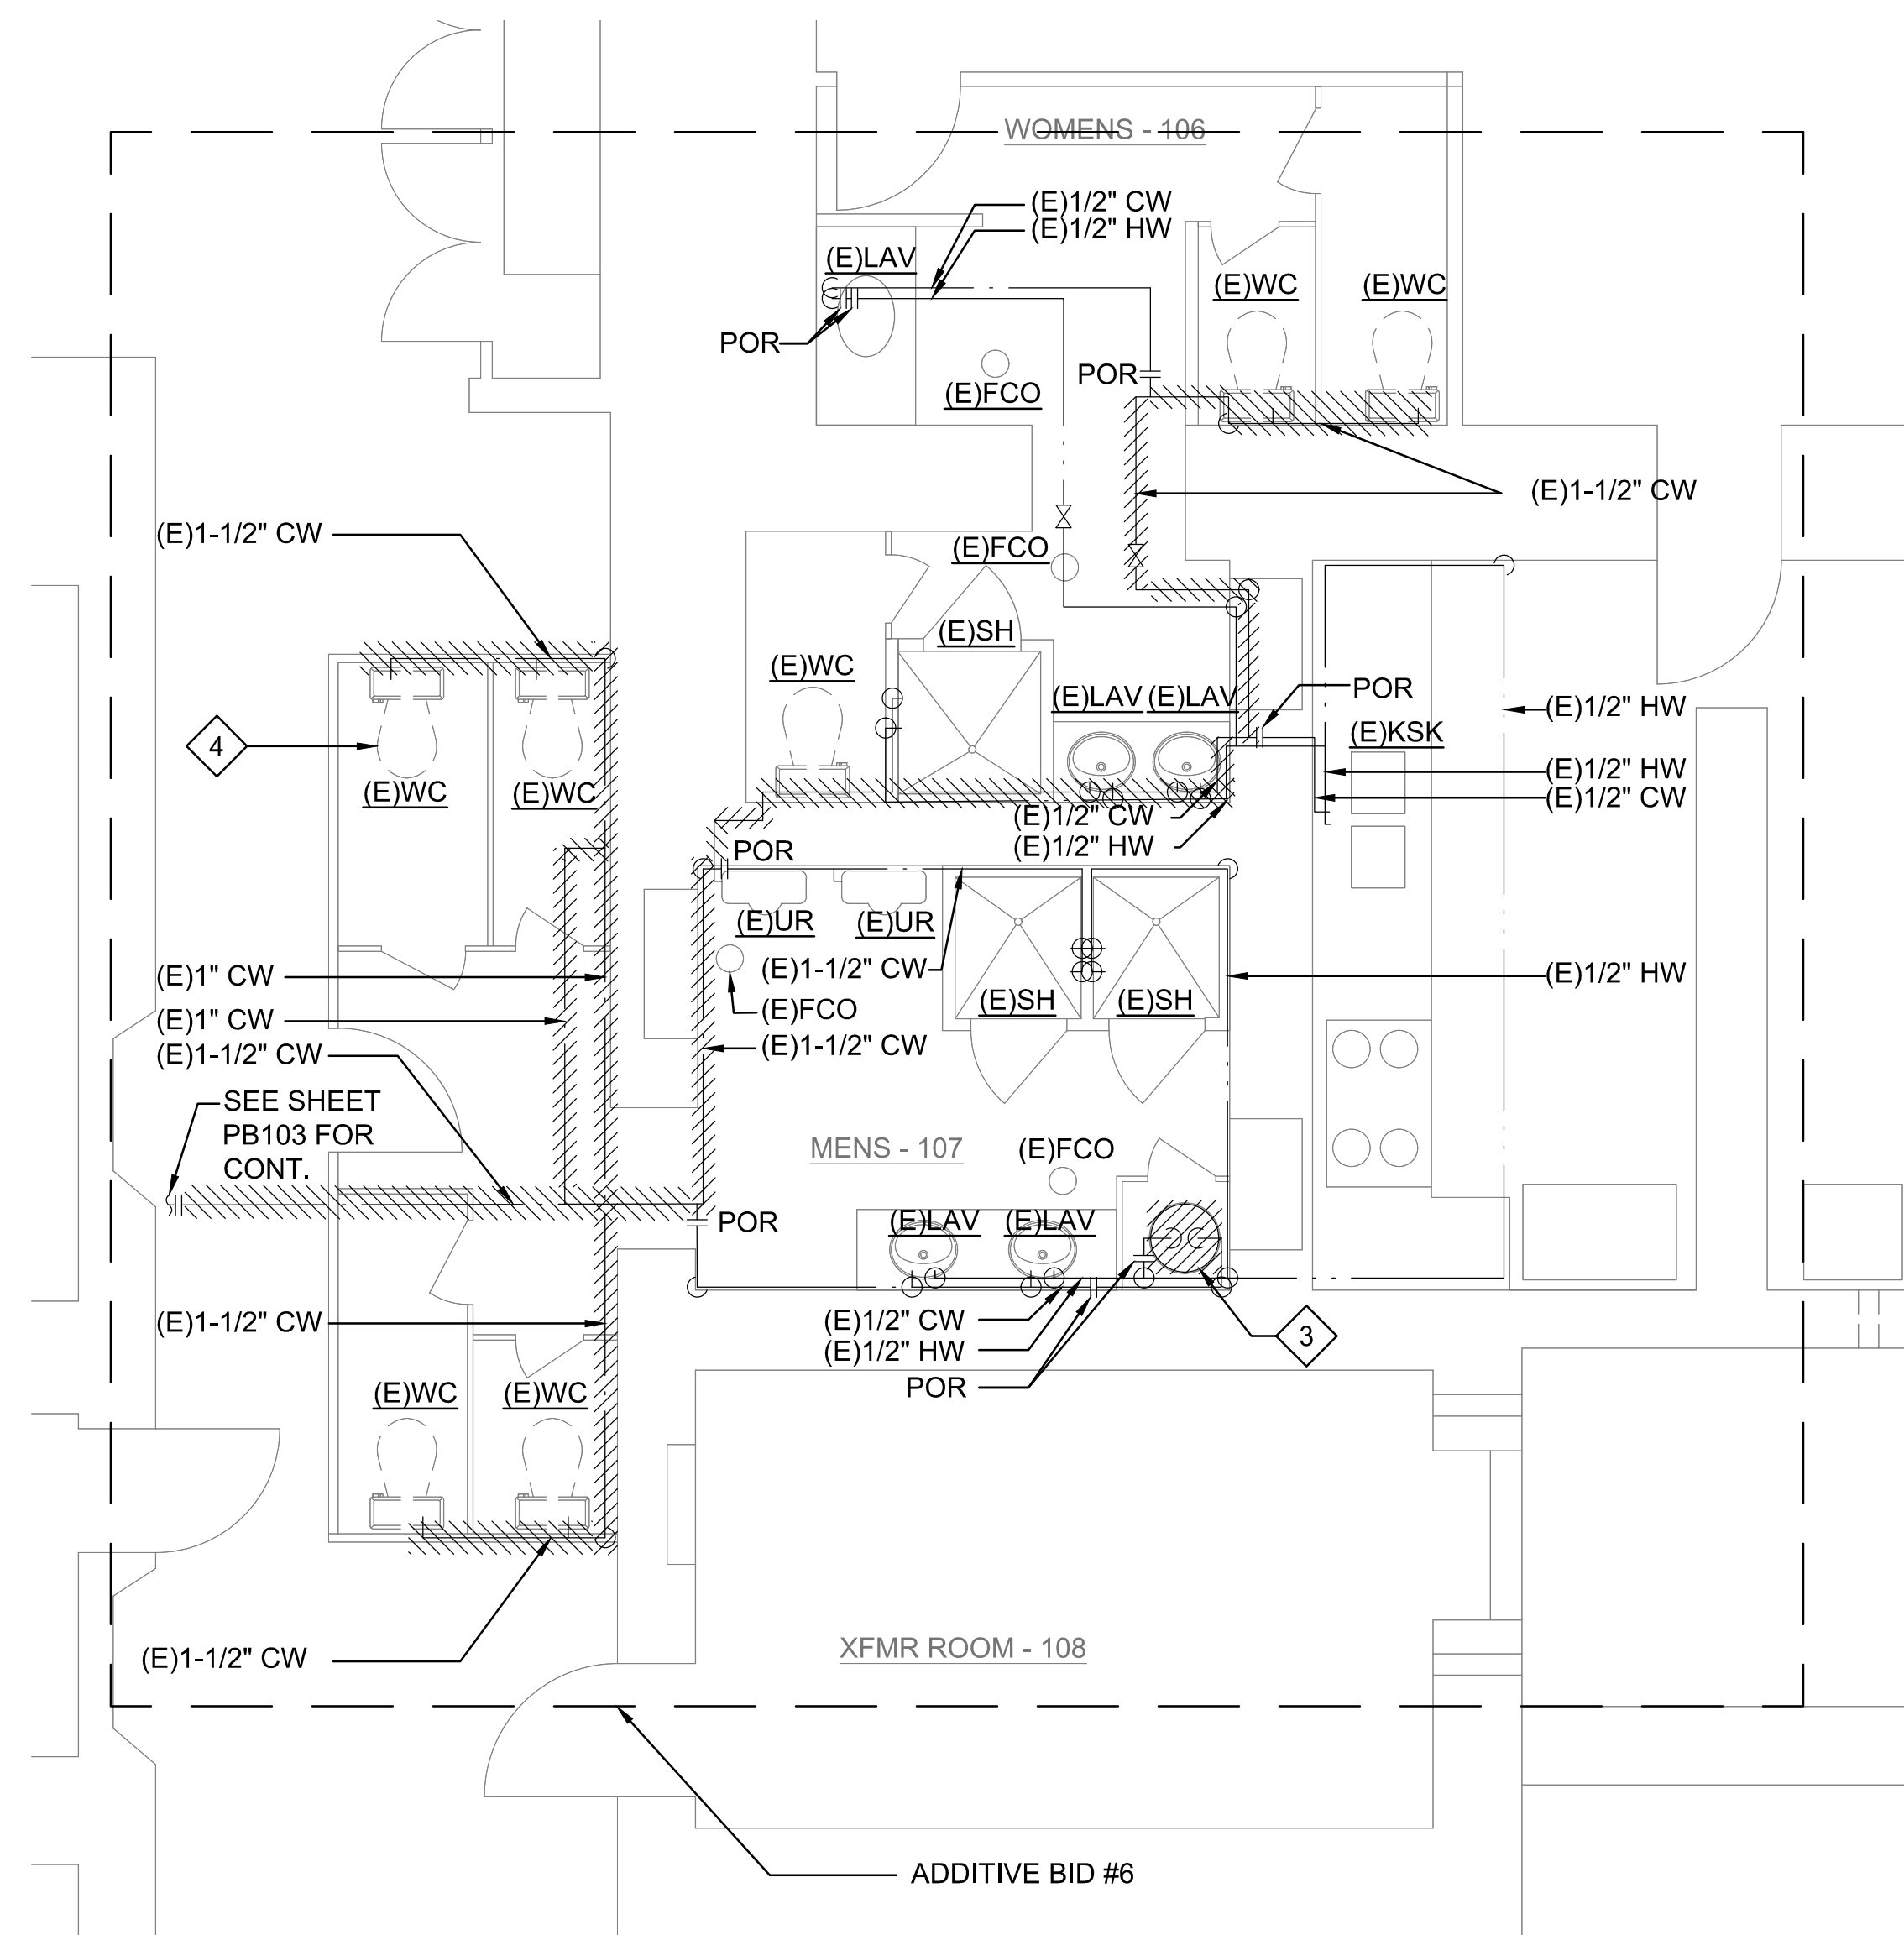

A1
PB102

ENLARGED DOMESTIC WATER FLOOR PLAN - DEMO



SCALE: 1/4" = 1'-0"

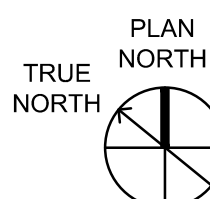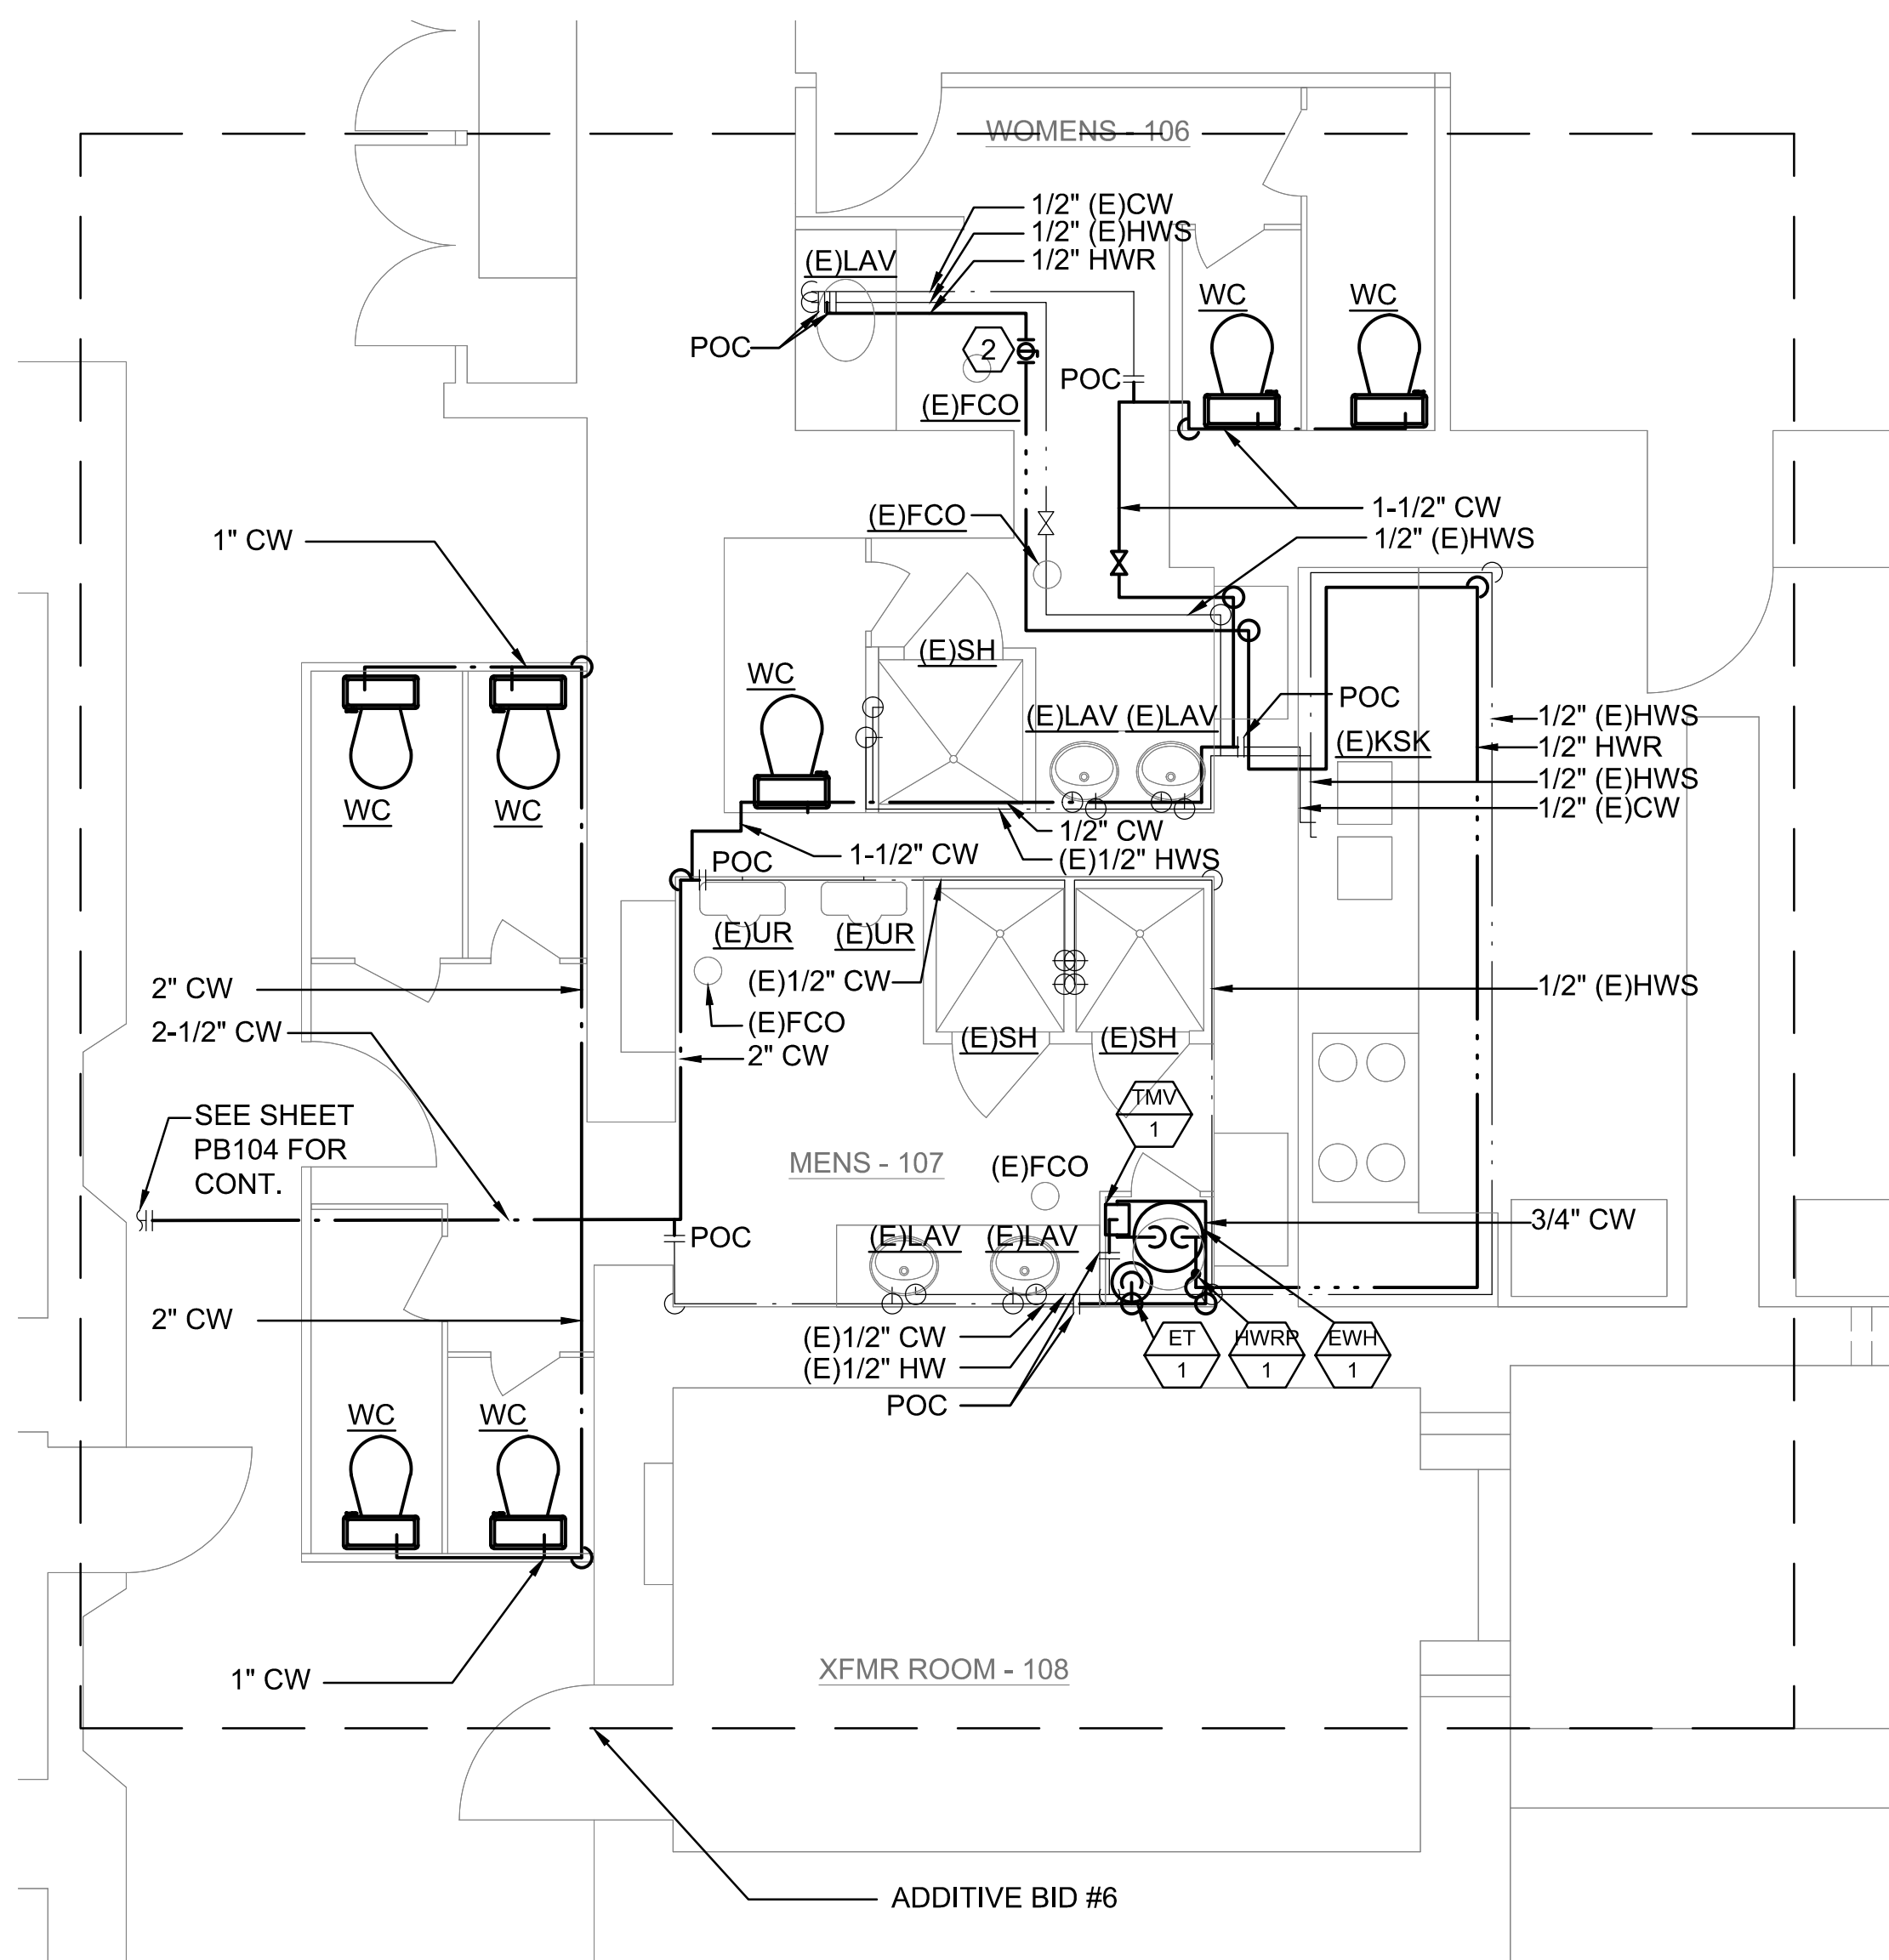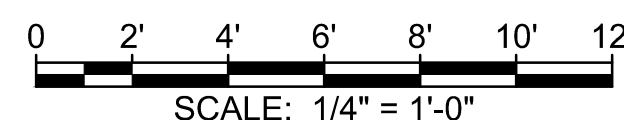

A3
PB102



ENLARGED DOMESTIC WATER FLOOR PLAN - NEW

PB102 SCALE: 1/4" = 1'-0"

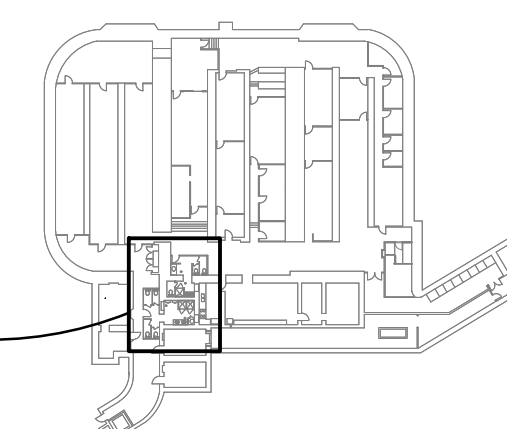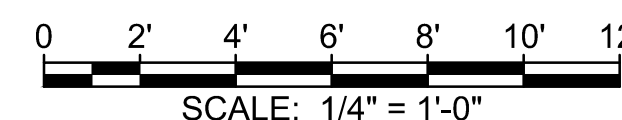

KEY PLAN

SCALE: NTS

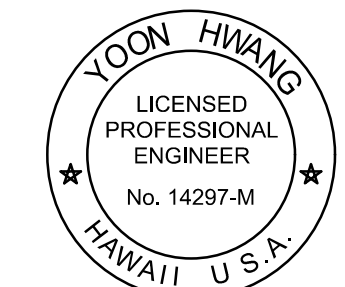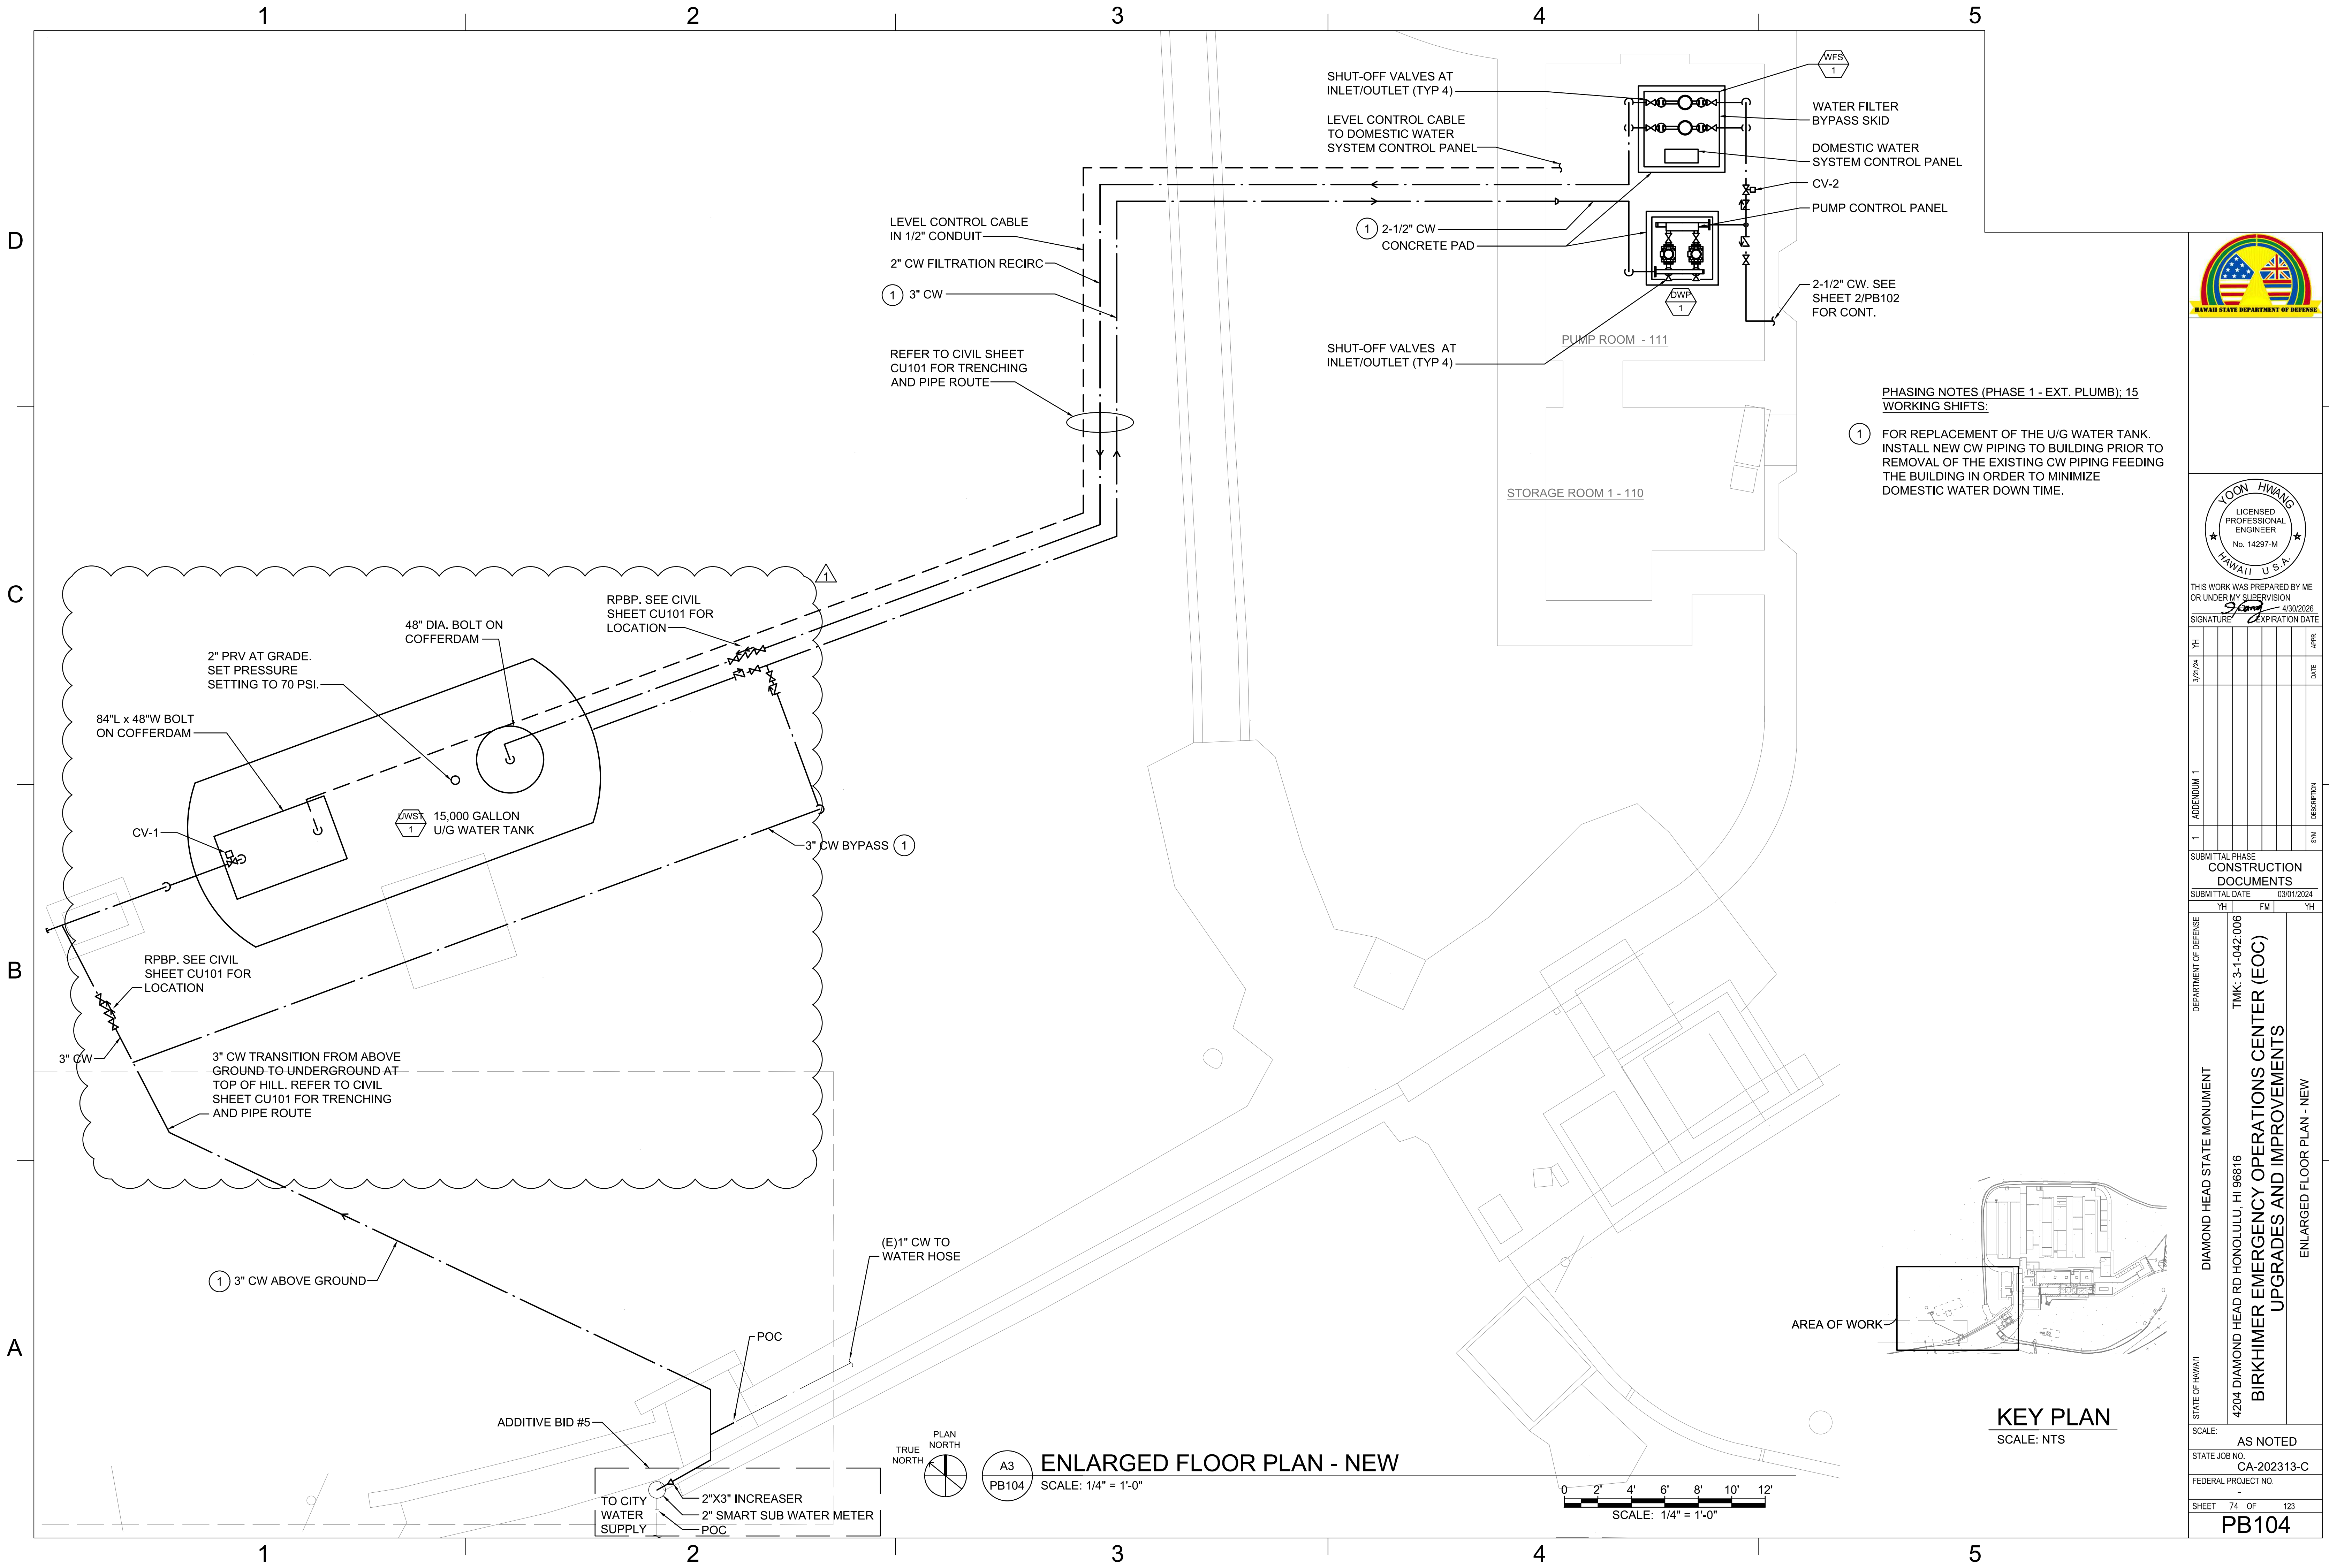

THIS WORK WAS PREPARED BY ME OR UNDER MY SUPERVISION
SIGNATURE: *Yoon Hwang* EXPIRATION DATE: 4/30/2026

YH	FM	YH	APR	DATE	DESCRIPTION
3/2/24					
ADDENDUM 1					
1					

SUBMITTAL PHASE
CONSTRUCTION DOCUMENTS

SUBMITTAL DATE: 03/01/2024

DEPARTMENT OF DEFENSE
TMK: 3-1-042:006

DIAMOND HEAD STATE MONUMENT
4204 DIAMOND HEAD RD HONOLULU, HI 96816
BIRKHAMER EMERGENCY OPERATIONS CENTER (EOC)
UPGRADES AND IMPROVEMENTS
ENLARGED FLOOR PLAN - NEW

SCALE: AS NOTED

STATE JOB NO. CA-202313-C

FEDERAL PROJECT NO.

SHEET 74 OF 123

PB104

1

2

3

4

5

PHASING NOTES (PHASE 1 - FUEL PLUMB); 15 WORKING SHIFTS:

1. INSTALL TEMPORARY FUEL TANK (AST-3); 500 GALLONS, UL142, 86" L x 45" W x 51" H. SEE SHEET A2/PB401 FOR SEQUENCE OF INSTALLATION.
2. INSTALL TEMPORARY FUEL PUMP (FP-1); 15 GPM, 15 FT HEAD, 120V POWER. SEE SHEET A2/PB401 FOR SEQUENCE OF INSTALLATION.

GENERAL NOTES:

1. IF REMOVING, MULTI-INCREMENT SOIL SAMPLELINE SHALL BE PERFORMED. FOR PIPE RUNS OF 90 FEET OR LESS, ONE SOIL SAMPLE IS RECOMMENDED. PIPING EXTERIOR SHALL BE CLEANED AND INSPECTED FOR SIGNS OF CORROSION AND LEAKAGE.
2. ENSURE NO SPILLAGE OF THE PIPING CONTENTS OCCUR, NOTIFY FUEL RELEASE TO HDOH IMMEDIATELY AND CLEANUP.

KEYED NOTES:

1. REMOVE EQUIPMENT AND ANY ASSOCIATED PIPING, SUPPORTS, CONTROLS, AND WIRING.
2. REMOVE PIPING/CONDUIT AND ANY ASSOCIATED SUPPORTS.
3. CONTRACTOR TO VERIFY PIPE SIZE.

KEYED NOTES CONT.:

4. RECOVER FUEL IN THE (E)U/G STORAGE TANK PRIOR TO REMOVAL. USE THE RECOVERED FUEL TO FILL THE NEW ABOVEGROUND FUEL STORAGE TANK.
5. (E)U/G PIPING FROM (E)FUEL TANK. CONTRACTOR TO VERIFY PIPE SIZE AND IF IT IS SERVING ANY ACTIVE EQUIPMENT. DEMO IF THE PIPING IS CONFIRMED TO BE ABANDONED.

STORAGE ROOM 2 - 109

REMOVE FOV TERMINATION ABOVE GROUND

3/4" FOR (2" O.D - DOUBLE WALL)

LEAK DETECTION CABLE AT LOW POINT OF U/G FOR PIPING

POR

POR

3/4" FOS (2" O.D - DOUBLE WALL)

FUEL MONITORING CABLE

6,000 GALLON U/G FUEL STORAGE TANK

MECHANICAL ROOM - 105


(E)FP

(E)DAYTANK
(E)FP CONTROL PANEL

POR FOR LEAK DETECTION CABLES, RECONNECT TO NEW PANEL

FUEL MONITORING PANEL TO BE REMOVED


LEAK DETECTION CABLE TO FOS/FOR PIPING TO REMAIN

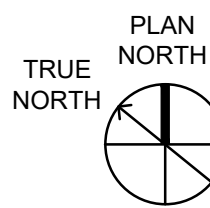

B4
PB105

ENLARGED FLOOR PLAN - MECH ROOM - DEMO


SCALE: 1/4" = 1'-0"

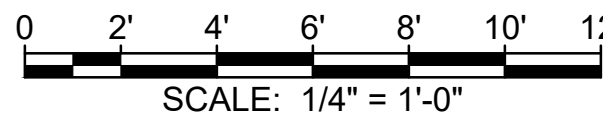

A1
PB105

ENLARGED FLOOR PLAN - DEMO

SCALE: 1/4" = 1'-0"

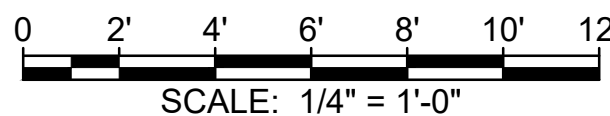


AST-3 1
FP-1 2

FOR TYPICAL TRAFFIC CONTROL MEASURE, SEE SHEET CP501

KEY PLAN

SCALE: NTS

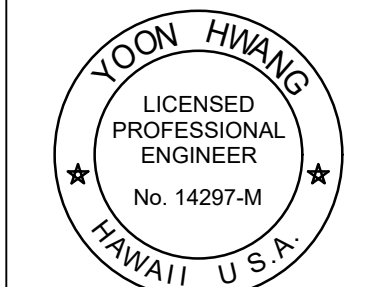

THIS WORK WAS PREPARED BY ME OR UNDER MY SUPERVISION

SIGNATURE: *Yoon Hwang* EXPIRATION DATE: 4/30/2026

YH

3/2/24

DATE

APPRO

DESCRIPTION

SYN

ADDITION 1

CONSTRUCTION DOCUMENTS

SUBMITTAL DATE 03/01/2024

YH FM YH

DEPARTMENT OF DEFENSE

DIAMOND HEAD STATE MONUMENT

4204 DIAMOND HEAD RD HONOLULU, HI 96816

TMK: 3-1-042:006

BIRKHMER EMERGENCY OPERATIONS CENTER (EOC)

UPGRADES AND IMPROVEMENTS

ENLARGED FLOOR PLAN - DEMO




SCALE: AS NOTED

STATE JOB NO. CA-202313-C

FEDERAL PROJECT NO.


SHEET 75 OF 123

PB105

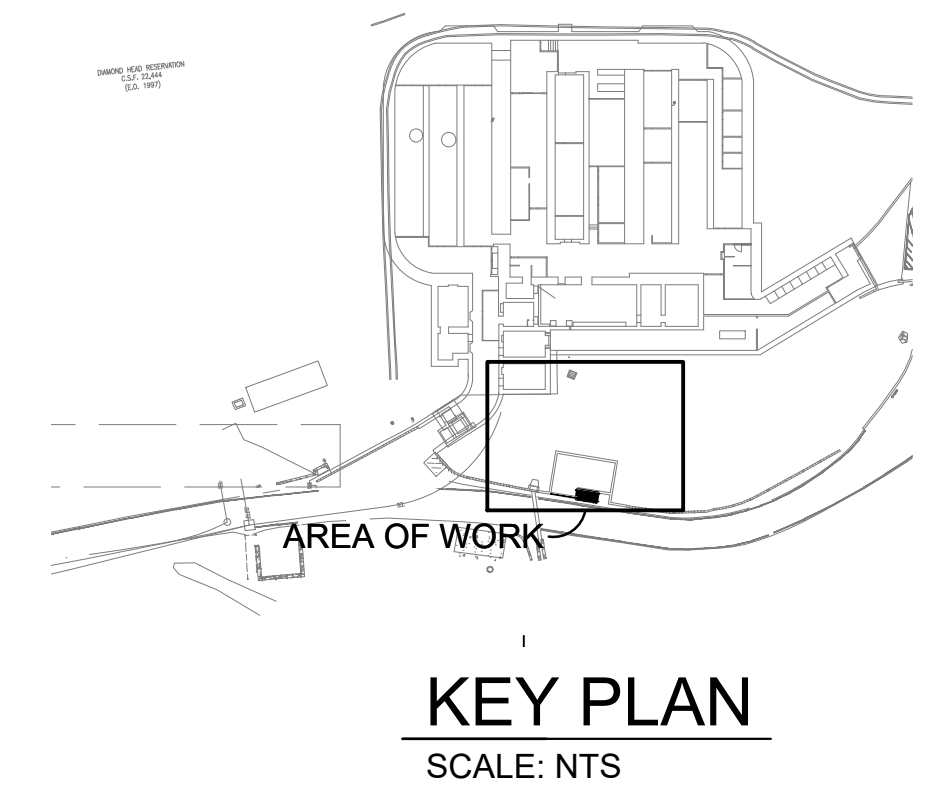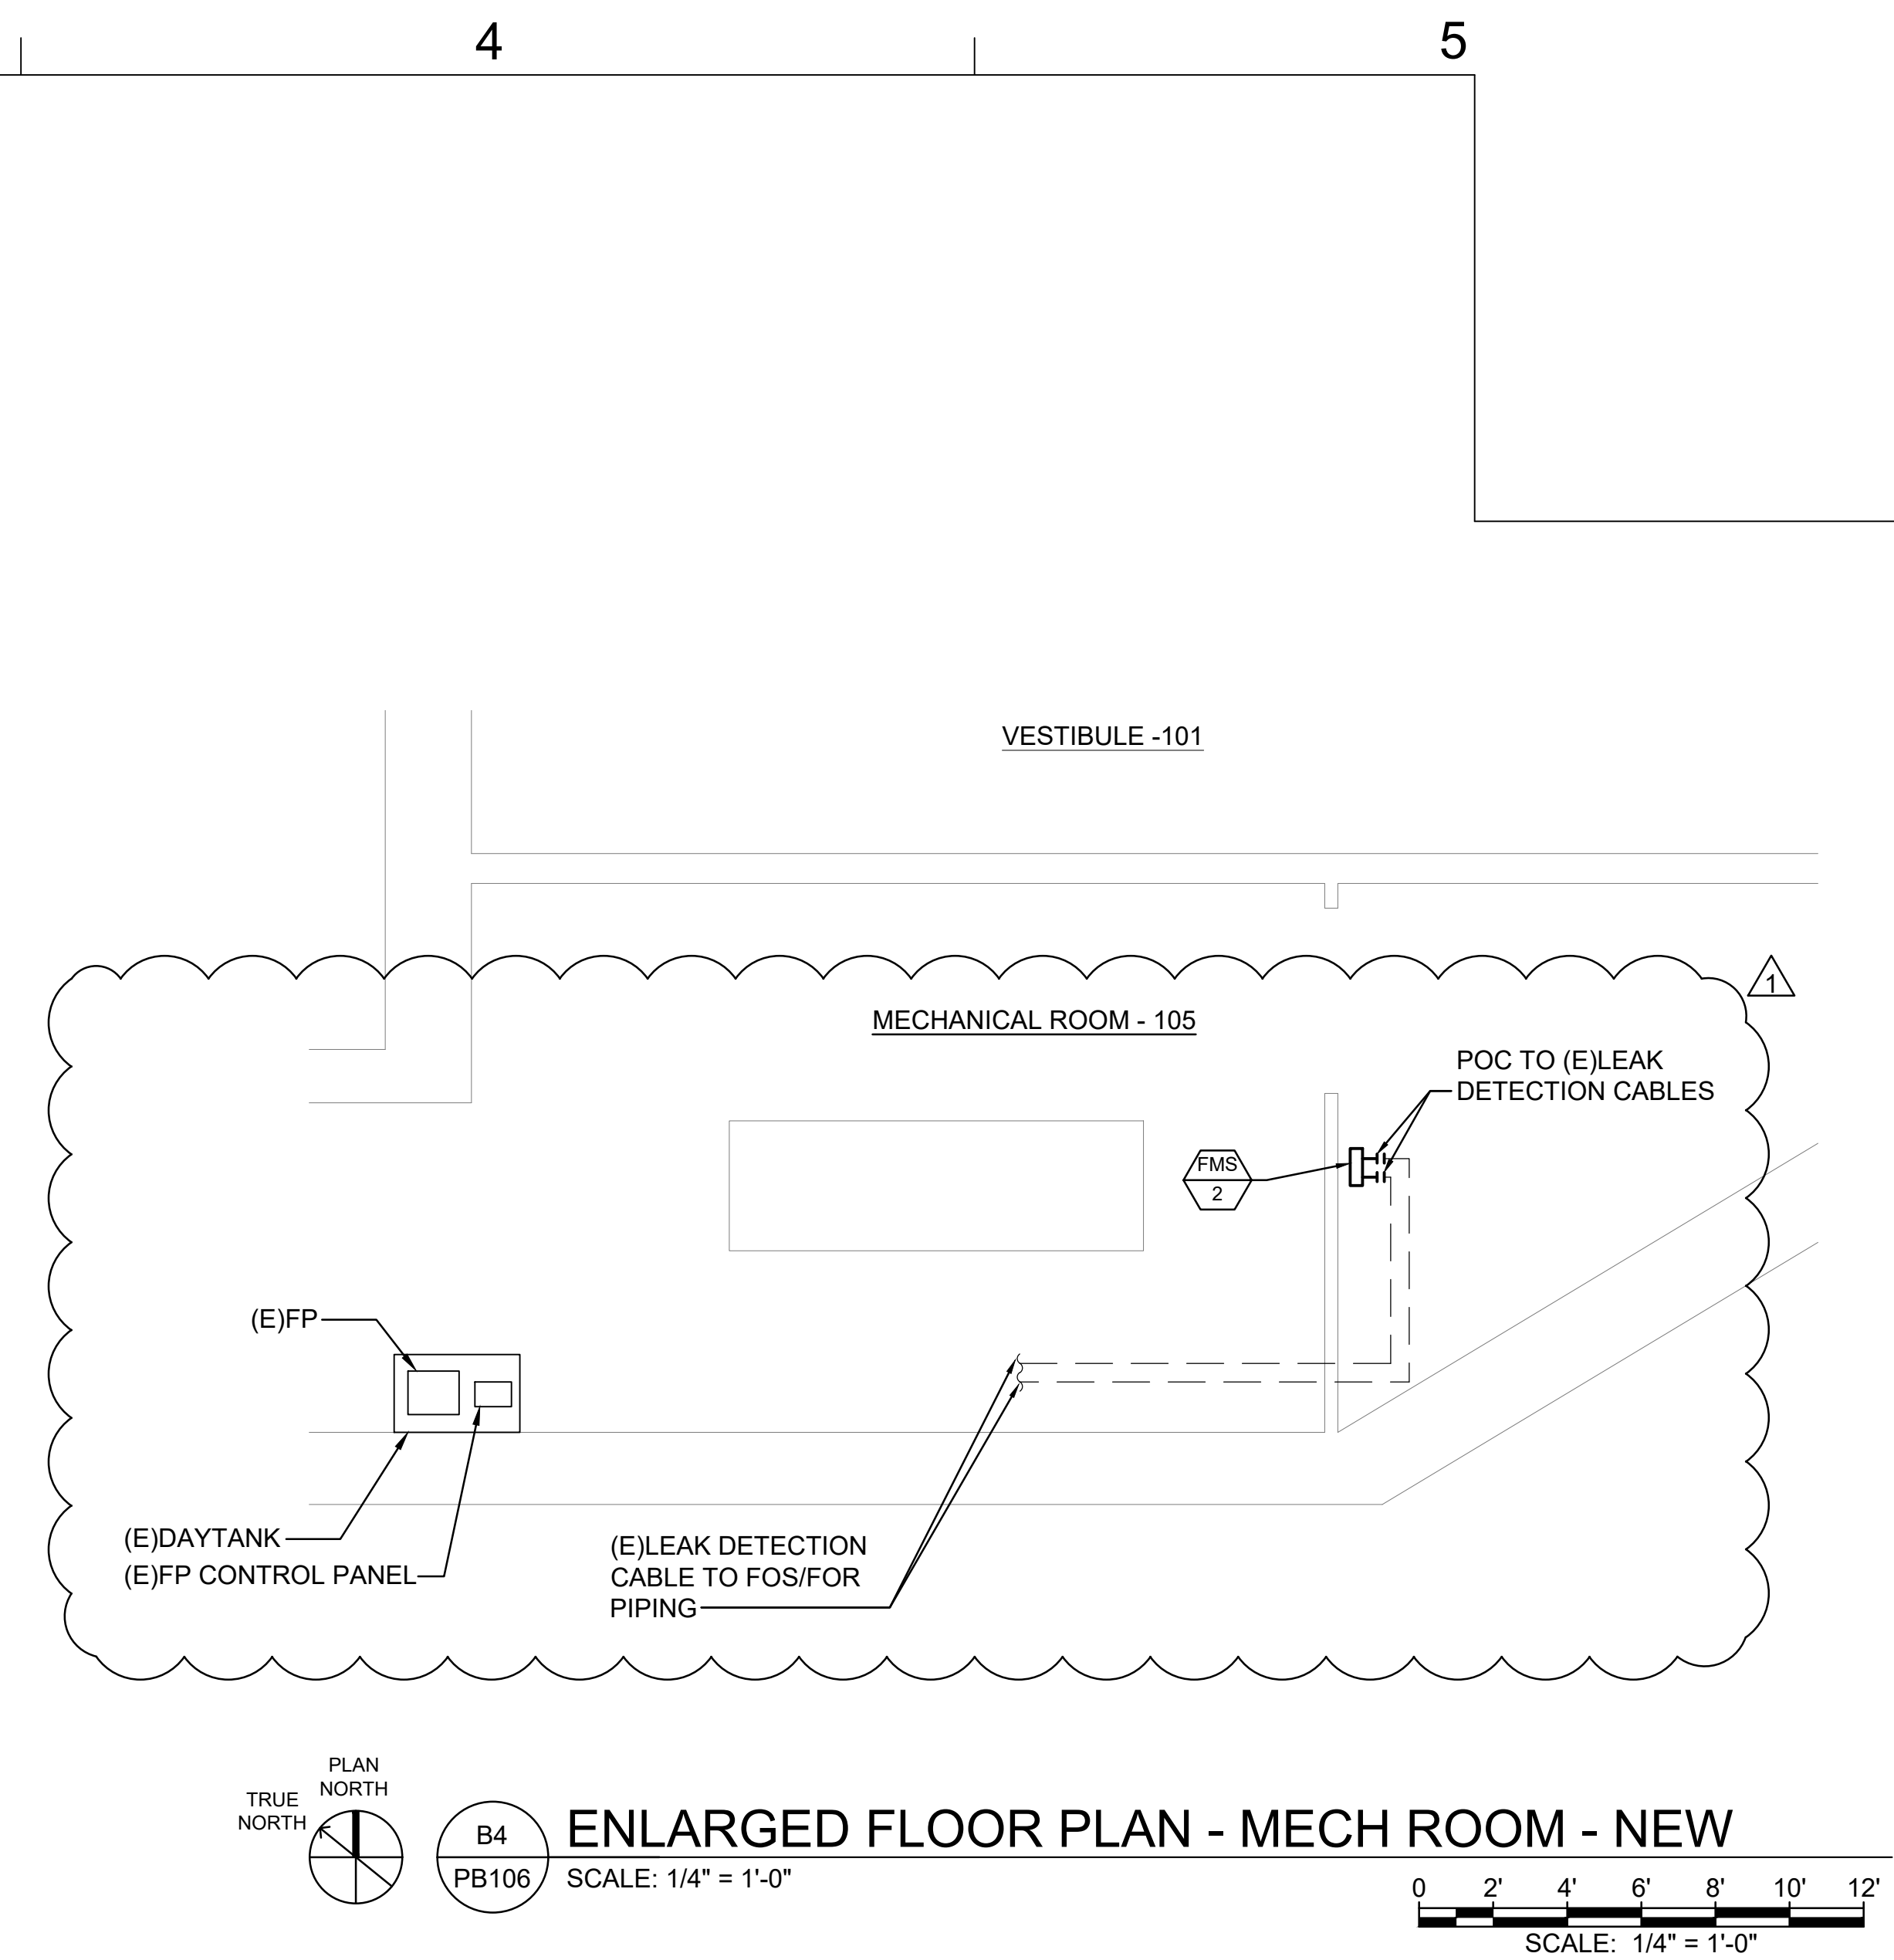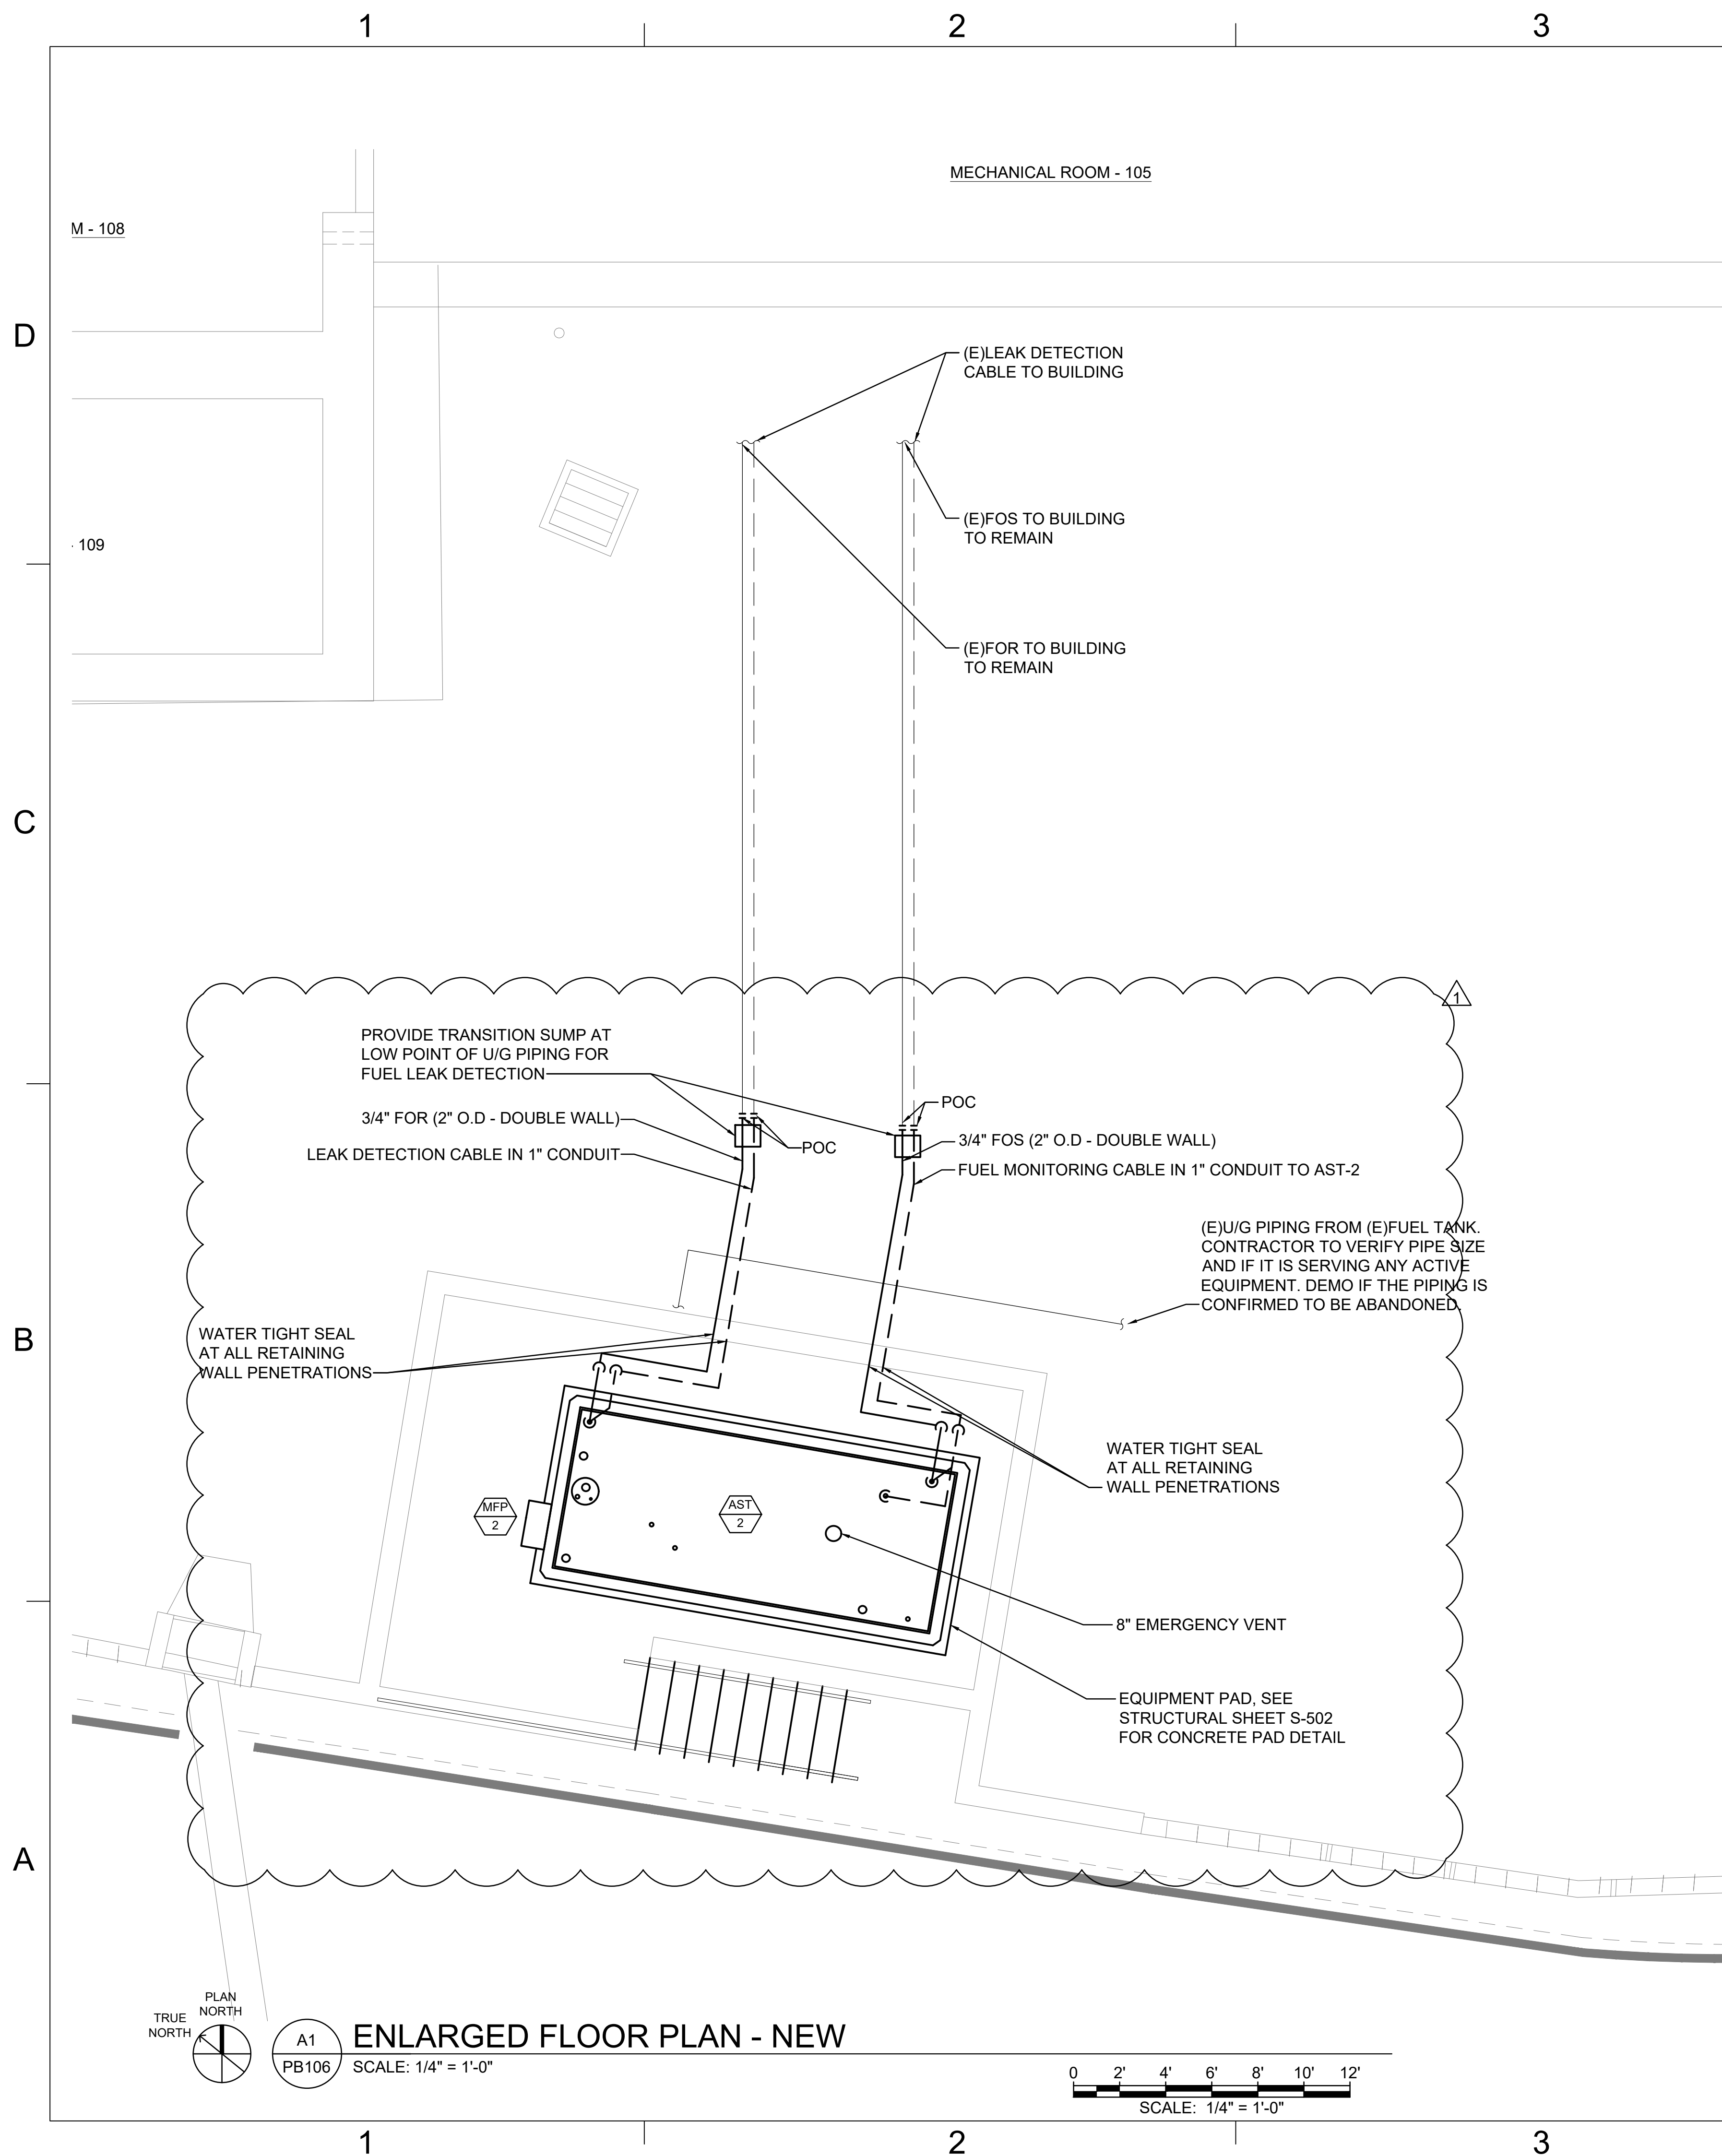

PHASING NOTES (PHASE 1 - FUEL PLUMB); 15 WORKING SHIFTS:

- ① INSTALL NEW ABOVEGROUND FUEL TANK PRIOR TO THE REMOVAL OF THE EXISTING U/G FUEL TANK. NEW FUEL PIPING SHALL ALSO BE INSTALLED AS CLOSE AS POSSIBLE TO THE POC PRIOR TO THE REMOVAL OF EXISTING FUEL PIPING.

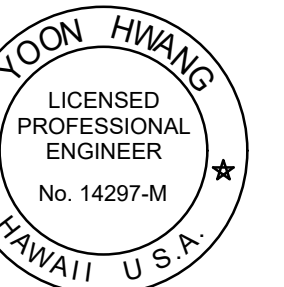

THIS WORK WAS PREPARED BY ME
UNDER MY SUPERVISION
4/30/2026
SIGNATURE EXPIRATION DATE

[illegible][illegible]

CONSTRUCTION
DOCUMENTS

SUBMITTAL DATE			03/01/2024
YH	FM	YH	

TMK: 3-1-042:006	ER (EOC)
------------------	----------

DIAMOND HEAD STATE MONUMENT
HONOLULU, HI 96816
EMERGENCY OPERATIONS CENT
RADES AND IMPROVEMENTS
ENLARGED FLOOR PLAN - NEW

4204 DIAMOND HEAD RD H
BIRKHIMER EM
UPGI




SCALE: AS NOTED

STATE JOB NO.
CA-202313-C

FEDERAL PROJECT NO.
-

HEET 76 OF 123

PB106

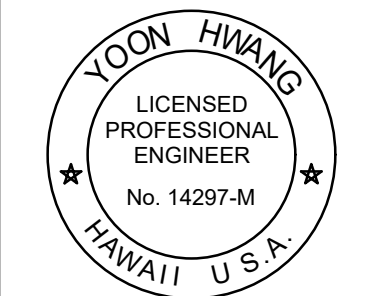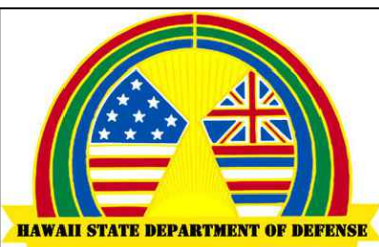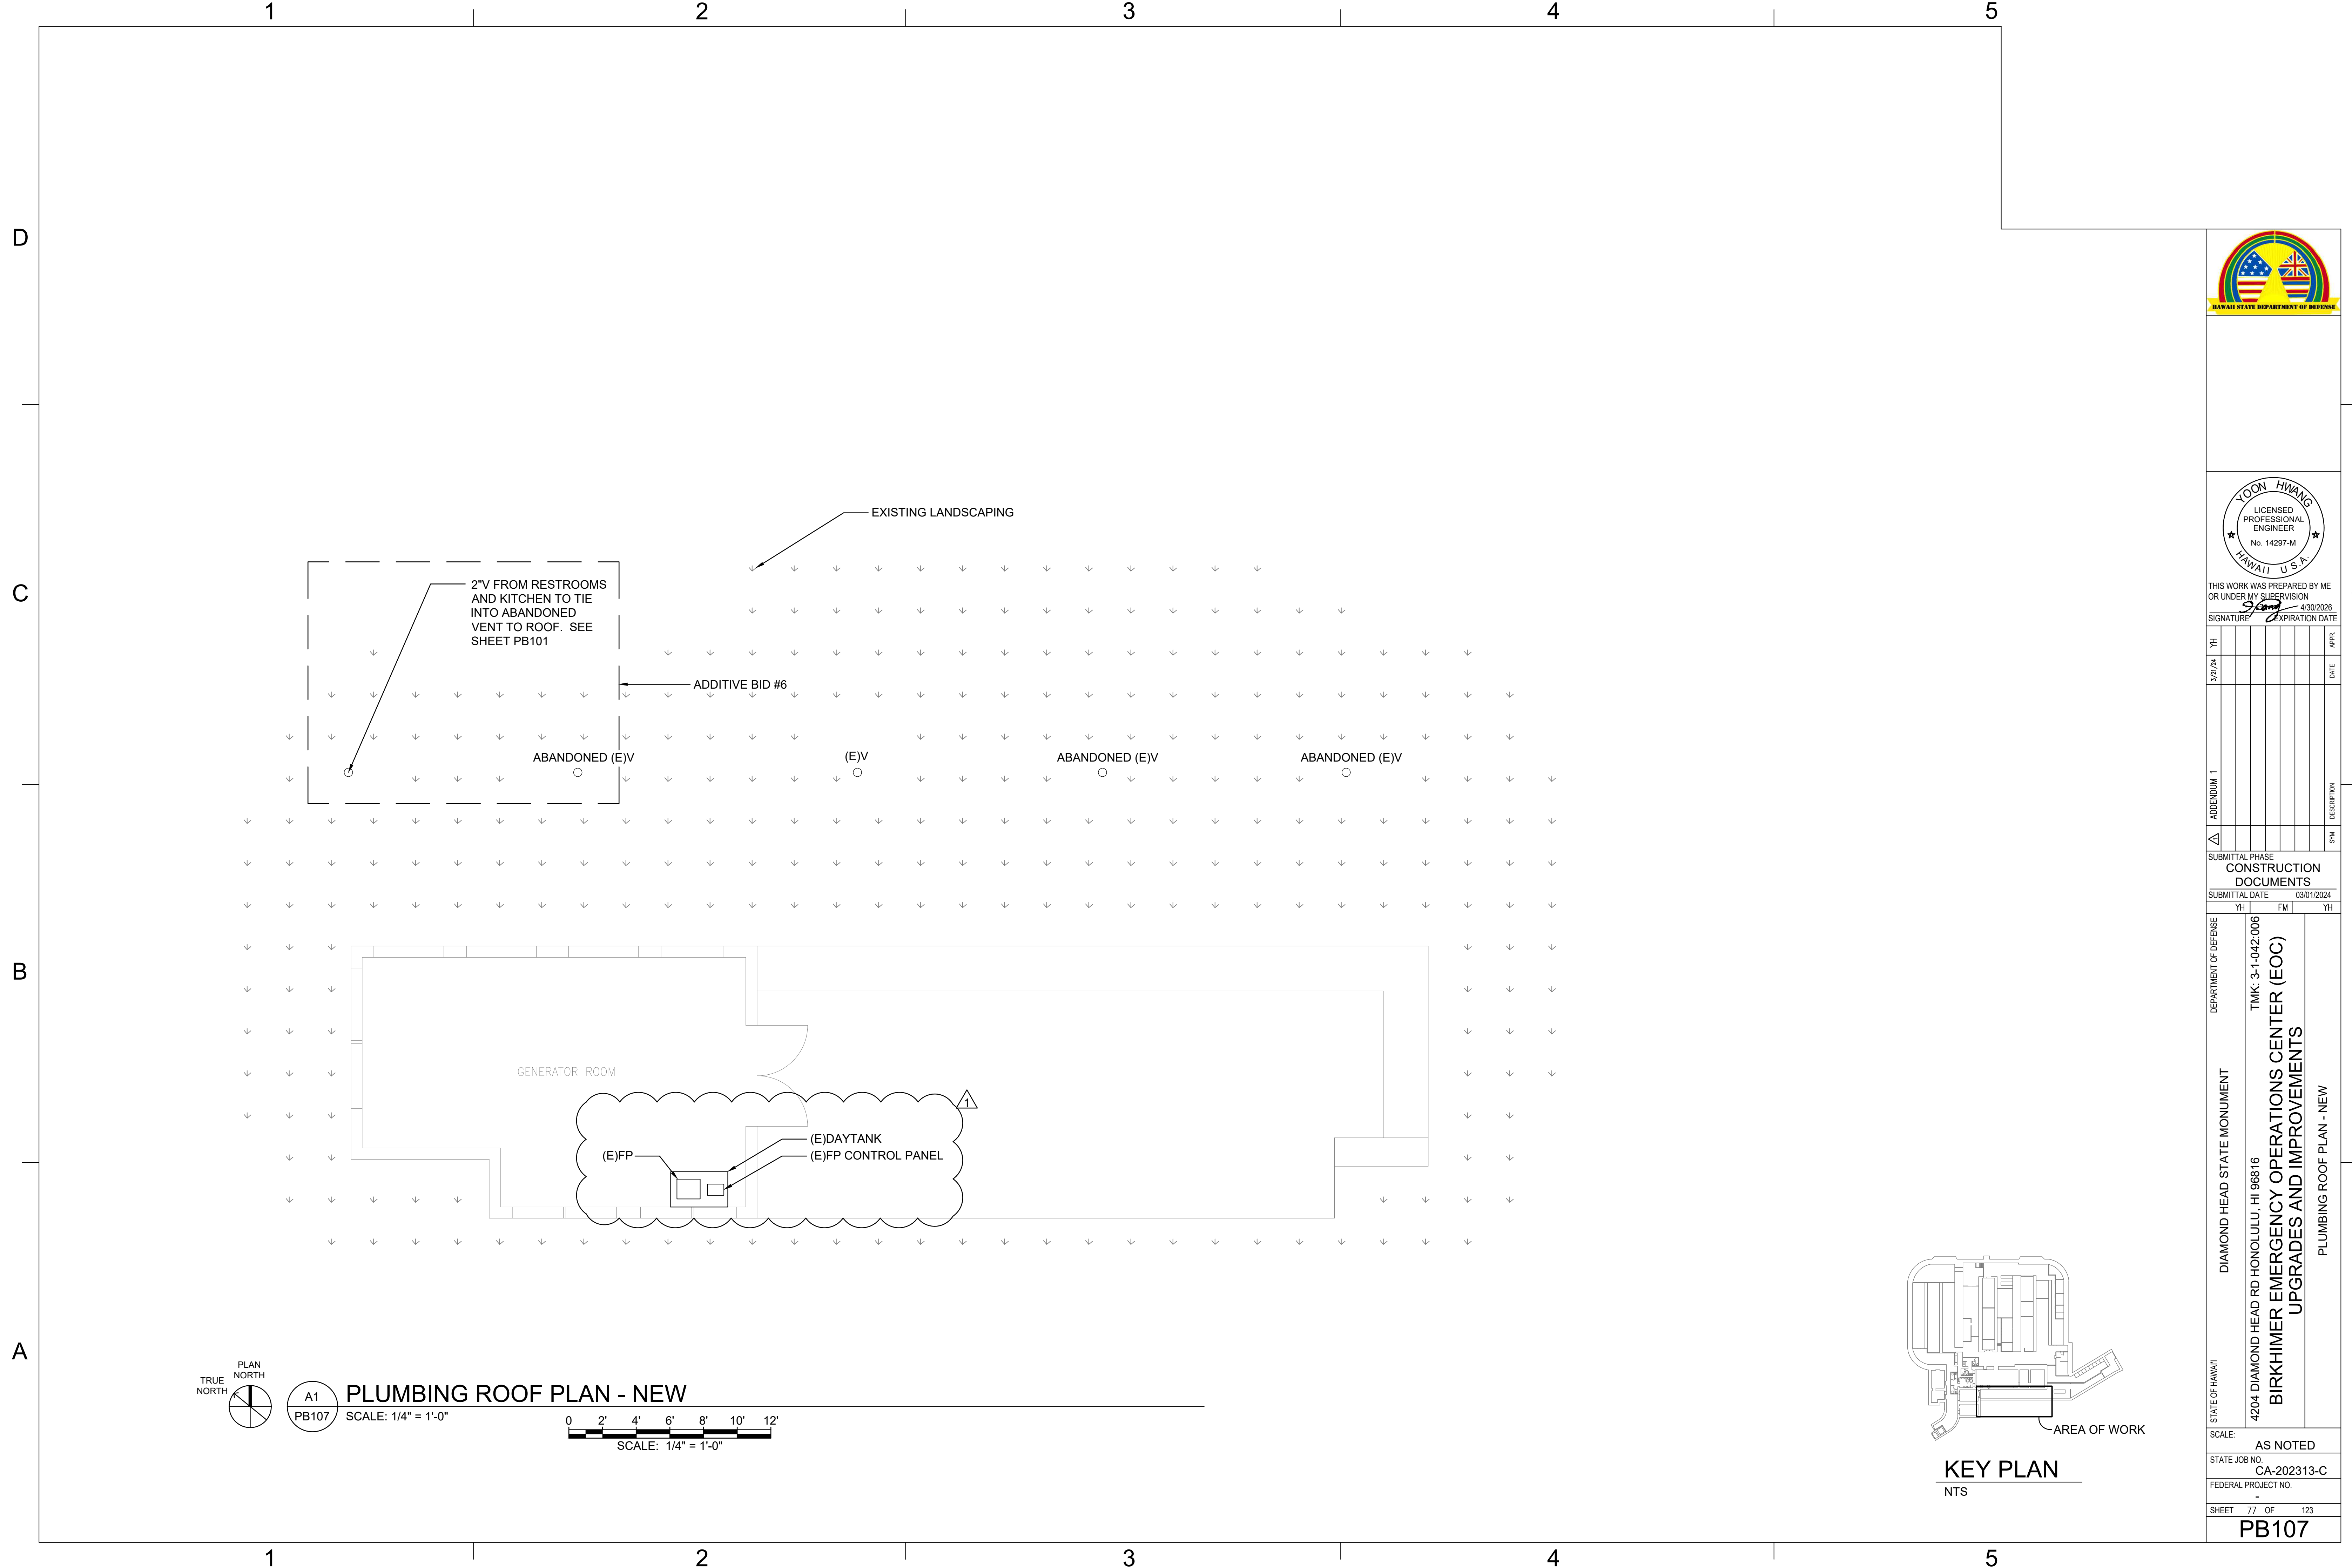

THIS WORK WAS PREPARED BY ME OR UNDER MY SUPERVISION
SIGNATURE: *[Signature]* EXPIRATION DATE: 4/30/2026

YH									APR
3/2/24									DATE
ADDENDUM 1									DESCRIPTION
									SYM


CONSTRUCTION DOCUMENTS

SUBMITTAL DATE 03/01/2024

YH	FM	YH

STATE OF HAWAII
DIAMOND HEAD STATE MONUMENT
4204 DIAMOND HEAD RD HONOLULU, HI 96816
BIRKHAMER EMERGENCY OPERATIONS CENTER (EOC)
UPGRADES AND IMPROVEMENTS
PLUMBING ROOF PLAN - NEW


SCALE: AS NOTED
STATE JOB NO. CA-202313-C
FEDERAL PROJECT NO. -
SHEET 77 OF 123
PB107

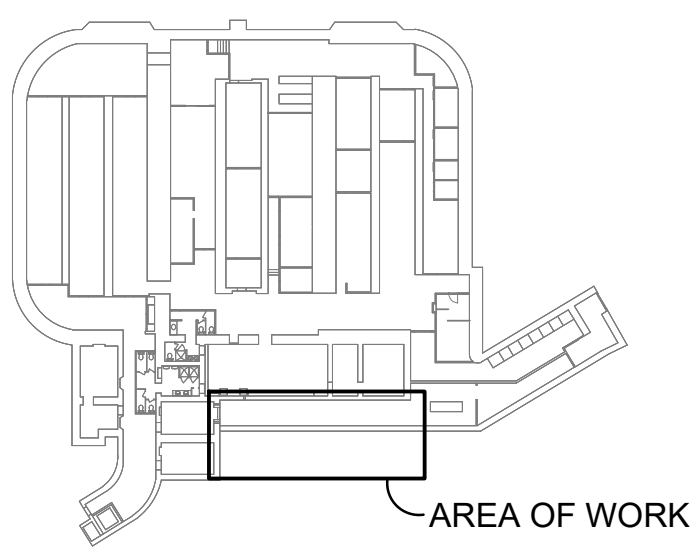

KEY PLAN

NTS

1										2										3										4										5	
ELECTRIC WATER HEATER SCHEDULE	
MARK		LOCATION		AREA SERVED			RECOVERY RATE			TANK STORAGE (GAL)		E-POWER (Y/N)	ELECTRICAL				MAXIMUM DIAMETER (IN)		QT Y	REMARKS	
EWH-1		WATER HEATER CLOSET		KITCHEN, MENS AND WOMENS RESTROOMS			21GPH @ 90F RISE			50		NO	4.5	240	1	60	20.25		1	PROVIDE DRAIN PAN WITH DRAINPIPE ROUTED TO NEAREST FLOOR DRAIN	
HOT WATER RECIRCULATION PUMP SCHEDULE	
MARK		LOCATION		SERVED	FLOW RATE (GPM)	HEAD (FT)	E-POWER (Y/N)	ELECTRICAL				QTY	REMARKS	
								V	PH	HZ	WATT S	AMPS	



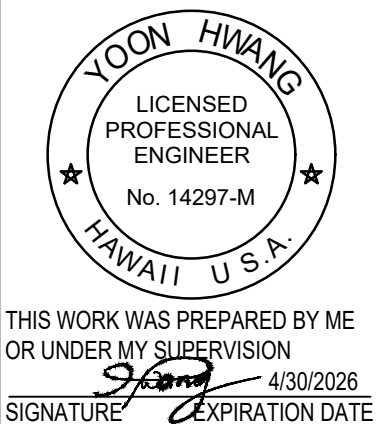


THIS WORK WAS PREPARED BY ME OR UNDER MY SUPERVISION
SIGNATURE: *Yoon Hwang* EXPIRATION DATE: 4/30/2026

YH									APR
3/2/24									DATE
ADDENDUM 1									DESCRIPTION
									SYM

SUBMITTAL PHASE
CONSTRUCTION DOCUMENTS
SUBMITTAL DATE 03/01/2024

STATE OF HAWAII	DIAMOND HEAD STATE MONUMENT	DEPARTMENT OF DEFENSE
4204 DIAMOND HEAD RD HONOLULU, HI 96816		TMK: 3-1-042:006
BIRKHIMER EMERGENCY OPERATIONS CENTER (EOC) UPGRADES AND IMPROVEMENTS		
PLUMBING SCHEDULES		

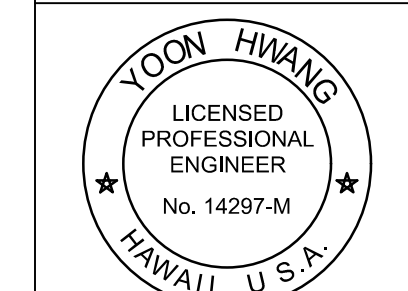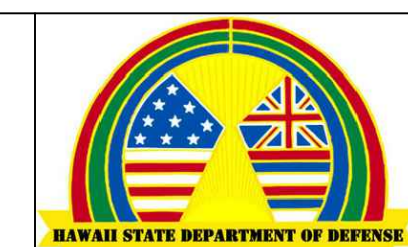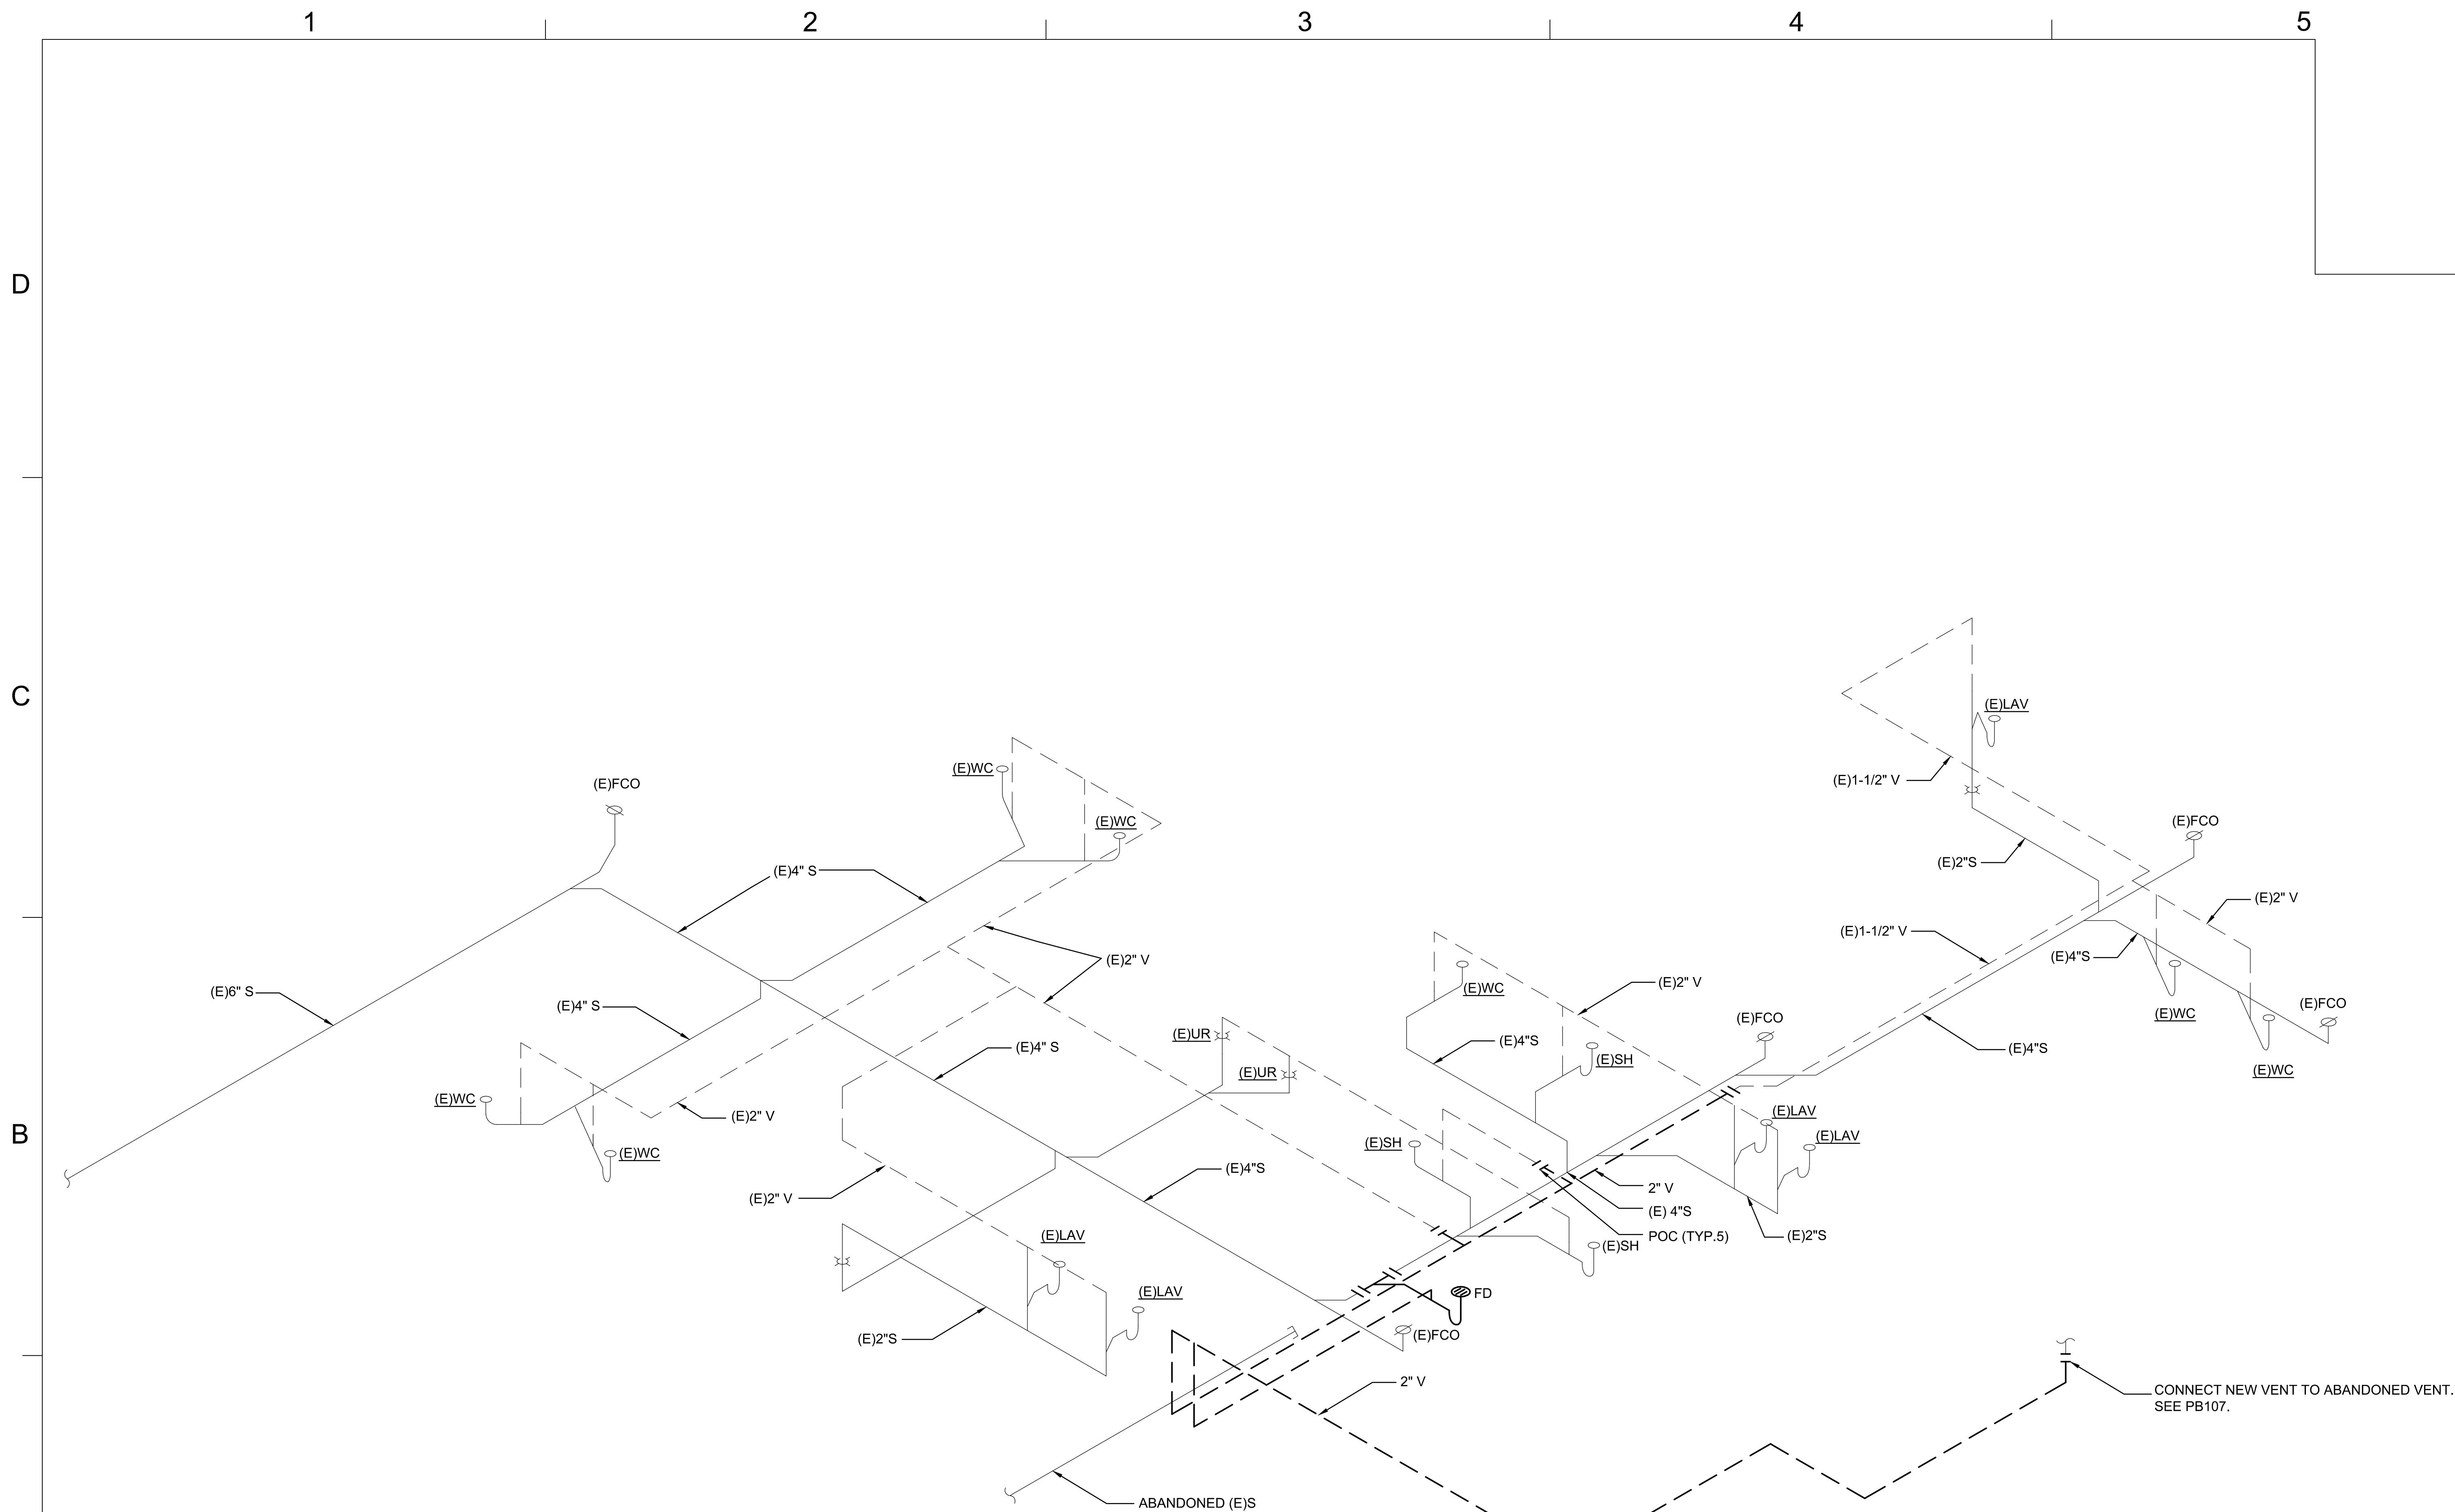

THIS WORK WAS PREPARED BY ME
OR UNDER MY SUPERVISION

James 4/30/2026
SIGNATURE EXPIRATION DATE

[illegible][illegible]

SUBMITTAL DATE			03/01/2024
YH	FM	YH	

DEPARTMENT OF DEFENSE	TMK: 3-1-042:006	
	ER (EOC)	

DIAMOND HEAD STATE MONUMENT
HONOLULU, HI 96816
EMERGENCY OPERATIONS CENTER
GRADES AND IMPROVEMENTS
RAIN PLUMBING ISOMETRIC DIAGRAM

STATE OF HAWAII
4204 DIAMOND HEAD RD H
BIRKHIMER EMB
UPGR
DI

SCALE: AS NOTED

STATE JOB NO.
CA-202313-C


FEDERAL PROJECT NO.

SHEET 82 OF 123

PB901

DRAIN PLUMBING ISOMETRIC DIAGRAM

— CONNECT NEW VENT TO ABANDONED VENT.
SEE PB107.

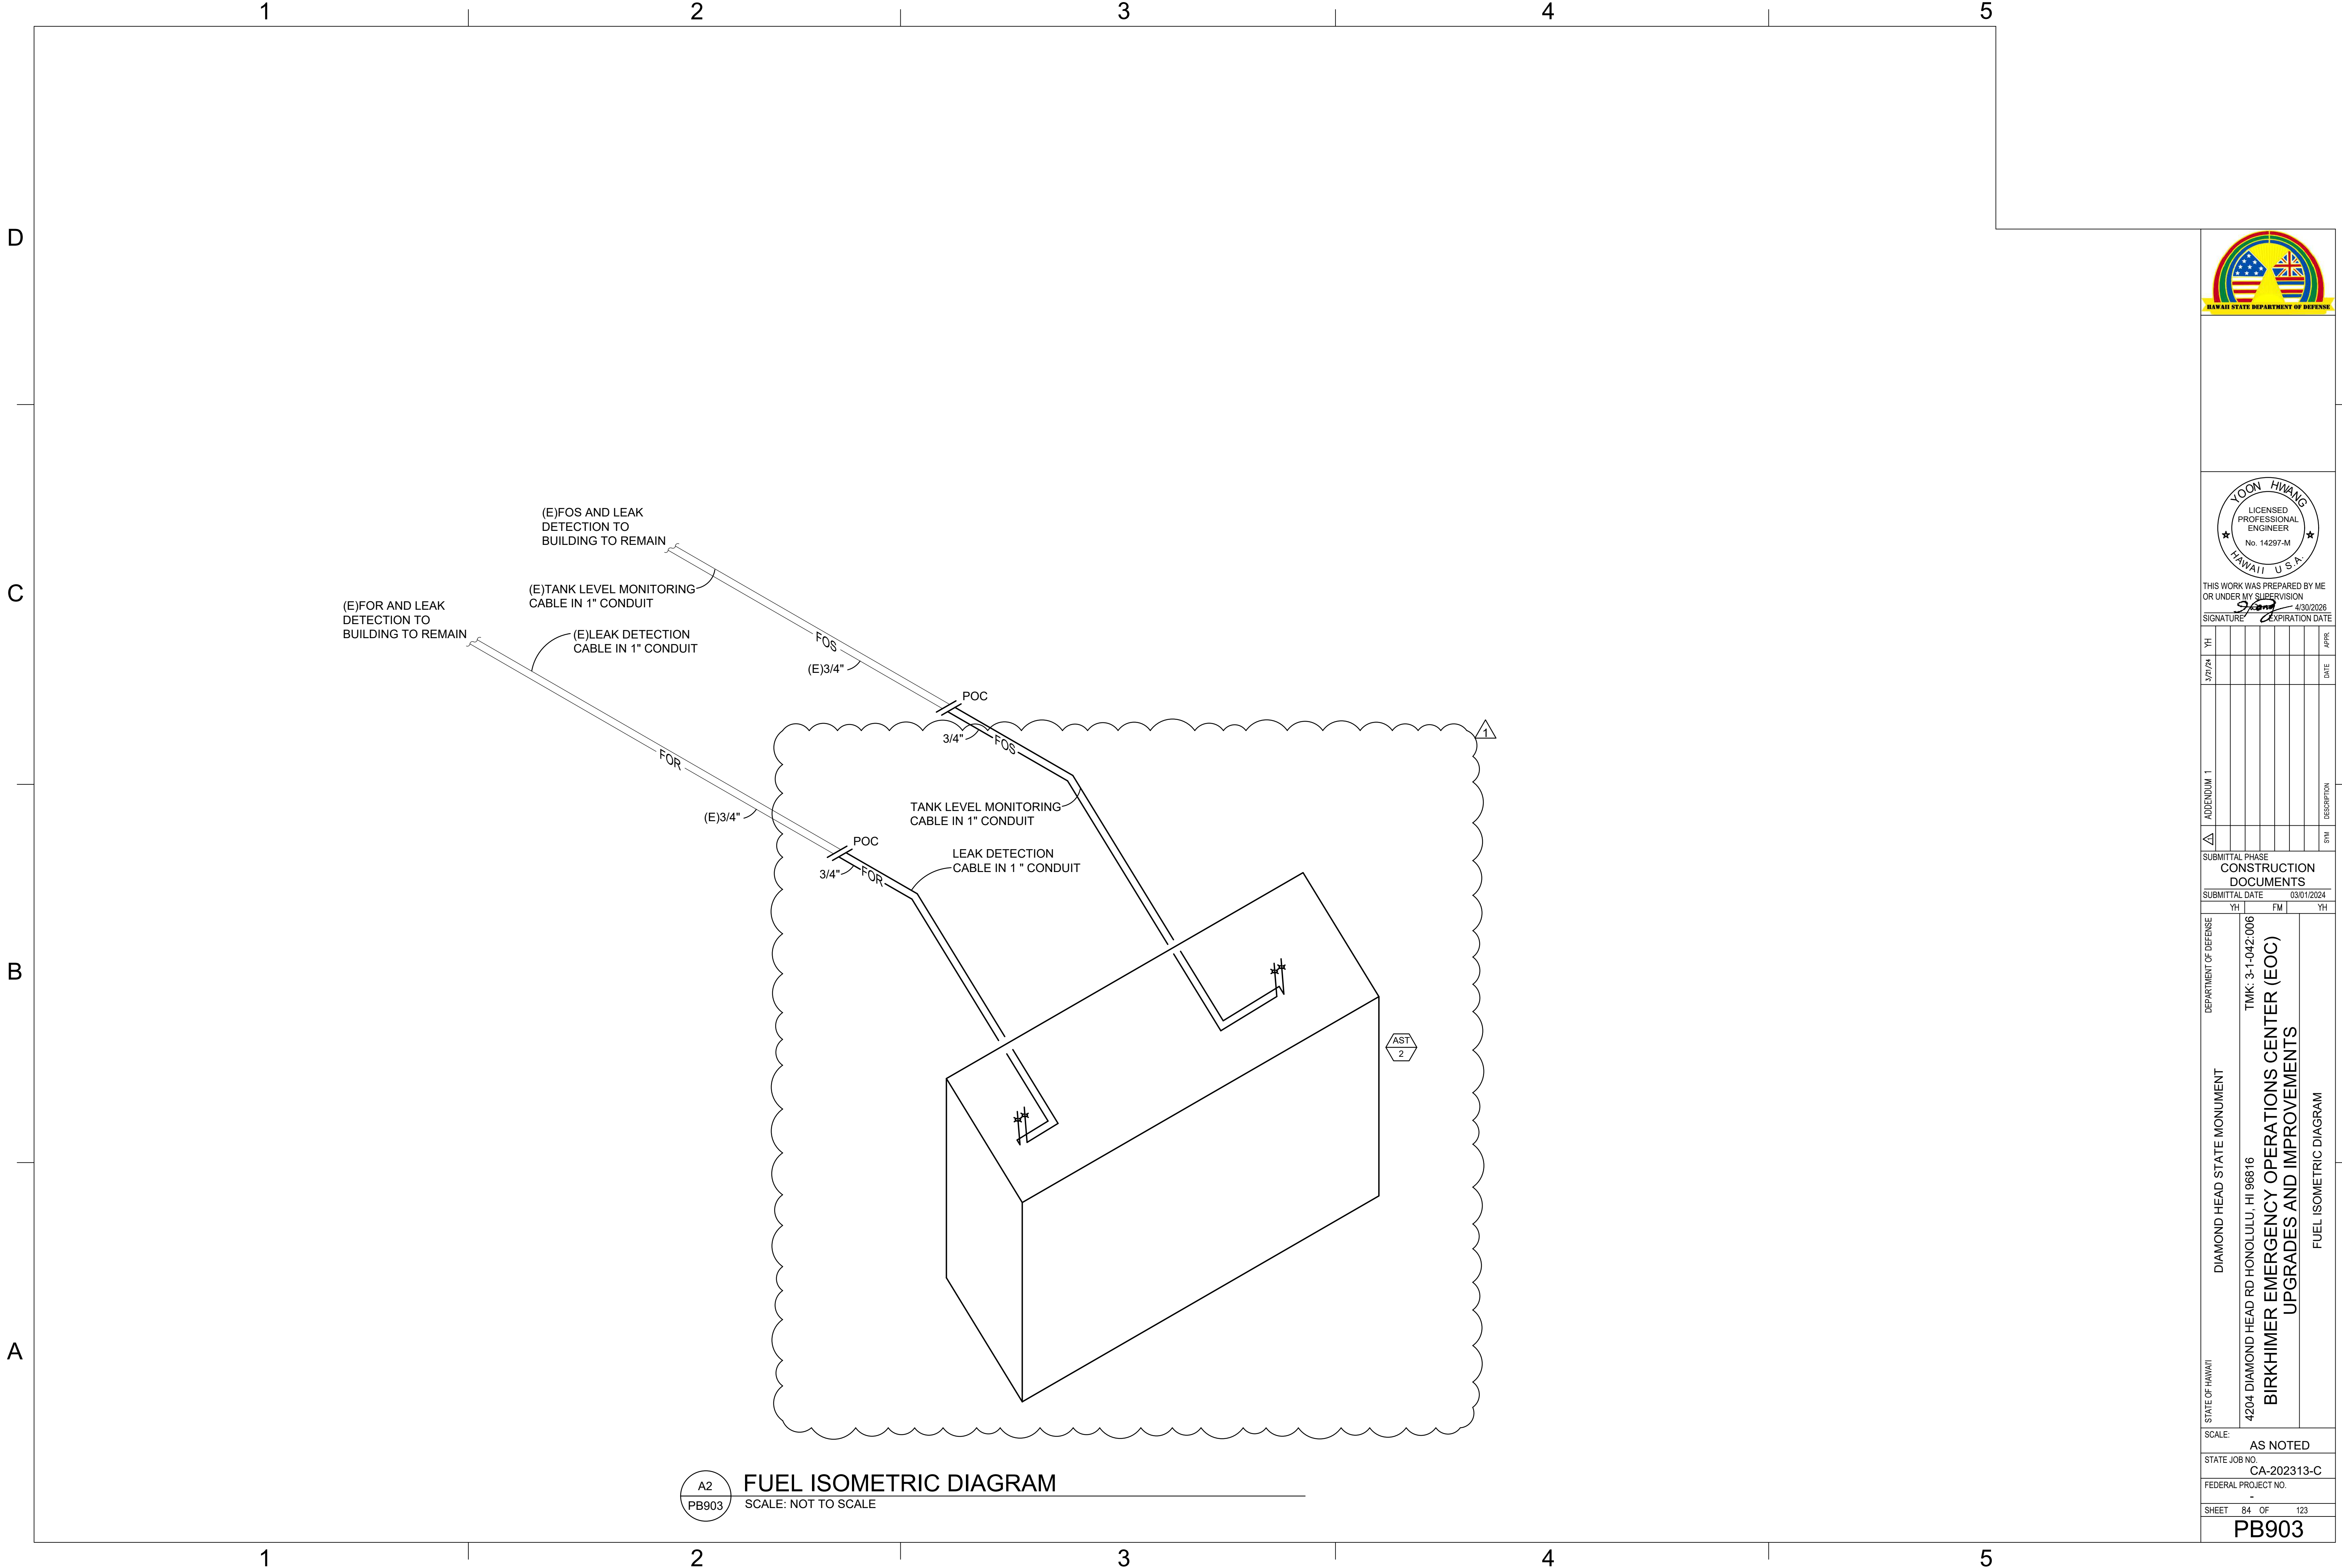

ELECTRICAL SYMBOL LIST / MOUNTING HEIGHT SCHEDULE


MOUNTING HEIGHT FROM FLOOR TO TOP		(SPECIAL MOUNTING HEIGHTS INDICATED ON PLAN)		DESCRIPTION
TOP	℄	EXISTING	NEW	
				LUMINAIRE, 1'X4' NOMINAL, MOUNTING STYLE AS INDICATED IN LIGHT FIXTURE SCHEDULE
				LUMINAIRE, LINEAR, WALL MOUNTED
				LUMINAIRE, 2'X4' NOMINAL, MOUNTING STYLE AS INDICATED IN LIGHT FIXTURE SCHEDULE
				LUMINAIRE, 2'X2' NOMINAL, MOUNTING STYLE AS INDICATED IN LIGHT FIXTURE SCHEDULE
				LUMINAIRE, MOUNTING STYLE AS INDICATED IN LIGHT FIXTURE SCHEDULE
				LUMINAIRE, WALL MOUNTED
				ILLUMINATED EXIT SIGN, WALL MOUNTED, DIRECTIONAL ARROWS AS INDICATED
				ILLUMINATED EXIT SIGN, CEILING MOUNTED, DIRECTIONAL ARROWS AS INDICATED
46"				LIGHT SWITCH, WALL MOUNTED, 1P20A, 120/277V, 1HP MAXIMUM
				OCCUPANCY SENSOR, CEILING MOUNTED
7'-0"				OCCUPANCY SENSOR, WALL MOUNTED
46"				WALL BOX SWITCH/OCCUPANCY SENSOR, SELF-CONTAINED DUAL TECHNOLOGY TYPE, 800W MINIMUM, 120/277V, WALL MOUNTED
46"				LIGHTING CONTROL KEYPAD, WALL MOUNTED ("2" INDICATES NUMBER OF KEYPAD BUTTONS, OTHER NUMBERS SIMILAR)
46"				LOW VOLTAGE CONTROL SWITCH, WALL MOUNTED
				HOMERUN ARROW TO PANELBOARD. LETTER INDICATES PANELBOARD, NUMBERS INDICATES CIRCUITS.
				INTERIOR WORK: CONCEALED CONDUIT IN FINISHED FLOOR OR BELOW GRADE (NO HASHMARKS INDICATE 2 CURRENT CARRYING CONDUCTORS AND 1 GROUND CONDUCTOR WITHIN, ALL OTHERS SIMILAR). EXTERIOR WORK: CONCRETE ENCASED UNDERGROUND DUCT LINE, SEE DUCT SECTION INDICATOR AND SCHEDULE.
				CONCEALED CONDUIT IN CEILING OR WALLS, (HASHMARKS INDICATE 3-WIRES WITHIN, ALL OTHERS SIMILAR).
				EXPOSED RACEWAY, PROVIDE STRAP 8'-0" ON CENTER MAXIMUM
				LIQUID-TIGHT FLEXIBLE CONDUIT
				DENOTES DEMOLITION/REMOVAL
18"				RECEPTACLE, WALL MOUNTED, DUPLEX, GROUNDING TYPE, 125V, NEMA TYPE 5-20R
18"				RECEPTACLE, WALL MOUNTED, DUPLEX, GFCI TYPE, 125V, NEMA TYPE 5-20R
18"				RECEPTACLE, WALL MOUNTED, DUPLEX, GFCI TYPE, WEATHER-RESISTANT DEVICE WITH WEATHERPROOF-WHILE-IN-USE COVER PLATE
				JUNCTION BOX, LARGE, WALL MOUNTED
				JUNCTION BOX, LARGE, HORIZONTALLY MOUNTED
				JUNCTION BOX, HORIZONTALLY MOUNTED
18"				JUNCTION BOX, WALL MOUNTED
				EQUIPMENT TERMINATION WITH FLEXIBLE CONDUIT WHIP
60"				COMBINATION MOTOR STARTER/NON-FUSED DISCONNECT SWITCH, FURNISHED BY MECHANICAL CONTRACTOR & INSTALLED BY ELECTRICAL CONTRACTOR
				MOTOR CONNECTION
60"				MAGNETIC MOTOR STARTER, FURNISHED BY MECHANICAL CONTRACTOR & INSTALLED BY ELECTRICAL CONTRACTOR
60"				NON-FUSED DISCONNECT SWITCH, 3P30A UNLESS OTHERWISE NOTED, VOLTAGE TO MATCH CIRCUITING
60"				ENCLOSED CIRCUIT BREAKER
72"				PANELBOARD
46"				MANUAL MOTOR STARTER WITH THERMAL OVERLOAD, 1HP MAXIMUM
				PARKING LOT/ROADWAY LIGHT ASSEMBLY, SINGLE LUMINAIRE PER POLE

ELECTRICAL SYMBOL LIST / MOUNTING HEIGHT SCHEDULE, CONTINUED

MOUNTING HEIGHT FROM FLOOR TO		(SPECIAL MOUNTING HEIGHTS INDICATED ON PLAN)		
TOP	CL	SYMBOL		DESCRIPTION
		EXISTING	NEW	
				POWER TRANSFORMER
				GROUND
				CIRCUIT BREAKER
				NON-FUSED DISCONNECT SWITCH
				TRANSFER SWITCH
				POTENTIAL TRANSFORMER
				CURRENT TRANSFORMER
				METER SOCKET AND KILOWATT HOUR METER WITH DEMAND REGISTER
				DIESEL ENGINE GENERATOR SET
				FLOOD LIGHT FIXTURE
				EQUIPMENT TAG; EXHAUST FAN "EF-1" INDICATED; ALL OTHERS SIMILAR
				LIGHT FIXTURE TYPE INDICATOR; FIXTURE TYPE "A" INDICATED; ALL OTHERS SIMILAR
				KEYNOTE INDICATOR - DEMOLITION WORK
				KEYNOTE INDICATOR - NEW WORK
				DETAIL INDICATOR: TOP HALF DENOTES DETAIL NUMBER, BOTTOM HALF DENOTES SHEET NUMBER
			+42"	DENOTES 42" ABOVE FINISHED FLOOR OR GRADE
			ATS	AUTOMATIC TRANSFER SWITCH
			GFCI	GROUND FAULT CIRCUIT INTERRUPTER
			GND	GROUND
			HP	HORSEPOWER
			KVA	KILOVOLT-AMPERE
			KW	KILOWATT
			KWH	KILOWATT-HOUR
			MIN	MINIMUM
			WP	WEATHERPROOF
				ROOM CONTROLLER


CITY AND COUNTY OF HONOLULU
REVISED ORDINANCES OF HONOLULU 2021
CHAPTER 16B

TO THE BEST OF MY KNOWLEDGE, THIS PROJECT'S DESIGN SUBSTANTIALLY
CONFORMS TO THE BUILDING ENERGY CONSERVATION CODE FOR:

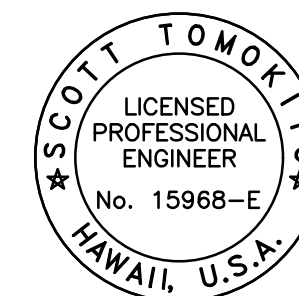

X ELECTRICAL COMPONENT SYSTEMS

SIGNATURE: Scott Tomokiyo DATE: 02/12/2024
NAME: SCOTT TOMOKIYO
TITLE: ELECTRICAL ENGINEER
LICENSE No.: 15968-E

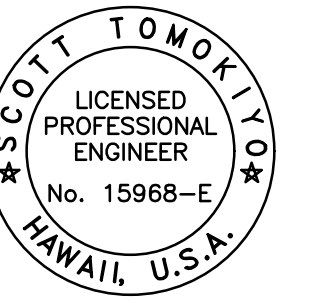

THIS WORK WAS PREPARED BY ME
UNDER MY SUPERVISION
Scott Tompkins 4/30/2026
SIGNATURE EXPIRATION DATE

[illegible]

SUBMITTAL PHASE									
CONSTRUCTION									
DOCUMENTS									

SUBMITTAL DATE		03/01/2024
SF	KR	ST

TMK: 3-1-042:006	ER (EOC)
------------------	----------

DIAMOND HEAD STATE MONUMENT
RD HONOLULU, HI 96816
EMERGENCY OPERATIONS CENT
GRADES AND IMPROVEMENTS
ELECTRICAL LEGEND AND ABBREVIATION

4204 DIAMOND HEAD R
BIRKIMER E
UP

SCALE: AS NOTED

STATE JOB NO.
CA-202313-C

FEDERAL PROJECT NO.

SHEET 86 OF 123

E 001



E-001


GENERAL ELECTRICAL NOTES:

1. ALL WORK SHOWN ON THE ELECTRICAL DRAWINGS IS NEW UNLESS OTHERWISE NOTED. ALL MATERIALS SHALL BE NEW AND "LISTED" OR "LABELED" AS DEFINED BY THE NATIONAL ELECTRICAL CODE (NEC). WORK INCLUDES INSTALLATION OF ALL ELECTRICAL SYSTEMS COMPLETE AND OPERATIONAL AS LIMITED BY THE INTENT OF THE CONTRACT DOCUMENTS.
2. ALL WORK SHALL COMPLY WITH THE NATIONAL ELECTRICAL CODE (NEC), NATIONAL ELECTRICAL SAFETY CODE, AND BUILDING ORDINANCES OF THE CITY AND COUNTY OF HONOLULU. CONSTRUCTION PRACTICES SHALL CONFORM TO THE LATEST EDITION OF AMERICAN ELECTRICIANS' HANDBOOK BY CROFT AND APPLICABLE INSTRUCTIONS OF MANUFACTURERS OF EQUIPMENT AND MATERIAL SUPPLIED FOR THIS PROJECT.
3. OBTAIN AND PAY FOR BUILDING / ELECTRICAL PERMIT, ARRANGE FOR PERIODIC INSPECTION BY LOCAL AUTHORITIES, AND DELIVER CERTIFICATE OF FINAL INSPECTION TO THE CONTRACTING OFFICER.
4. RETENTION OF PLANS: ONE SET OF APPROVED PLANS, SPECIFICATIONS, AND COMPUTATIONS SHALL BE RETAINED BY THE BUILDING OFFICIAL FOR A PERIOD OF NOT LESS THAN 90 DAYS FROM DATE OF COMPLETION OF THE WORK COVERED THEREIN, AND ONE SET OF APPROVED PLANS SHALL BE RETURNED TO THE APPLICANT, AND SAID SET SHALL BE KEPT ON THE SITE OF THE BUILDING OR WORK AT ALL TIMES DURING WHICH THE WORK AUTHORIZED THEREBY IS IN PROGRESS.
5. STRUCTURES UNDERGOING CONSTRUCTION, ALTERATION, OR DEMOLITION OPERATIONS, INCLUDING THOSE IN UNDERGROUND LOCATIONS, SHALL COMPLY WITH NFPA 241, STANDARD FOR SAFEGUARDING CONSTRUCTION, ALTERATION, AND DEMOLITION OPERATIONS, AND NFPA 1, AS LOCALLY AMENDED.
6. FIRE SAFETY DURING ALTERATION:
 - a. NFPA 1, 16.4.4.1 WHERE THE BUILDING IS PROTECTED BY FIRE PROTECTION SYSTEMS, SUCH SYSTEMS SHALL BE MAINTAINED OPERATIONAL AT ALL TIMES DURING ALTERATION.
 - b. NFPA 1, 16.4.4.2 WHERE ALTERATION REQUIRES MODIFICATION OF A PORTION OF THE FIRE PROTECTION SYSTEM, THE REMAINDER OF THE SYSTEM SHALL BE KEPT IN SERVICE AND THE FIRE DEPARTMENT SHALL BE NOTIFIED.
 - c. NFPA 1, 16.4.4.3 WHEN IT IS NECESSARY TO SHUT DOWN THE SYSTEM, THE AHJ SHALL HAVE THE AUTHORITY TO REQUIRE ALTERNATE MEASURES OF PROTECTION UNTIL THE SYSTEM IS RETURNED TO SERVICE.
 - d. NFPA 1, 10.7.1.1 AS NECESSARY DURING EMERGENCIES, MAINTENANCE, DRILLS, PRESCRIBED TESTING, ALTERATIONS, OR RENOVATIONS, PORTABLE OR FIXED FIRE-EXTINGUISHING SYSTEMS OR DEVICES OR ANY FIRE-WARNING SYSTEM SHALL BE PERMITTED TO BE MADE INOPERATIVE OR INACCESSIBLE. A FIRE WATCH SHALL BE REQUIRED AS SPECIFIED IN SECTIONS 13.3.3.6.5.2(a)(b), 13.7.1.5.3, 16.5.4, 34.6.3.3, 41.2.2.6, 41.2.2.7, 41.2.4, 41.3.5, 41.4.1, 34.5.4.3, AND 25.1.8 AT NO COST TO THE AHJ. NFPA 1, AS LOCALLY AMENDED.
7. THE DRAWINGS DO NOT REFLECT ALL THE EXISTING CONDITIONS THAT MAY BE ENCOUNTERED DURING CONSTRUCTION. VISIT THE PROJECT SITE AND BECOME FAMILIAR WITH THE READILY OBSERVABLE EXISTING CONDITIONS, THE EXTENT OF ANY DEMOLITION, RELOCATION, RECONNECTION, AND THE NEW WORK PRIOR TO BIDDING. REPORT ANY READILY OBSERVABLE DISCREPANCIES AND/OR DIFFERENCES BETWEEN THE EXISTING CONDITIONS AND THE CONSTRUCTION DOCUMENTS TO THE CONTRACTING OFFICER. RESOLVE ALL READILY OBSERVABLE DISCREPANCIES AND QUESTIONS PRIOR TO THE START OF WORK. BID SUBMISSION SHALL BE CONSIDERED AS EVIDENCE THAT THE CONTRACTOR HAS VISITED THE SITE AND RESOLVED ALL READILY OBSERVABLE DISCREPANCIES AND QUESTIONS AND NO EXTRA PAYMENT WILL BE AUTHORIZED FOR WORK REQUIRED BY THE CONTRACTOR'S FAILURE TO DO SO.
8. COORDINATE ALL ELECTRICAL WORK WITH THE WORK OF THE OTHER TRADES AND SCHEDULE WORK TO MINIMIZE THE NUMBER AND DURATION OF ELECTRICAL OUTAGES AND IMPACT TO THE OPERATIONS IN OR ADJACENT TO THE PROJECT AREA. COORDINATE ACCESS TO THE PROJECT AREA AND SCHEDULE ALL REQUIRED SYSTEM OUTAGES WITH THE CONTRACTING OFFICER.
9. VERIFY AND COORDINATE ALL PENETRATIONS PRIOR TO THE START OF CONSTRUCTION. OBTAIN APPROVAL BEFORE MAKING ANY PENETRATIONS THROUGH STRUCTURAL MEMBERS OR FIRE RATED WALLS AND CEILINGS.
10. SCAN (E.G. X-RAY, ELECTROMAGNETIC, ETC.) ALL CONCRETE WALLS OR FLOOR STRUCTURES PRIOR TO COMMENCING WITH CORING/DRILLING WORK FOR PENETRATIONS TO AVOID DAMAGING THE EXISTING REINFORCING STEEL.
11. COORDINATE AND PROVIDE ACCESS PANELS FOR ALL CONCEALED ELECTRICAL EQUIPMENT, DEVICES, BOXES, AND CONDUIT BODIES SO THAT THEY ARE ACCESSIBLE.
12. EXISTING DEVICE AND EQUIPMENT LOCATIONS, CIRCUIT ASSIGNMENTS, WIRING CONNECTIONS, AND CONDUIT RUNS INDICATED WERE DERIVED FROM AVAILABLE REFERENCE DOCUMENTS AND LIMITED FIELD INVESTIGATION. FIELD VERIFY ALL EXISTING CONDITIONS AND MAKE ANY NECESSARY ADJUSTMENTS TO SATISFY THE INTENT OF THE DRAWINGS AND SPECIFICATIONS.
13. RE-ROUTE ALL EXISTING CONDUIT, WIRING, AND CABLING TO REMAIN WITHIN THE PROJECT AREA AS NECESSARY TO FACILITATE THE REMOVAL OF EXISTING EQUIPMENT AS WELL AS THE INSTALLATION OF ALL NEW EQUIPMENT. REMOVE AND RE-INSTALL ELECTRICAL EQUIPMENT, INCLUDING LIGHTS, TO REMAIN AS REQUIRED.
14. WORK INCIDENTAL TO THE CONTRACT AND NECESSARY TO COMPLETE THE PROJECT, ALTHOUGH NOT SPECIFICALLY REFERRED TO IN THE CONTRACT DOCUMENTS, SHALL BE FURNISHED AND PERFORMED BY THE CONTRACTOR AT NO ADDITIONAL COST TO THE PROJECT. AN EXAMPLE OF SUCH INCIDENTAL WORK ARE OUTLET BOXES, JUNCTION BOXES, AND PULL BOXES REQUIRED FOR THE INSTALLATION OF ELECTRICAL DEVICES, LIGHTING FIXTURES, AND EQUIPMENT. ALL INCIDENTAL WORK SHALL BE FURNISHED AND INSTALLED IN ACCORDANCE WITH THE NEC.
15. ELECTRICAL CONTRACTOR SHALL BE RESPONSIBLE TO PROVIDE ALL CONDUIT AND WIRING FOR THE POWER CONNECTION TO ALL EQUIPMENT AS INDICATED IN THE DRAWINGS AND SPECIFICATIONS. ALL INCIDENTAL CONDUIT AND WIRING REQUIRED FOR A COMPLETE AND OPERATIONAL SYSTEM MAY NOT BE SHOWN IN THE DRAWINGS OR SPECIFICATIONS. CONTRACTOR SHALL COORDINATE INCIDENTAL CONDUIT AND WIRING REQUIREMENTS BETWEEN ALL TRADES TO ENSURE THE INCIDENTAL CONDUIT AND WIRING IS PROVIDED AND THE AFFECTED SYSTEMS OPERATE AS INTENDED.

- THE LOCATION OF ALL ELECTRICAL APPARATUS AND DEVICES SHOWN ON THE DRAWINGS ARE APPROXIMATE AND BEFORE INSTALLING, STUDY THE ARCHITECTURAL, STRUCTURAL, AND MECHANICAL DETAILS, THEN MAKE INSTALLATION IN THE MOST LOGICAL MANNER. CIRCUIT ROUTING IS TYPICAL AND MAY BE VARIED IN ANY MANNER. ANY PIECE OF EQUIPMENT/DEVICE MAY BE RELOCATED WITHIN 10' BEFORE INSTALLATION AT THE DIRECTION OF THE CONTRACTING OFFICER WITHOUT ADDITIONAL CHARGE TO THE PROJECT.
17. SHOULD PROJECT CONDITIONS REQUIRE REARRANGEMENT OF THE PROJECT'S WORK, THE CONTRACTOR SHALL MARK SUCH CHANGES ON THE AS-BUILT DRAWINGS. IF THESE CHANGES REQUIRE AN ALTERNATE METHOD TO THOSE SPECIFIED IN THE CONTRACT DOCUMENTS, THE CONTRACTOR SHALL SUBMIT DRAWINGS TO REFLECT THE PROPOSED ALTERNATE METHODS TO THE CONTRACTING OFFICER FOR REVIEW AND APPROVAL. THE CONTRACTOR SHALL NOT PROCEED UNTIL APPROVAL IS OBTAINED. REARRANGEMENT OF WORK FOR THE PURPOSE OF COORDINATION SHALL NOT BE CONSIDERED AN ITEM FOR EXTRA COST.
 18. DISCONNECT AND REMOVE ALL ELECTRICAL APPARATUS, LIGHT FIXTURES, WIRING DEVICES, JUNCTION BOXES, AND ASSOCIATED FEEDER AND BRANCH CIRCUIT WIRING IN THE PROJECT AREA, UNLESS OTHERWISE NOTED. THE DEMOLITION DRAWINGS ARE INTENDED TO SHOW THE GENERAL LIMITS OF THE SCOPE OF WORK AND MAY NOT SHOW ALL THE EXISTING DEVICES, CONDUIT RUNS, ETC. FEEDER AND BRANCH CIRCUIT WIRING TO BE REMOVED SHALL BE DISCONNECTED FROM ITS SOURCE. REMOVE ALL CONDUCTORS, CONDUIT, AND CONDUIT SUPPORT STRUCTURES WHERE ACCESSIBLE. PATCH/REPAIR WALL, FLOOR, AND CEILING DAMAGES AS A RESULT OF THE REMOVAL WORK.
 19. THE ACCESSIBLE PORTIONS OF ABANDONED COMMUNICATIONS AND FIRE ALARM CABLES SHALL BE REMOVED IN ACCORDANCE WITH THE NEC.
 20. THE EXISTING ELECTRICAL, TELECOM, FIRE ALARM, AND OTHER ELECTRICALLY-RELATED SYSTEMS IN AREAS ADJACENT TO, OUTSIDE OF, AND/OR OTHERWISE PASSING THROUGH THE PROJECT LIMITS, MUST REMAIN OPERATIONAL DURING THE CONSTRUCTION PERIOD AND POST-CONSTRUCTION. THE CONTRACTOR SHALL EXERCISE DUE CARE AND CAUTION WHEN WORKING NEAR ANY EXISTING EQUIPMENT, DEVICES, OR CABLING/CIRCUITING. PROVIDE NEW JUNCTION BOXES, CONDUITS, WIRING, AND THE LABOR REQUIRED TO FACILITATE THE REQUIRED OPERATIONAL CONTINUITY. BOXES, CONDUITS, AND WIRING SHALL BE IN ACCORDANCE WITH THE NEC. ANY DAMAGE TO THE EXISTING EQUIPMENT, DEVICES, OR CABLING/CIRCUITING RESULTING FROM THE CONTRACTOR'S OPERATIONS SHALL BE IMMEDIATELY REPAIRED OR OTHERWISE RESTORED TO ITS ORIGINAL WORKING CONDITION AT NO ADDITIONAL COST TO THE PROJECT.
 21. THE ELECTRICAL DRAWINGS ARE BASED ON PROPOSED EQUIPMENT. VERIFY ALL SYSTEM REQUIREMENTS (ELECTRICAL, MECHANICAL, FIRE ALARM, SPECIALTY SYSTEMS, ETC.) WITH THE SELECTED SYSTEM'S MANUFACTURER OR AUTHORIZED REPRESENTATIVE PRIOR TO COMMENCING WITH ANY WORK. COORDINATE RATINGS OF OVERCURRENT PROTECTION DEVICES, DISCONNECT SWITCHES, CONDUIT, AND WIRING TO MATCH THE ACTUAL EQUIPMENT SUPPLIED FOR THE PROJECT. CORRECT ALL DISCREPANCIES SO AS TO PROVIDE A COMPLETE AND OPERATIONAL SYSTEM. RECORD CHANGES ON THE AS-BUILT DRAWINGS.
 22. ALL EQUIPMENT AND APPARATUS SHALL BE CAPABLE OF FITTING IN THE SPACES SHOWN WHILE MEETING THE MANUFACTURER'S RECOMMENDED ACCESS REQUIREMENTS AND APPLICABLE CODE REQUIREMENTS. REVIEW ALL SPACES WHERE EQUIPMENT IS TO BE INSTALLED PRIOR TO ORDERING OF EQUIPMENT AND NOTIFY THE CONTRACTING OFFICER OF ANY INADEQUATE CLEARANCES OR CONDITIONS THAT WILL PREVENT THE PROPER INSTALLATION, MAINTENANCE, AND OPERATION OF THE EQUIPMENT.
 23. CONFIRM THE TYPE OF CEILING BEING INSTALLED PRIOR TO ORDERING LUMINAIRES AND TRIMS FOR PROPER COORDINATION. LUMINAIRES INDICATED MAY NOT EXPRESSLY CONFORM TO THE TYPE OF CEILING OR OPENING PROVIDED BY OTHER TRADES.
 24. CONCEAL ALL CONDUIT WHEREVER REASONABLY POSSIBLE; EXPOSED CONDUITS ARE PERMITTED ONLY WHERE SPECIFICALLY SHOWN ON THE DRAWINGS. ALL EXPOSED CONDUITS IN FINISHED AREAS SHALL BE INSTALLED IN THE LEAST VISIBLE LOCATIONS. CARE SHALL BE TAKEN TO INSTALL CONDUIT IN THE MOST AESTHETICALLY PLEASING MANNER.
 25. WHERE DEVICES, EQUIPMENT, BOXES, AND OTHER ELECTRICAL MATERIALS ARE INDICATED TO BE OF WEATHERPROOF (WP) CONSTRUCTION, THE INTERCONNECTING RACEWAYS, INCLUDING COUPLINGS AND CONNECTORS, SHALL BE LISTED FOR AND INSTALLED TO PROVIDE A COMPLETE WEATHERPROOF / WET LOCATION INSTALLATION. ALL INCIDENTAL MATERIALS REQUIRED TO COMPLETE THE INSTALLATION SHALL ALSO BE OF WEATHERPROOF / WET LOCATION LISTING.
 26. WIRING DEVICES AND CONDUITS SHALL BE FLUSH MOUNTED, WHEREVER REASONABLY POSSIBLE. WHERE NEW DEVICES ARE INDICATED TO BE INSTALLED IN EXISTING WALLS, FISH THE CONDUIT DOWN INTO THE EXISTING WALL CAVITY AND KEEP DISTURBANCES TO THE EXISTING WALLS TO A MINIMUM. WHERE OBSTRUCTIONS ARE ENCOUNTERED OR CUTTING OF THE WALL TO ACCOMPLISH THE WIRING DEVICE AND CONDUIT INSTALLATION IS UNAVOIDABLE, CONSULT WITH THE CONTRACTING OFFICER PRIOR TO COMMENCING ANY WORK.
 27. PROVIDE TYPEWRITTEN CIRCUIT DIRECTORIES FOR ALL PANELS, NEW OR MODIFIED, REFLECTING THE CIRCUIT ARRANGEMENTS AS THEY WERE ACTUALLY INSTALLED.
 28. AN ADHESIVE VINYL NAMEPLATE SHALL BE PROVIDED FOR ALL SWITCHES, RECEPTACLES, DISCONNECT SWITCHES, MOTOR STARTERS, AND MISCELLANEOUS DEVICES REQUIRING POWER. THE NAMEPLATE SHALL INDICATE THE PANELBOARD SERVING THE DEVICE AND THE CORRESPONDING CIRCUIT ASSIGNMENT. LETTERING SHALL BE A MINIMUM OF 1/4" HIGH. UTILIZE BROTHER "P-TOUCH" LABEL MAKER OR APPROVED SUBSTITUTE.
 29. A GREEN, EQUIPMENT GROUND CONDUCTOR SIZED IN ACCORDANCE WITH THE NEC ARTICLE 250 SHALL BE INSTALLED IN ALL FEEDER AND BRANCH CIRCUITS WHETHER INDICATED ON CONTRACT DRAWINGS OR NOT. INSTALL THIS CONDUCTOR IN ALL RACEWAYS INCLUDING THOSE INSTALLED FOR SWITCH LEGS AND ATTACH TO THE DEVICE, LUMINAIRE, OR EQUIPMENT USING A SUITABLE GROUNDING LUG.


- DO NOT USE A COMMON NEUTRAL FOR MULTIPLE BRANCH CIRCUITS INSTALLED IN A COMMON CONDUIT. PROVIDE A DEDICATED NEUTRAL FOR EACH INDIVIDUAL CIRCUIT. WHERE MULTIPLE DEDICATED NEUTRALS ARE INSTALLED IN A COMMON CONDUIT, PROVIDE COLOR CODING OF THE DIFFERENT NEUTRAL CONDUCTORS IN ACCORDANCE WITH THE NEC (WHITE, GRAY, THREE CONTINUOUS WHITE OR GRAY STRIPES, ETC.)
31. PROVIDE NYLON PULLSTRINGS IN ALL EMPTY CONDUITS UNLESS OTHERWISE INDICATED.
 32. THE TELECOMMUNICATIONS RACEWAY SYSTEM INSTALLATION SHALL COMPLY WITH TIA/EIA AND BICSI STANDARDS UNLESS OTHERWISE NOTED.
 33. CONDUIT BODIES (E.G. LB, LR, ETC.) SHALL NOT BE PERMITTED IN THE TELECOMMUNICATIONS RACEWAY SYSTEMS UNLESS SPECIFICALLY INDICATED TO BE UTILIZED AND LISTED FOR TELECOMMUNICATIONS SYSTEM USE.
 34. PROVIDE INSULATED BUSHINGS AT ALL TELECOMMUNICATIONS CONDUIT TERMINATIONS AT ALL BOXES, BACKBOARDS, AND CONDUIT STUBS.
 35. ALL SURFACE MOUNTED DEVICES SHALL BE INSTALLED UTILIZING FACTORY PAINTED SURFACE MOUNTING ACCESSORIES AND MATCHING DEVICE BOXES FOR THE MOST AESTHETICALLY PLEASING INSTALLATION.
 36. PROVIDE KNOCK-OUT PLUGS FOR ALL UNUSED CONDUIT PENETRATIONS IN BOXES AND ENCLOSURES DUE TO CONDUIT REMOVAL.
 37. PENETRATIONS THROUGH FIRE-RATED WALLS, CEILINGS, AND FLOORS SHALL BE SEALED TO MAINTAIN FIRE RATINGS. UTILIZE 3M CP25, PUTTY 303, OR OTHER SUITABLE UL-LISTED SEALING SYSTEM.
 38. PATCH, REFINISH, AND PAINT ALL PENETRATIONS THROUGH WALLS AND SLABS TO MATCH FINISH OF ADJACENT SURFACES.
 39. RESTORE/REPAIR ANY DAMAGE TO EXISTING SURFACES RESULTING FROM THE INSTALLATION OF NEW ELECTRICAL ITEMS. THE AREAS REPAIRED SHALL MATCH THE ADJACENT SURFACES IN TEXTURE, FINISH, AND COLOR.
 43. PAINTING OF ELECTRICAL EQUIPMENT:
 - a. INTERIOR LOCATIONS - PRIME AND PAINT ALL EXPOSED CONDUITS, BOXES, FITTINGS, SUPPORT CHANNELS, MOUNTING HARDWARE, AND ACCESSORIES WITH TWO FINISH COATS TO MATCH THE SURFACE ON WHICH THEY ARE MOUNTED OR TO MATCH THE FINISH OF THE ADJACENT SURFACES. EQUIPMENT SURFACES/COMPONENTS WITH A FACTORY-APPLIED PAINT FINISH NEED NOT BE PAINTED.
 - b. EXTERIOR LOCATIONS - PRIME ALL EXPOSED CONDUITS, BOXES, FITTINGS, SUPPORT CHANNELS, MOUNTING HARDWARE, AND ACCESSORIES WITH A 2-PART EPOXY PRIMER AND FINISH WITH 2 COATS OF AN ALIPHATIC ACRYLIC URETHANE PAINT. PAINT FINISH TO MATCH THE SURFACE ON WHICH THEY ARE MOUNTED OR TO MATCH THE FINISH OF THE ADJACENT SURFACES. STAINLESS STEEL MATERIALS NEED NOT BE PAINTED.
 44. ELECTRICAL EQUIPMENT SUPPORTING HVAC EQUIPMENT INSTALLED ABOVE SUSPENDED CEILINGS SHALL COMPLY WITH THE NEC FOR WORKSPACE CLEARANCE IN AREAS OF LIMITED ACCESS.
 45. LIGHTING SYSTEM CONTROLS FUNCTIONAL TESTING: PROVIDE ALL MATERIALS AND LABOR REQUIRED TO TEST THE LIGHTING SYSTEM CONTROLS TO ENSURE THAT THE CONTROL HARDWARE AND SOFTWARE ARE CALIBRATED, ADJUSTED, PROGRAMMED, AND IN PROPER WORKING CONDITION IN ACCORDANCE WITH THE CONTRACT DOCUMENTS. THE CONTRACTOR SHALL PERFORM AND DOCUMENT THE FUNCTIONAL TESTING WHICH SHALL BE IN ACCORDANCE WITH THE APPLICABLE PARAGRAPHS OF THE COUNTY'S ENERGY CODE. THE DESIGNER OF RECORD SHALL WITNESS THE FUNCTIONAL TESTING. THE TESTING DOCUMENTATION SHALL BE PROVIDED TO THE DESIGNER OF RECORD FOR REVIEW AND APPROVAL PRIOR TO PROJECT CLOSE-OUT.
 46. ALL ELECTRIFIED UTILIZATION EQUIPMENT, CONTROL DEVICES, CONTROL CIRCUITING, AND SEPARATELY MOUNTED MOTOR STARTERS/CONTROLLERS ARE SPECIFIED AND PROVIDED UNDER THE APPLICABLE SPECIFICATION SECTIONS. ALL LINE VOLTAGE POWER TO THE ELECTRIFIED UTILIZATION EQUIPMENT SHALL BE PROVIDED UNDER THE ELECTRICAL CONTRACT DOCUMENTS.
 47. FOR ELECTRIFIED UTILIZATION EQUIPMENT, COORDINATE THE MOUNTING HEIGHT OF THE ASSOCIATED JUNCTION BOX, DISCONNECT SWITCH, OR STARTER/CONTROLLER WITH THE ACTUAL EQUIPMENT SUPPLIED.
 48. PROVIDE EARTHQUAKE BRACING FOR ALL ELECTRICAL EQUIPMENT, APPARATUS, AND RACEWAYS. BRACING SHALL, AS A MINIMUM, COMPLY WITH THE COUNTY BUILDING CODE.
 49. ALL CONDUITS ENTERING THE BUILDING FROM THE EXTERIOR SHALL BE SEALED TO PREVENT ENTRANCE OF MOISTURE, GASES, AND RODENTS.
 50. WHERE A FIRE ALARM SYSTEM EVENT IS REQUIRED TO TURN "ON" EGRESS OR OTHER AUTOMATICALLY CONTROLLED LIGHTING FIXTURES, COORDINATE ALL INTERFACE REQUIREMENTS WITH THE FIRE ALARM SYSTEM SUPPLIER AND APPROPRIATE INSTALLING CONTRACTOR.
 51. THE STATE WARNING POINT ROOM AND IT SERVER ROOM IN B303 SHALL REMAIN OPERATIONAL THROUGHOUT THE ENTIRE CONSTRUCTION PERIOD. PROVIDE A PORTABLE GENERATOR TO POWER PANELS MS-1, CDS-1, AND IT-1 DURING ANY OUTAGES. THE FLOOR OUTLETS IN THE WARNING POINT ROOM ARE POWERED BY PANEL MS-1. OUTAGE IS LIMITED TO AFTER HOURS AND THE WEEKENDS FOR THE REST OF B303. 24/7 POWER IS REQUIRED FOR BIRKHIEMER AND PSB. PROVIDE TEMPORARY POWER TO SUPPORT OPERATIONS. COORDINATE ANY OUTAGES WITH THE CONTRACTING OFFICER 2 WEEKS IN ADVANCE.

 HAWAII STATE DEPARTMENT OF DEFENSE				
SIGNATURE		EXPIRATION DATE		
				APPR.
				DATE
				DESCRIPTION
				SYM
SUBMITTAL PHASE				
CONSTRUCTION DOCUMENTS				
SUBMITTAL DATE		03/01/2024		
	ST	KR		ST
DEPARTMENT OF DEFENSE	DIAMOND HEAD STATE MONUMENT TWK: 3-1-042:006 4204 DIAMOND HEAD RD HONOLULU, HI 96816 BIRKHMIR EMERGENCY OPERATIONS CENTER (EOC) UPGRADES AND IMPROVEMENTS GENERAL ELECTRICAL NOTES			
STATE OF HAWAII				
SCALE:	AS NOTED			
STATE JOB NO.	CA-2023313-C			
FEDERAL PROJECT NO.	-			
SHEET	87	OF	123	
E-002				

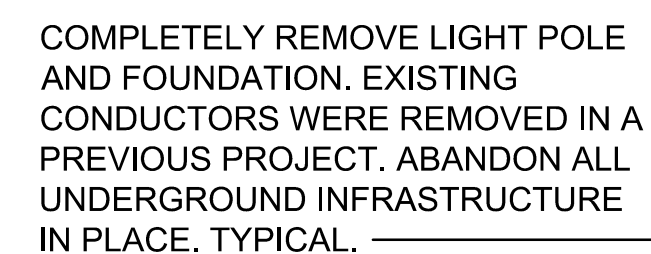

B303



DIAMOND HEAD TUNNEL ROAD

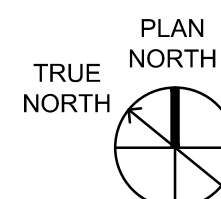

A1
EA101

SITE ELECTRICAL PLAN - DEMO

SCALE: 1" = 30'-0"

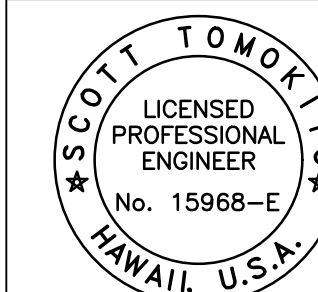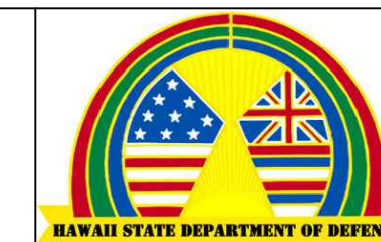

THIS WORK WAS PREPARED BY MI
OR UNDER MY SUPERVISION

Signature: Scott Tomokyo 4/30/2022
SIGNATURE EXPIRATION DATE

[illegible]

SUBMITTAL PHASE										
CONSTRUCTION										
DOCUMENTS										

SUBMITTAL DATE			03/01/202
SE	KR	S	

42004 DIAMOND HEAD RD HONOLULU, HI 96816	TMK: 3-1-042:006	
BIRKHMIR EMERGENCY OPERATIONS CENTER (EOC) UPGRADES AND IMPROVEMENTS		
SITE ELECTRICAL PLAN - DEMO		

SCALE: AS NOTED

STATE JOB NO. CA-202313-C

FEDERAL PROJECT NO.

SHEET 88 OF 123

EA101

1

2

3

4


5

D

C

B

A

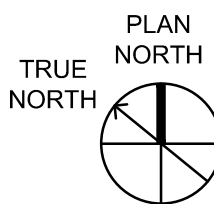



1
EA101

SITE ELECTRICAL PLAN

SCALE: 1" = 30'-0"



SCALE: 1" = 30'

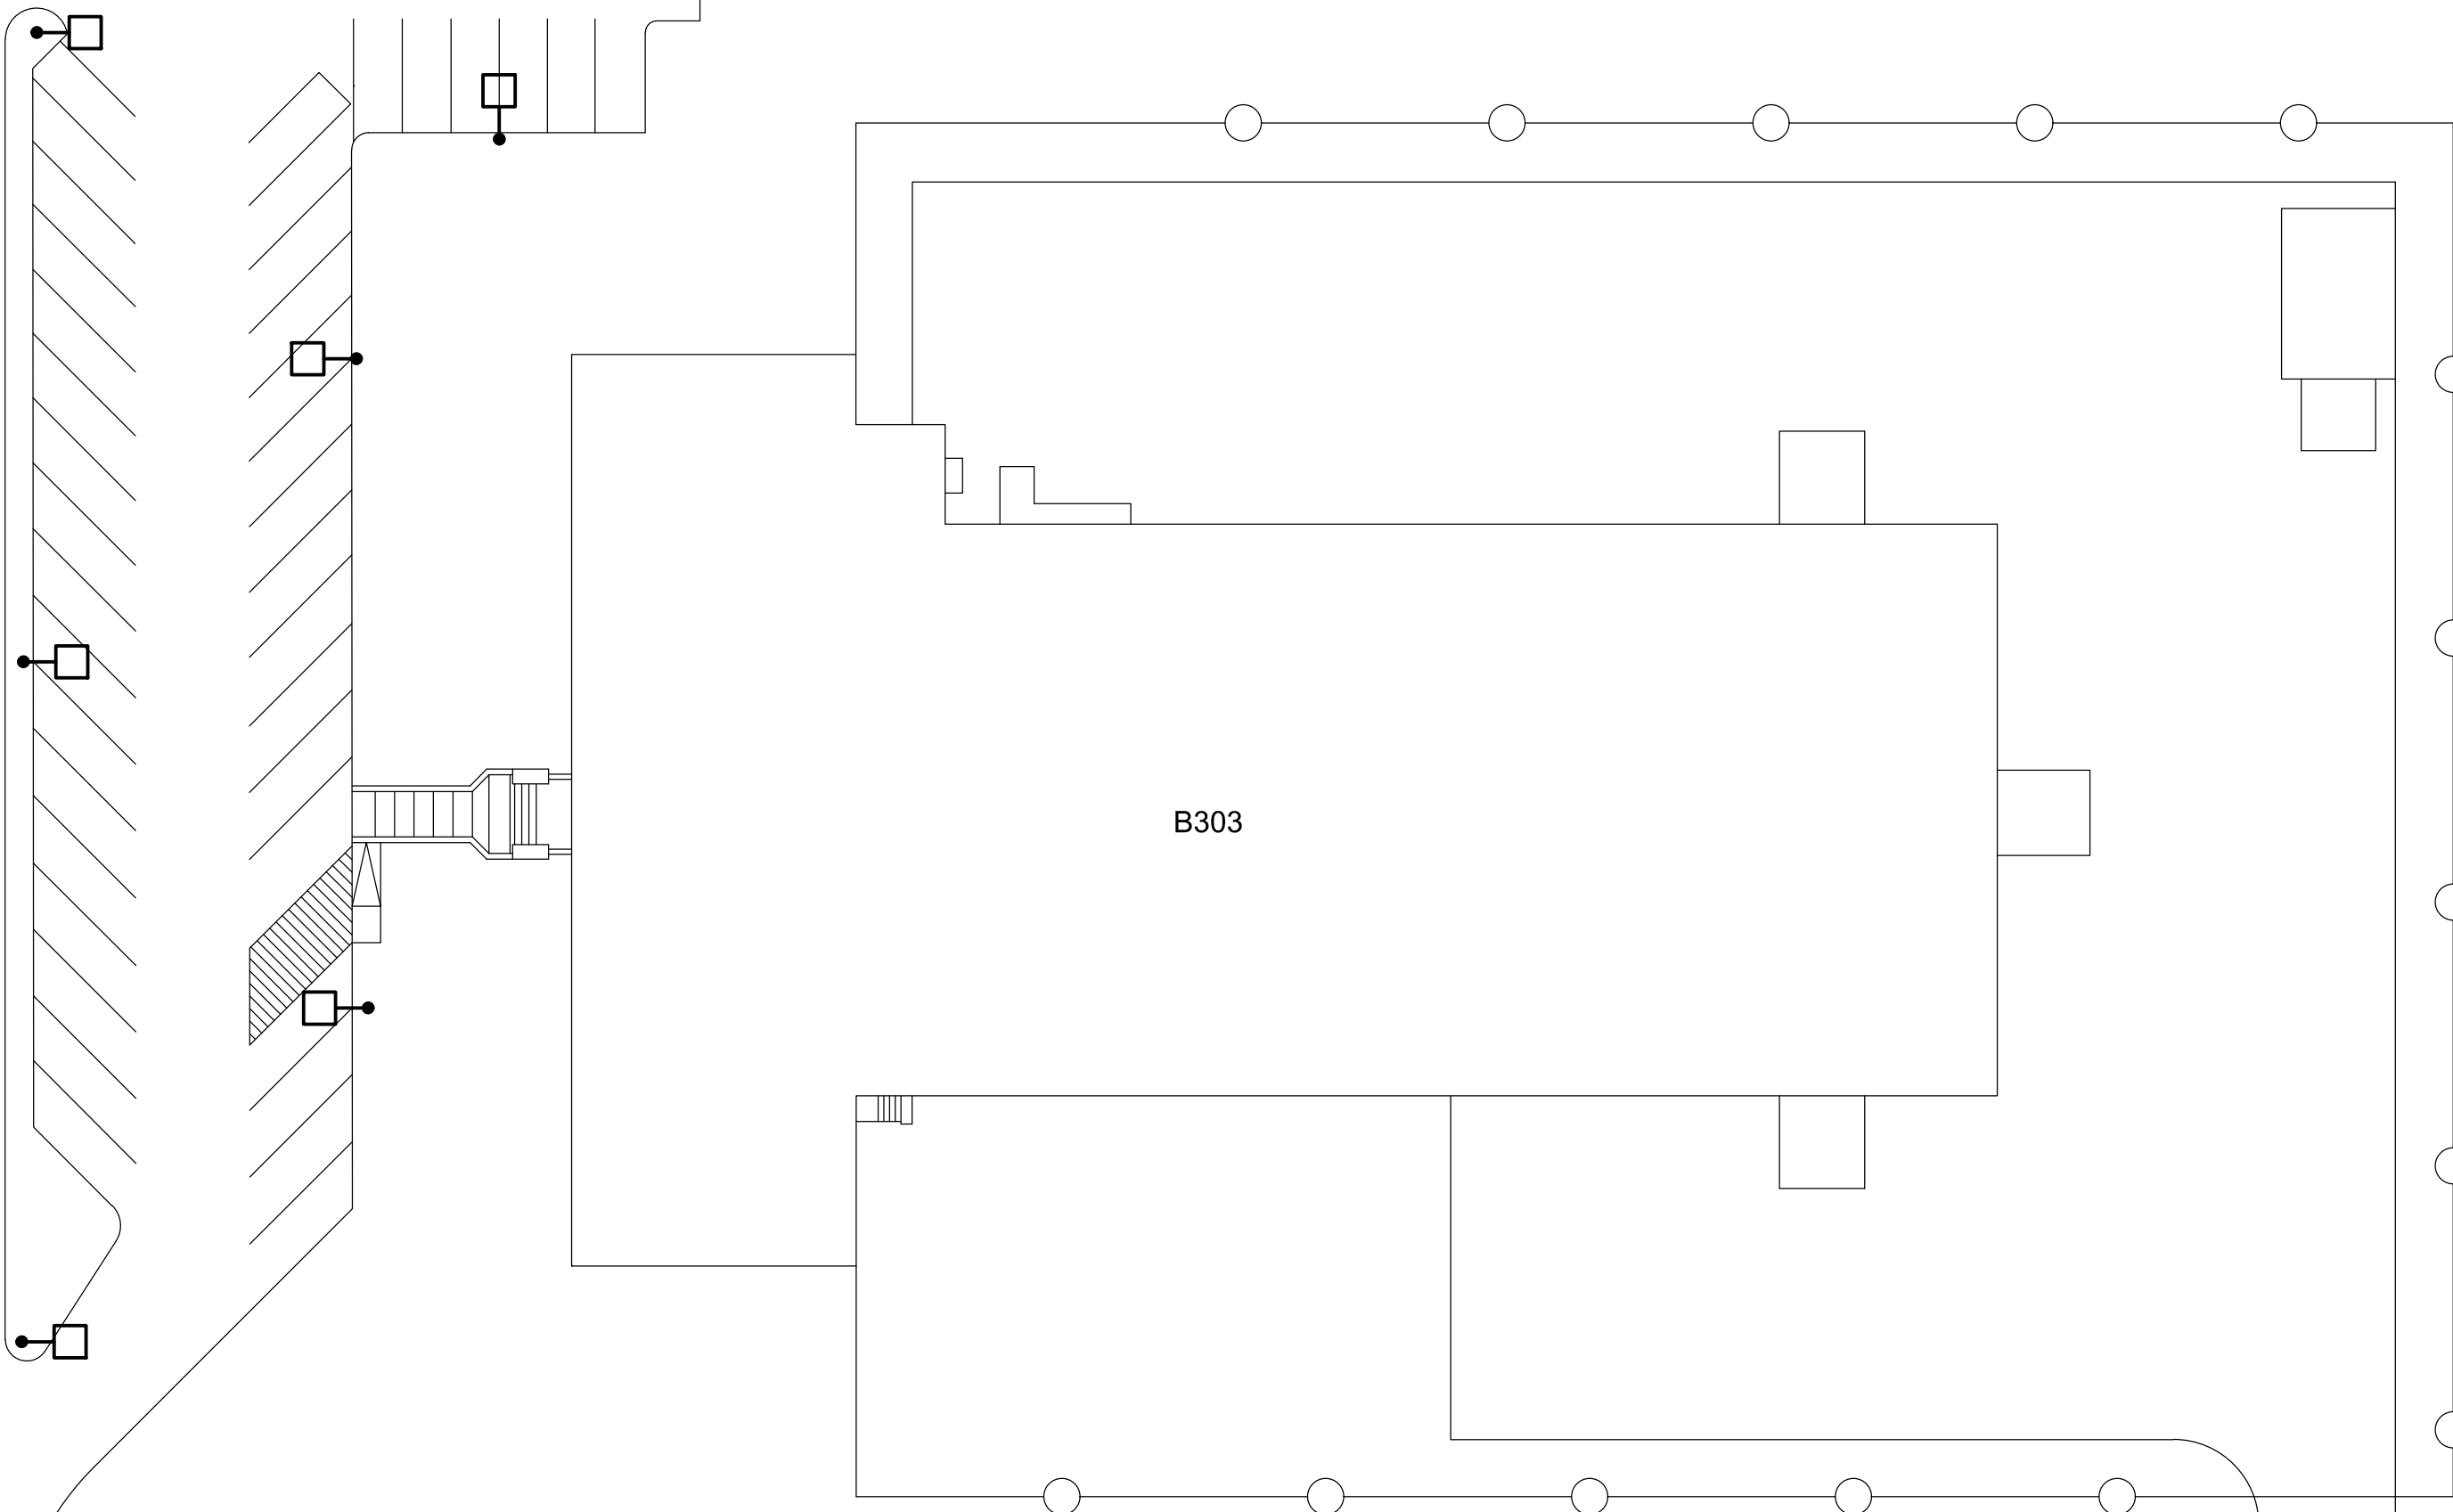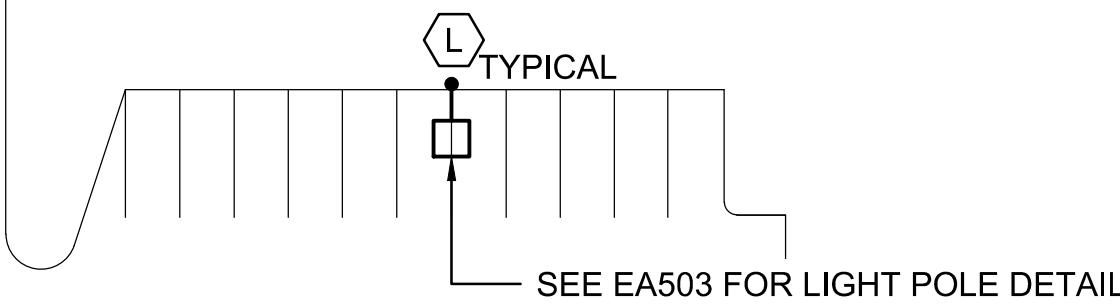


B303

DIAMOND HEAD TUNNEL ROAD

GENERAL NOTES

- REFER TO EA701 FOR LIGHT FIXTURE

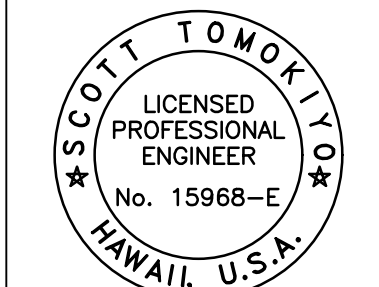

THIS WORK WAS PREPARED BY ME OR UNDER MY SUPERVISION

SIGNATURE: *Scott Tomkiyo* EXPIRATION DATE: 4/30/2026

APPROVED: DATE: DESCRIPTION: SYN:

APPROVED: DATE: DESCRIPTION: SYN:

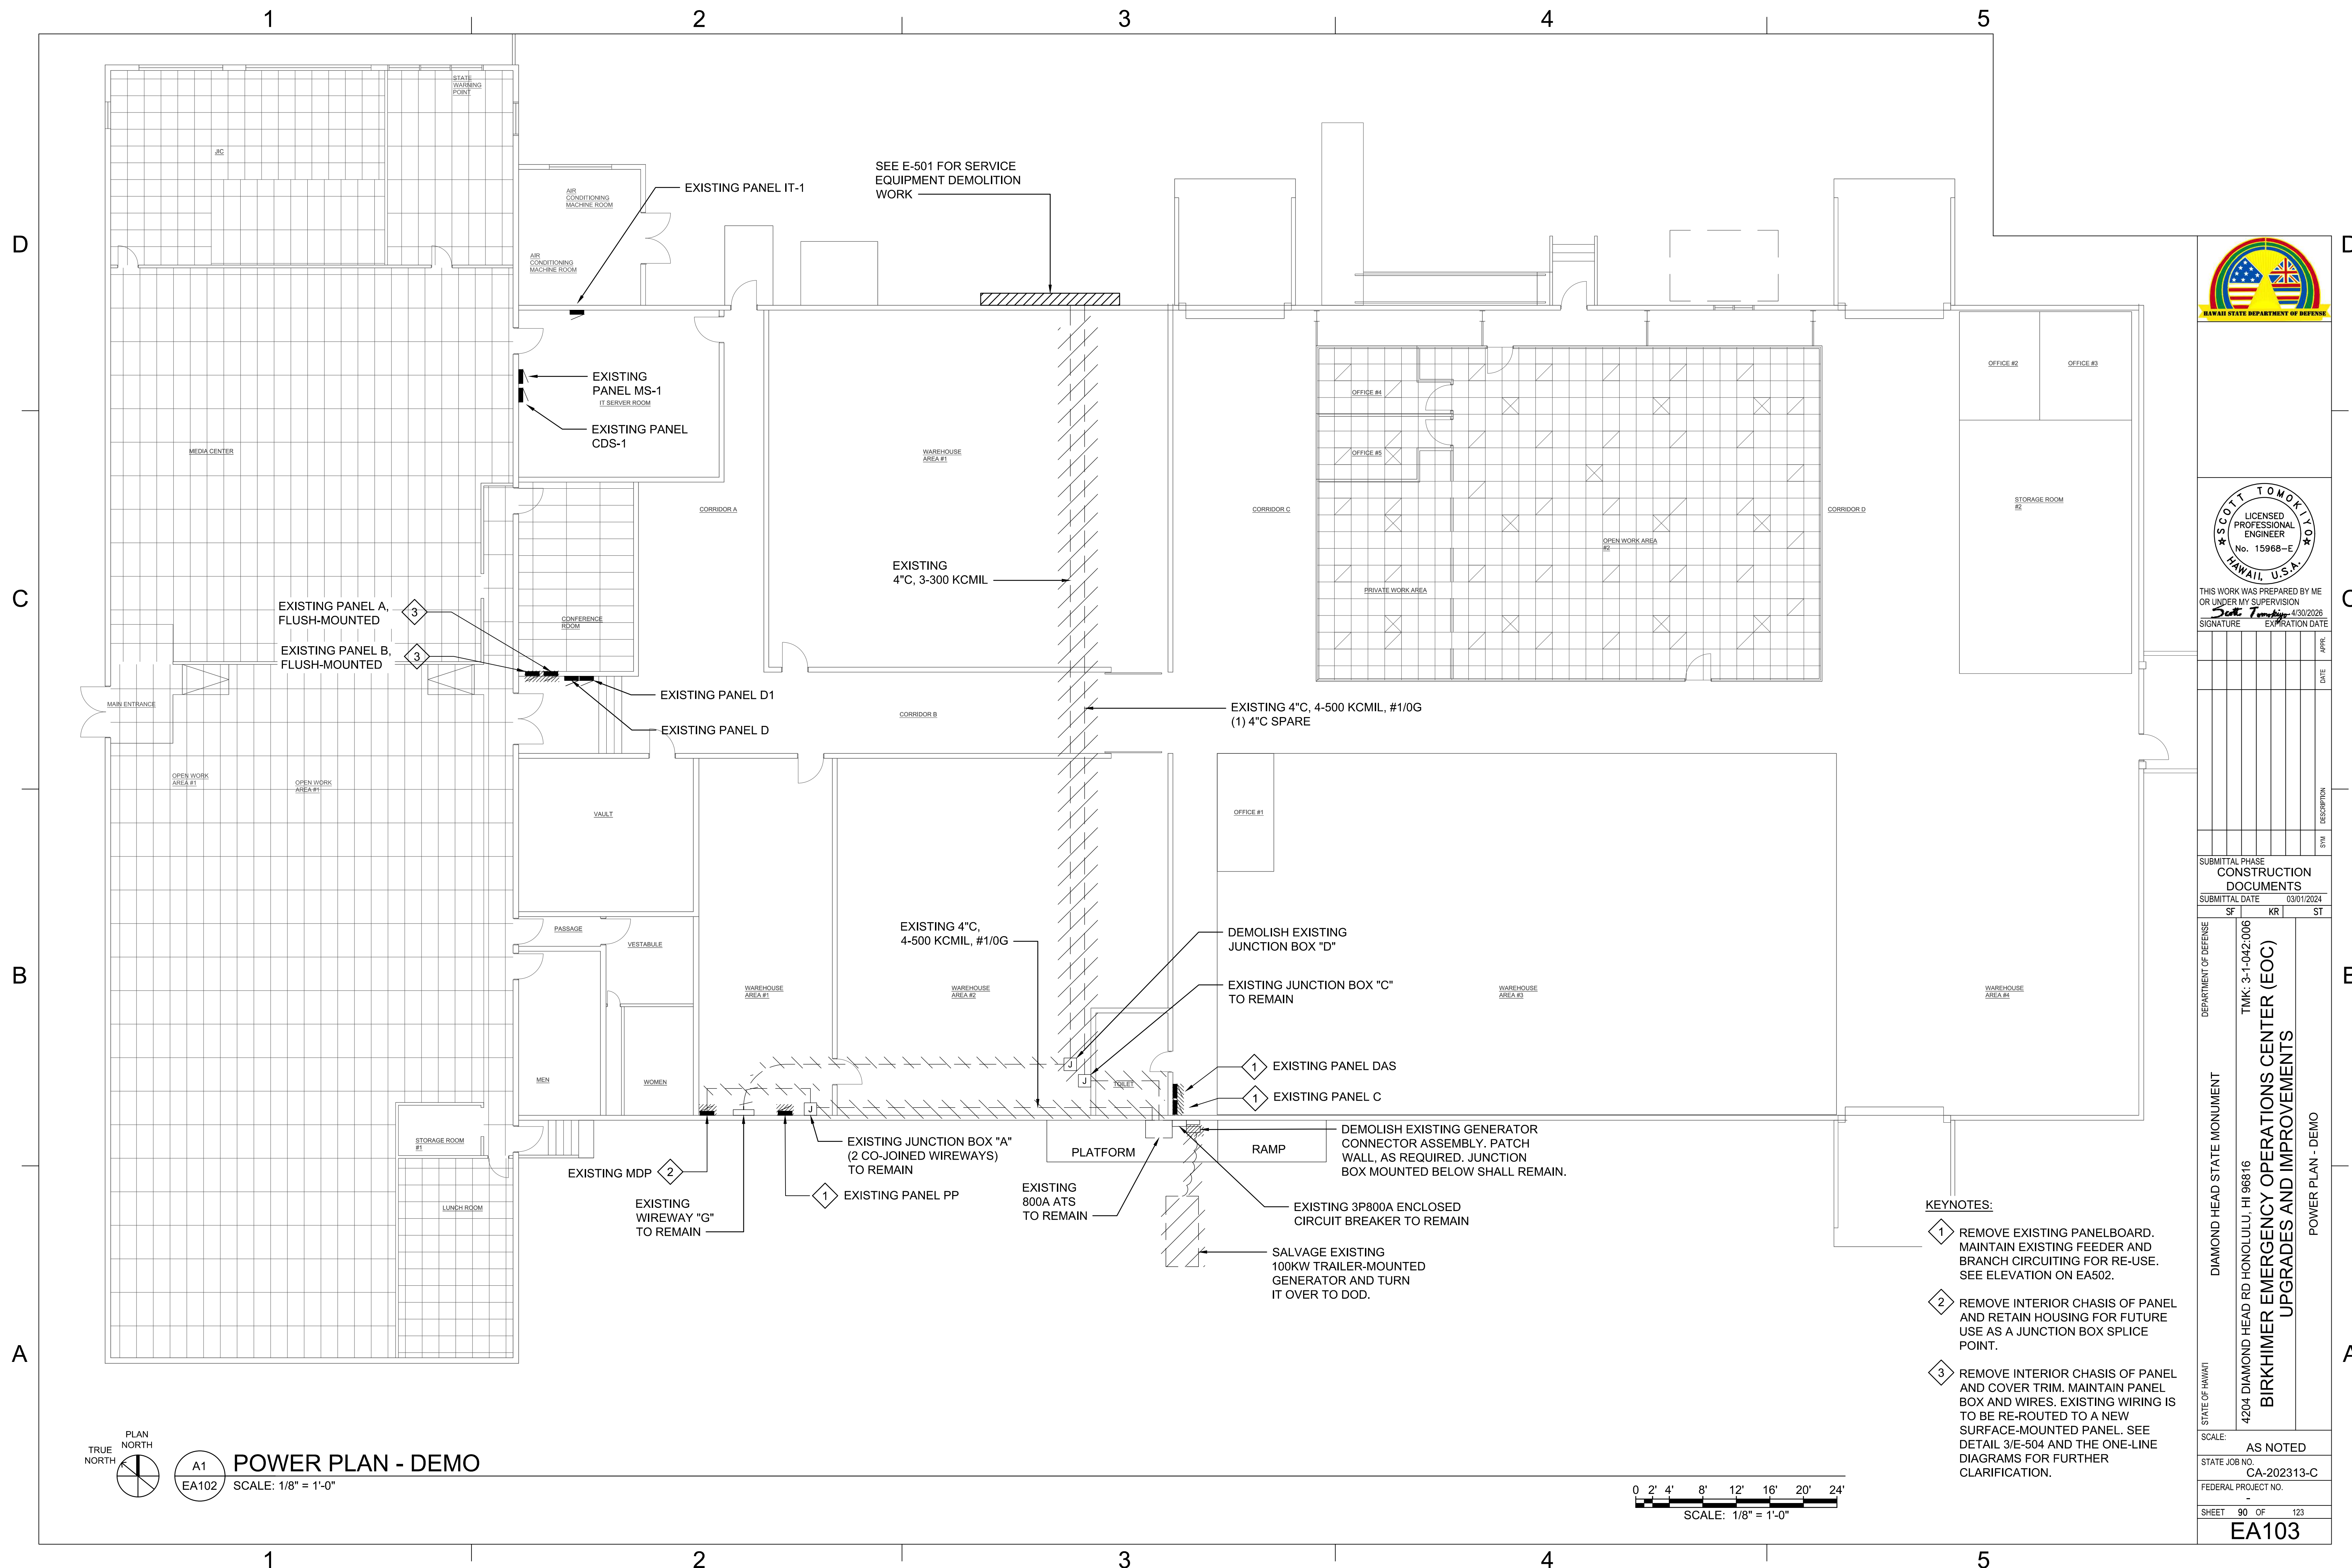

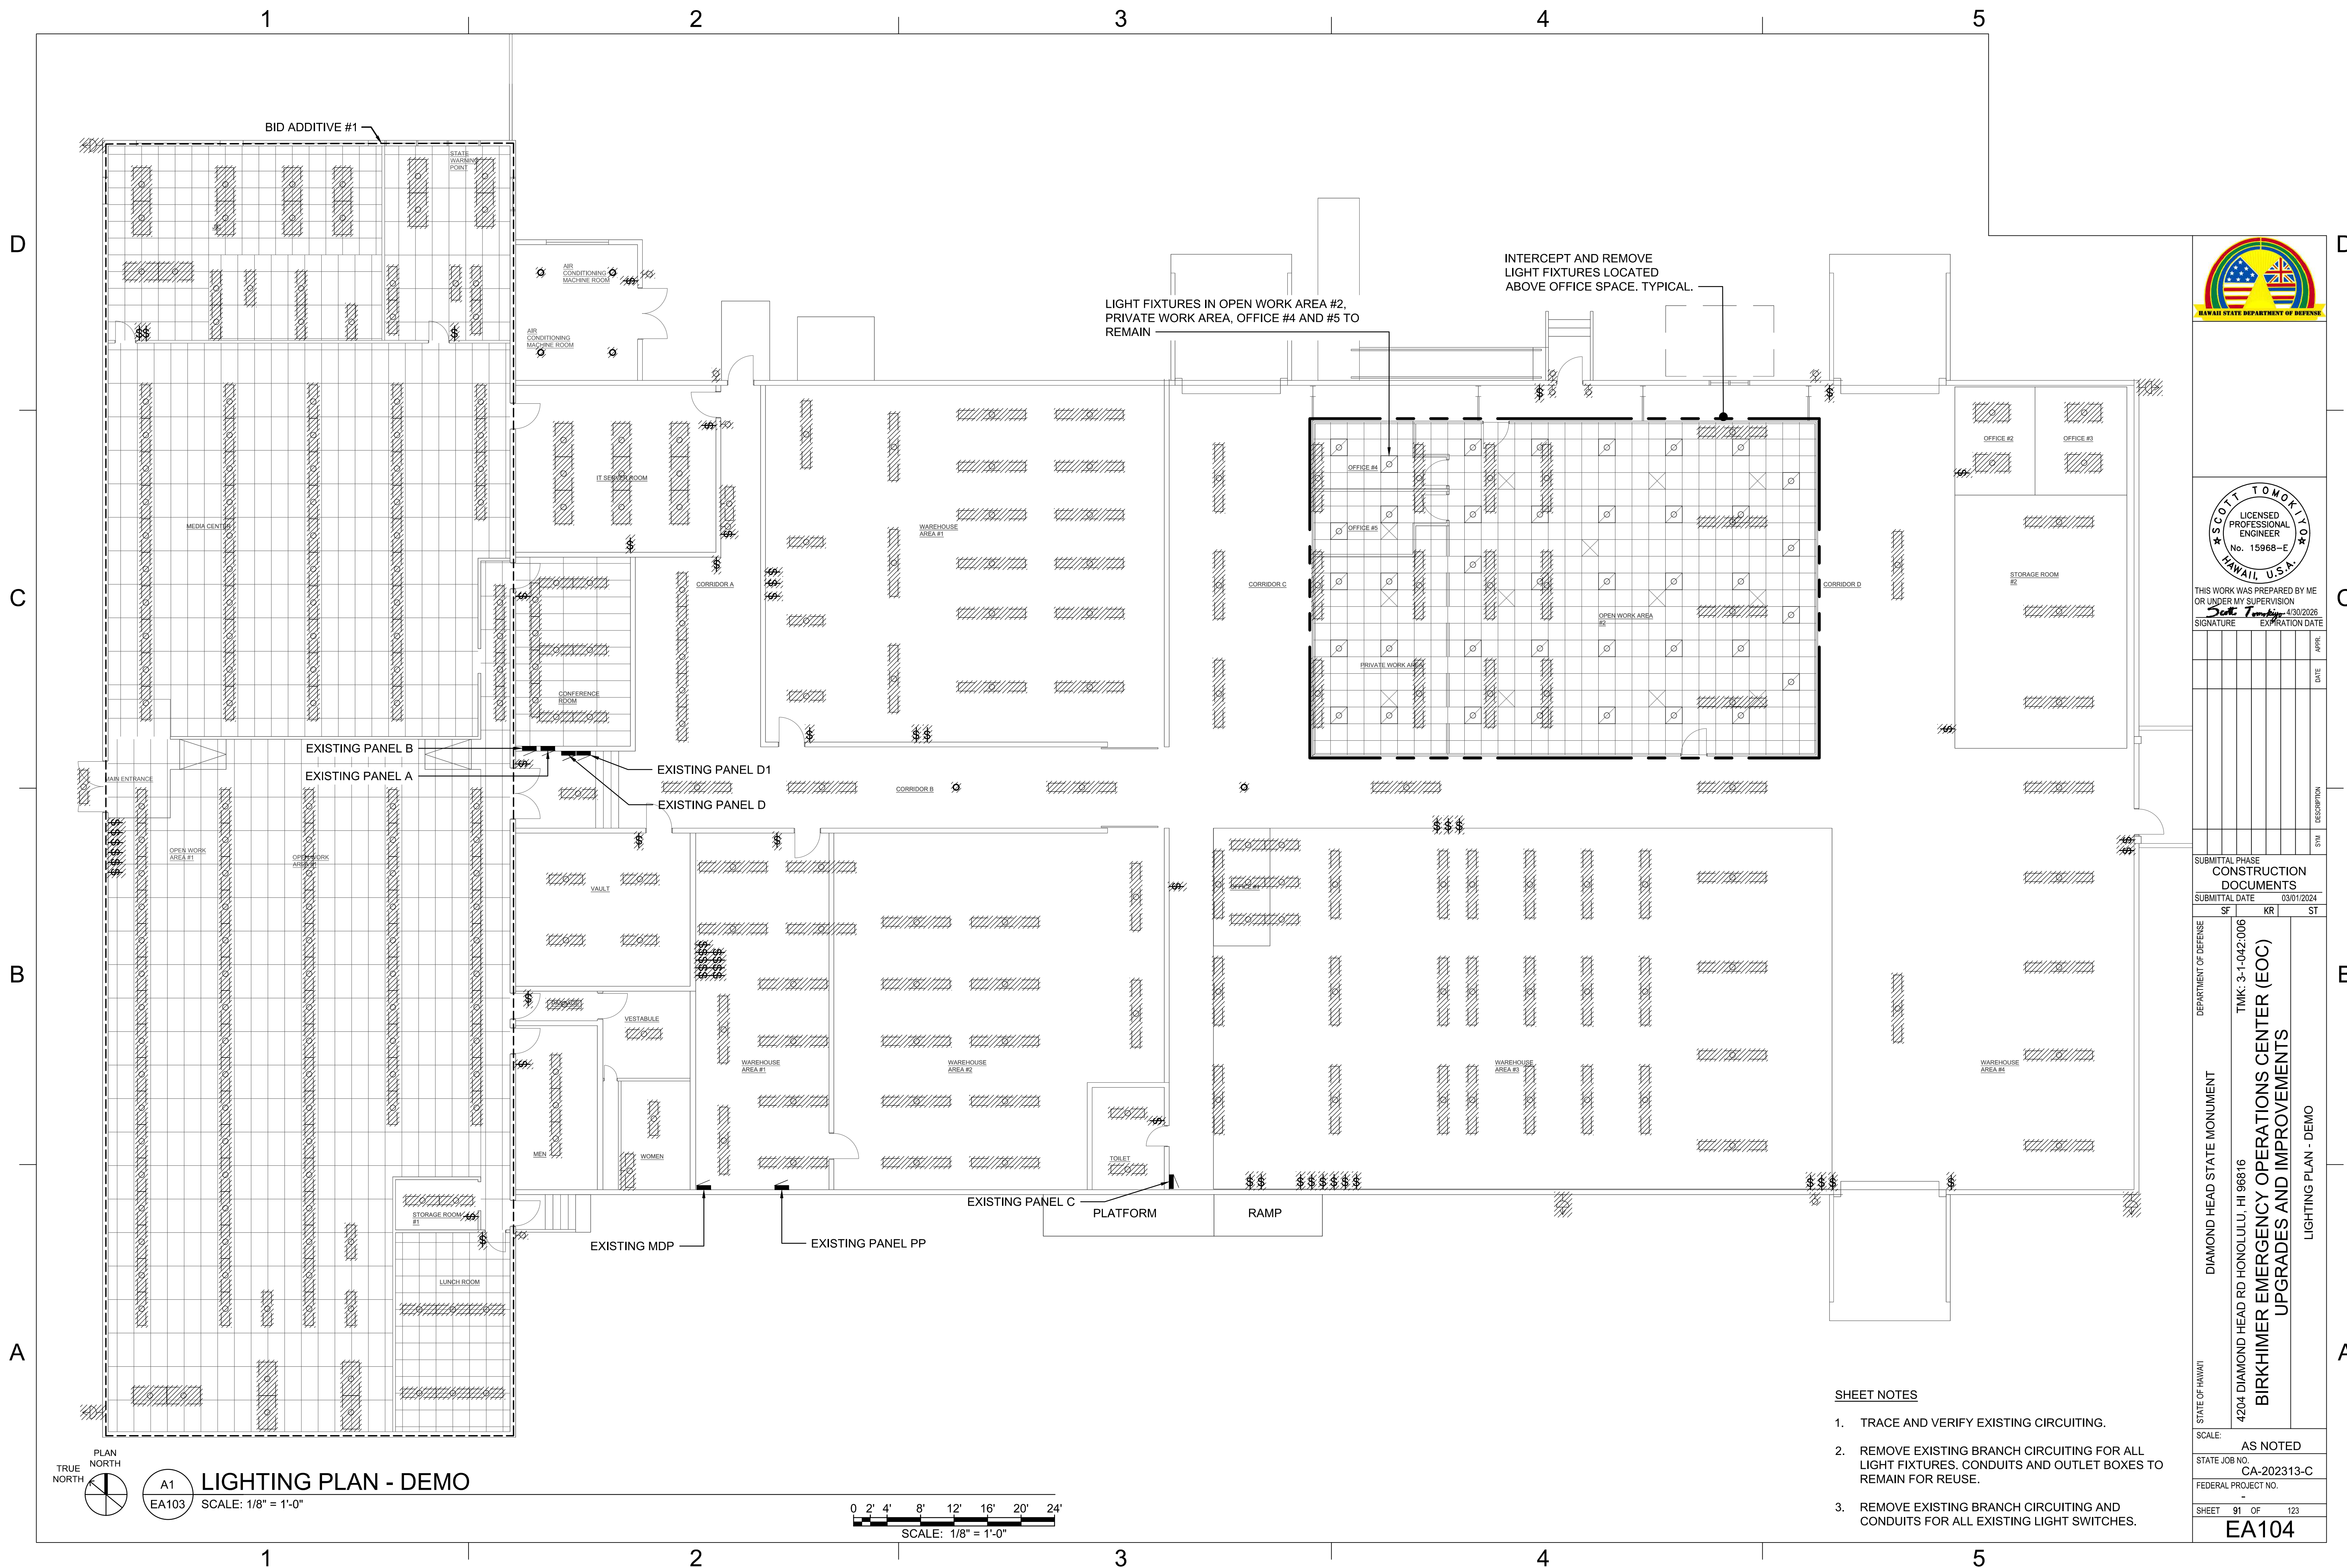

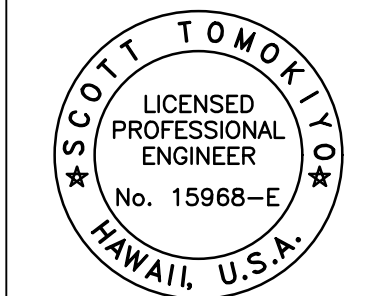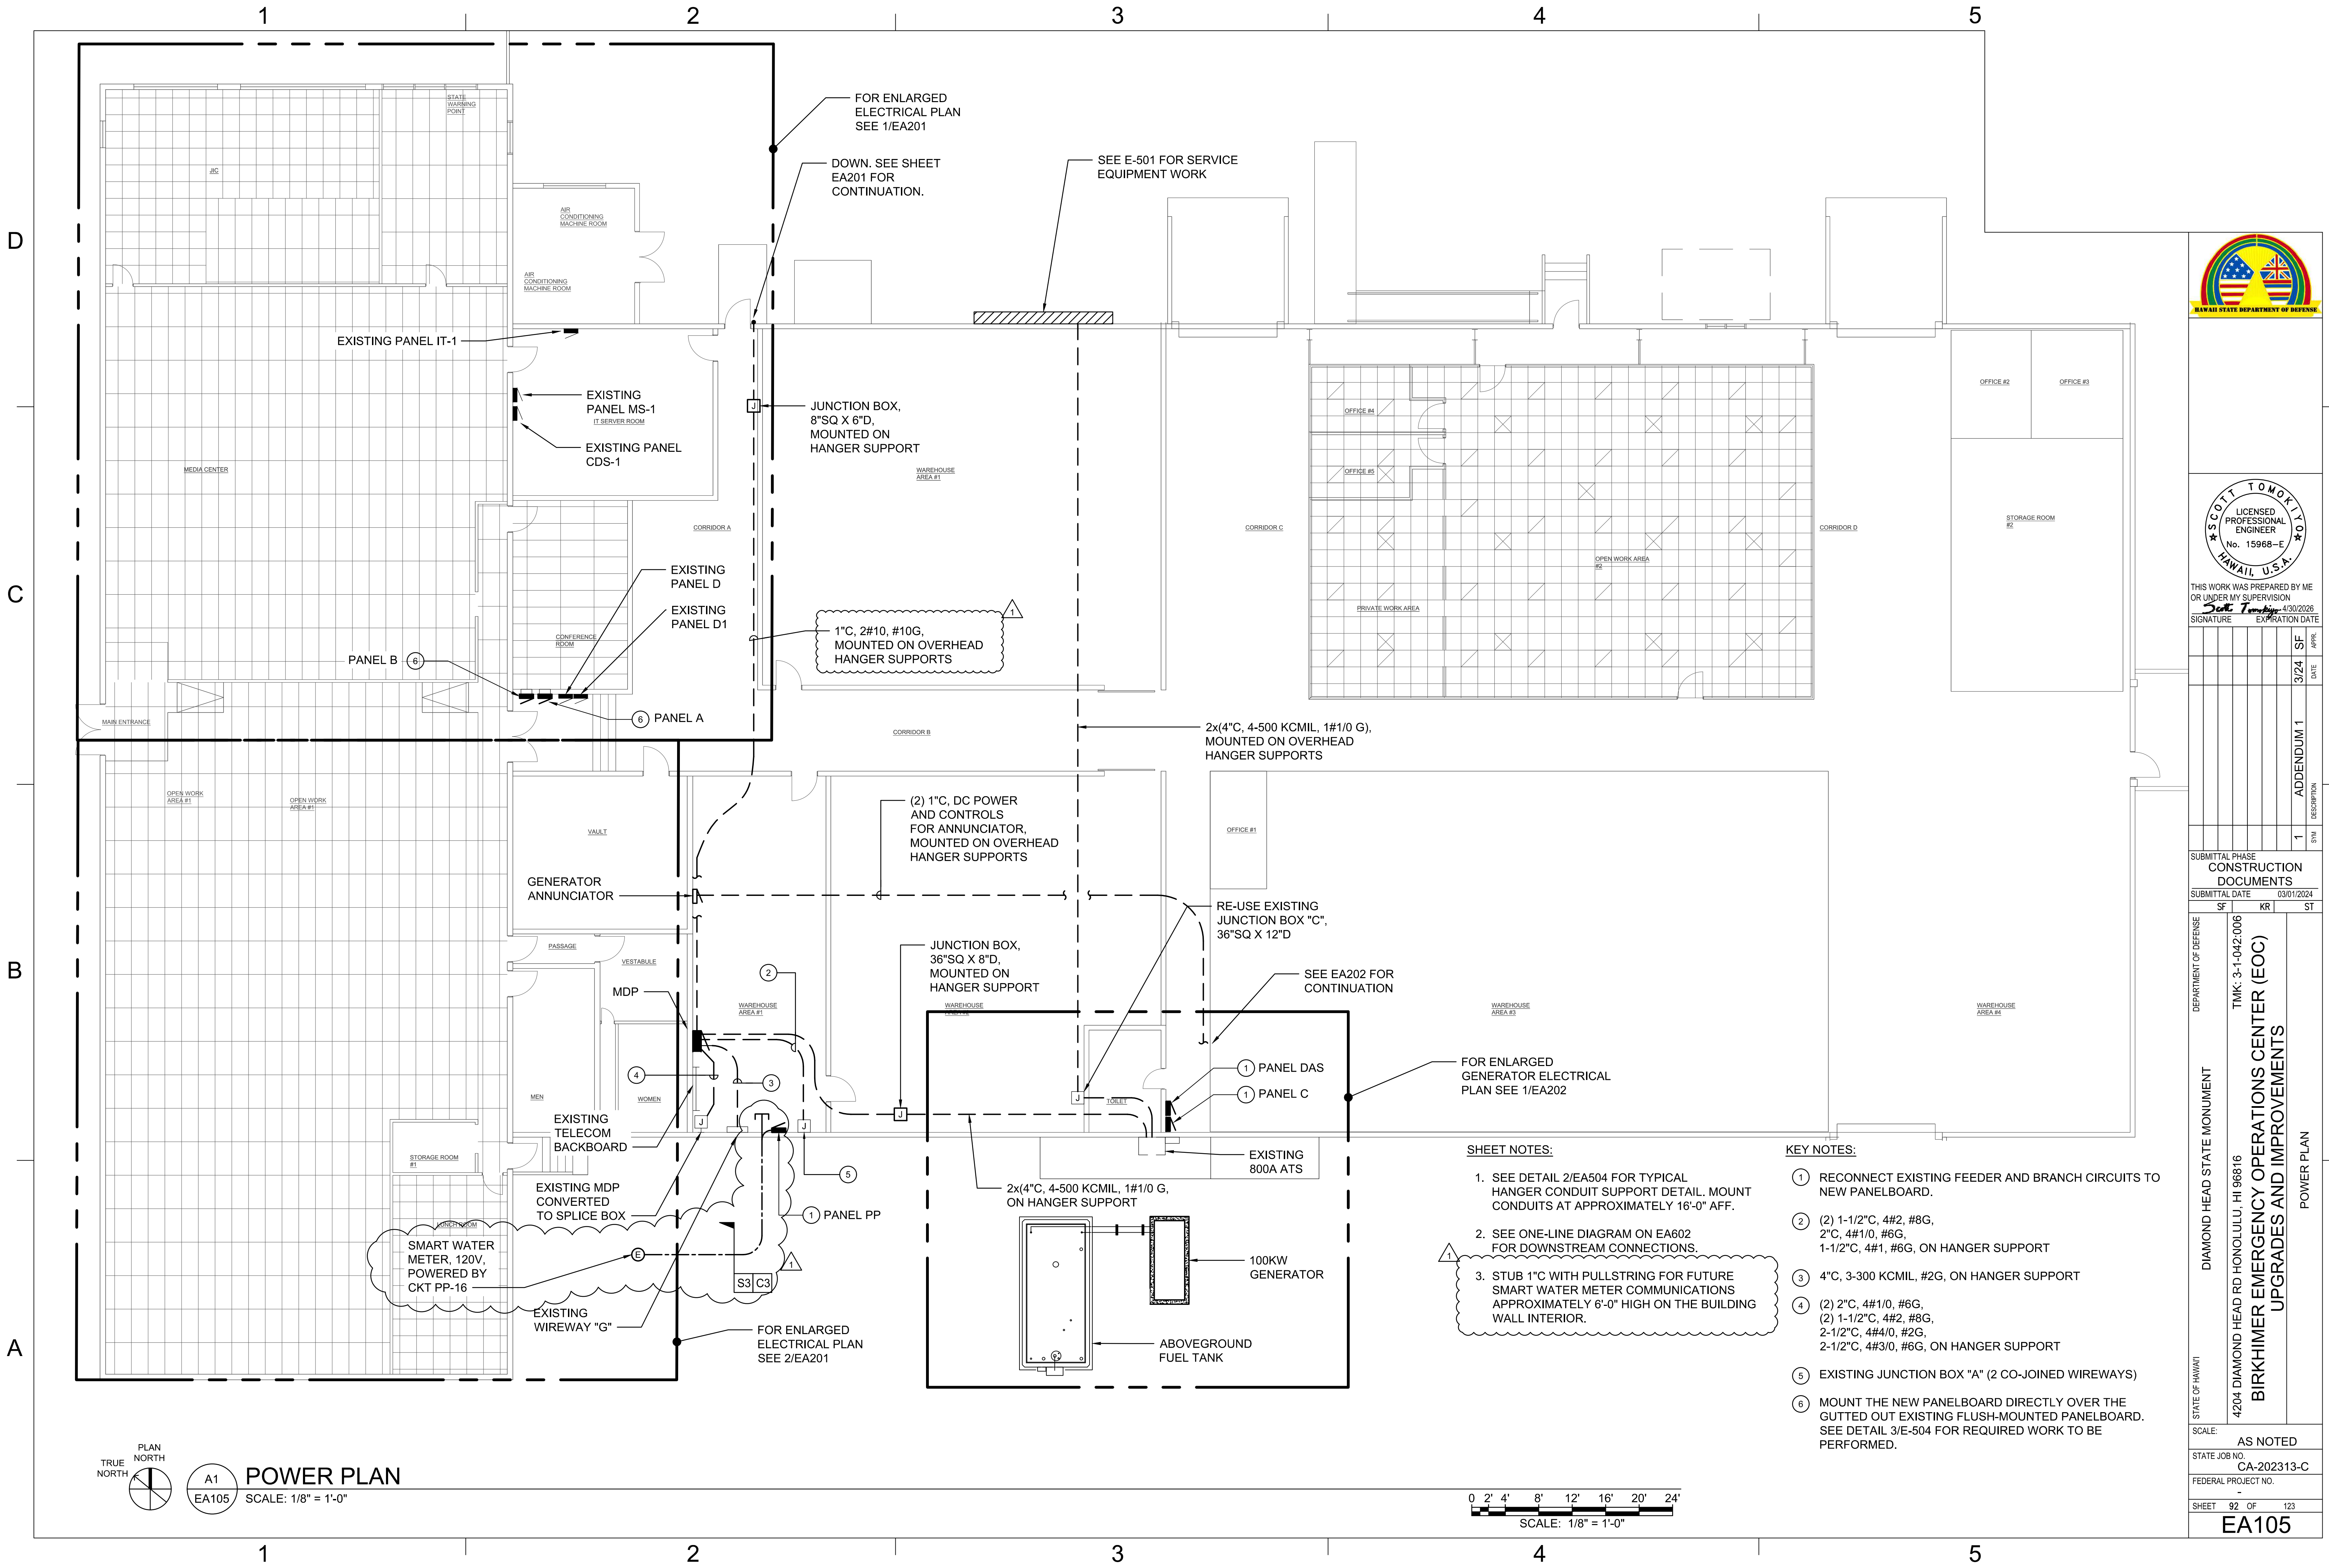

THIS WORK WAS PREPARED BY ME OR UNDER MY SUPERVISION
SIGNATURE: Scott Tomkiy EXPIRATION DATE


SYN	DESCRIPTION	DATE	APPR.
1	ADDENDUM 1	3/24	

SUBMITTAL PHASE
CONSTRUCTION DOCUMENTS
SUBMITTAL DATE 03/01/2024

SF	KR	ST

DEPARTMENT OF DEFENSE
DIAMOND HEAD STATE MONUMENT
STATE OF HAWAII
4204 DIAMOND HEAD RD HONOLULU, HI 96816
TMK: 3-1-042:006
BIRKHAMER EMERGENCY OPERATIONS CENTER (EOC)
UPGRADES AND IMPROVEMENTS
POWER PLAN

SCALE:
STATE JOB NO. CA-202313-C
FEDERAL PROJECT NO. -
SHEET 92 OF 123
EA105

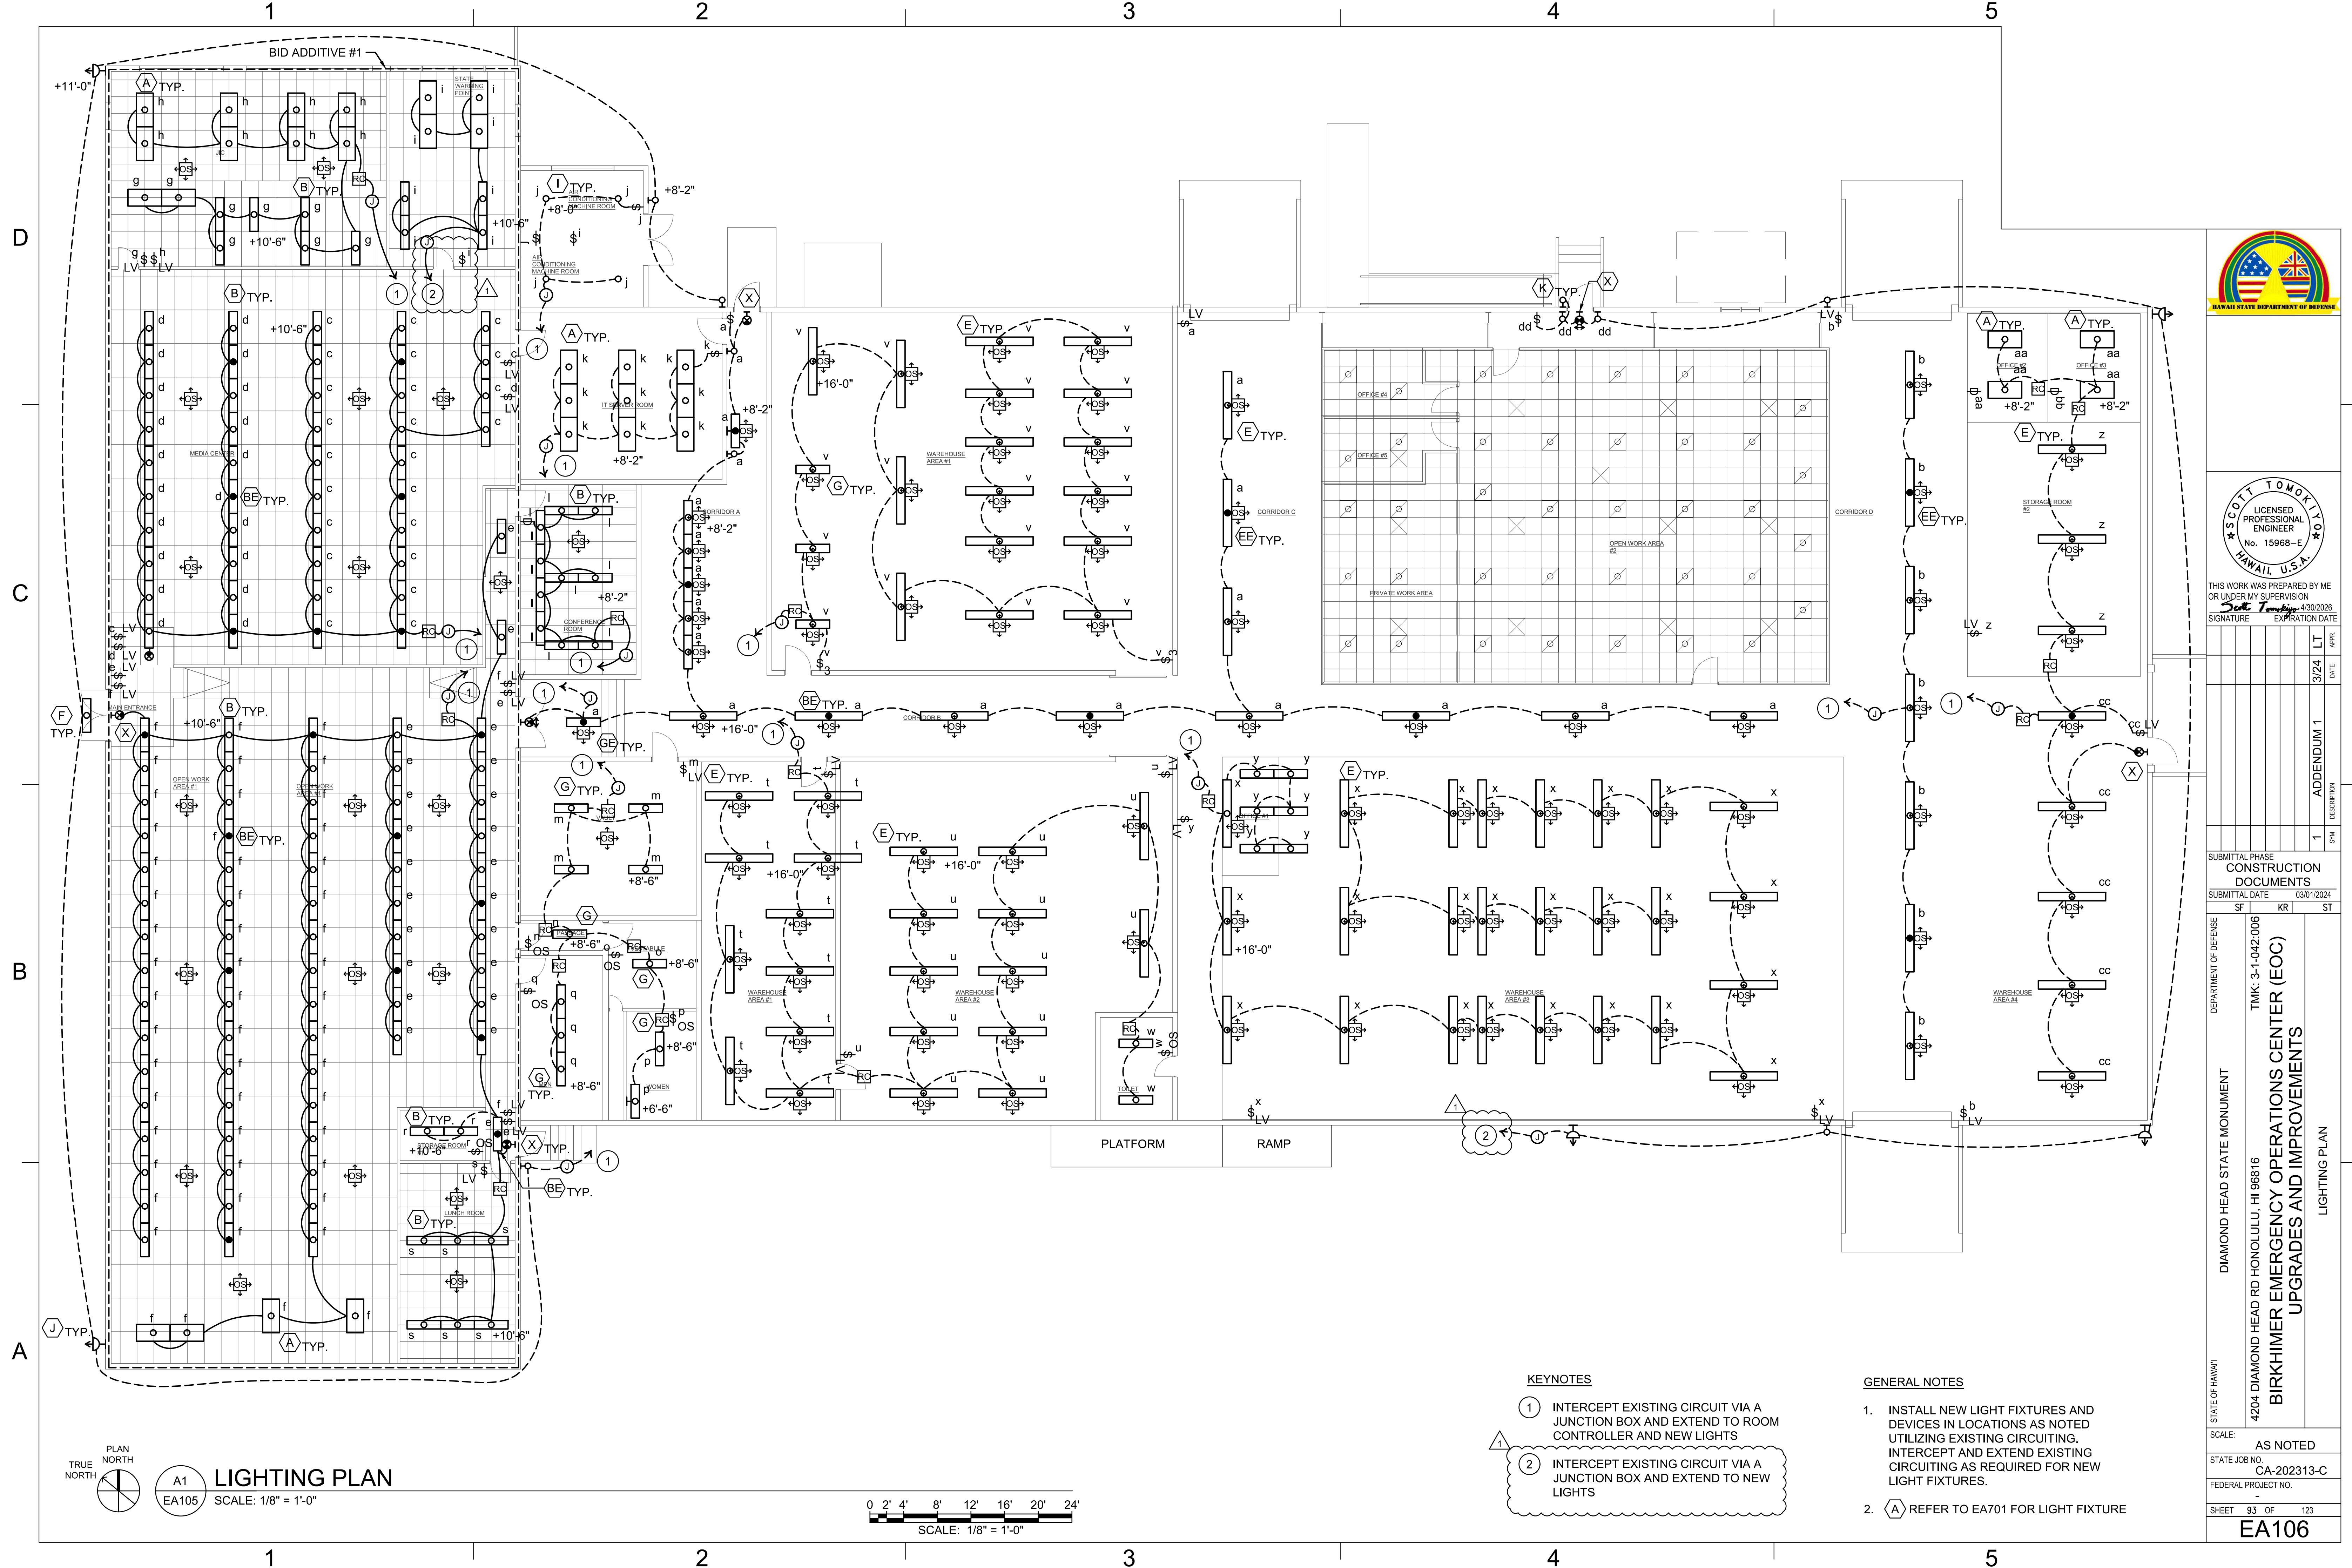

LIGHTING PLAN

SCALE: 1/8" = 1'-0"


0 2' 4' 8' 12' 16' 20' 24'
SCALE: 1/8" = 1'-0"

KEYNOTES

- 1 INTERCEPT EXISTING CIRCUIT VIA A JUNCTION BOX AND EXTEND TO ROOM CONTROLLER AND NEW LIGHTS
- 2 INTERCEPT EXISTING CIRCUIT VIA A JUNCTION BOX AND EXTEND TO NEW LIGHTS

GENERAL NOTES

- 1. INSTALL NEW LIGHT FIXTURES AND DEVICES IN LOCATIONS AS NOTED UTILIZING EXISTING CIRCUITING. INTERCEPT AND EXTEND EXISTING CIRCUITING AS REQUIRED FOR NEW LIGHT FIXTURES.
- 2. (A) REFER TO EA701 FOR LIGHT FIXTURE


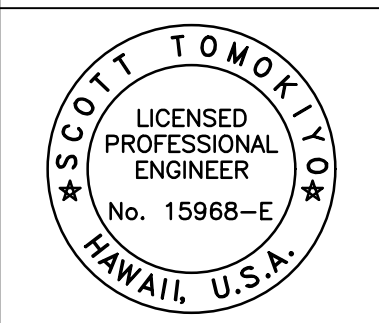


THIS WORK WAS PREPARED BY ME OR UNDER MY SUPERVISION
DATE: 4/30/2026
SIGNATURE: Scott Tomokiyo

SYN	DESCRIPTION	DATE	LT	APPR
1	ADDENDUM 1	3/24		

SUBMITTAL PHASE	CONSTRUCTION DOCUMENTS
SF	KR
ST	

STATE OF HAWAII
DEPARTMENT OF DEFENSE
DIAMOND HEAD STATE MONUMENT
4204 DIAMOND HEAD RD HONOLULU, HI 96816
TMK: 3-1-042:006
BIRKHIRMER EMERGENCY OPERATIONS CENTER (EOC) UPGRADES AND IMPROVEMENTS
LIGHTING PLAN
SCALE: AS NOTED
STATE JOB NO. CA-202313-C
FEDERAL PROJECT NO. -
SHEET 93 OF 123
EA106

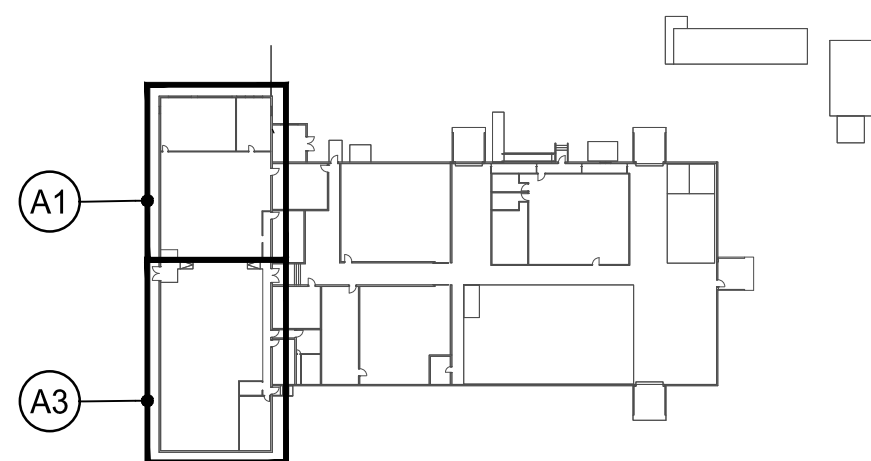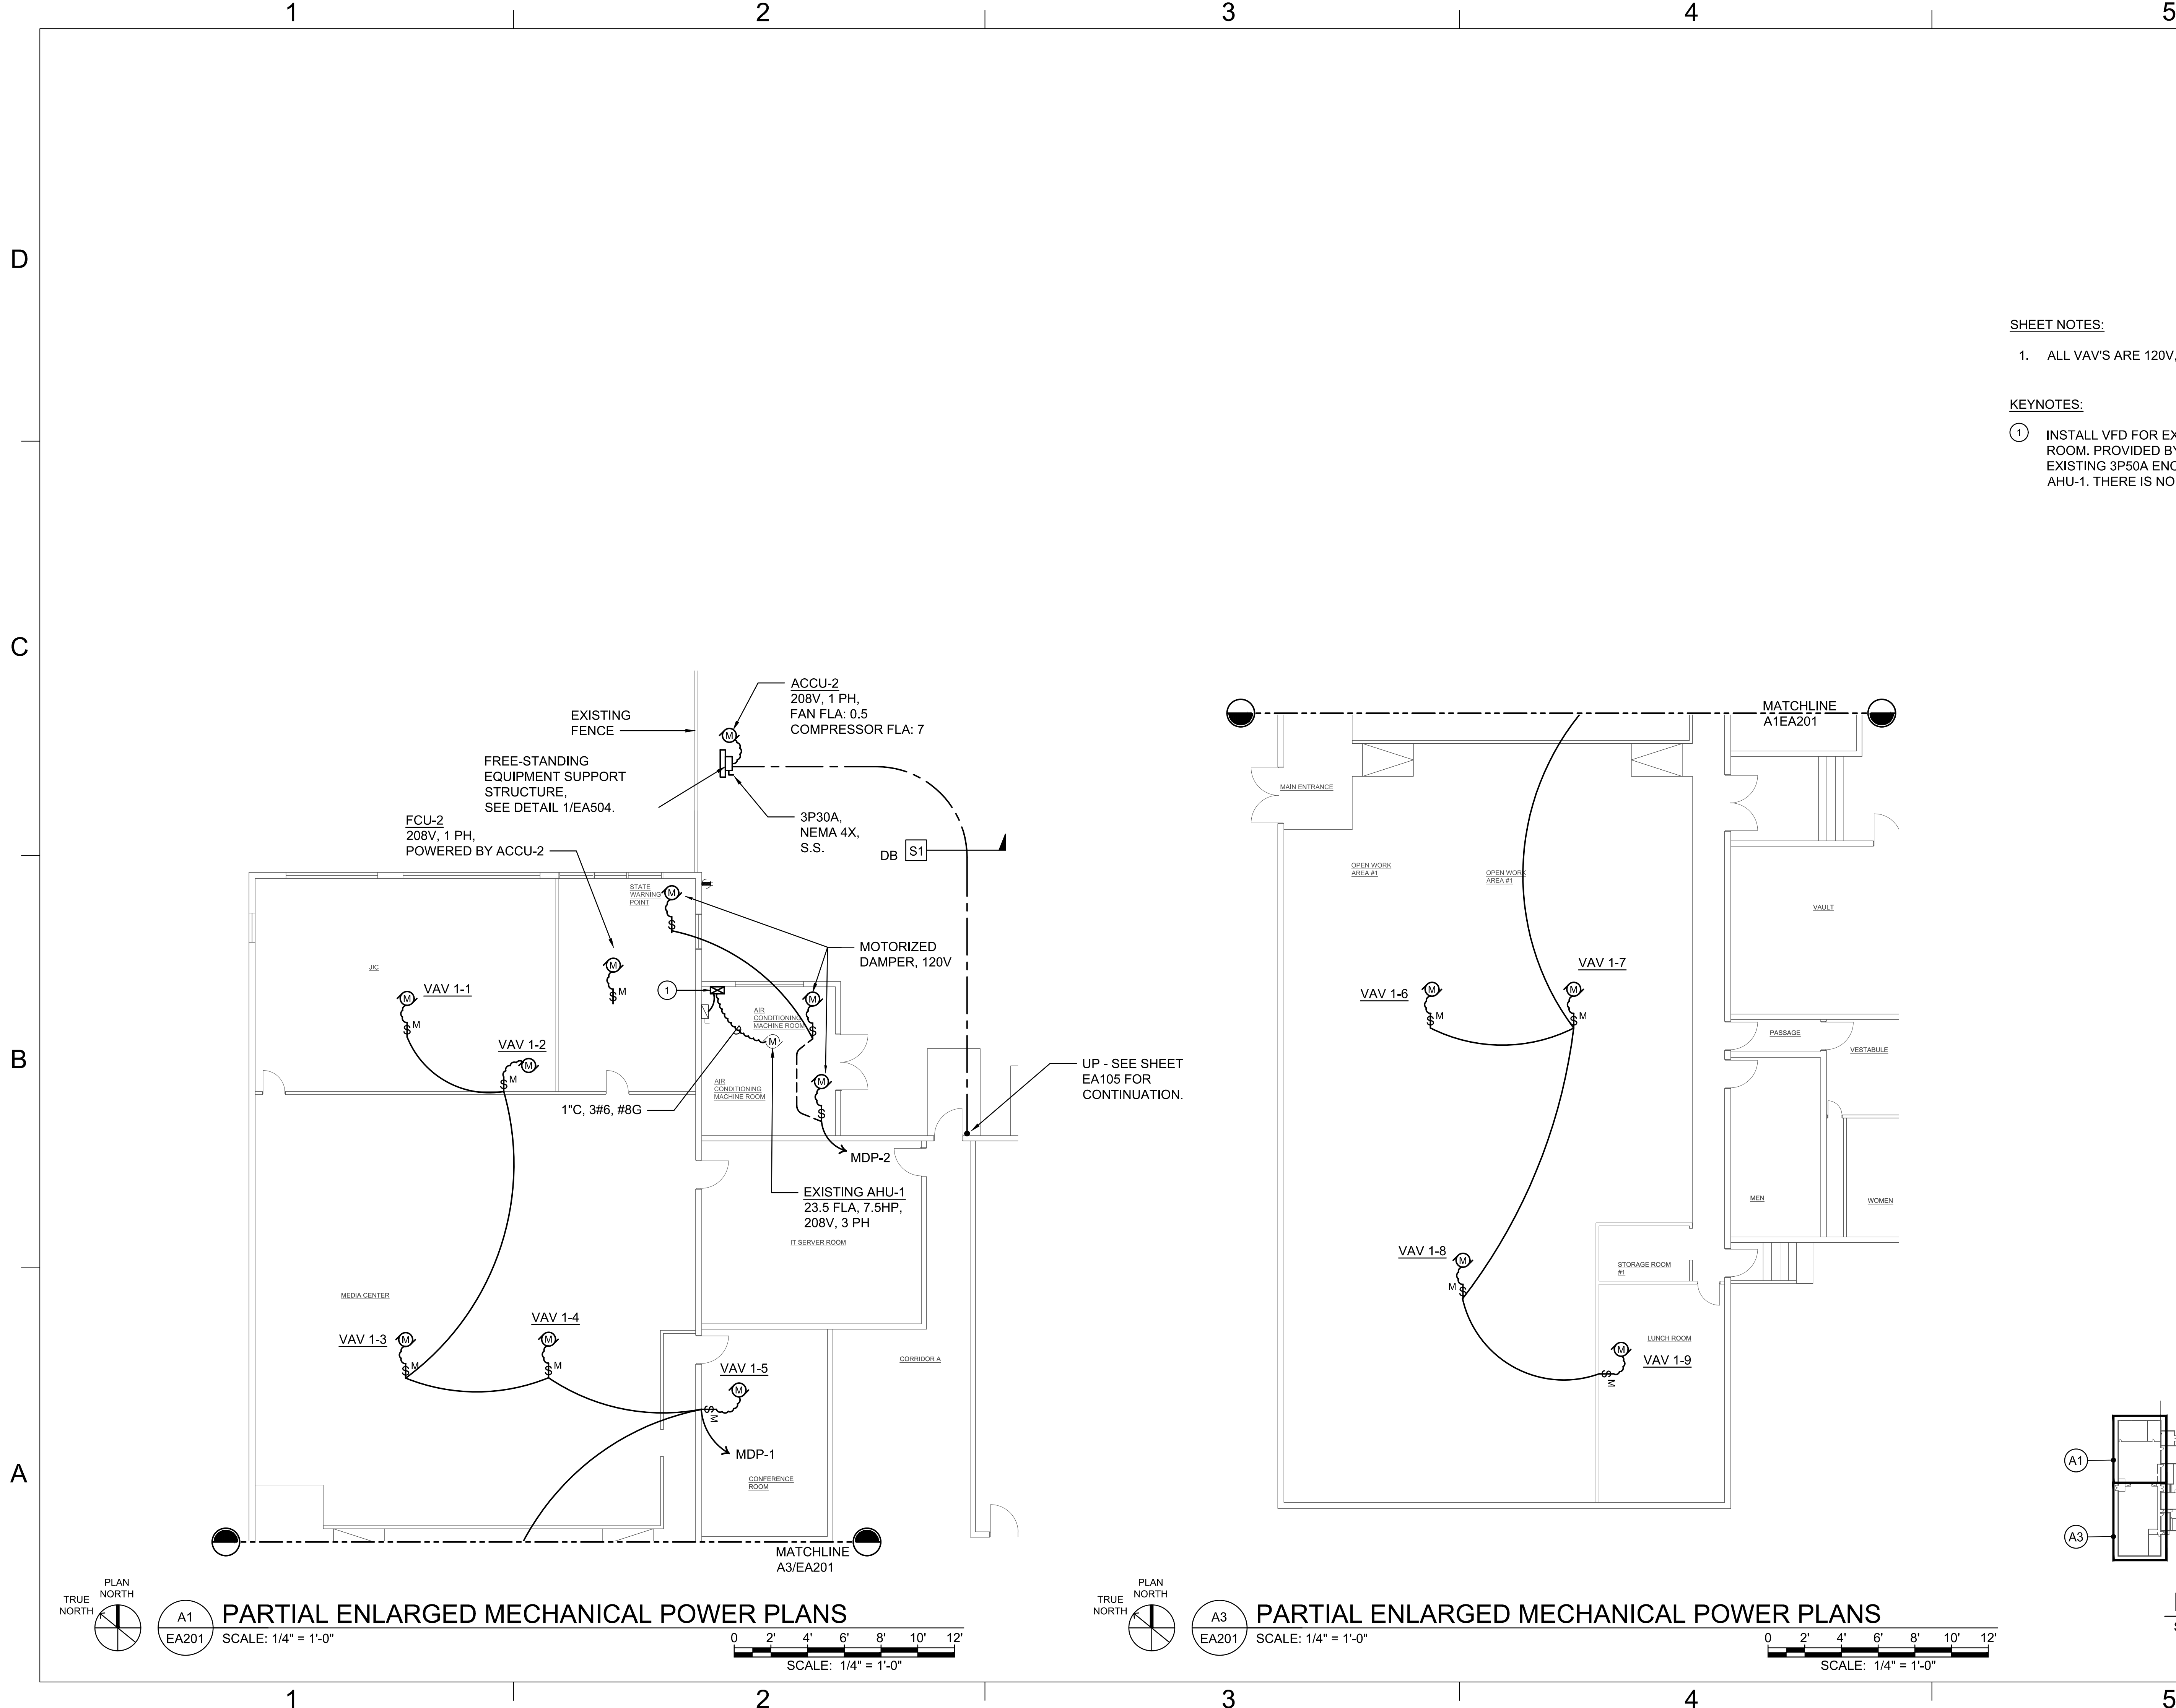

KEY PLAN


SCALE: NTS

SHEET NOTES:

1. ALL VAV'S ARE 120V, 1-PHASE

KEYNOTES

- ① INSTALL VFD FOR EXISTING AHU-1 IN THE SAME ROOM. PROVIDED BY MECHANICAL. REUSE EXISTING 3P50A ENCLOSED BREAKER FOR AHU-1. THERE IS NO EXISTING STARTER

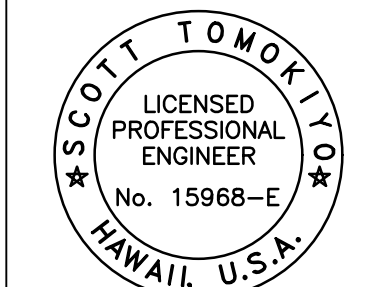

THIS WORK WAS PREPARED BY ME
OR UNDER MY SUPERVISION
Scott Tompkins 4/30/2026
SIGNATURE EXPIRATION DATE

[illegible]

SUBMITTAL PHASE
CONSTRUCTION
DOCUMENTS

SUBMITTAL DATE		03/01/2024
SF	KR	ST

STATE OF HAWAII	DIAMOND HEAD STATE MONUMENT	DEPARTMENT OF DEFENSE
4204 DIAMOND HEAD RD HONOLULU, HI 96816	TMK: 3-1-042:006	
BIRKHMIR EMERGENCY OPERATIONS CENTER (EOC) UPGRADES AND IMPROVEMENTS		
PARTIAL ENLARGED MECH POWER PLANS		

SCALE:	AS NOTED	
STATE JOB NO.	CA-202313-C	
FEDERAL PROJECT NO.	-	
SHEET	94 OF	123
EA201		

1

2

3

4



5

D

C

B


A

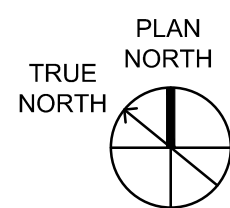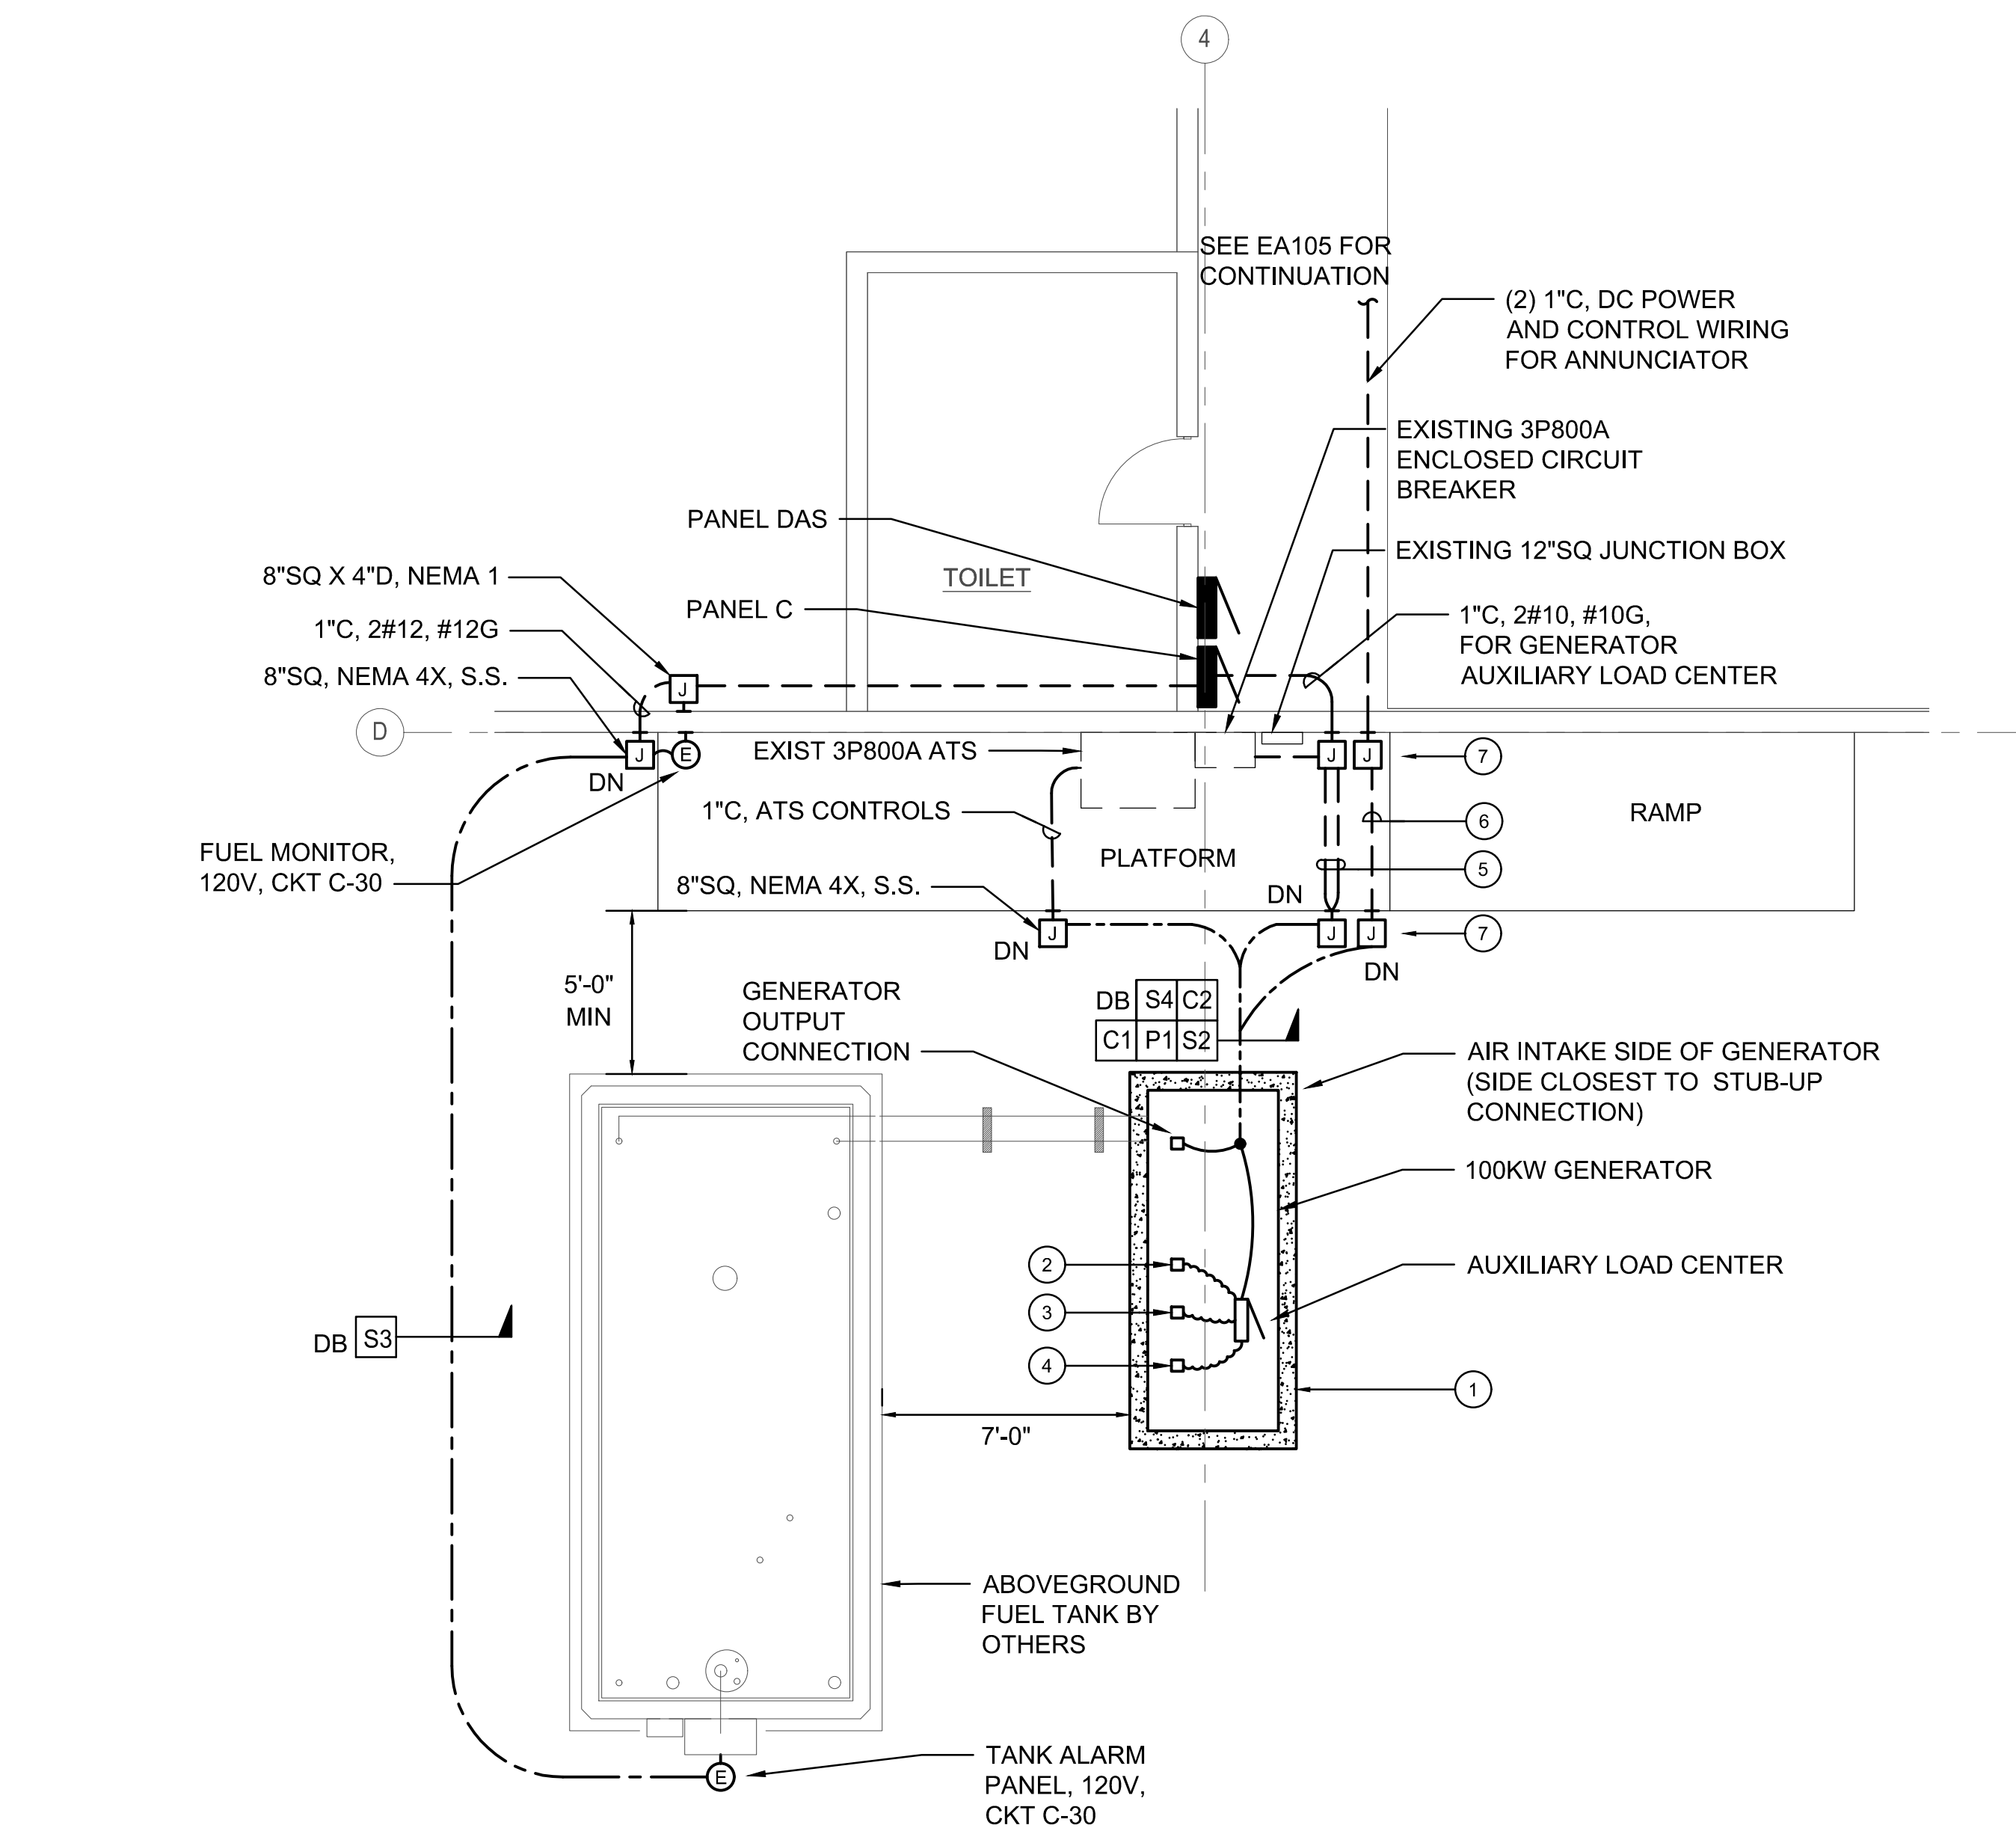

A3
EA202

ENLARGED GENERATOR POWER PLAN

SCALE: 1/4" = 1'-0"

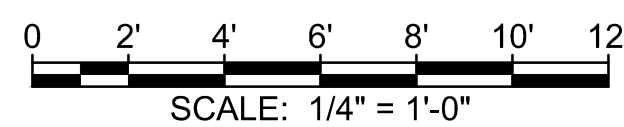


SHEET NOTES:

1. CONDUITS ON THE PLATFORM FLOOR SHALL BE MOUNTED ON PYRAMID SUPPORT BLOCKS.

KEYNOTES:

- 1 CONCRETE PAD, APPROXIMATELY 120"L X 50"W. COORDINATE WITH ACTUAL SIZE OF GENERATOR ENCLOSURE. CONCRETE PAD SHALL EXTEND 6" ON ALL SIDES OF THE GENERATOR ENCLOSURE. SEE STRUCTURAL DRAWINGS FOR CONCRETE PAD DETAIL.
- 2 JACKET WATER HEATER, 120V, 3/4"C, 2#10, 1#10G
- 3 BATTERY CHARGER, 120V, 3/4"C, 2#10, 1#10G
- 4 SPACE HEATER, 120V, 3/4"C, 2#10, 1#10G
- 5 4"C, 4-500KCML, #2G, FOR GENERATOR OUTPUT
1"C, 2#10, #10G, FOR GENERATOR AUXILIARY LOAD CENTER
- 6 1"C, CONTROLS FOR ANNUNCIATOR
1"C, DC POWER FOR ANNUNCIATOR
- 7 (1) 32"SQ X 8"D, NEMA 4X, S.S. JUNCTION BOX FOR POWER CONDUCTORS AND (1) 8"SQ, NEMA 4X, S.S., JUNCTION BOX FOR THE ANNUNCIATOR DC POWER AND CONTROLS.

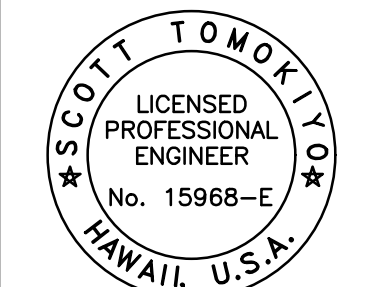

THIS WORK WAS PREPARED BY ME OR UNDER MY SUPERVISION
4/30/2026

SIGNATURE EXPIRATION DATE

DATE

DATE

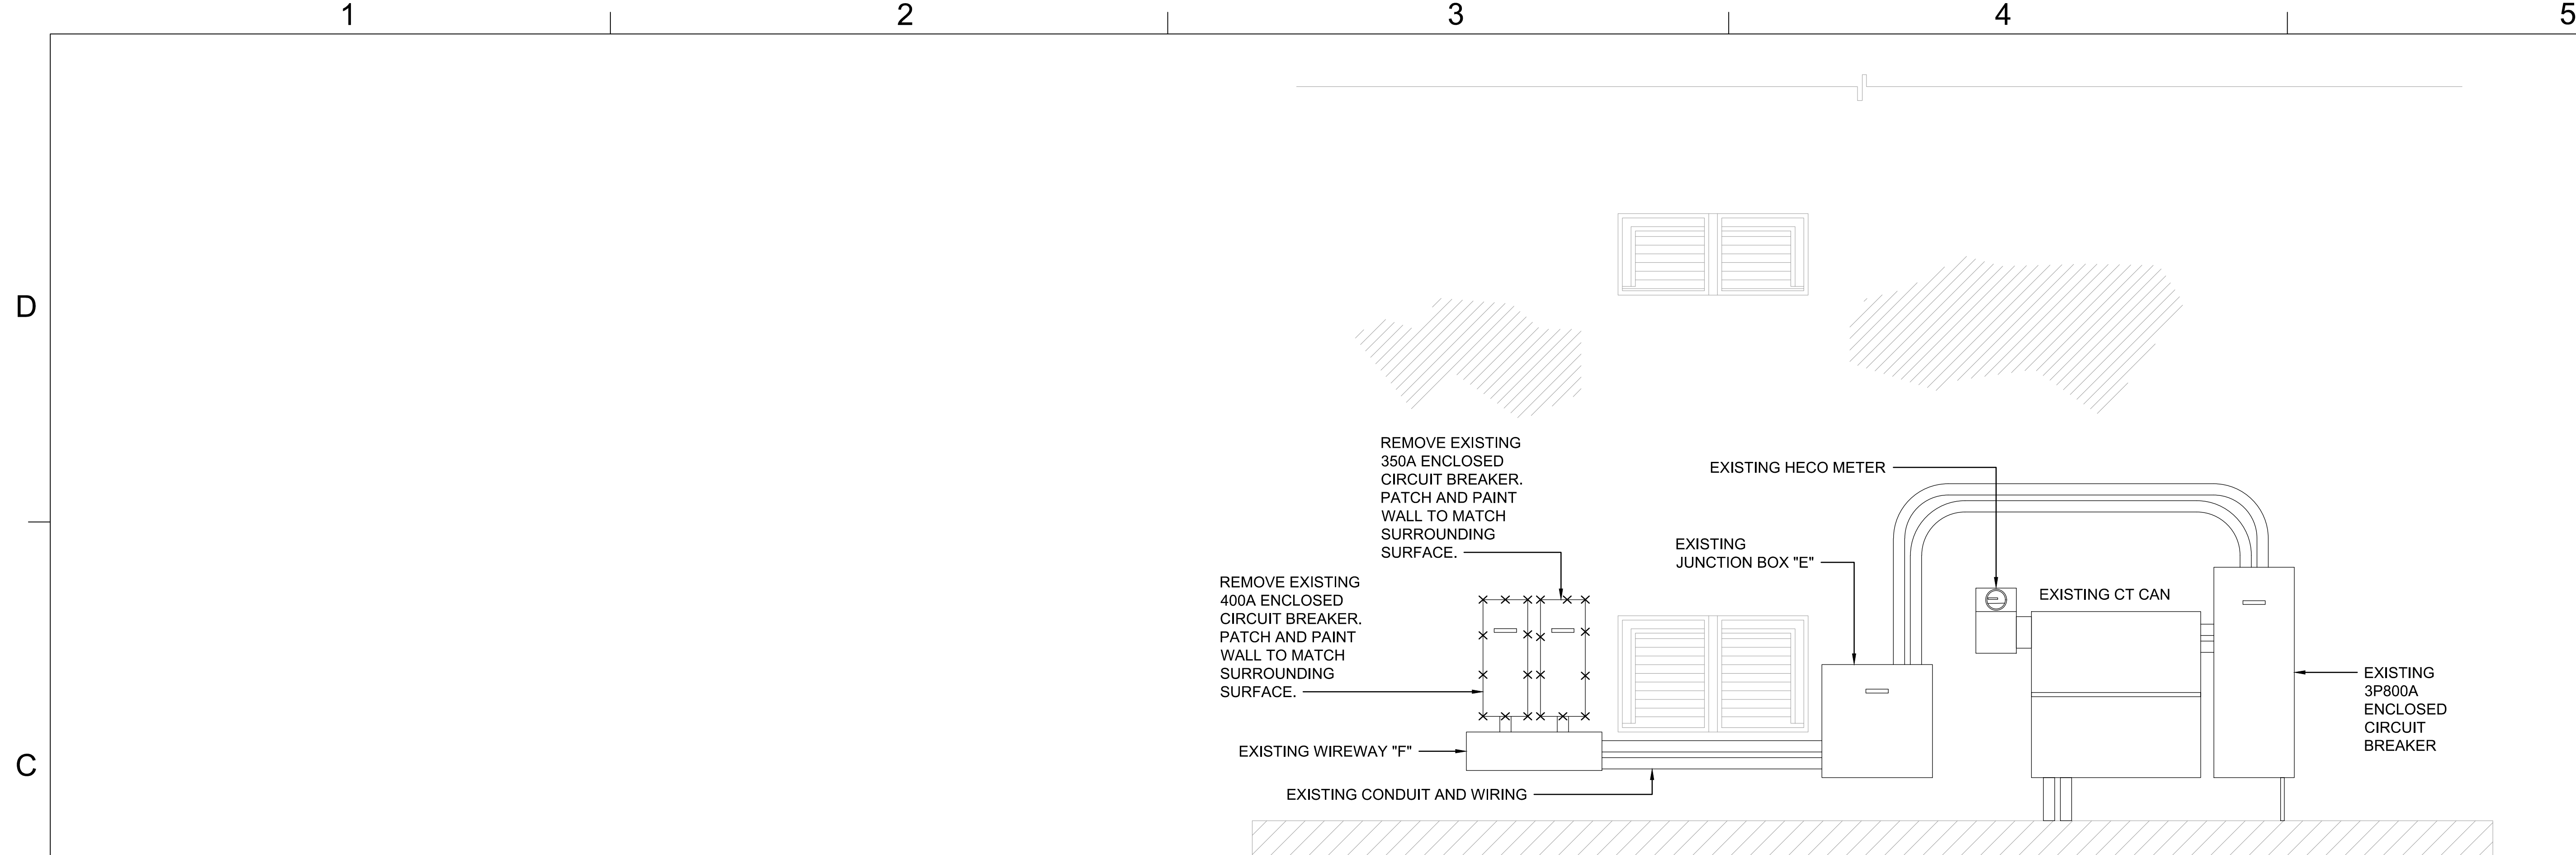

C3 ELECTRICAL SERVICE ELEVATION - DEMO

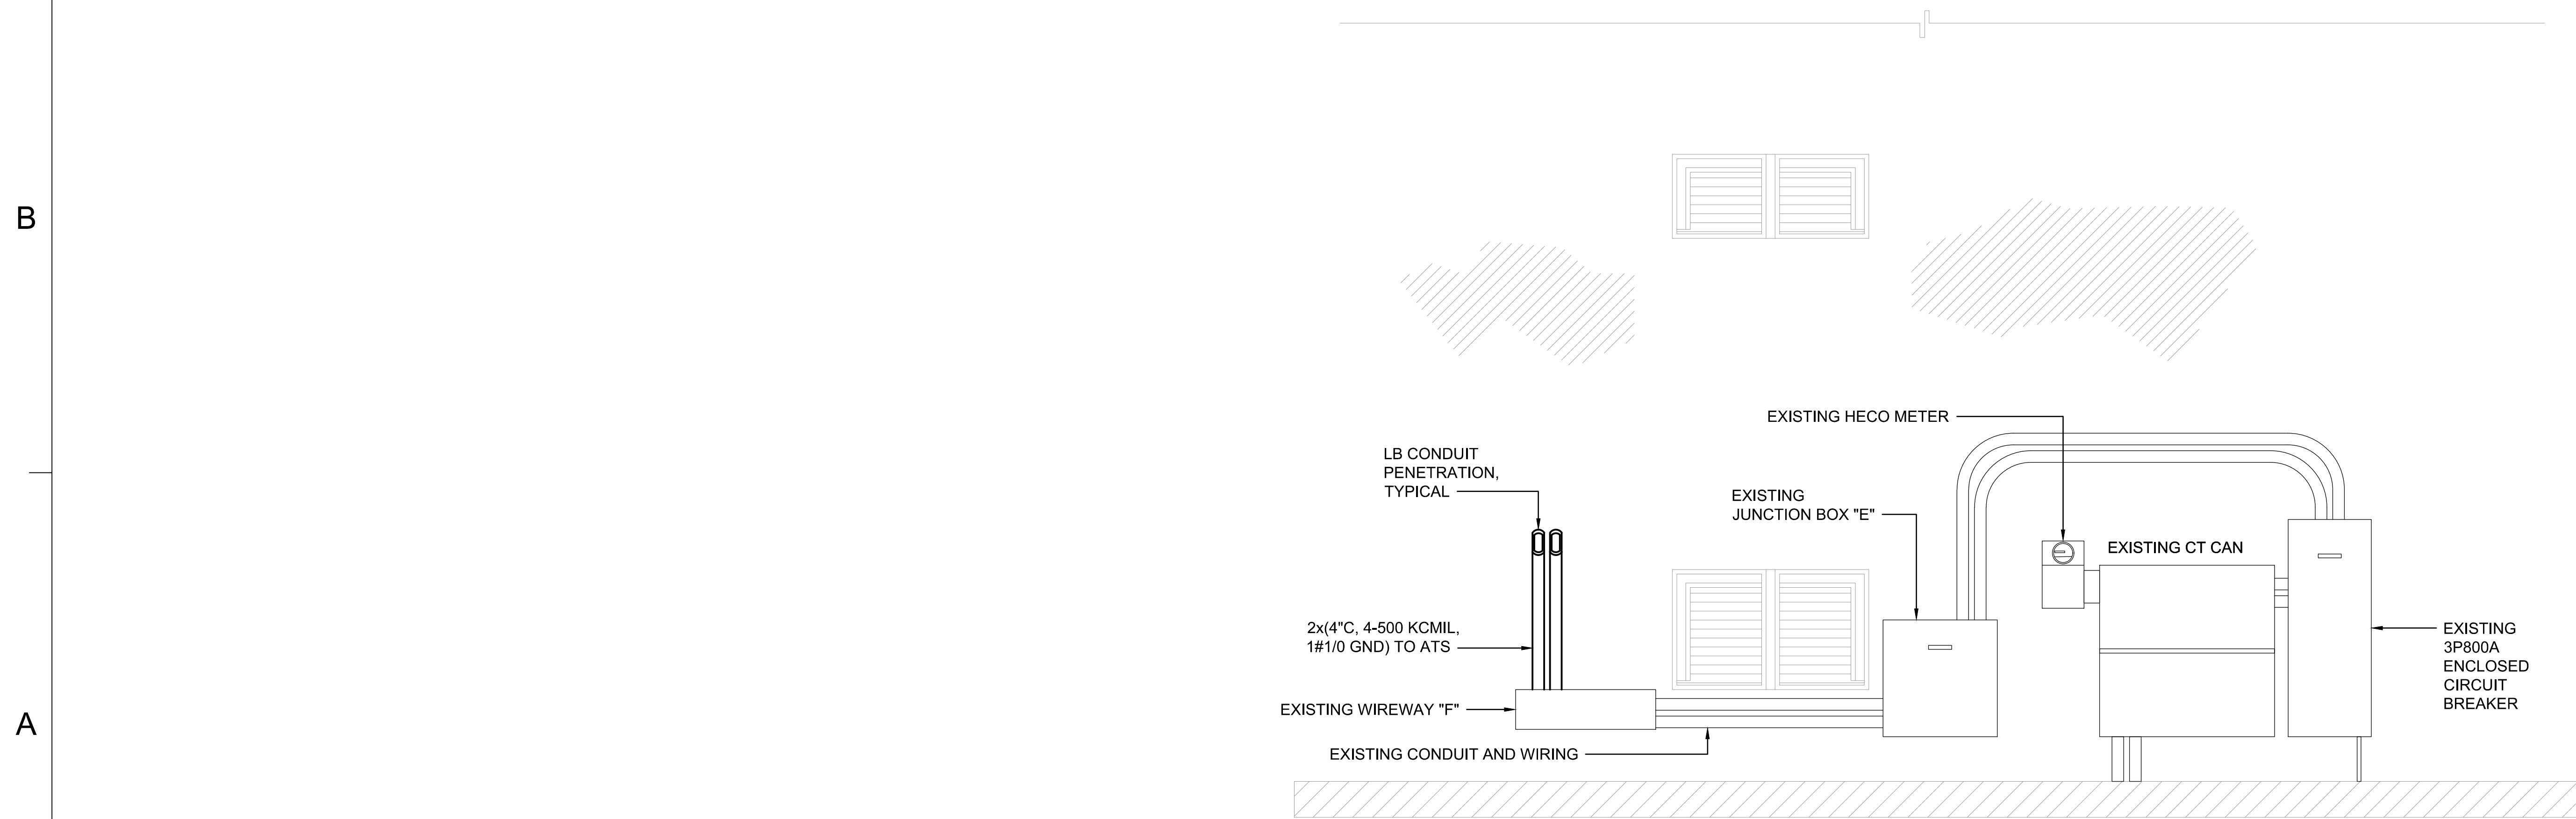

ELECTRICAL SERVICE ELEVATION

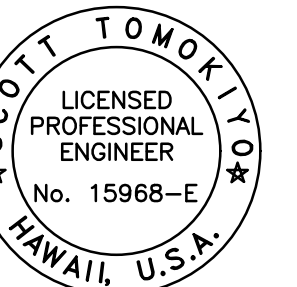

THIS WORK WAS PREPARED BY ME
UNDER MY SUPERVISION
SIGNATURE EXPIRATION DATE

[illegible][illegible]

SUBMITTAL DATE		03/01/2024
SF	KR	ST

TMK: 3-1-042:006	ER (EOC)
------------------	----------

DIAMOND HEAD STATE MONUMENT

4204 DIAMOND HEAD RD HONOLULU, HI 96816

**BIRKHYMER EMERGENCY OPERATIONS CENTER
UPGRADES AND IMPROVEMENTS**

ELECTRICAL ELEVATION DETAILS

SCALE:	AS NOTED
--------	----------

---------------	-------------

FEDERAL PROJECT NO.

SHEET 96 OF 123

EA501


A

A

C4 EA503 TYPICAL DIRECT BURIED DUCT SECTION SCALE: NTS

A2 LIGHT POLE DETAIL
EA503 SCALE: NTS



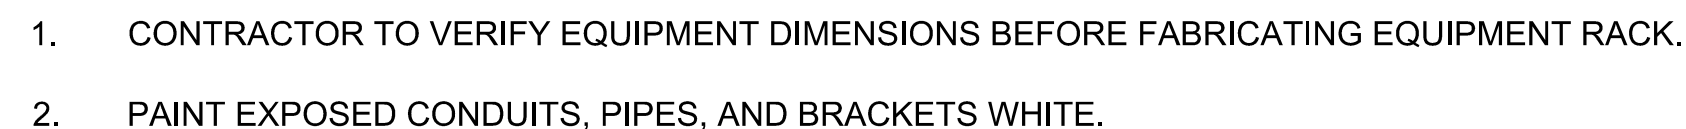


NEW PANEL MOUNTED ON EXISTING FLUSH PANEL DETAIL


SCALE: NTS



TYPICAL HANGER SUPPORT DETAIL

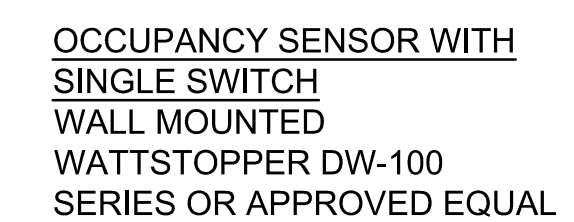

5) SCALE: NTS

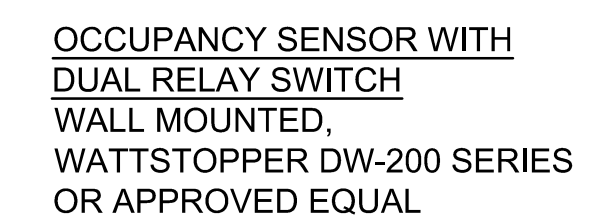



5) SCALE: NTS



1. PROVIDE NUMBER OF ROOM CONTROLLERS, OCCUPANCY SENSORS, AND LOW VOLTAGE SWITCHES AS REQUIRED FOR EACH SPACE FOR A COMPLETE AND OPERATIONAL SYSTEM.
2. ALL CABLING SHALL BE INSTALLED IN CONDUIT. MINIMUM CONDUIT SIZE SHALL BE 3/4".

SCALE: NTS

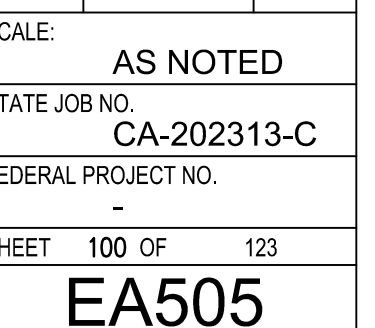

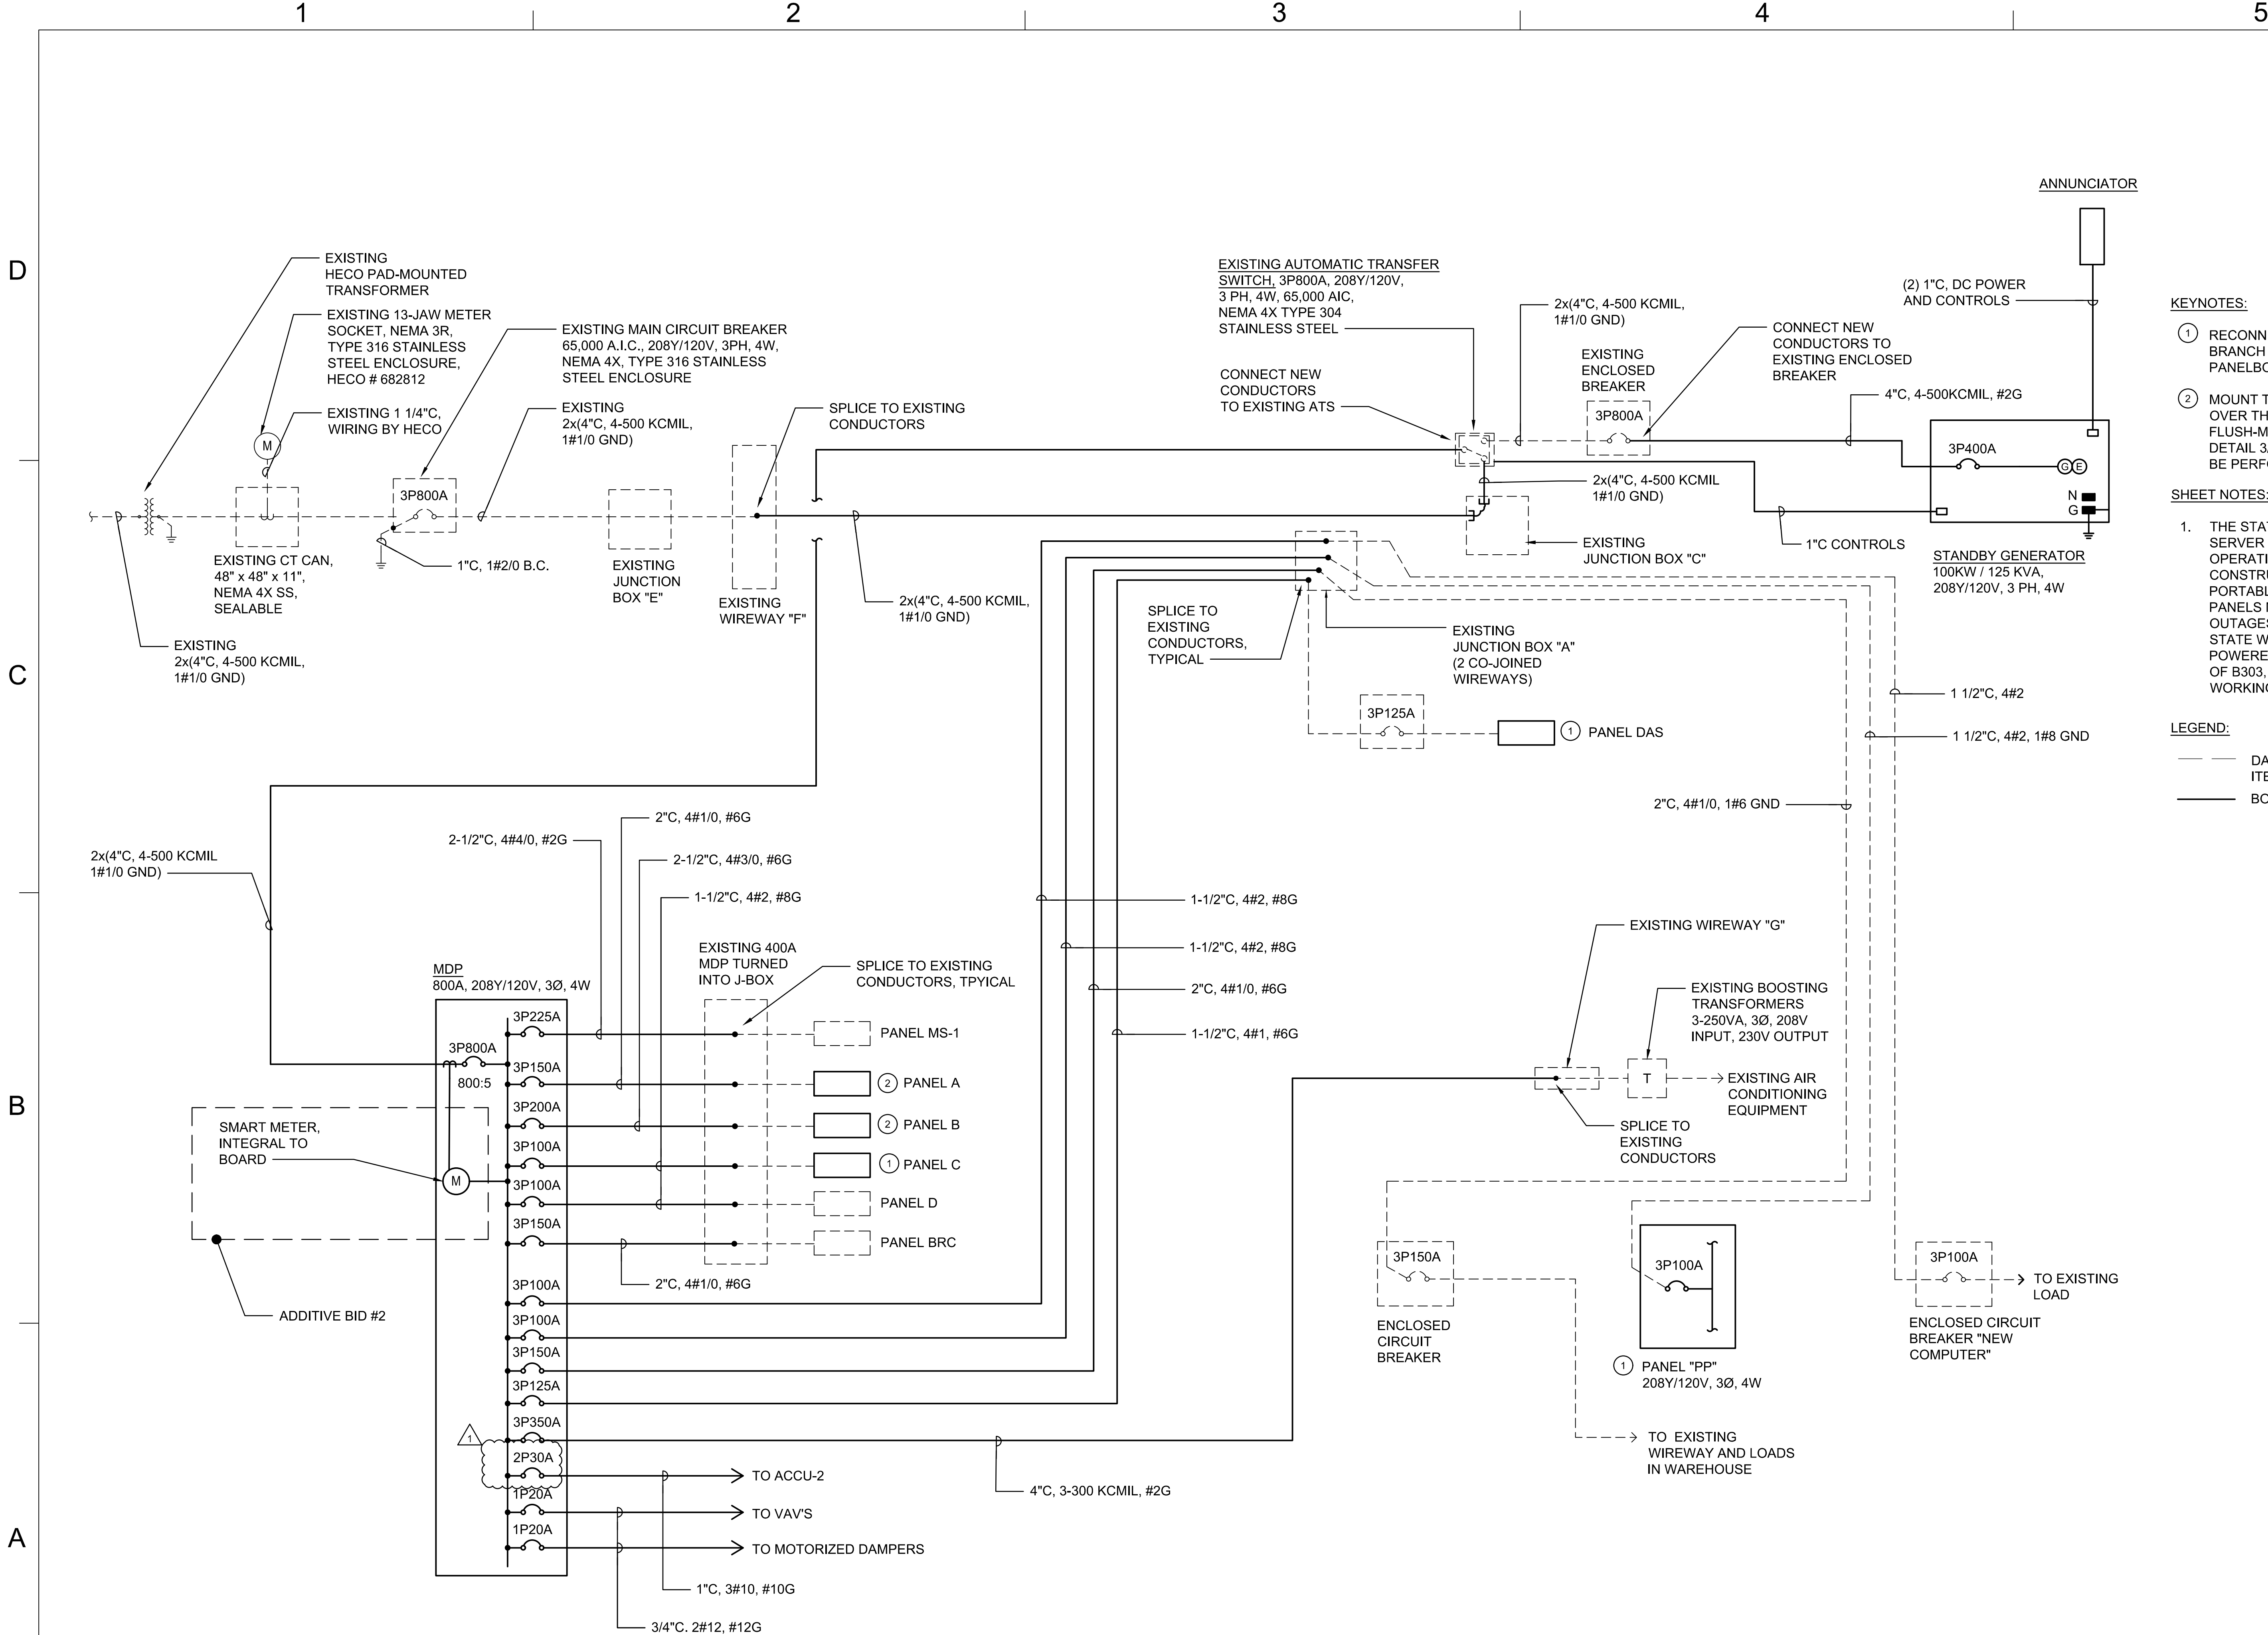


- KEYNOTES:**
- 1 RECONNECT EXISTING FEEDER AND BRANCH CIRCUITS TO NEW PANELBOARD.
 - 2 MOUNT THE NEW PANELBOARD DIRECTLY OVER THE GUTTED OUT EXISTING FLUSH-MOUNTED PANELBOARD. SEE DETAIL 3/E-504 FOR REQUIRED WORK TO BE PERFORMED.
- SHEET NOTES:**
1. THE STATE WARNING POINT ROOM AND IT SERVER ROOM SHALL REMAIN OPERATIONAL THROUGHOUT THE ENTIRE CONSTRUCTION PERIOD. PROVIDE A PORTABLE GENERATOR TO POWER PANELS MS-1, CDS-1, AND IT-1 DURING ANY OUTAGES. THE FLOOR OUTLETS IN THE STATE WARNING POINT ROOM ARE POWERED BY PANEL MS-1. FOR THE REST OF B303, OUTAGES ARE LIMITED TO AFTER WORKING HOURS AND THE WEEKEND.

LEGEND:

— DASHED LINE INDICATES EXISTING ITEM

— BOLD LINE INDICATES NEW WORK

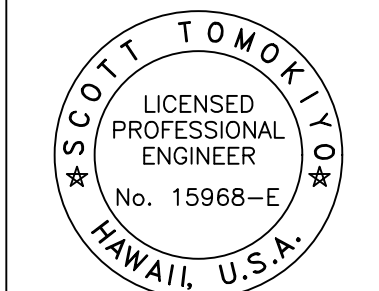

THIS WORK WAS PREPARED BY ME OR UNDER MY SUPERVISION
DATE: 4/30/2026
SIGNATURE: Scott Tomokiyo EXPIRATION DATE

SYN		DESCRIPTION	DATE	APPR.
1	ADDENDUM 1		3/24	SF

SUBMITTAL PHASE		CONSTRUCTION DOCUMENTS	DATE	APPR.
SF	KR	ST	03/01/2024	

STATE OF HAWAII	DEPARTMENT OF DEFENSE	DIAMOND HEAD STATE MONUMENT	TMK: 3-1-042:006	4204 DIAMOND HEAD RD HONOLULU, HI 96816
BIRKHAMER EMERGENCY OPERATIONS CENTER (EOC) UPGRADES AND IMPROVEMENTS				
ONE-LINE DIAGRAM				

SCALE:	AS NOTED
STATE JOB NO.	CA-202313-C
FEDERAL PROJECT NO.	-
SHEET	102 OF 123
EA602	

D

C


B

A

[illegible]

LIGHTING CONTROLS SCHEDULE							
ROOM NO. / ID	ROOM NAME	LOW VOLTAGE	SWITCH TYPE	RECEPTACLE CONTROL	LIGHTING CONTROL REQUIREMENTS	CONTROL DIAGRAM REFERENCE	KEYPAD DETAIL REFERENCE
	JIC OFFICE	YES	2-BUTTON WALL SWITCH + ROOM CONTROLLER + OCCUPANCY SENSOR	NO	AUTOMATIC ON FOR 50% OF LIGHTS MANUAL ON FOR REMAINDER OF LIGHTS AUTOMATIC OFF AFTER 20 MINUTES OF INACTIVITY	A1/EA505	
	STATE WARNING POINT	NO	MANUAL TOGGLE	NO	MANUAL ON MANUAL OFF		
	MEDIA CENTER	YES	2-BUTTON WALL SWITCH + ROOM CONTROLLER + OCCUPANCY SENSOR	NO	AUTOMATIC ON FOR 50% OF LIGHTS MANUAL ON FOR REMAINDER OF LIGHTS AUTOMATIC OFF AFTER 20 MINUTES OF INACTIVITY	A1/EA505	
	AIR CONDITIONING MACHINE ROOM	NO	MANUAL TOGGLE	NO	MANUAL ON MANUAL OFF		
	IT SERVER ROOM	NO	MANUAL TOGGLE	NO	MANUAL ON MANUAL OFF		
	CONFERENCE ROOM	YES	3-BUTTON KEYPAD + OCCUPANCY SENSOR	NO	BUTTON #1 - MANUAL ON FOR 100% OF LIGHTS BUTTON #2 - AV MODE (ALL LIGHTS DIMMED TO 10%) BUTTON #3 - MANUAL ALL OFF AUTOMATIC OFF AFTER 20 MINUTES OF INACTIVITY	A1/EA505	
	OPEN WORK AREA #1	YES	2-BUTTON WALL SWITCH + ROOM CONTROLLER + OCCUPANCY SENSOR	NO	AUTOMATIC ON FOR 50% OF LIGHTS MANUAL ON FOR REMAINDER OF LIGHTS AUTOMATIC OFF AFTER 20 MINUTES OF INACTIVITY	A1/EA505	
	PASSAGE	YES	2-BUTTON WALL SWITCH + OCCUPANCY SENSOR	NO	AUTOMATIC ON FOR 100% OF LIGHTS (SAFETY) AUTOMATIC OFF AFTER 20 MINUTES OF INACTIVITY	A3/EA505	
	VESTABULE	YES	2-BUTTON WALL SWITCH + OCCUPANCY SENSOR	NO	AUTOMATIC ON FOR 100% OF LIGHTS (SAFETY) AUTOMATIC OFF AFTER 20 MINUTES OF INACTIVITY	A3/EA505	
	MEN RESTROOM	YES	1-BUTTON WALL SWITCH + OCCUPANCY SENSOR	NO	AUTOMATIC ON FOR 100% OF LIGHTS (SAFETY) AUTOMATIC OFF AFTER 20 MINUTES OF INACTIVITY	A3/EA505	
	WOMEN RESTROOM	YES	1-BUTTON WALL SWITCH + OCCUPANCY SENSOR	NO	AUTOMATIC ON FOR 100% OF LIGHTS (SAFETY) AUTOMATIC OFF AFTER 20 MINUTES OF INACTIVITY	A3/EA505	

LIGHTING CONTROLS SCHEDULE							
ROOM NO. / ID	ROOM NAME	LOW VOLTAGE	SWITCH TYPE	RECEPTACLE CONTROL	LIGHTING CONTROL REQUIREMENTS	CONTROL DIAGRAM REFERENCE	KEYPAD DETAIL REFERENCE
	STORAGE ROOM #1	NO	WALLBOX OCCUPANCY SENSOR WITH DUAL SWITCHES/RELAYS	NO	AUTOMATIC ON FOR 50% OF LIGHTS MANUAL ON FOR REMAINDER OF LIGHTS AUTOMATIC OFF AFTER 20 MINUTES OF INACTIVITY	A5/EA505	
	STORAGE ROOM #2	NO	WALLBOX OCCUPANCY SENSOR WITH DUAL SWITCHES/RELAYS	NO	AUTOMATIC ON FOR 50% OF LIGHTS MANUAL ON FOR REMAINDER OF LIGHTS AUTOMATIC OFF AFTER 20 MINUTES OF INACTIVITY	A5/EA505	
	LUNCH ROOM	NO	2-BUTTON WALL SWITCH + ROOM CONTROLLER + OCCUPANCY SENSOR	NO	AUTOMATIC ON FOR 50% OF LIGHTS MANUAL ON FOR REMAINDER OF LIGHTS AUTOMATIC OFF AFTER 20 MINUTES OF INACTIVITY	A1/EA505	
	WAREHOUSE AREA #1, #2, #3, #4	NO	2-BUTTON WALL SWITCH + OCCUPANCY SENSOR	NO	AUTOMATIC ON FOR 100% OF LIGHTS DIM TO 20% AFTER 5 MINUTES OF INACTIVITY AUTOMATIC OFF AFTER 20 MINUTES OF INACTIVITY	A1/EA505	
	OFFICE #1, #2, #3	YES	2-BUTTON WALL SWITCH + ROOM CONTROLLER + OCCUPANCY SENSOR	NO	AUTOMATIC ON FOR 50% OF LIGHTS MANUAL ON FOR REMAINDER OF LIGHTS AUTOMATIC OFF AFTER 20 MINUTES OF INACTIVITY	A3/EA505	
	CORRIDOR A, B, C, D	NO	2-BUTTON WALL SWITCH + OCCUPANCY SENSOR	NO	AUTOMATIC ON FOR 100% OF LIGHTS DIM TO 20% AFTER 5 MINUTES OF INACTIVITY AUTOMATIC OFF AFTER 20 MINUTES OF INACTIVITY	A3/EA505	

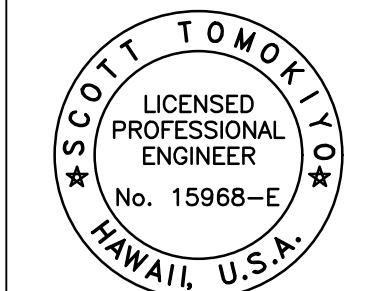

THIS WORK WAS PREPARED BY ME
OR UNDER MY SUPERVISION
Scott Tompkins 4/30/2026
SIGNATURE EXPIRATION DATE

[illegible][illegible]

SUBMITTAL DATE			03/01/2024
SF	KR	ST	

DEPARTMENT OF DEFENSE
TMK: 3-1-042:006
ER (EOC)

DIAMOND HEAD STATE MONUMENT

STATE OF HAWAII

SCALE: AS NOTED

STATE JOB NO. CA 203313 C

CA-202313-C
FEDERAL PROJECT NO.

SHEET 103 OF 123

EA701

D

C

B

A

PANELBOARD: NEW C																				
LOCATION: CORRIDOR								VOLTS: 208Y/120				A.I.C RATING: 10,000								
SUPPLY FROM: MDP								PHASES: 3				MAINS TYPE: MCB								
MOUNTING: SURFACE								WIRES: 4				BUS RATING: 225								
ENCLOSURE: NEMA 1								CABINET WIDTH: 20"				MCB RATING: 100								
GND	WIRE	CKT	CIRCUIT DESCRIPTION	ID	TRIP	POLES	A		B		C		POLES	TRIP	ID	CIRCUIT DESCRIPTION	CKT	WIRE	GND	
-	-	1	O - EXISTING LOAD		20	1	0.7	0.7					1	20		O - EXISTING LOAD	2	-	-	
-	-	3	O - EXISTING LOAD		20	1			0.7	0.7			1	20		O - EXISTING LOAD	4	-	-	
-	-	5	O - EXISTING LOAD		20	1					0.7	0.7	1	20		O - EXISTING LOAD	6	-	-	
-	-	7	O - EXISTING LOAD		20	1	0.7	0.7					1	20		O - EXISTING LOAD	8	-	-	
-	-	9	O - FIRE ALARM	L	20	1			0.7	0.7			1	20		O - EXISTING LOAD	10	-	-	
-	-	11	O - EXISTING LOAD		20	1					0.7	0.7	1	20		O - EXISTING LOAD	12	-	-	
-	-	13	O - EXISTING LOAD		20	1	0.7	0.7					1	20		O - EXISTING LOAD	14	-	-	
-	-	15	O - EXISTING LOAD		20	1			0.7	0.7			1	20		O - EXISTING LOAD	16	-	-	
-	-	17	O - EXISTING LOAD		20	1					0.7	0.7	1	20		O - EXISTING LOAD	18	-	-	
-	-	19	O - EXISTING LOAD		20	1	0.7	0.7					1	20		O - EXISTING LOAD	20	-	-	
-	-	21	O - EXISTING LOAD		20	1			0.7	0.7			1	20		O - EXISTING LOAD	22	-	-	
-	-	23	O - EXISTING LOAD		20	1					0.7	0.7	1	20		O - EXISTING LOAD	24	-	-	
-	-	25	O - EXISTING LOAD		20	1	0.7	0.7					1	20		O - EXISTING LOAD	26	-	-	
-	-	27	O - EXISTING LOAD		20	1			0.7	0.7			1	20		O - EXISTING LOAD	28	-	-	
-	-	29	O - EXISTING LOAD		20	1					0.7	0.4	1	20		O - TANK ALARM PANEL	30	12	12	
-	-	31	O - EXISTING LOAD		20	1	0.7	0.0					1	20		SPARE	32	-	-	
10	10	33	O - GENERATOR AUX PANEL		30	1			1.2	0.0			1	20		SPARE	34	-	-	
-	-	35	SPARE		20	1					0.0	0.0	1	20		SPARE	36	-	-	
-	-	37	SPARE		20	1	0.0	0.0					1	20		SPARE	38	-	-	
-	-	39	SPARE		20	1			0.0	0.0			1	20		SPARE	40	-	-	
-	-	41	SPARE		20	1					0.0	0.0	1	20		SPARE	42	-	-	
TOTAL LOAD:					7.7 KVA			8.2 KVA			6.7 KVA									
TOTAL AMPS:					21.4 A			22.8 A			18.6 A									
ID LEGEND: *L DENOTES LOCKABLE BREAKER ACCESSORY																				
LOAD CLASSIFICATION			CONNECTED LOAD		DEMAND FACTOR		DEMAND LOAD		PANEL TOTALS											
LIGHTING			0.0 KVA		100.0%		0.0 KVA													
RECEPTACLES			0.0 KVA		#DIV/0!		0.0 KVA		TOTAL CONNECTED LOAD:										22.6 KVA	
HVAC			0.0 KVA		100.0%		0.0 KVA		TOTAL DEMAND LOAD:										22.6 KVA	
MOTOR LOAD			0.0 KVA		100.0%		0.0 KVA		TOTAL CONNECTED CURRENT:										62.7 A	
FIRE ALARM			0.0 KVA		100.0%		0.0 KVA		TOTAL DEMAND CURRENT:										62.7 A	
KITCHEN EQUIPMENT			0.0 KVA		65.0%		0.0 KVA													
OTHER LOADS			22.6 KVA		100.0%		22.6 KVA													
NOTES:																				
1. REPLACES EXISTING PANEL C. FIELD VERIFY EXISTING BREAKER SIZES. NEW BREAKER SHALL MATCH EXISTING.																				
2. BOLD INDICATES NEW CIRCUITING ADDED TO THE PANEL.																				

PANELBOARD: NEW DAS

LOCATION: CORRIDOR

SUPPLY FROM: MDP

MOUNTING: SURFACE

ENCLOSURE: NEMA 1

VOLTS: 208Y/120

PHASES: 3

WIRES: 4

CABINET WIDTH: 20"

A.I.C RATING: 10,000

MAINS TYPE: MLO

BUS RATING: 125

MCB RATING: N/A

WIRE	CKT	CIRCUIT DESCRIPTION	ID	TRIP	POLES	A	B	C	POLES	TRIP	ID	CIRCUIT DESCRIPTION	CKT	WIRE	GND	
-	1	L - OFFICE LIGHTS	20	1		1.0	1.0		1	20		R - RECEIPT	2	-	-	
-	3	R - REFRIGERATOR	20	1			1.0	1.0	1	20		H - AC MAUKA	4	-	-	
-	5	L - WAREHOUSE LTS	20	1				1.0	1.0	1	20	R - RECEPT	6	-	-	
-	7	L - WAREHOUSE LTS	20	1	1.0	1.0			1	20		H - AC - MAKAI	8	-	-	
-	9	L - NIGHT LIGHTS	20	1			1.0	1.0	1	20		R - PLUGS	10	-	-	
-	11	R - PLUGS	20	1				1.0	1.0	1	20	H - AC UNIT NEW OFFICE	12	-	-	
-	13	SPARE	20	1	0.0	0.0			1	20		SPARE	14	-	-	
-	15	SPARE	20	1			0.0	0.0	1	20		SPARE	16	-	-	
-	17	SPARE	20	1				0.0	0.0	1	20	SPARE	18	-	-	
TOTAL LOAD:						4.0 KVA	4.0 KVA	4.0 KVA								
TOTAL AMPS:						11.1 A	11.1 A	11.1 A								
ID LEGEND:																
CLASSIFICATION			CONNECTED LOAD		DEMAND FACTOR		DEMAND LOAD		PANEL TOTALS							
LIGHTING			4.0 KVA		100.0%		4.0 KVA									
RECEPTACLES			5.0 KVA		100.0%		5.0 KVA		TOTAL CONNECTED LOAD:				12.0 KVA			
			3.0 KVA		100.0%		3.0 KVA		TOTAL DEMAND LOAD:				12.0 KVA			
MOTOR LOAD			0.0 KVA		100.0%		0.0 KVA		TOTAL CONNECTED CURRENT:				33.3 A			
FIRE ALARM			0.0 KVA		100.0%		0.0 KVA		TOTAL DEMAND CURRENT:				33.3 A			
KITCHEN EQUIPMENT			0.0 KVA		65.0%		0.0 KVA									
OTHER LOADS			0.0 KVA		100.0%		0.0 KVA									
NOTES:																
1. REPLACES EXISTING PANEL DAS. FIELD VERIFY EXISTING BREAKER SIZES. NEW BREAKER SIZES SHALL MATCH EXISTING.																

PANELBOARD: NEW PP																		
LOCATION: WAREHOUSE AREA #1								VOLTS: 208Y/120				A.I.C RATING: 10,000						
SUPPLY FROM: MDP								PHASES: 3				MAINS TYPE: MCB						
MOUNTING: SURFACE								WIRES: 4				BUS RATING: 100						
ENCLOSURE: NEMA 1								CABINET WIDTH: 20"				MCB RATING: 100						
GND	WIRE	CKT	CIRCUIT DESCRIPTION	ID	TRIP	POLES	A	B	C	POLES	TRIP	ID	CIRCUIT DESCRIPTION	CKT	WIRE	GND		
-	-	1	PFB	-	-		0.0	0.0		-	-	-	PFB	2	-	-		
-	-	3	O - WATER COOLER	20	1			1.0	1.0		1	20	M - FUJITSU AC SUPPLY ROOM	4	-	-		
-	-	5	R - PLUG COM LINE	20	1				1.0	1.0	1	20	O - FAN	6	-	-		
-	-	7	O - EXISTING LOAD	20	1	1.0	0.0			-	-	-	PFB	8	-	-		
-	-	9	PFB	-	-			0.0	0.0	-	-	-	PFB	10	-	-		
-	-	11	PFB	-	-				0.0	1.0	2	-	O - EXISTING LOAD	12	-	-		
-	-	13	O - WATER HEATER	-	2	1.0	1.0			2	-	-	O - EXISTING LOAD	14	-	-		
-	-	15	O - WATER HEATER	-	2			1.0	0.2	1	20		O - WATER METER	16	12	12		
-	-	17	M - EXHAUST FAN	-	2				1.0	0.0	1	20	SPARE	18	-	-		
-	-	19	M - EXHAUST FAN	-	2	1.0	0.0			1	20		SPARE	20	-	-		
-	-	21	SPARE	20	1			0.0	0.0	1	20		SPARE	22	-	-		
-	-	23	SPARE	20	1				0.0	0.0	1	20	SPARE	24	-	-		
-	-	25	SPARE	20	1	0.0	0.0			1	20		SPARE	26	-	-		
-	-	27	SPARE	20	1			0.0	0.0	1	20		SPARE	28	-	-		
-	-	29	SPARE	20	1				0.0	0.0	1	20	SPARE	30	-	-		
				TOTAL LOAD:		4.0 KVA		3.2 KVA		4.0 KVA								
				TOTAL AMPS:		11.1 A		8.9 A		11.1 A								
ID LEGEND:																		
LOAD CLASSIFICATION			CONNECTED LOAD		DEMAND FACTOR		DEMAND LOAD			PANEL TOTALS								
LIGHTING			0.0 KVA		100.0%		0.0 KVA			TOTAL CONNECTED LOAD:							11.2 KVA	
RECEPTACLES			1.0 KVA		100.0%		1.0 KVA			TOTAL DEMAND LOAD:							11.2 KVA	
HVAC			0.0 KVA		100.0%		0.0 KVA			TOTAL CONNECTED CURRENT:							31.1 A	
MOTOR LOAD			3.0 KVA		100.0%		3.0 KVA			TOTAL DEMAND CURRENT:							31.1 A	
FIRE ALARM			0.0 KVA		100.0%		0.0 KVA											
KITCHEN EQUIPMENT			0.0 KVA		65.0%		0.0 KVA											
OTHER LOADS			7.2 KVA		100.0%		7.2 KVA											
NOTES:																		
1. FIELD VERIFY EXISTING BREAKER SIZES. NEW BREAKERS SHALL MATCH EXISTING.																		
2. REPLACES EXISTING PANEL PP.																		

D


C

B

A



PANELBOARD: NEW A																			
LOCATION: WAREHOUSE CORRIDOR							VOLTS: 208Y/120					A.I.C RATING: 10,000							
SUPPLY FROM: MDP							PHASES: 3					MAINS TYPE: MLO							
MOUNTING: SURFACE							WIRES: 4					BUS RATING: 225							
ENCLOSURE: NEMA 1							CABINET WIDTH: 20"					MCB RATING: N/A							
GND	WIRE	CKT	CIRCUIT DESCRIPTION	ID	TRIP	POLES	A		B		C		POLES	TRIP	ID	CIRCUIT DESCRIPTION	CKT	WIRE	GND
-	-	1	L - 1ST ROW LEFT	20	1		1.0	1.0					1	20		L - 3RD ROW RIGHT	2	-	-
-	-	3	L - 2ND ROW LEFT	20	1				1.0	1.0			1	20		L - 2ND ROW RIGHT	4	-	-
-	-	5	L - 3RD ROW LEFT	20	1						1.0	1.0	1	20		L - 1ST ROW RIGHT	6	-	-
-	-	7	L - 4TH ROW LEFT	20	1		1.0	1.0					1	20		L - 4TH ROW RIGHT	8	-	-
-	-	9	L - 5TH ROW LEFT	20	1				1.0	1.0			1	20		L - CENTER ENTRY AISLE	10	-	-
-	-	11	O - EXISTING LOAD	20	1						1.0	1.0	1	20		L - 5TH ROW RIGHT	12	-	-
-	-	13	O - EXISTING LOAD	20	1		1.0	1.0					1	20		O - TELEPHONE EQUIPMENT	14	-	-
-	-	15	O - EXISTING LOAD	20	1				1.0	1.0			1	20		L - LUNCH ROOM	16	-	-
-	-	17	O - EXISTING LOAD	20	1						1.0	1.0	1	20		L - ENGR OFFICE	18	-	-
-	-	19	L - IBM AND AC MACHINE ROOM	20	1		1.0	1.0					1	20		L - COMPTROLLER / WHSE CENTER	20	-	-
-	-	21	L - IBM KEYPUNCH ROOM	20	1				1.0	1.0			1	20		L - USPFO / RH, CENTER, CLOTH STR	22	-	-
-	-	23	L - OFC LOG OFF	20	1						1.0	1.0	1	30		L - A/A WHSE CLOTH STORE, LH	24	-	-
-	-	25	L - SALES STORE OFC	20	1		1.0	1.0					1	20		L - SALES STORE / WHSE OFC	26	-	-
-	-	27	L - SALES STORE 1ST ROW	20	1				1.0	1.0			1	20		L - WHSE OFC / 3RD ROW SALES STR	28	-	-
-	-	29	L - SALES STORE 2ND ROW	20	1						1.0	1.0	1	20		L - SALES STORE, CLOTH, 4TH ROW	30	-	-
-	-	31	L - LATRINE (MEN / WOMEN)	20	1		1.0	1.0					1	20		O - EXISTING LOAD	32	-	-
-	-	33	L - VAULT AND PANEL	20	1				1.0	1.0			2	30		O - EXISTING LOAD	34	-	-
-	-	35	M - EXHAUST FAN LATRINE	20	1						1.0	1.0	2	30		O - EXISTING LOAD	36	-	-
-	-	37	O - EXISTING LOAD	20	1		1.0	1.0					1	20		O - EXISTING LOAD	38	-	-
-	-	39	O - EXISTING LOAD	20	1				1.0	1.0			1	20		O - EXISTING LOAD	40	-	-
-	-	41	PFB	-	-						0.0	1.0	1	20		O - EXISTING LOAD	42	-	-
-	-	43	SPARE	20	1		0.0	0.0					1	20		SPARE	44	-	-
-	-	45	SPARE	20	1				0.0	0.0			1	20		SPARE	46	-	-
-	-	47	SPARE	20	1						0.0	0.0	1	20		SPARE	48	-	-
-	-	49	SPARE	20	1		0.0	0.0					1	20		SPARE	50	-	-
-	-	51	SPARE	20	1				0.0	0.0			1	20		SPARE	52	-	-
-	-	53	SPARE	20	1						0.0	0.0	1	20		SPARE	54	-	-
TOTAL LOAD:							14.0 KVA		14.0 KVA		13.0 KVA								
TOTAL AMPS:							38.9 A		38.9 A		36.1 A								
ID LEGEND:																			

PANELBOARD: NEW B																			
LOCATION: WAREHOUSE CORRIDOR							VOLTS: 208Y/120					A.I.C RATING: 10,000							
SUPPLY FROM: MDP							PHASES: 3					MAINS TYPE: MLO							
MOUNTING: SURFACE							WIRES: 4					BUS RATING: 225							
ENCLOSURE: NEMA 1							CABINET WIDTH: 20"					MCB RATING: N/A							
GND	WIRE	CKT	CIRCUIT DESCRIPTION	ID	TRIP	POLES	A		B		C		POLES	TRIP	ID	CIRCUIT DESCRIPTION	CKT	WIRE	GND
-	-	1	L - STAGE LIGHTS	20	1	1.0	1.0					1	20			R - LEFT REAR OFFICE	2	-	-
-	-	3	R - LEFT FRONT OFFICE	20	1			1.0	1.0			1	20			R - LEFT REAR OFFICE	4	-	-
-	-	5	R - LEFT FRONT OFFICE	20	1					1.0	1.0	1	20			R - LEFT REAR OFFICE	6	-	-
-	-	7	R - RIGHT OFFICE	20	1	1.0	1.0					1	20			R - LUNCH ROOM	8	-	-
-	-	9	R - RIGHT OFFICE	20	1			1.0	1.0			1	20			R - LUNCH ROOM	10	-	-
-	-	11	PFB	-	-					0.0	1.0	1	20			R - REFRIG / COMPUTER / KITCHEN	12	-	-
-	-	13	PFB	-	-	0.0	1.0					1	20			R - STORE	14	-	-
-	-	15	O - CARLSON OFF	20	1			1.0	1.0			1	20			R - DISPOSAL	16	-	-
-	-	17	PFB	-	-					0.0	1.0	1	20			R - REFRIGERATOR	18	-	-
-	-	19	R - STORE	20	1	1.0	1.0					1	20			R - PAYROLL	20	-	-
-	-	21	L - CAGE AREA	20	1			1.0	1.0			1	20			O - TELEPHONE SYSTEM	22	-	-
-	-	23	O - OZALID	20	1					1.0	1.0	1	20			O - OZALID	24	-	-
-	-	25	R - CLOCK	20	1	1.0	1.0					1	20			O - DEHUMIDIFER CABINET	26	-	-
-	-	27	R - 31-ADP KP	20	1			1.0	1.0			1	20			R - CAGE AREA	28	-	-
-	-	29	R - RECORDS STORAGE / CAGE	20	1					1.0	1.0	1	20			O - EXISTING LOAD	30	-	-
-	-	31	O - EXISTING LOAD	20	1	1.0	1.0					1	20			O - FRONT DOOR ACCESS CONTROL	32	-	-
-	-	33	R - XEROX MACHINE	20	1			1.0	1.0			1	20			R - CAGE AREA AND TIME SWITCH	34	-	-
-	-	35	PFB	-	-					0.0	1.0	1	20			O - EXISTING LOAD	36	-	-
-	-	37	F - SMOKE DETECTOR	20	1	1.0	0.0					-	-			PFB	38	-	-
-	-	39	R - NEW OUTLET	20	1			1.0	0.0			-	-			PFB	40	-	-
-	-	41	O - DUCT DETECTOR	20	1					1.0	0.0	-	-			PFB	42	-	-
-	-	43	SPARE	20	1	0.0	0.0					1	20			SPARE	44	-	-
-	-	45	SPARE	20	1			0.0	0.0			1	20			SPARE	46	-	-
-	-	47	SPARE	20	1					0.0	0.0	1	20			SPARE	48	-	-
-	-	49	SPARE	20	1	0.0	0.0					1	20			SPARE	50	-	-
-	-	51	SPARE	20	1			0.0	0.0			1	20			SPARE	52	-	-
-	-	53	SPARE	20	1					0.0	0.0	1	20			SPARE	54	-	-
TOTAL LOAD:							12.0 KVA	13.0 KVA	10.0 KVA										
TOTAL AMPS:							33.3 A	36.1 A	27.8 A										
ID LEGEND:																			
LOAD CLASSIFICATION			CONNECTED LOAD		DEMAND FACTOR		DEMAND LOAD		PANEL TOTALS										
LIGHTING			2.0 KVA		100.0%		2.0 KVA												
RECEPTACLES			22.0 KVA		72.7%		16.0 KVA		TOTAL CONNECTED LOAD:				35.0 KVA						
HVAC			0.0 KVA		100.0%		0.0 KVA		TOTAL DEMAND LOAD:				29.0 KVA						
MOTOR LOAD			0.0 KVA		100.0%		0.0 KVA		TOTAL CONNECTED CURRENT:				97.2 A						
FIRE ALARM			1.0 KVA		100.0%		1.0 KVA		TOTAL DEMAND CURRENT:				80.5 A						
KITCHEN EQUIPMENT			0.0 KVA		65.0%		0.0 KVA												
OTHER LOADS			10.0 KVA		100.0%		10.0 KVA												
NOTES:																			
1. REPLACE EXISTING PANEL B.																			
2. FIELD VERIFY EXISTING BREAKER SIZES. NEW BREAKERS SHALL MATCH EXISTING.																			

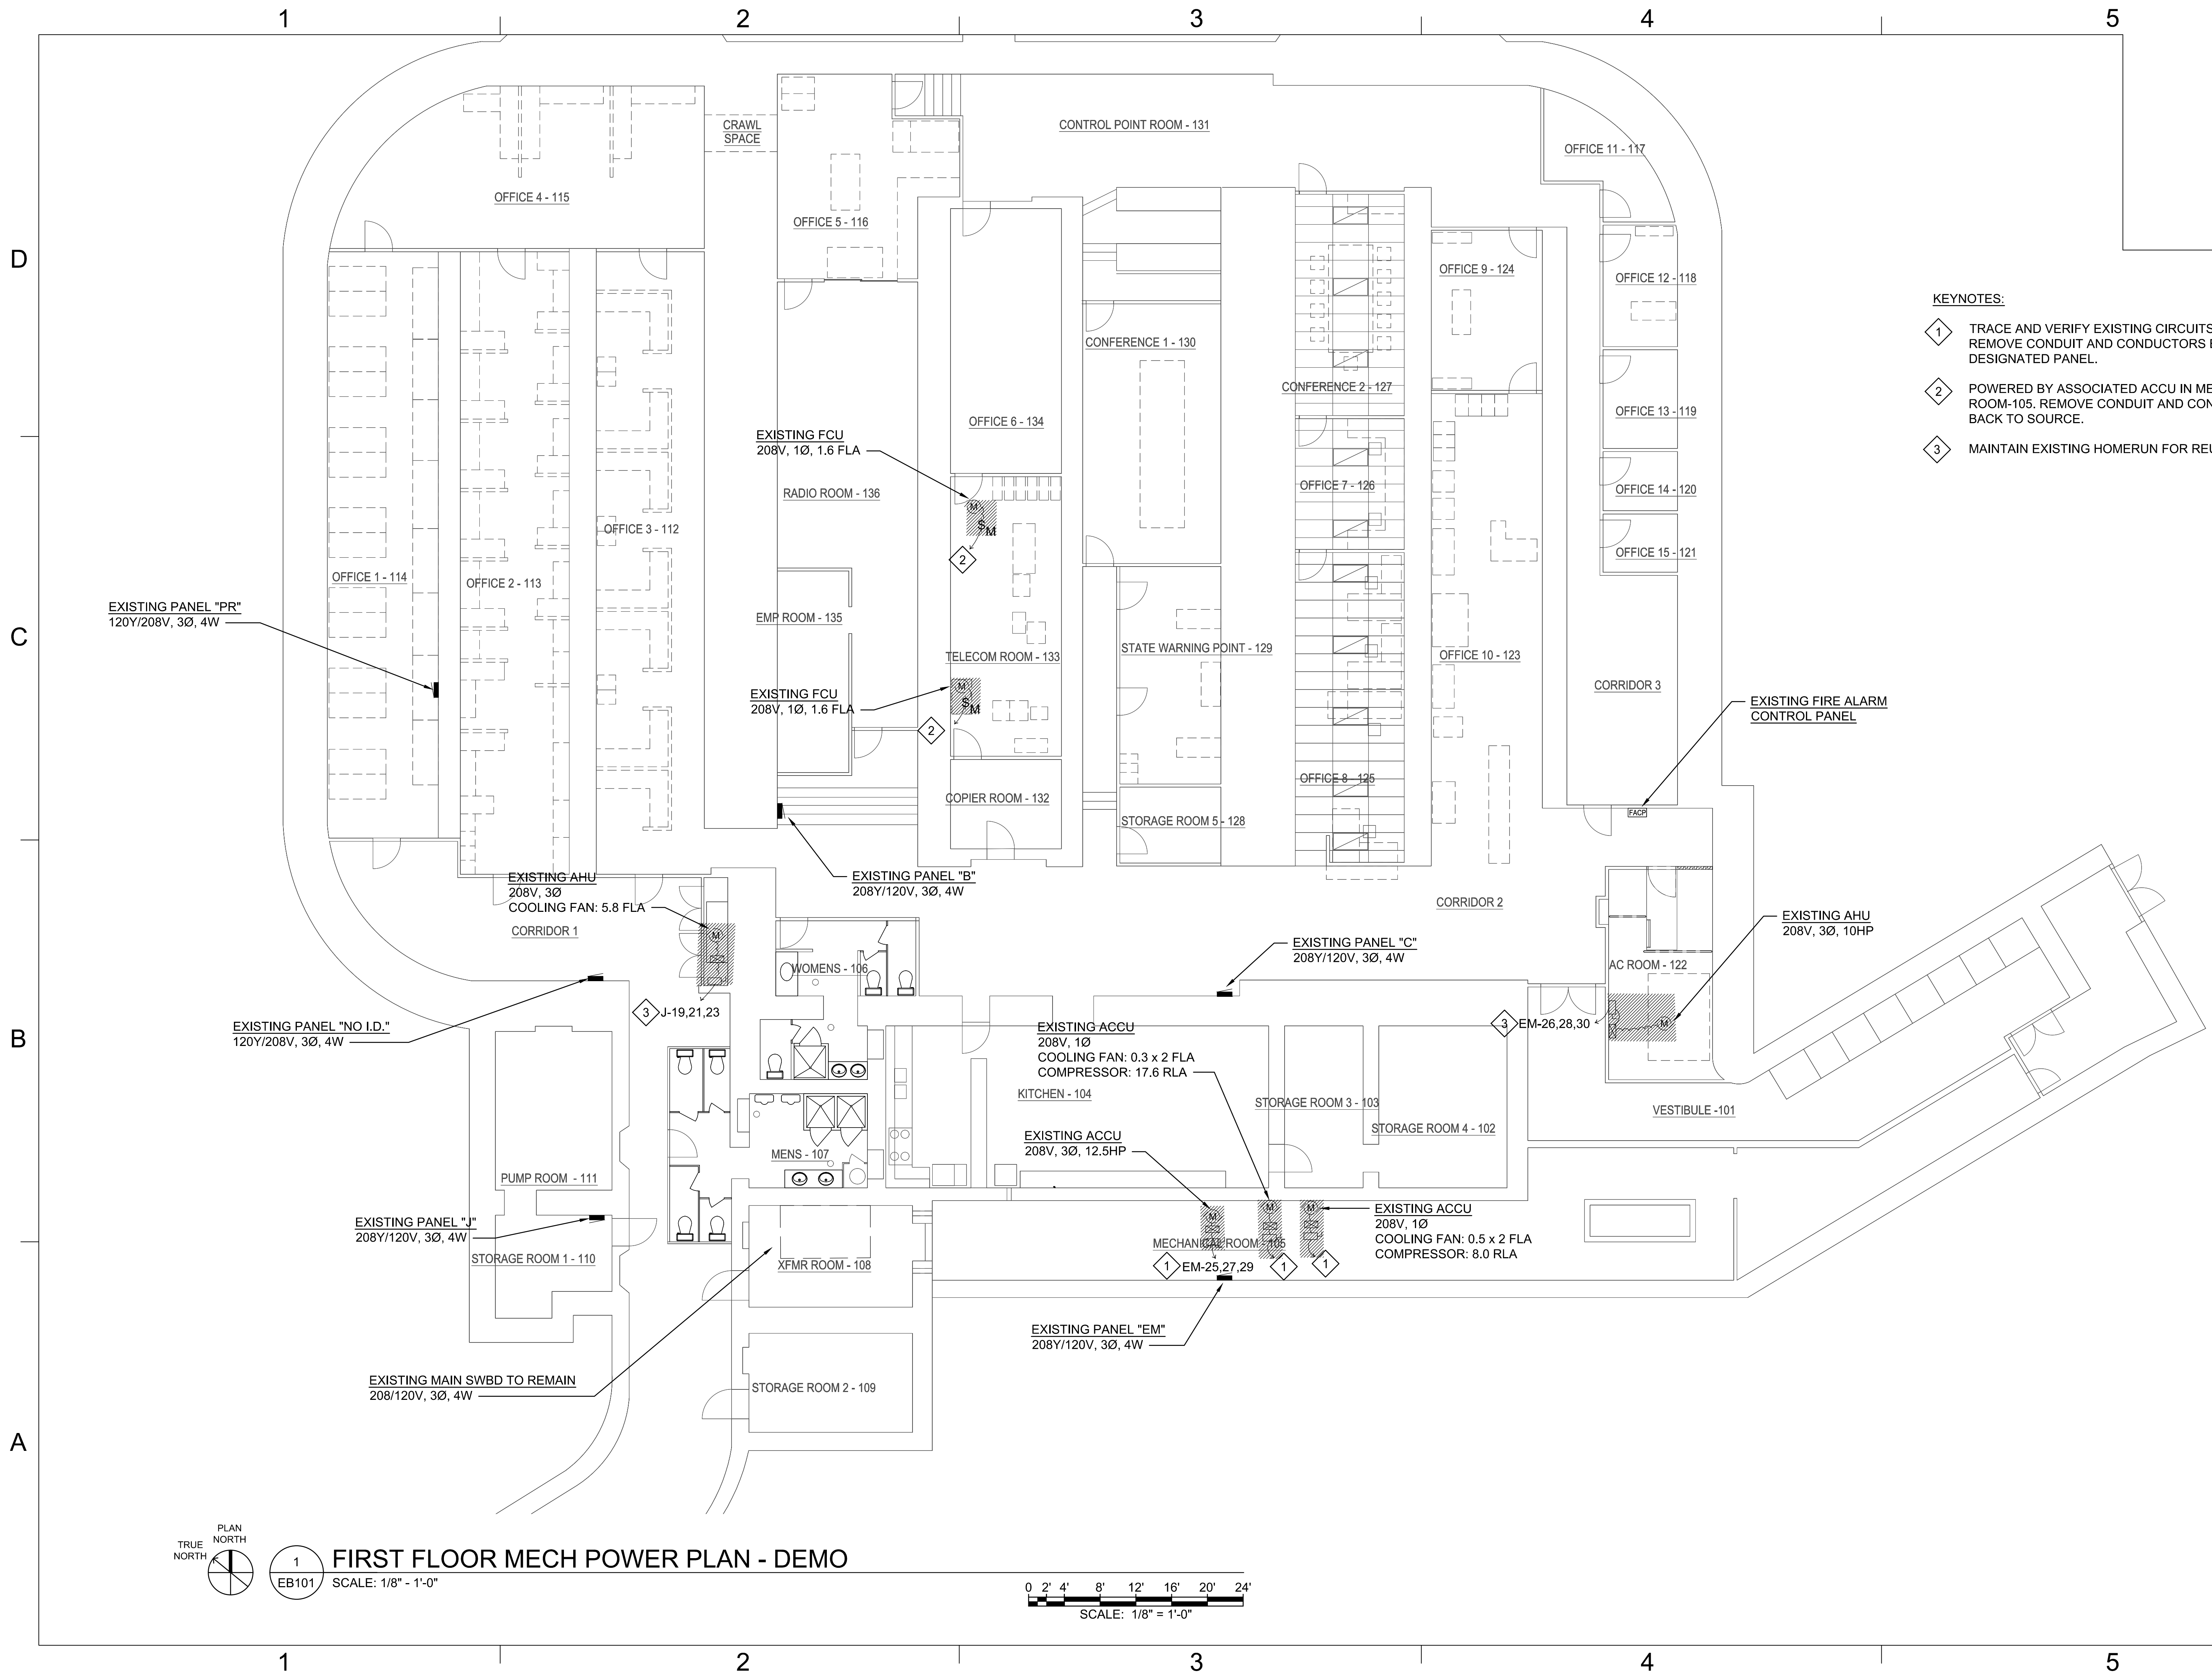

KEYNOTES:

1. TRACE AND VERIFY EXISTING CIRCUITS. REMOVE CONDUIT AND CONDUCTORS BACK TO DESIGNATED PANEL.
2. POWERED BY ASSOCIATED ACCU IN MECHANICAL ROOM-105. REMOVE CONDUIT AND CONDUCTORS BACK TO SOURCE.
3. MAINTAIN EXISTING HOMERUN FOR REUSE.

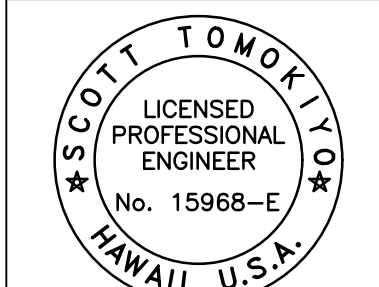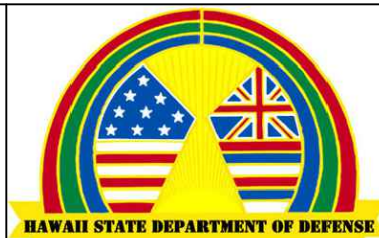

THIS WORK WAS PREPARED BY ME
OR UNDER MY SUPERVISION
Scott Tompkins 4/30/2026
SIGNATURE EXPIRATION DATE

[illegible]

SUBMITTAL PHASE
CONSTRUCTION
DOCUMENTS

SUBMITTAL DATE		03/01/2024
SF	KR	ST

STATE OF HAWAII	DIAMOND HEAD STATE MONUMENT	DEPARTMENT OF DEFENSE
4204 DIAMOND HEAD RD HONOLULU, HI 96816	TMK: 3-1-042:006	
BIRKHMIR EMERGENCY OPERATIONS CENTER (EOC) UPGRADES AND IMPROVEMENTS		
FIRST FLOOR MECH POWER PLAN - DEMO		

SCALE: AS NOTED

STATE JOB NO.
CA-202313-C

FEDERAL PROJECT NO.

SHEET 106 OF 123

EB101

1

2

3

4

5

D

C

B



A

D

C

B


A

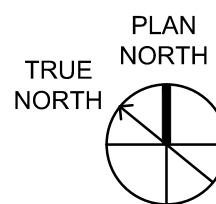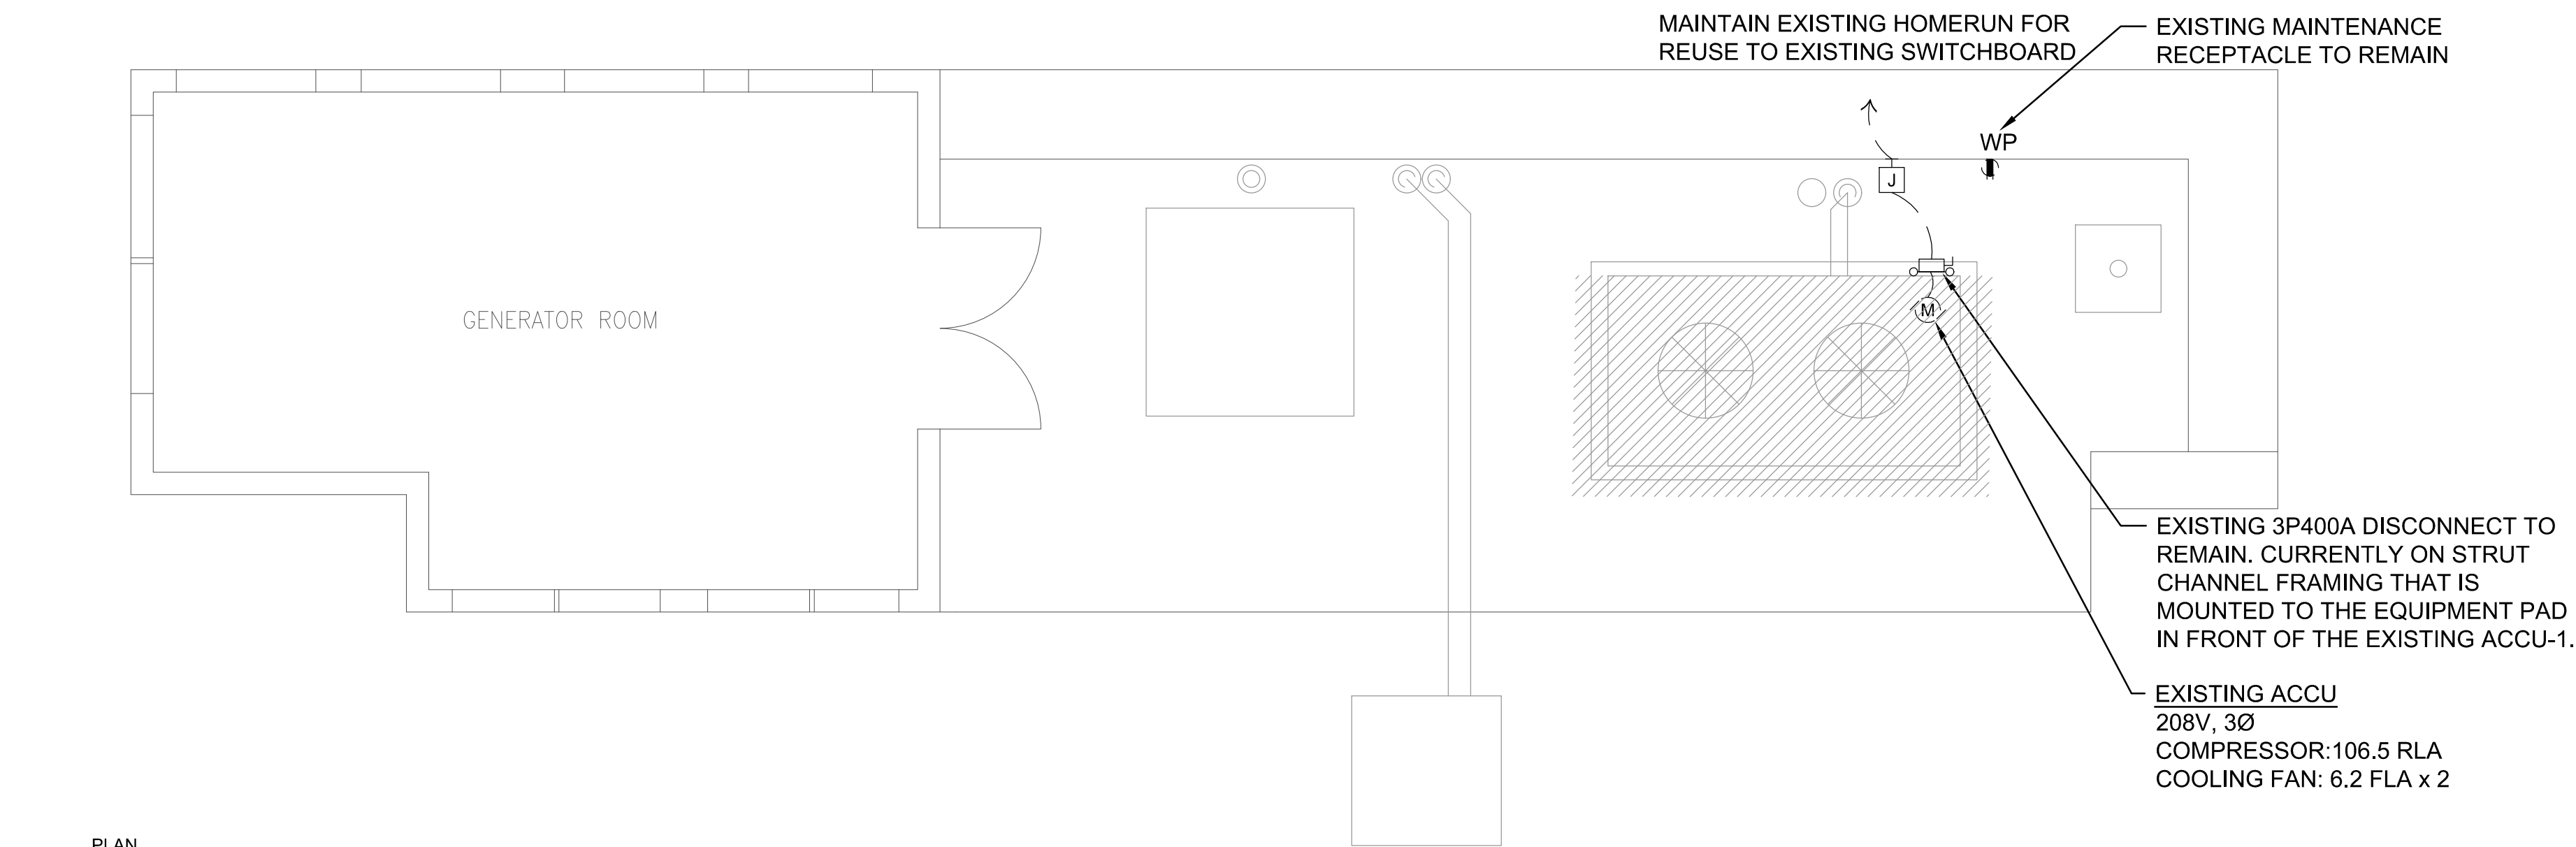



C1
EB102

ROOF MECH POWER PLAN - DEMO

SCALE: 1/4" = 1'-0"

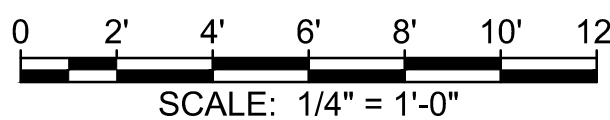


SCALE: 1/4" = 1'-0"

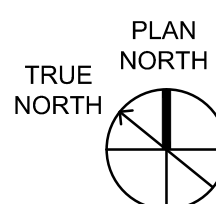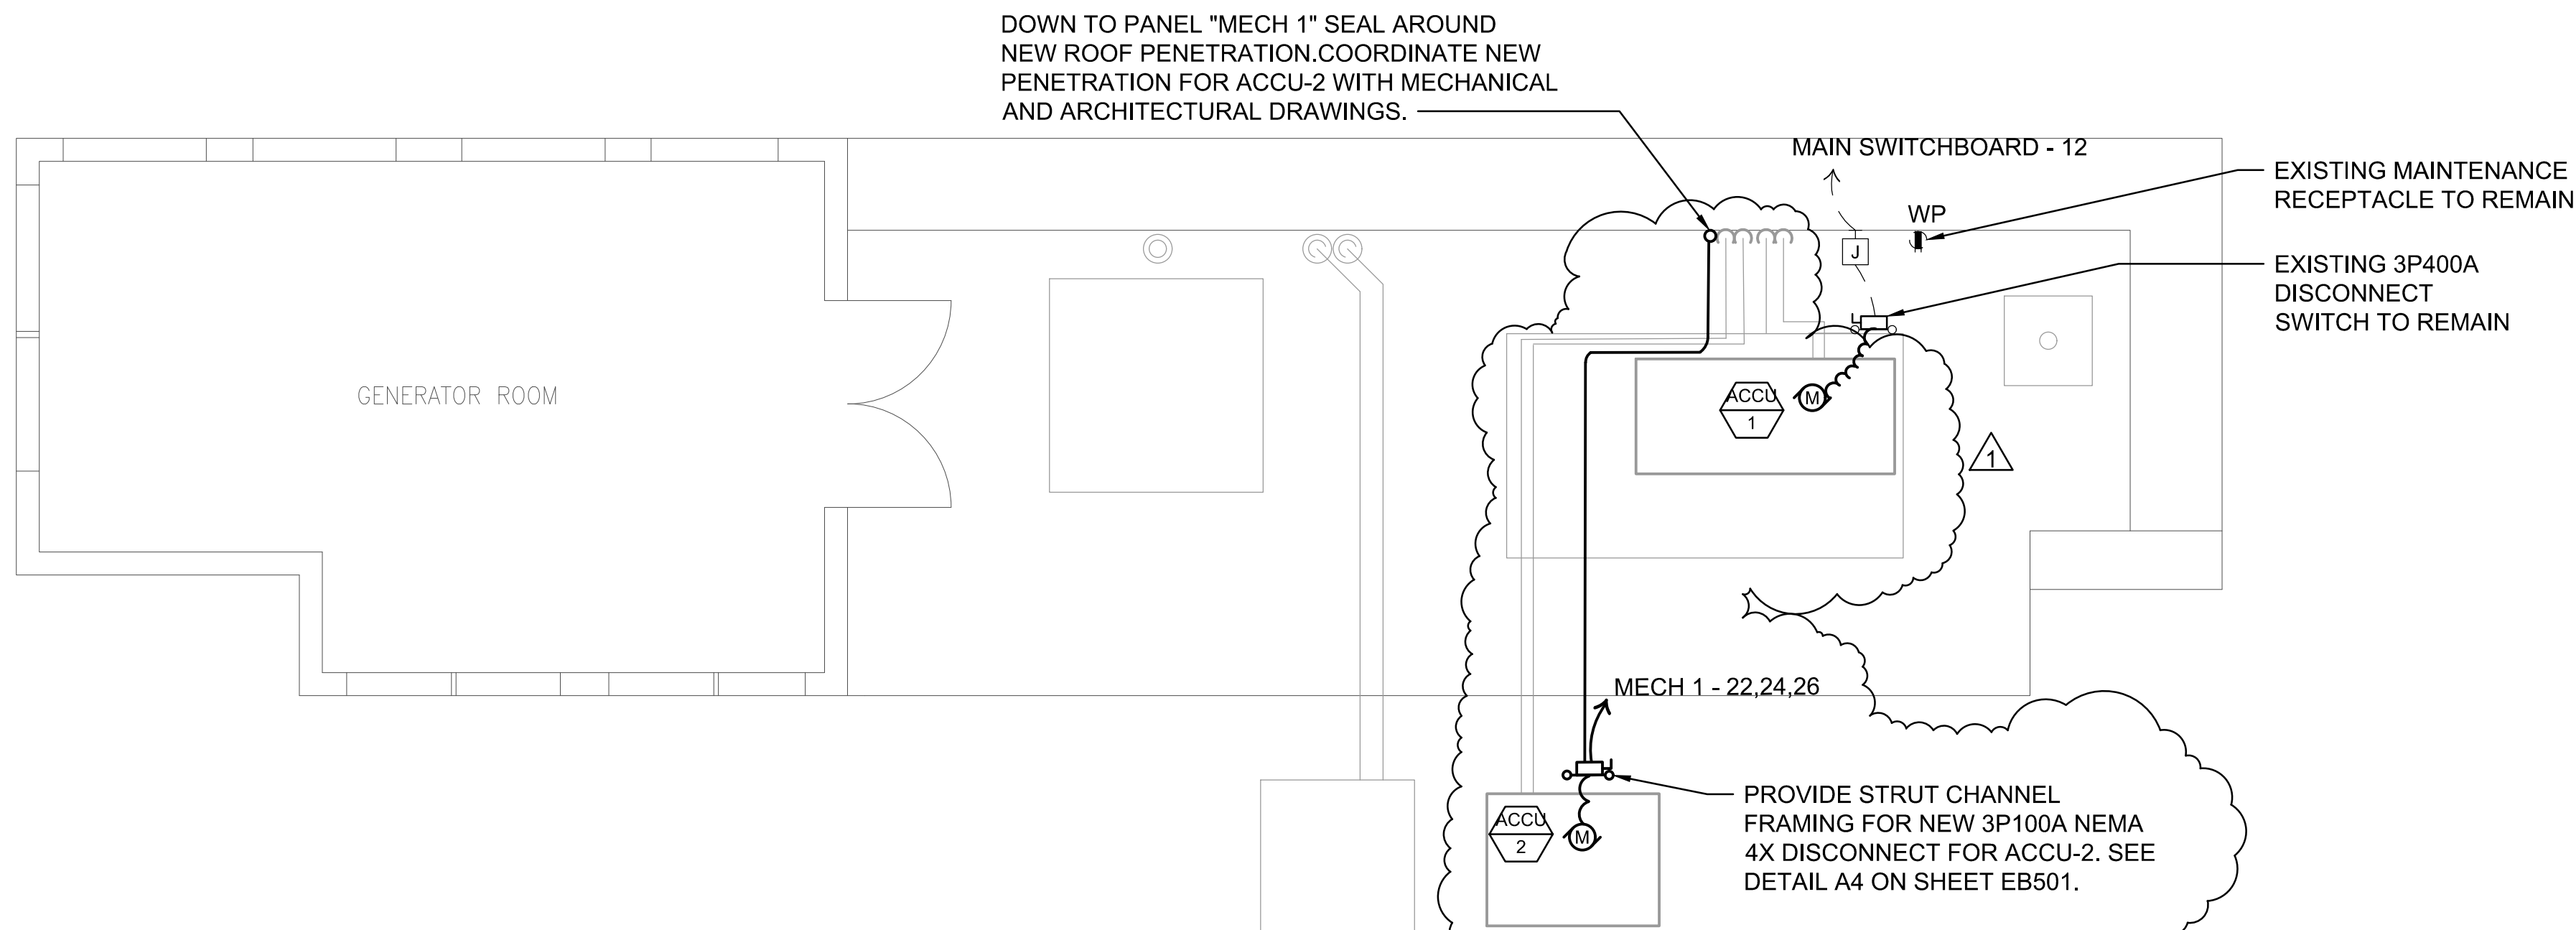

A1
EB102

ROOF MECH POWER PLAN

SCALE: 1/4" = 1'-0"

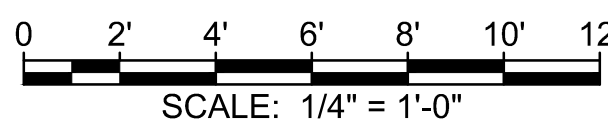

SCALE: 1/4" = 1'-0"



1

2

3

4

5

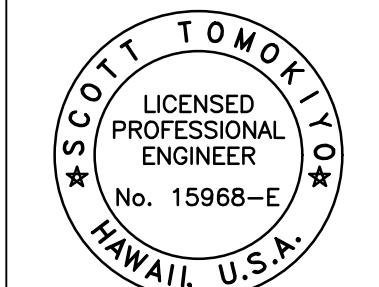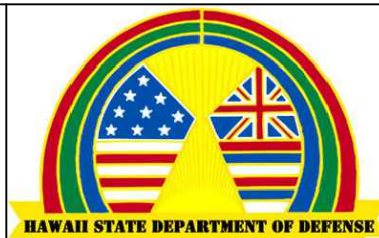

THIS WORK WAS PREPARED BY ME OR UNDER MY SUPERVISION

SIGNATURE: *Scott Tomokiy* EXPIRATION DATE: 4/30/2026

ST

3/2/24

DATE

APPRO

SYN

DESCRIPTION

ADDENDUM NO.1

CONSTRUCTION DOCUMENTS

SUBMITTAL DATE 03/01/2024

SF KR ST

DEPARTMENT OF DEFENSE

DIAMOND HEAD STATE MONUMENT

TMK: 3-1-042:006

4204 DIAMOND HEAD RD HONOLULU, HI 96816

BIRKHAMER EMERGENCY OPERATIONS CENTER (EOC)

UPGRADES AND IMPROVEMENTS

ROOF MECH POWER PLANS

SCALE: AS NOTED


STATE JOB NO. CA-202313-C

FEDERAL PROJECT NO.

SHEET 107 OF 123


EB102

A

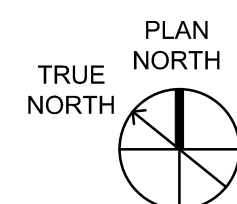


0 2' 4' 6' 8' 10' 12'

SCALE: 1/4" = 1'-0"


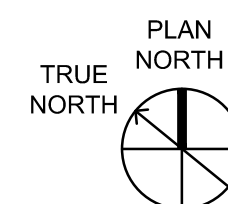


① INTERCEPT EXISTING CIRCUIT VIA A JUNCTION BOX AND EXTEND TO ROOM CONTROLLER AND NEW LIGHTS.



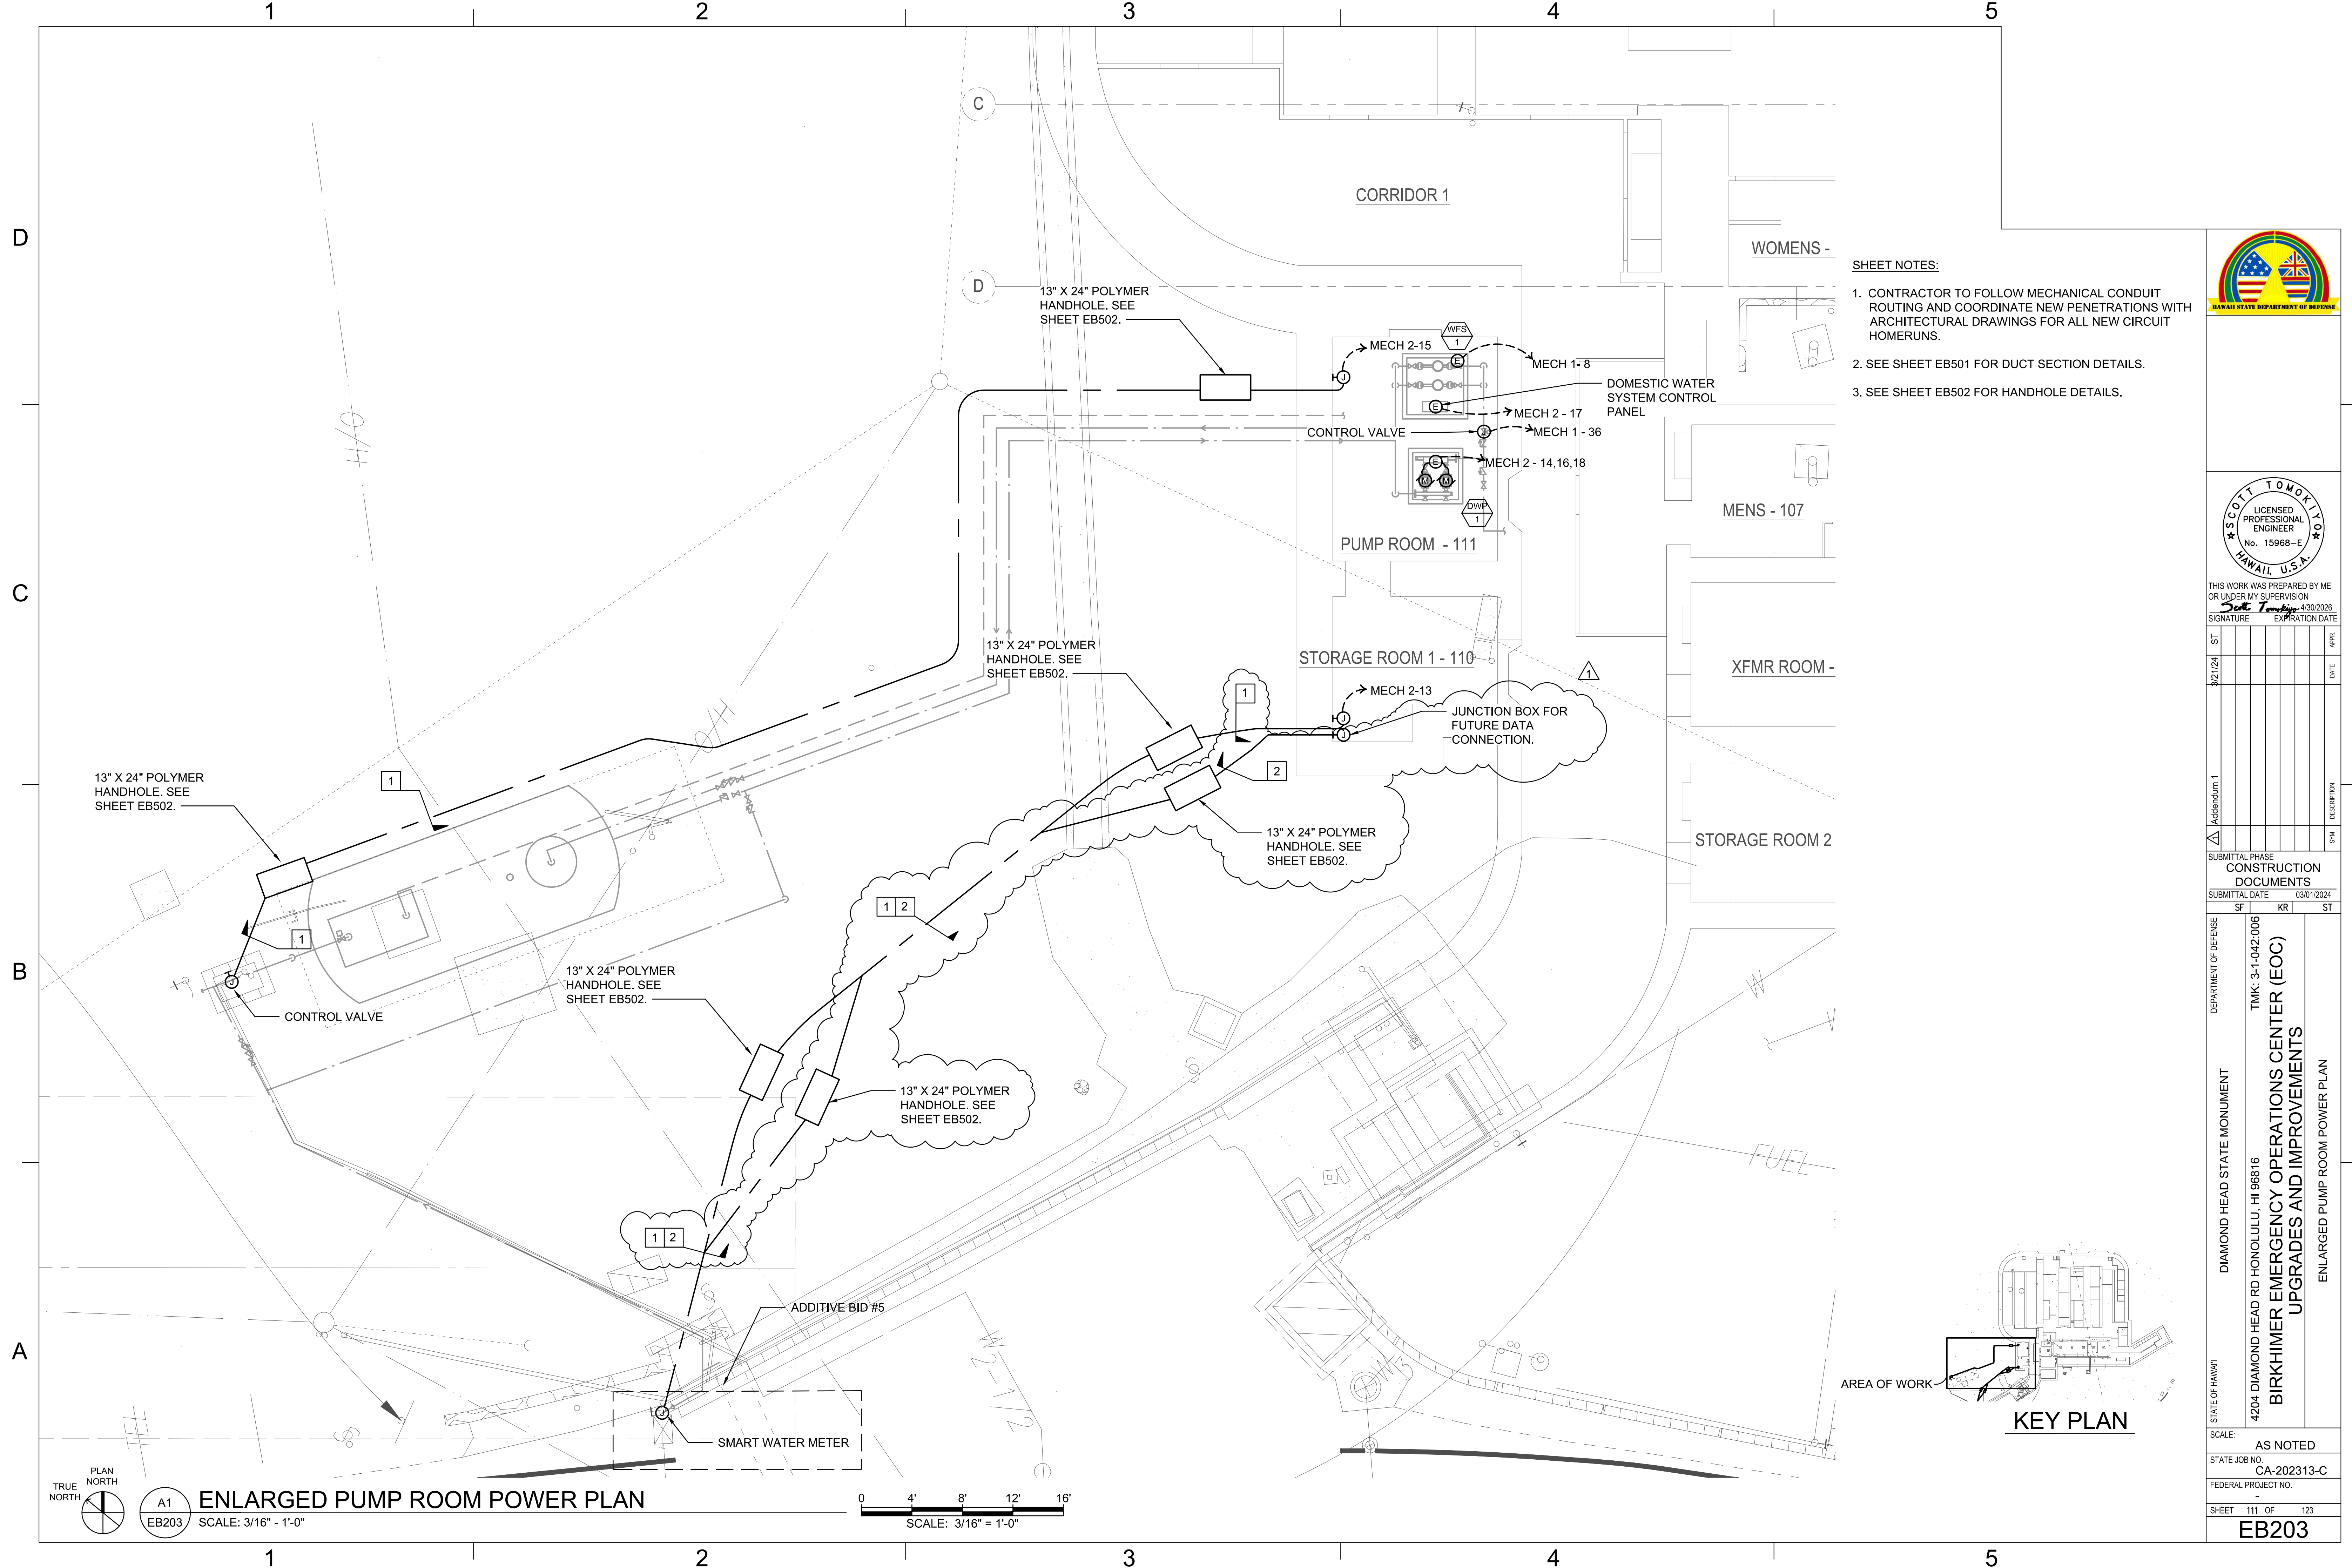

- SHEET NOTES:**
- 1. CONTRACTOR TO FOLLOW MECHANICAL CONDUIT ROUTING AND COORDINATE NEW PENETRATIONS WITH ARCHITECTURAL DRAWINGS FOR ALL NEW CIRCUIT HOMERUNS.
 - 2. SEE SHEET EB501 FOR DUCT SECTION DETAILS.
 - 3. SEE SHEET EB502 FOR HANDHOLE DETAILS.

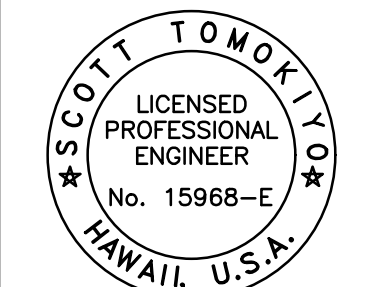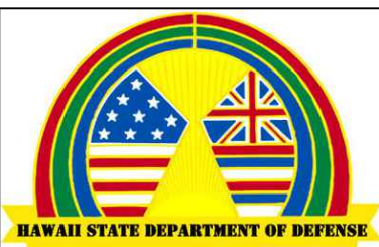


THIS WORK WAS PREPARED BY ME OR UNDER MY SUPERVISION
Scott Tomkiyo 4/30/2026
SIGNATURE EXPIRATION DATE

ST	DATE	APPR.	DATE	SYN.	DESCRIPTION
3/21/24					
Addendum 1					

SUBMITTAL PHASE
CONSTRUCTION DOCUMENTS
SUBMITTAL DATE 03/01/2024



DEPARTMENT OF DEFENSE	STATE OF HAWAII	DIAMOND HEAD STATE MONUMENT	TMK: 3-1-042:006	4204 DIAMOND HEAD RD HONOLULU, HI 96816	BIRKHAMER EMERGENCY OPERATIONS CENTER (EOC) UPGRADES AND IMPROVEMENTS	ENLARGED PUMP ROOM POWER PLAN
-----------------------	-----------------	-----------------------------	------------------	---	---	-------------------------------


SCALE: AS NOTED
STATE JOB NO. CA-202313-C
FEDERAL PROJECT NO. -
SHEET 111 OF 123
EB203

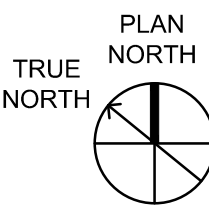


A1
EB203

ENLARGED PUMP ROOM POWER PLAN
SCALE: 3/16" = 1'-0"

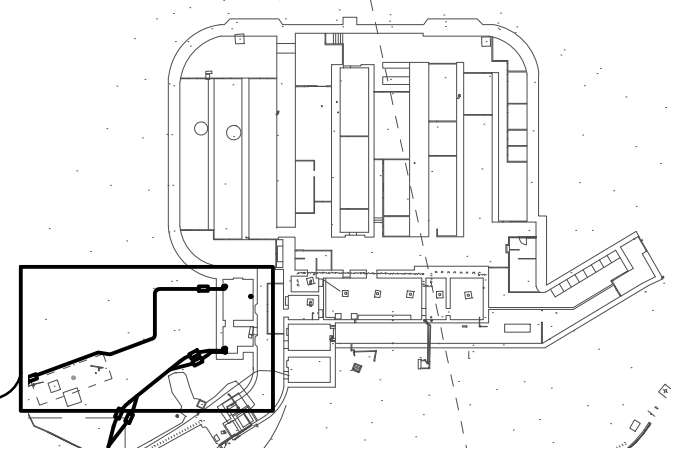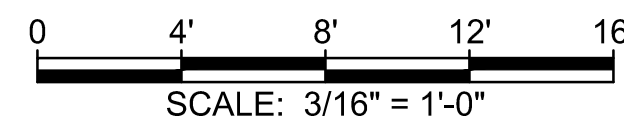

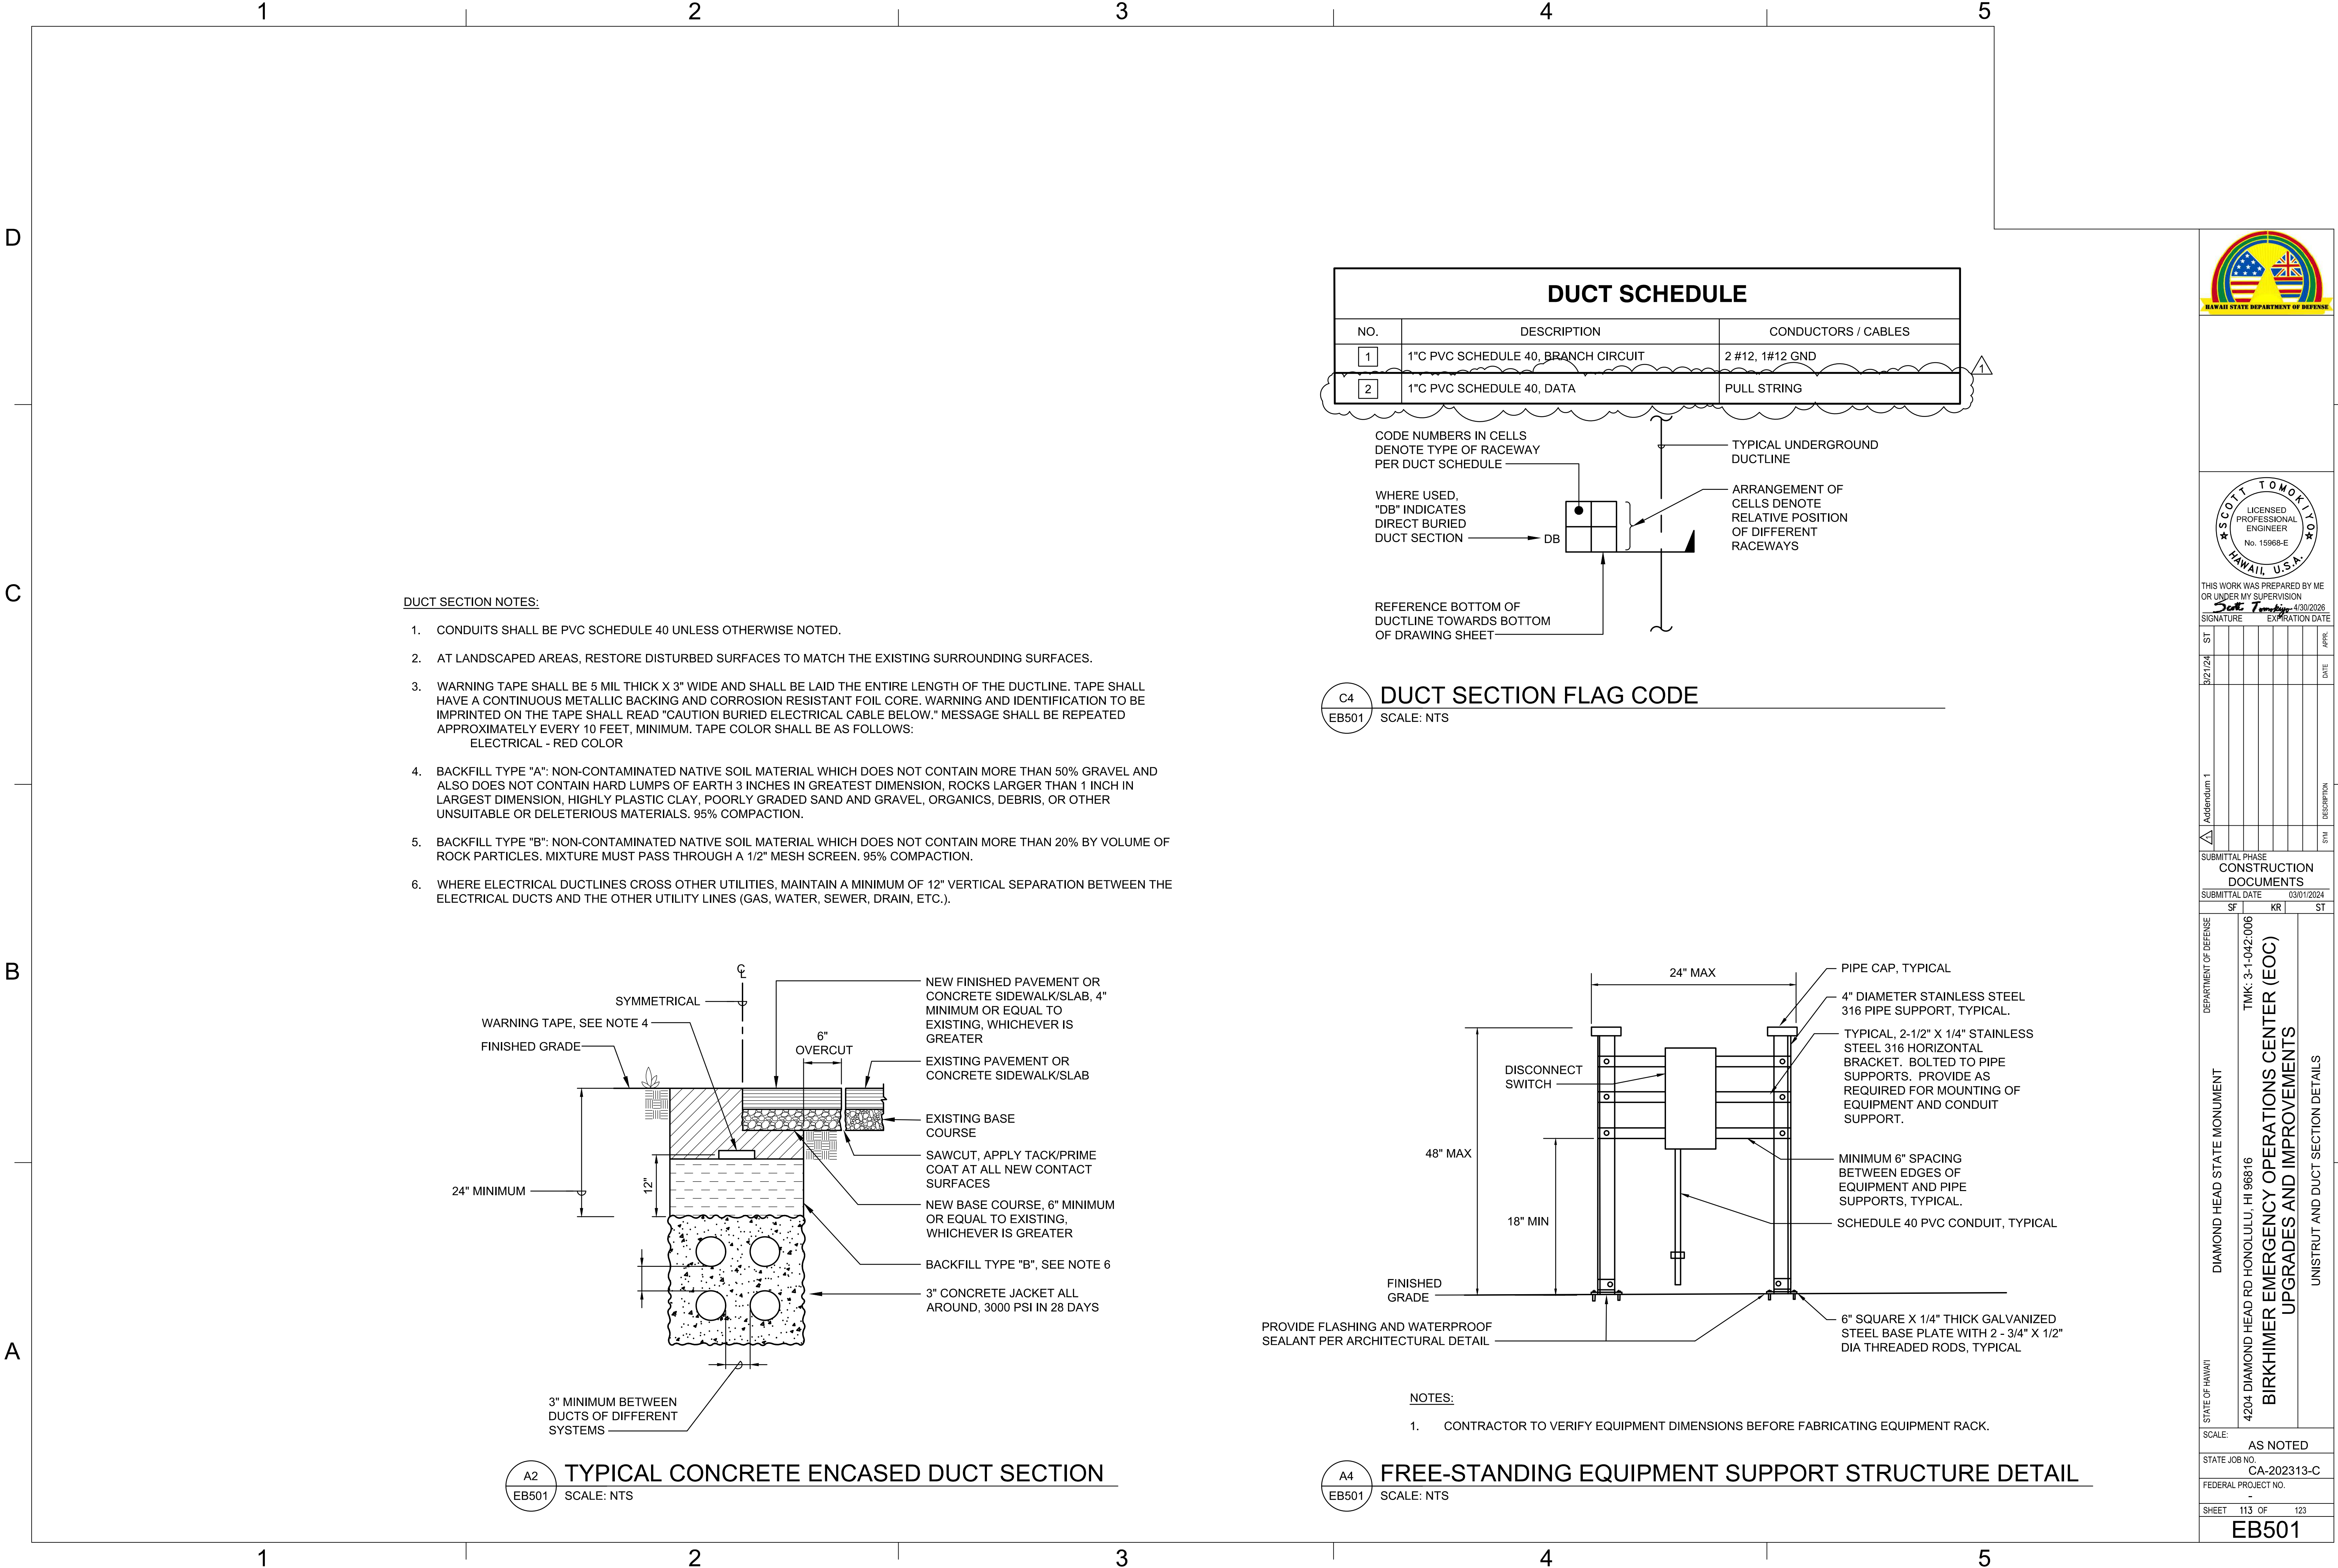

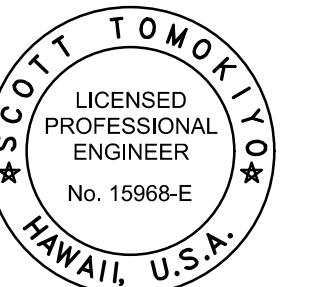[illegible]

SUBMITTAL PHASE		
CONSTRUCTION		
DOCUMENTS		
SUBMITTAL DATE		03/01/2024
SF	KR	ST


DIAMOND HEAD STATE MONUMENT	4204 DIAMOND HEAD RD HONOLULU, HI 96816	TMK: 3-1-042-006
BIRKHMIR EMERGENCY OPERATIONS CENTER (EOC) UPGRADES AND IMPROVEMENTS		
HANDHOLE DETAILS		

SCALE:	AS NOTED	
STATE JOB NO.	CA-202313-C	
FEDERAL PROJECT NO.	-	
SHEET	114 OF	123
EB502		







- BOLTDOWN (2X)
- STD. MARKING, ELEC
- NON SKID SURFACE
- POLYMER CONCRETE COVER
- LIFT PIN

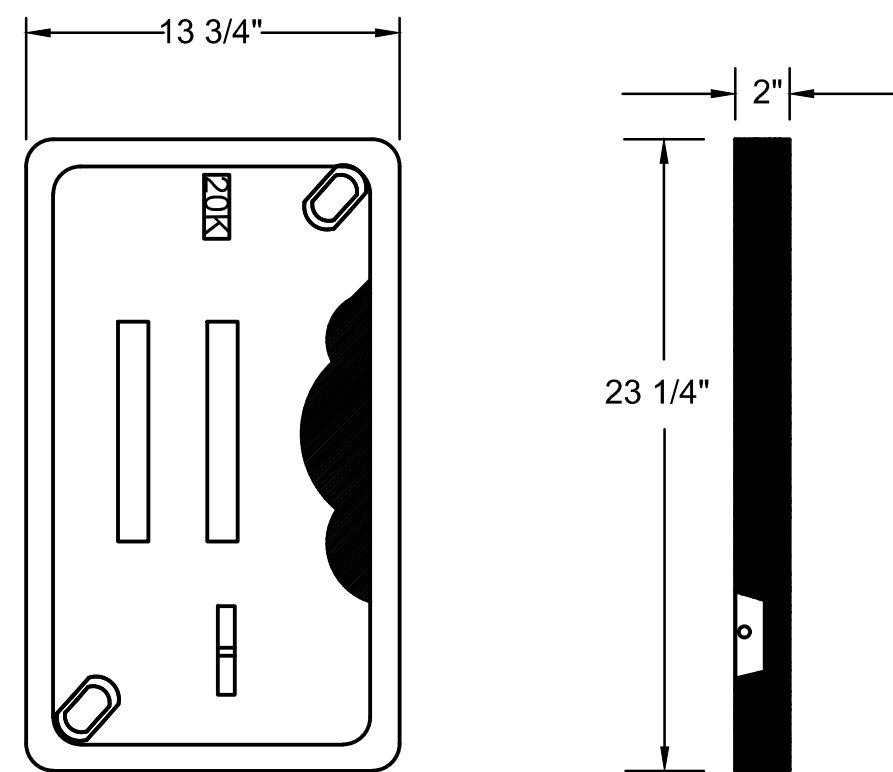

13" X 24" HANDHOLE COVER DETAIL

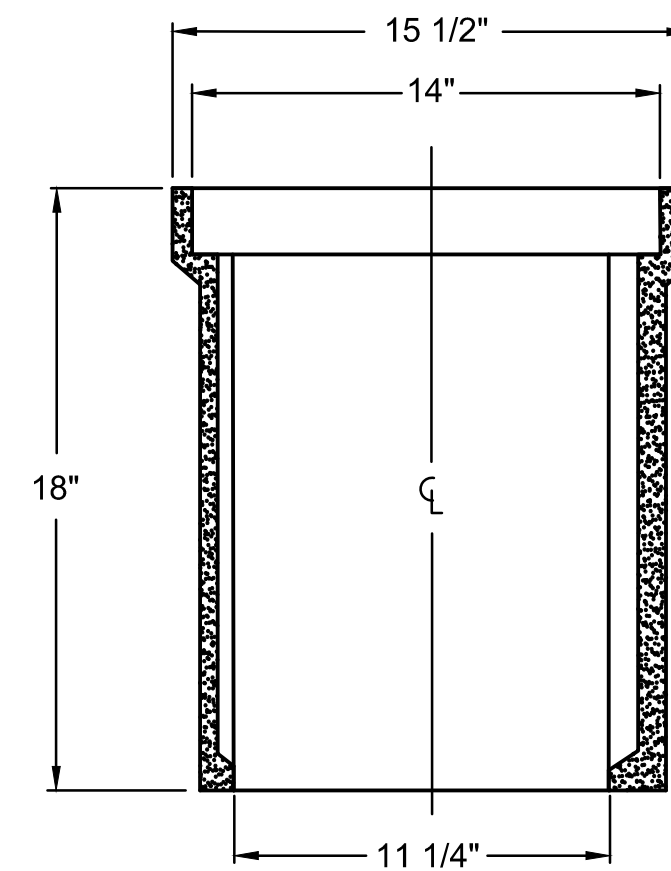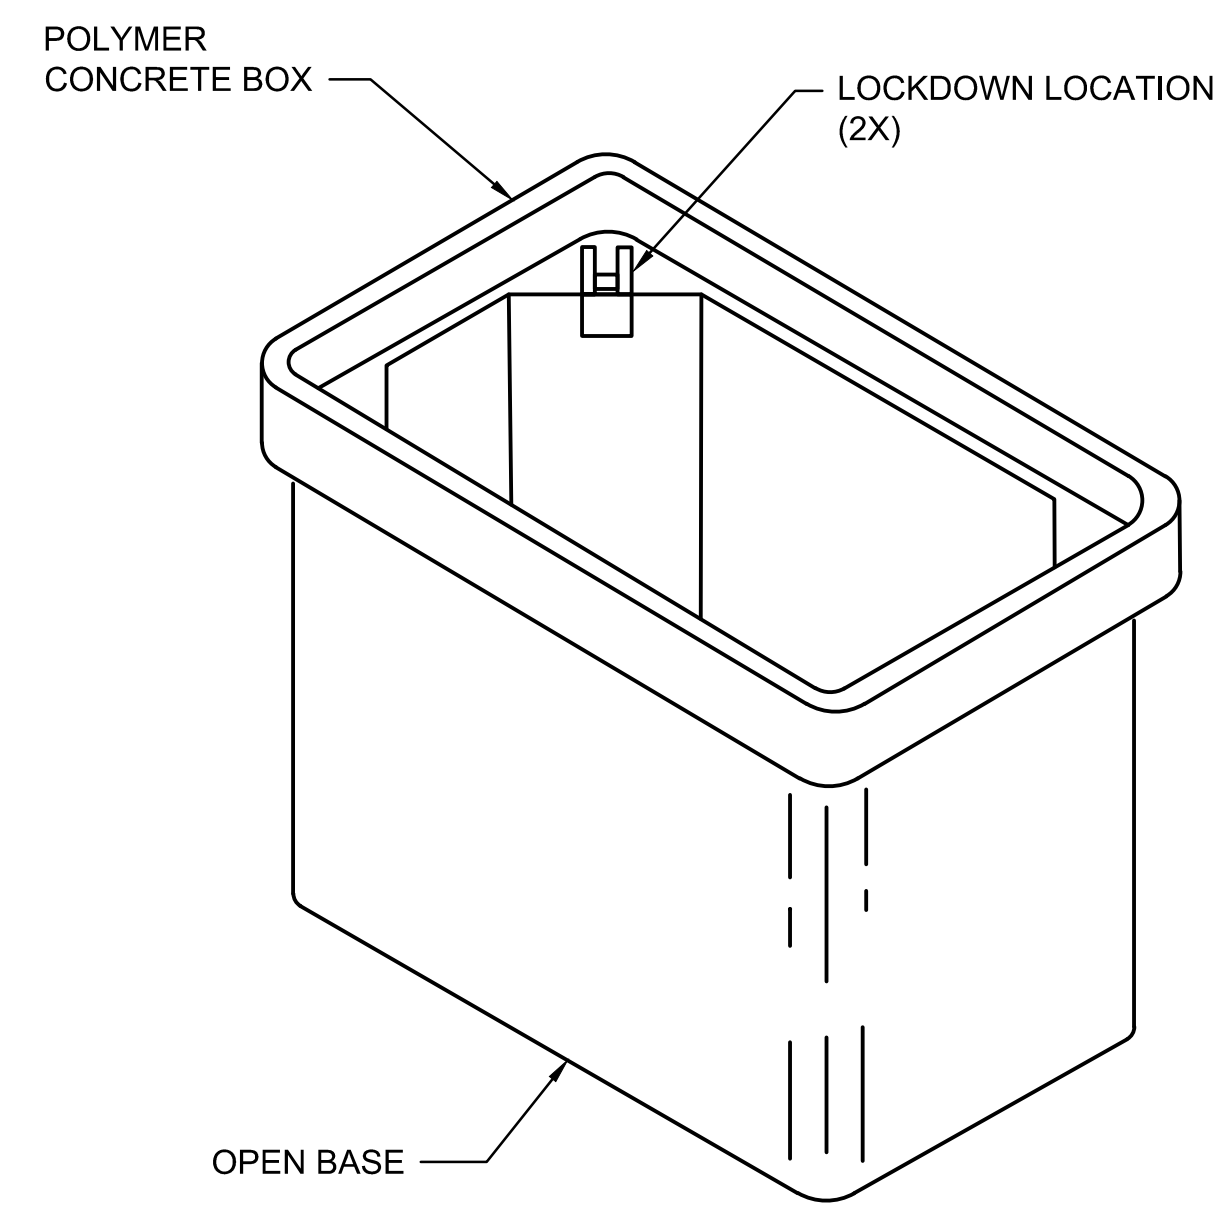


SECTION A-A




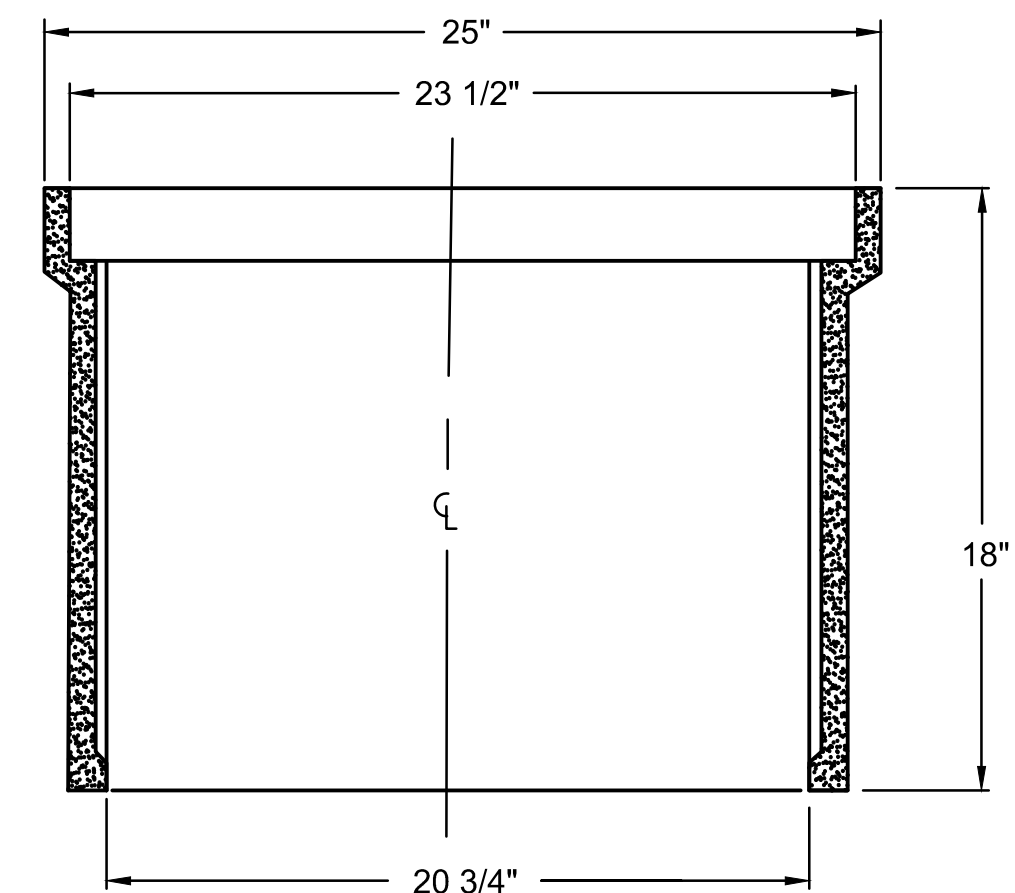


SECTION B-B

13" X 24" HANDHOLE COVER DETAIL

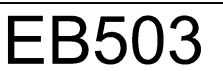

[illegible]

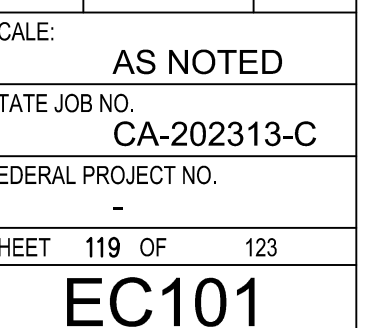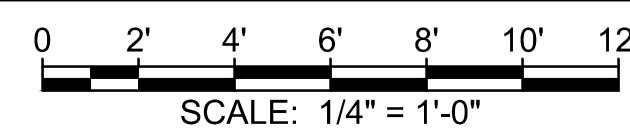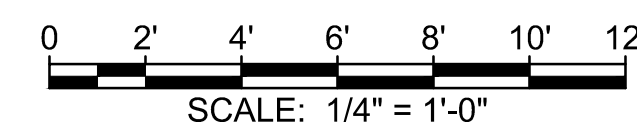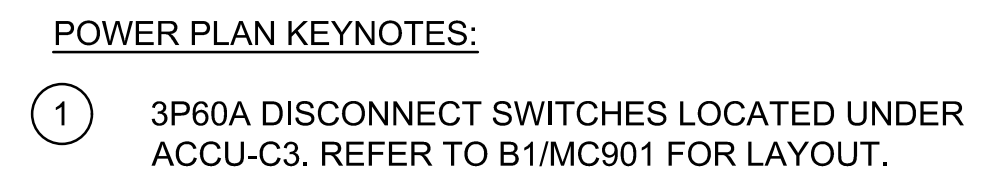

Meeting Minutes

Page 1

March 19, 2024

**STATE OF HAWAII
DEPARTMENT OF DEFENSE**

PRE-BID MEETING MINUTES

DATE: March 19, 2024

TIME: 9:00 a.m.

LOCATION: Building 303
4204A Diamond Head Road

PROJECT: Birkhimer EOC Upgrades and Improvements
Diamond Head Crater
State Project No. CA-202313-C

PRESENT: See attached list

SUBJECT: Pre-Bid Meeting

MEETING MINUTES:

- I. Tad Nakayama began the meeting by going through the meeting agenda. Upon conclusion of the meeting, site visit to the three project sites (Building 303, Birkhimer, and PSB) was conducted.

II. Questions from the attendees are addressed below.

1. Does the Birkhimer water tank work require any phasing? **No, it does not. The existing water tank is abandoned in place, and currently not in use. Contractor shall replace the existing tank in place.**
2. Is it required for the bidders to hold the bid price for 180 days? **Yes, see OF-9 of the project specifications for further information.**
3. Is a cost breakdown required during the bid or can it be provided after? **DOD will consider this request and modify the Offer section, if determined to be acceptable.**
4. Do Birkhimer generators need to be replaced? **No**
5. Is a cost breakdown required during the bid or can it be provided after? **DOD will consider this request and modify the offer section, if determined to be acceptable.**

Enc

1. Pre-bid meeting agenda
2. Attendance list

**STATE OF HAWAII
DEPARTMENT OF DEFENSE**

PRE-BID MEETING AGENDA

DATE: March 19, 2024

TIME: 9:00 a.m.

LOCATION: Building 303
4204A Diamond Head Road

PROJECT: Birkhimer EOC Upgrades and Improvements
Diamond Head Crater
State Project No. CA-202313-C

PRESENT: See attached list

SUBJECT: Pre-Bid Meeting

MEETING SUMMARY:

I. GENERAL DISCUSSION

1. Attendees reminded fill out attendance sheet completely (name, address, phone number, etc.).
2. Participants involved with the project were introduced (State, Design Consultant, CM Consultant).
3. All questions must be submitted in writing to the DOD contracting office by March 20, 2024 by 3:30 pm. Questions can be emailed to: jesper.h.andersen@hawaii.gov.

This meeting is to clarify general questions only. If there is a conflict between what was stated in this meeting and the bid documents, the bid documents shall govern. Any significant changes will be issued through an addendum. A copy of the meeting minutes will be issued as an addendum.

4. Design Consultant, InSynergy to provide a brief description of the scope of work.

The work generally includes but is not limited to the following for the three buildings of the State of Hawaii Department of Defense (Birkhimer EOC).

Building #303:

- a. Provide the following HVAC work:
 - i. Provide a new dedicated Direct Expansion (DX) heat pump a/c system to State Warning Point Room.
 - ii. Replace existing duct board ductwork with new Sheetmetal duct.
 - iii. Provide stand-alone Variable Air Volume (VAV) Terminal units to all areas serve by AHU-1
 - iv. Convert existing AHU-1 to a VAV unit.
- b. Install a new emergency generator and aboveground fuel tank
- c. Replace light fixtures with new throughout the building as indicated in the contract drawing.
- d. Provide new battery powered parking lot light fixtures.
- e. Provide all indicated electrical removal and new work as indicated.
- f. Repave the existing parking lot as indicated.
- g. All incidental related work shall be included in this project.
- h. Refer to phasing plan for the required phasing work for this project.
- i. Provide minor architectural work such as providing new louvers, remove and reinstall ceiling tiles.

Public Services Building:

- a. Provide heat pump DX air conditioning units and associated electrical, and refrigerant piping work.
- b. Replace existing light fixtures with new to install a/c units.

Birkhimer:

- a. Provide new a/c systems.
- b. Install a new emergency potable water system including a new underground water tank, water piping from the underground tank to the Birkhimer building, water booster pumps, water re-circulation filtration system.
- c. Provide new domestic cold and hot water piping in the men and women's bathroom, and kitchen.
- d. Replace an existing underground diesel fuel tank with a new aboveground tank as indicated.

- e. Provide ceiling tile, and grid, restoration work as indicated in architectural work.
5. The Design Consultant will be responsible to take minutes of this meeting and also receive any questions you have during this meeting and the site visit. It is the attendee's responsibility to clearly state the questions for recordation. The design consultant will not be responsible for any errors in the question.
6. Important items brought to attendees attention:
 - Bid Opening is April 11, 2024.
 - Last day for Substitution Requests, clarification on bidding documents and/or specifications must be emailed to jesper.h.andersen@hawaii.gov by 3:00 pm, March 20, 2024.
 - This bid contains additive alternates. The cost on page OF-2 is the sum of the basic bid (items 1-17). Fill in costs for the bid alternatives, as well.
7. Project duration is 400 calendar days from NTP. Liquidated damages in the amount of \$2,600 per working day will be assessed if work is not completed within the contract time. See OF-9 for further information.
8. Unless there is a problem with the award process, the State intends to issue the Notice to Proceed date 180 calendar days from Bid Opening date (hold bid prices). See OF-9 for further information.
9. Two of the three facilities are staffed on a normal basis. Be aware of construction work restrictions per Section 1100.

Birkhimer Emergency Operations Center
Upgrades and Improvements
Pre-Bid Site Visit

March 19, 2024

Name	Company	Phone No.	Email address
Stephen Wong	RHS Lee, Inc	808-451-9026	stevenwong@rhslee.com
Eleanor Rego / Kaleo Nawahine	TCG Construction Inc	208-407-1123	Kaleo@thecoregroup.com
Chase Kutana / Kent Matsuzaki	Economy Plumbing & A/C	808-375-5102	kent@economyplumbingac.com
TRAVIS NIIMI	NEIL NAKAI, INC.	808-846-1496	TRAVIS.NIIMI@HAWAIIANTEL.NET
Flor Carman	CEI / Commercial Electric Inc	808-841-4595	flor@cei-oahu.com
Youn Hwang	Insynergy Engineering	808-521-3773	yhwang@insynergyeng.com
Greg Okita	Insynergy Engineering	808-521-3773	gokita@insynergyeng.com
Scott Tomokiyo	Insynergy Engineering	808-521-3773	stomokiyo@insynergyeng.com
Lance Inouye	Ralph J Inouye Co Ltd	808-837-9007	lance@rsinouye.com
Michael S. Inouye	R.M. Towill Corporation	808-375-2958	michael@rmtowill.com
Michael Karlson	R.M. Towill Corporation	808-225-3523	michaelk@rmtowill.com
Michael Hong	R.M. Towill Corporation	808-284-1871	michaelh@rmtowill.com
Landon Nakai	M. Nakai Repair	808-841-7581	landon@mnakai.com
TAD NAKAYAMA	DOD-ENGR	808-369-3490	tad.t.nakayama@hawaii.gov

PERMIT NO. P-2023-004

EFFECTIVE DATE:	Sept 15, 2023
EXPIRATION DATE:	Sept 14, 2028
Renewal Application must be received by:	Mar 14, 2028

This permit is issued under the provisions of Chapter 342L, Hawaii Revised Statutes (HRS), and Chapter 11-280.1, Hawaii Administrative Rules (HAR). The above-named permittee is hereby authorized to operate the underground storage tank (UST) shown below:

Facility Name: Hawaii Emergency Management Agency - Birkhimer
Facility Address: 4204 Diamond Head Road, Honolulu, Hawaii 96816
Facility ID Number: 9-101805

Tank ID No.	Capacity	Content
2	6,000 gallons	Diesel

Acceptance of this permit constitutes an acknowledgment and agreement that the holder will comply with all rules, statutes, and orders of the Department of Health (DOH) and the conditions precedent to the granting of this permit.

Joanna X. Gato
(for) DIRECTOR OF HEALTH
State of Hawaii

This permit must be kept on-site and shall be made available for inspection upon request.

STANDARD CONDITIONS

1. Owners and operators are responsible for complying with all applicable requirements of Chapter 342L, HRS, and Chapter 11-280.1, HAR.
2. This permit does not limit the DOH's authority to inspect the tanks or facility or to bring an enforcement action for violations of Chapter 342L, HRS, or Chapter 11-280.1, HAR.
3. This permit may not be transferred without the express approval of the Director of Health.
4. The Director of Health may revoke or suspend this permit for any of the reasons listed in §11-280.1-330, HAR.
5. The owner and operator must apply for a permit modification to add USTs or tank systems to this permit.
6. If the renovation or modification of a UST would cause the UST to be out of compliance with this permit, the owner and operator must also submit an application to modify the permit.
7. This permit must be maintained at the location of the UST or tank system for which it was issued and be made available for inspection upon request of any duly authorized representative of the DOH.

Operation Requirements

Owners or operators must:

8. Ensure that releases due to spilling and overfilling do not occur.
9. Report, investigate, and clean up any spills and overfills in accordance with §11-280.1-53, HAR.
10. Ensure that releases due to corrosion are prevented.
11. Use a UST or tank system made of or lined with materials that are compatible with the substance stored.
12. Ensure that repairs will prevent releases due to structural failure and corrosion for as long as the UST or tank system is used to store regulated substances.
13. Ensure that spill and overfill prevention equipment and containment sumps that are part of interstitial monitoring for piping are operating properly and will prevent releases to the environment.
14. Provide a method, or combination of methods, of release detection that is installed, calibrated, operated, and maintained in accordance with §11-280.1-40, HAR.
15. Conduct periodic walkthrough inspections and maintenance in accordance with §§11-280.1-36 and 11-280.1-37, HAR.
16. Cooperate fully with inspections, monitoring, and testing conducted by the DOH, as well as requests by the DOH for document submission, monitoring, and testing by owners and operators.

Notification Requirements

Owners and operators must submit the following information to the DOH:

17. Notification for all USTs and tank systems as required by §342L-30, HRS, and §11-280.1-34, HAR.
18. Reports of all releases including suspected releases, spills and overfills, and confirmed releases.
19. Release response actions planned or taken.
20. Documentation of permanent closure or change-in-service within thirty (30) days after completion of work, in accordance with §11-280.1-71(e), HAR.

Miscellaneous Requirements

21. For each UST or tank system that is in use or temporarily out of use, owners and operators must designate a class A, class B, and class C operator trained in accordance with Chapter 11-280.1, HAR, Subchapter 10.
22. Owners or operators of petroleum USTs or tank systems must demonstrate financial responsibility for taking release response actions and for compensating third parties for bodily injury and property damage caused by accidental releases arising from the operation of petroleum USTs or tank systems in accordance with Chapter 11-280.1, HAR, Subchapter 8.

SPECIAL CONDITIONS

None



Description

Practices and procedures to identify and prevent the discharge of pollutants from contaminated soil to the drainage system and adjacent waterbodies.

Applications

- Projects in urbanized or industrial areas where previous site usage, undetected spills or leaks, illicit discharges, or underground storage tank leaks may have contributed to soil contamination.

Installation and Implementation Requirements

- Abide by all federal, state, and local regulations when dealing with contaminated soil.
- A site assessment should be conducted prior to ground-disturbing activity to identify contaminated soil or other hazardous pollutants.
- Research records of previous site uses and activities.
- Identify soil discoloration, odors, soil property differences, abandoned underground tanks or pipes, or buried debris to determine possible soil contamination.
- If contaminated soil or other hazardous pollutants are found on-site, stop work in the area immediately and notify the State of Hawaii Department of Health, Hazard Evaluation & Emergency Response (HEER) office (808-586-4249), as well as the Project Engineer.

Installation and Implementation Requirements *(continued)*

- Contaminated soil shall be placed on an impermeable liner or device, such as 20-mil plastic sheeting, surrounded with impermeable lined berms and covered with impermeable sheeting.
- Soil suspected of being contaminated should be isolated from other stockpiles until test results return. If the suspected contaminated soil has evidence of contamination (odor, sheen, color, etc.), then it should be handled and stored as contaminated until testing determines otherwise. Known contaminated soil must be segregated from uncontaminated soil.
- Soil testing is the only option to know if soil is contaminated. Sampling of the soil shall follow DOH guidelines and requirements. Test soil at a certified laboratory if soil is suspected of contamination. Multi Increment testing should be conducted if soil is contaminated with lead because it is commonly unevenly distributed.
- The contractor shall propose the testing protocols for the Engineer's approval.
- Contaminated soil stockpiles must remain on-site and cannot be transported or stored off-site without prior authorization.
- Temporary stockpiles of contaminated material must have signage designating material as contaminated.
- Identify area to temporarily store contaminated soil away from drainage facilities, waterbodies and conveyance systems.
- Construction vehicles leaving the excavation area must be clean of contaminated soil. All contaminated soil and wash water from vehicle cleaning must be properly contained, collected, and disposed of.
- Contaminated soil disposal options:
 - Re-use on-site (not grossly contaminated)
 - Off-site reuse (Refer to DOH *Guidance for Soil Stockpile Characterization and Evaluation of Imported and Exported Fill Material*)
 - Landfill disposal (check with landfill)



Contaminated material stockpiles must have signage designating material as contaminated.

Considerations

- Dispose of contaminated soils at DOH-permitted facilities. Transfer contaminated soils via DOH-approved transporter.

Considerations *(continued)*

- This manual does not explain environmental laws and regulations. Therefore, it is required to have a licensed contracting firm that is experienced in handling contaminated and hazardous materials when dealing with contaminated soil.
- Site-specific conditions may require the use of additional personal protective equipment (PPE). Gloves and safety glasses must be worn when dealing with contaminated soil.
- A removal action may be conducted either as a stand-alone response action, or as an interim response action to be followed by further removal or remedial action at a later date. In addition, a removal action may result in long-term management of contamination on site. Each of these different types of removal actions has implications for site closure.

What to Inspect

- Are stockpiles of contaminated soil stored on an impermeable liner or device, surrounded by an impermeable lined berm, and completely covered with impermeable material?
- Are the BMP measures installed properly and maintained?
- Has the contaminated soil been properly tested, per DOH guidelines and requirements?
- Is the contaminated soil in contact with non-contaminated bare soil?
- Has the contaminated soil come into contact with rainwater?
- Is the contaminated soil stockpile isolated from other stockpiles?

Maintenance

- Prevent leaks and spills by implementing spill prevention and control practices and procedures. *See* section SM-10 Spill Prevention and Control for more information.
- Repair tears and rips to the impermeable berm and cover to ensure erosion is prevented.
- Damaged perimeter control devices must be repaired/replaced when the device is not functioning as designed.
- Repair/replace barriers that no longer prevent contaminated soil from coming into contact with bare soils.

Hazardous Materials and Waste Management



Description

Practices and procedures to prevent hazardous material and waste from discharging into the storm drain system or adjacent waterbodies.

Applications

Handling and storing procedures on construction sites involving the following hazardous materials and waste:

TYPICAL HAZARDOUS MATERIALS AND WASTES FROM COMMERCIAL CONSTRUCTION AND DEMOLITION (C&D) JOBS

- Oil-based paint, stains, and varnishes
- Acids and bases (e.g., muriatic acid, etc.)
- Ignitable waste (gasoline and diesel)
- Used batteries
- Waste vehicle lubricants (e.g., used motor oil, etc.)
- Latex paint with mercury
- Thinners and painting solvents
- Spent sand blast material from paint removal operations
- Weatherproofing/insulation solvents
- Finishing and flooring adhesives and sealants
- Mechanical/electrical waste
- Absorbent materials used to clean up spills

Hazardous Materials and Waste Management

Applications *(continued)*

- All petroleum-based products
- Concrete curing/repair compounds and related concrete work products
- Contaminated rags
- Waste mercury or acrylic mercury paint
- Non-empty aerosol cans

TYPICAL HAZARDOUS MATERIALS AND WASTE FROM EXISTING STRUCTURES

- Sandblasted material such as grit or chips containing lead, cadmium, or chromium-based paints
- Asbestos
- Polychlorinated Biphenyls (PCBs)
 - Older transformers are a common source of PCBs.

Installation and Implementation Requirements

POTENTIALLY HAZARDOUS WASTE RECOGNITION

- Review product label and shipping papers.
- Identify key words such as flammable or ignitable (able to catch fire); carcinogenic (causes cancer); toxic or poisonous (injures or harms people or animals); and hazardous, danger, caustic or corrosive (burns through chemical action). Hawaii Administrative Rules (HAR) Title 11, Chapter 261 includes a list of hazardous waste and criteria. Review Safety Data Sheets (SDS) from the manufacturer and supplier of the product.

HAZARDOUS MATERIALS HANDLING AND STORAGE

- Hazardous material should remain in the original container. Do not transfer material into another storing device unless it is considered waste.
- Keep the original product label on the container because it includes important safety and disposal information. Keep all SDS at a designated location. Inform all personnel of the location of the SDS.
- Restrict amount of herbicide and fertilizer prepared to the quantity necessary for the current application. Comply with the recommended usage instructions. Do not apply herbicides and fertilizers during or just before a rain event.

Hazardous Materials and Waste Management

Installation and Implementation Requirements *(continued)*

- It is preferred to store hazardous material under a covered facility. If a covered facility is not applicable, materials must be placed in secondary containment and covered with impermeable material to prevent storm water from coming in contact with materials.
- Secondary containment must be able to retain 100% of the volume of the largest container or 10% of the aggregate total of all the containers being stored within the secondary containment, whichever is greater.
- Metal containers shall be covered by an impermeable material so they are not exposed to rainwater, which can cause rusting and potential leaks.
- Secondary containment is required for storing hazardous materials and must be impervious to the materials stored.
- All spills, free products, or storm water captured in a secondary containment shall be immediately removed and properly disposed of.
- Incompatible materials, such as chlorine and ammonia, shall not be stored in the same temporary containment facility.
- Immediately clean up hazardous waste that spills or leaks on the ground. Do not hose down or bury spills.



Hazardous materials stored under a covered facility and in secondary containment prevents storm water from coming into contact with materials.

DISPOSAL OF HAZARDOUS WASTE FROM CONSTRUCTION ACTIVITIES

- It is required to ensure the site has adequate space for hazardous waste storage volume.
- Waste storage areas must be located away from drain inlets, watercourses, and moving vehicles.
- Minimize hazardous waste stored on-site.
- Waste shall not be mixed and drums used for waste shall not be overfilled.
- Label all waste containers with the type of waste being stored and the date of accumulation.

Hazardous Materials and Waste Management

Installation and Implementation Requirements *(continued)*

- Store hazardous waste separate from non-hazardous waste to prevent mixing in case of a spill. Do not mix wastes.
- Remove as much paint from brushes on painted surface. Do not clean or rinse water-based paint brushes in soil, streets, gutters, storm drains, or streams. Rinse from water-based paints shall be discharged into the sanitary sewer system. Filter and reuse solvents and thinners.
- Dispose of oil-based paints and residue as a hazardous waste.
- Place hazardous waste in a sealable container suitable for the material.
- Rainwater that mixes with hazardous waste due to spills or leaks shall be treated as hazardous waste and must be placed in drums.
- Dispose of container only after all of the product has been used in accordance with federal, state, and local regulations.
- Hazardous waste that will not be recycled/reused must be disposed of off-site within 90 days of being generated, or as directed by the Resident/Construction Engineer.
- Maintain an ample supply of cleanup materials that are readily accessible for spills. All employees shall be informed of the location of the cleanup material and trained in their proper use.
- Hazardous waste must not accumulate on the ground.
- A licensed hazardous waste transporter shall dispose of hazardous waste at an authorized disposal facility. For more information regarding licensed transporters, refer to the State of Hawaii Department of Health (DOH) Hazardous Waste Section at website – <http://health.hawaii.gov/shwb/hazwaste/>.



Metal containers must be covered by an impermeable material or under a covered facility to prevent contact with rainwater, which can cause rusting and potential leaks.

WASTE RECYCLING AND DISPOSAL OF HAZARDOUS WASTE

- Designate areas for collection of hazardous wastes.
- Store hazardous materials and wastes in covered containers and label according to applicable Resource Conservation and Recovery Act (RCRA) requirements.
- Provide secondary containment for hazardous waste containers to prevent contact with storm water runoff.
- Keep wastes separate to prevent chemical reactions which make recycling and disposal difficult.
- Recycle useful materials such as oil- or water-based paint.

Hazardous Materials and Waste Management

Installation and Implementation Requirements *(continued)*

- Do not dispose of toxic liquid wastes (solvents, used oils, and paints) or chemicals (additives, acids, and curing compounds) in dumpsters allocated for construction debris.
- Schedule periodic waste collection to prevent overflow of containers.
- Ensure collection, removal, and disposal of hazardous waste complies with regulations.
- Clean up spills immediately. Do not clean spills or surfaces by hosing the area down. Use the appropriate tools in the spill prevention kit to mitigate spills from leaching into the receiving waters or entering a storm drainage system.
- Eliminate the source of the spill to prevent a discharge or a continuation of an ongoing discharge.

Considerations

- Hazardous waste that cannot be reused or recycled shall be disposed of by a licensed hazardous waste hauler.
- Nothing in this section relieves the contractor's responsibility of compliance with federal and state laws.

What to Inspect

- Is hazardous material in secondary containment and covered with an impermeable material?
- Are containers completely empty before being thrown into the waste bin?
- Is plastic cover ripped or torn?
- Are metal containers containing hazardous material rusting or leaking?
- Are original labels on all containers containing hazardous material?
- Are containers completely sealed?
- Is hazardous material in its original container?
- Is there evidence of leaks or spills on ground?
- Is hazardous waste being stored properly and regularly disposed of by a licensed transporter?



Hazardous materials not stored in a covered facility must be placed in secondary containment and under an impermeable cover.



Hazardous Materials and Waste Management

What to Inspect *(continued)*

- Is there an ample supply of cleanup material readily accessible?
- Is hazardous waste being mixed?

Maintenance

- Schedule regular hazardous waste collection.
- Replace/repair secondary containment if there are signs of leaking.
- Replace plastic cover that has rips and tears.
- Immediately clean up spills of hazardous material and dispose of waste properly.
- Maintain areas where hazardous material and waste must be kept clean and well organized.